

# University of Alaska Fairbanks UAF CTC BARNETTE PARKING GARAGE HEATING

## PROJECT NUMBER D18032-CTCGH



FACILITIES SERVICES  
DESIGN & CONSTRUCTION  
P.O. BOX 758160  
FAIRBANKS, AK 99775-8160  
907-474-5299  
907-474-7554 (fax)  
www.uaf.edu/ddc

Consultant:

Stamp:


Project Phase:  
RECORD DRAWINGS  
Project Title:  
**UAF CTC BARNETTE  
PARKING GARAGE HEATING**

Sheet Contents:  
TITLE SHEET

DATE	REVISIONS:	BY:

DRAWN AMK/RCL  
CHECKED JVK/PMB  
DATE SEPTEMBER 20, 2018  
SCALE 0"=1"

Project Number:  
**D18032-CTCGH**  
SHEET NO.  
**T100**  
1 OF 6

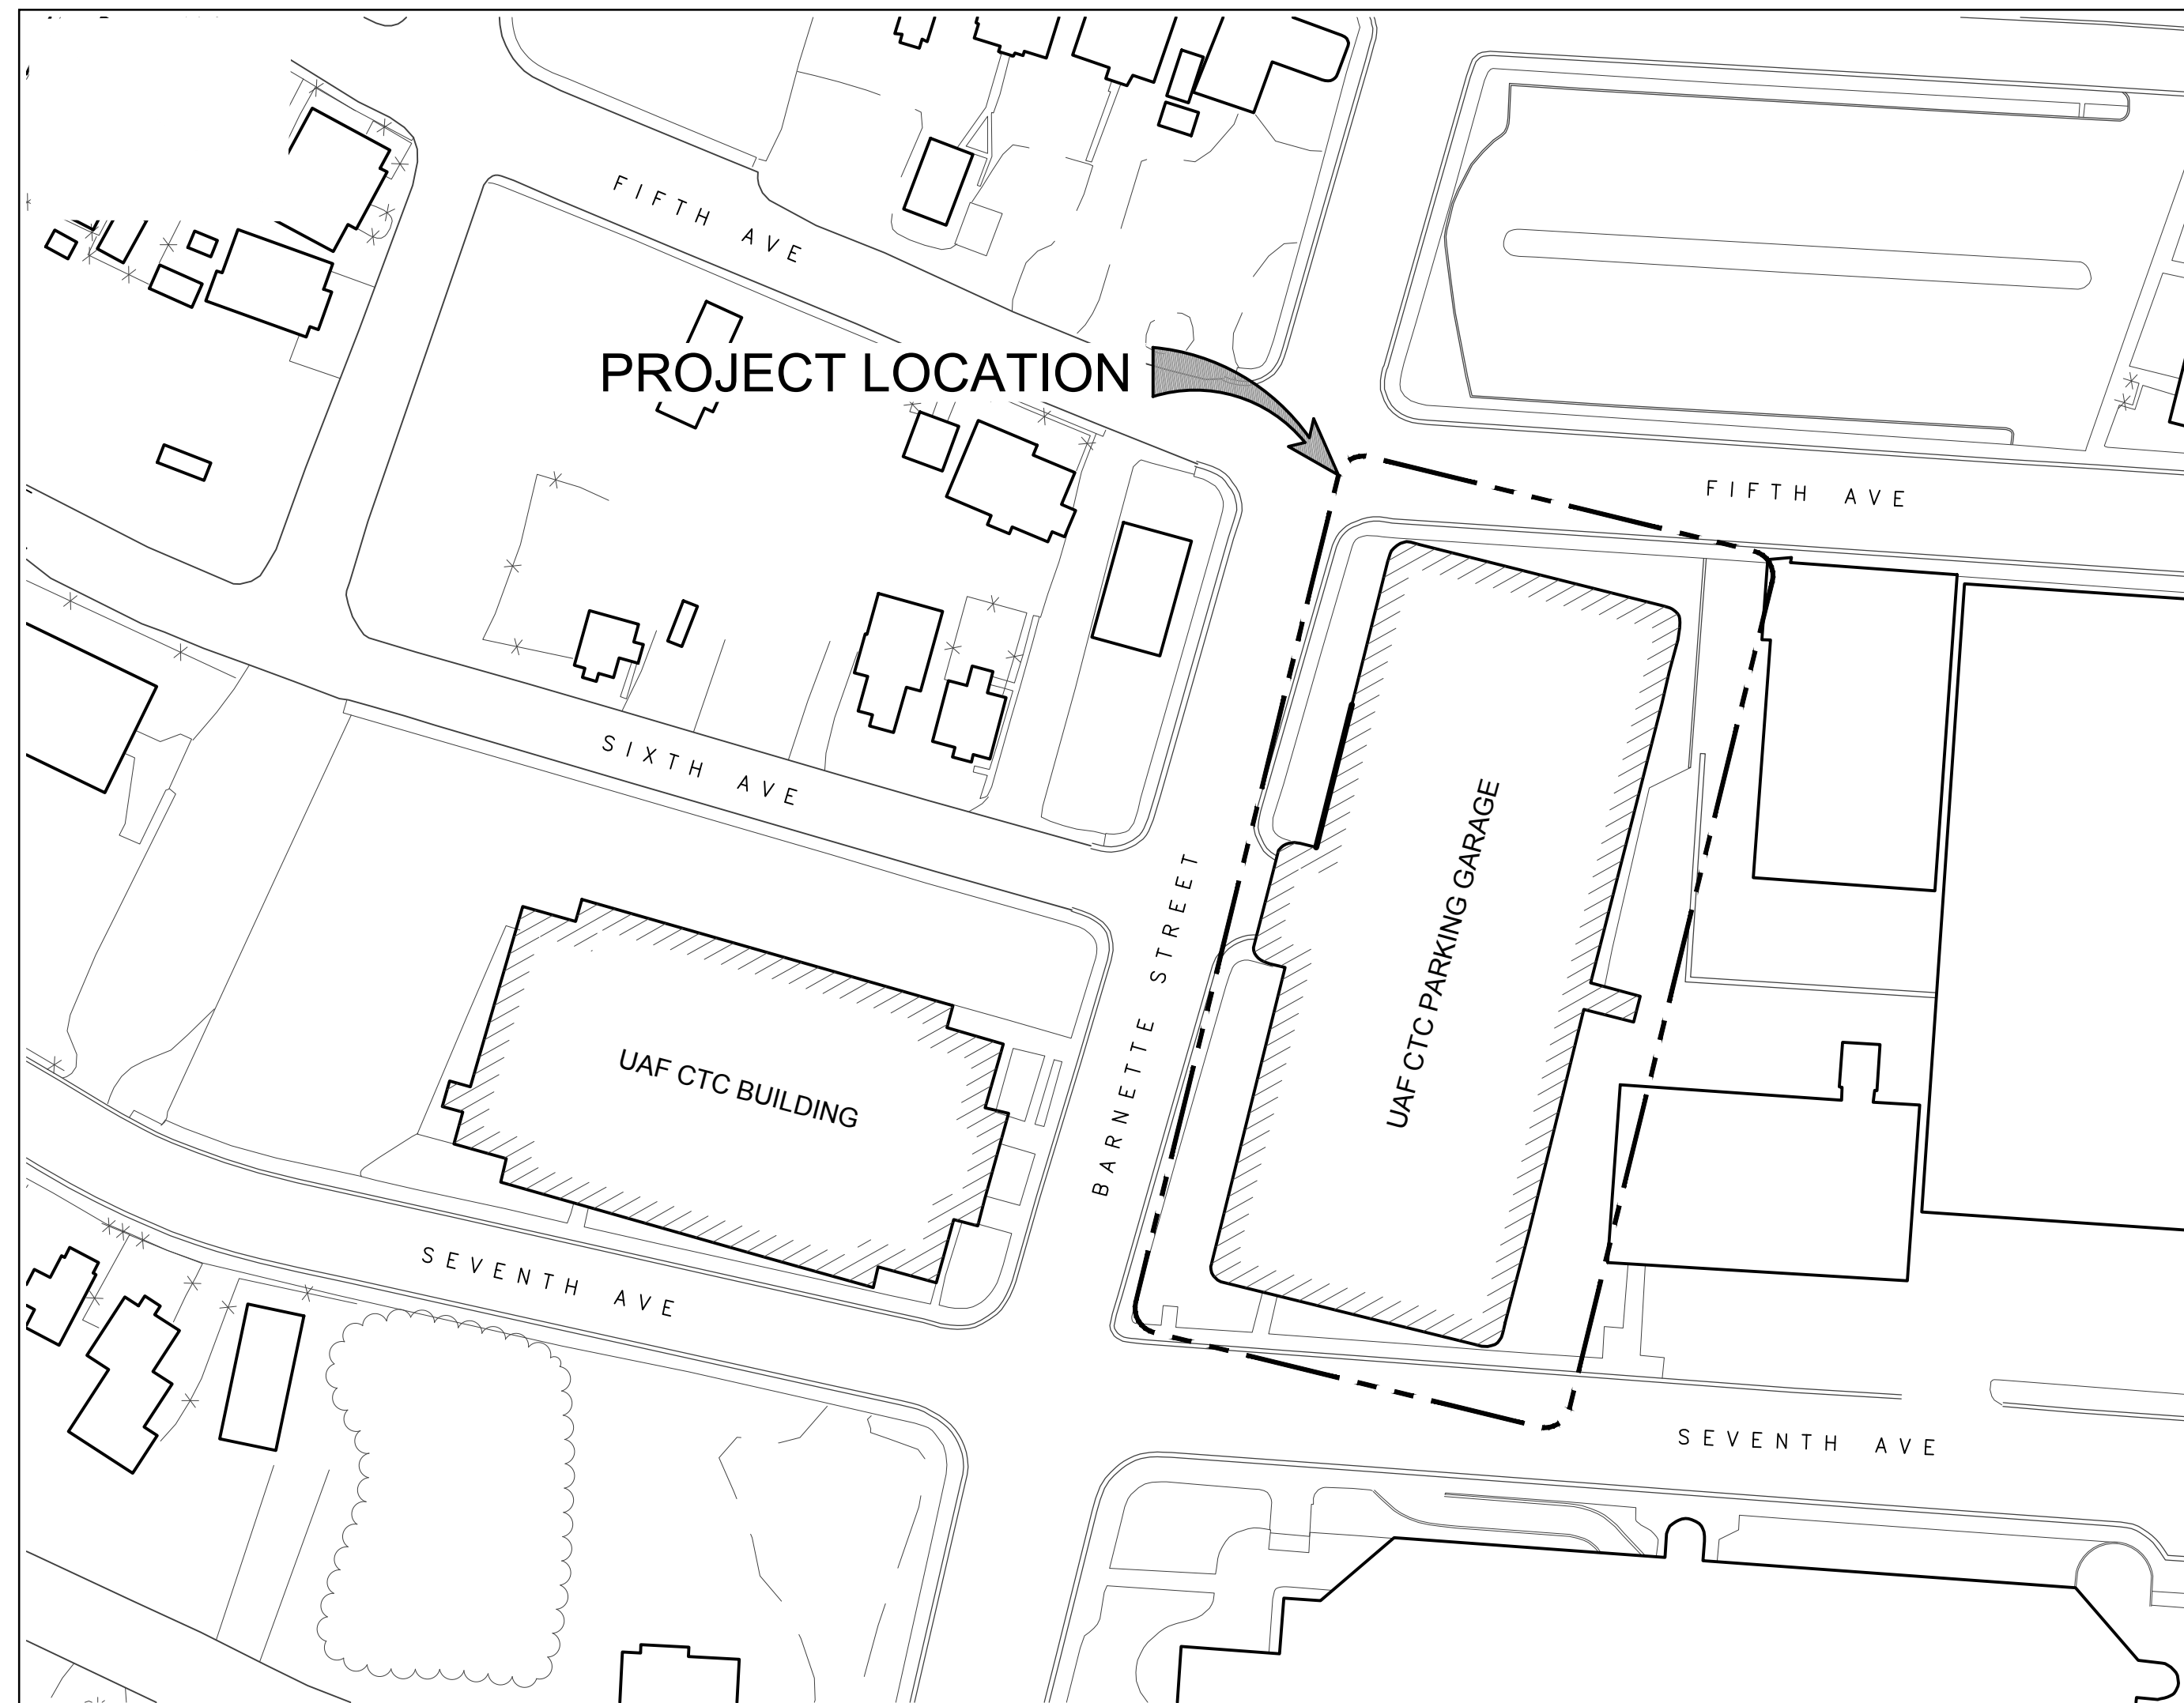

### DRAWING INDEX

T100	TITLE SHEET
M001	ABBREVIATIONS AND LEGENDS
M101	OVERALL PIPING PLAN
M102	MECH ROOM 000U1 PLAN AND DETAILS
M103	FIRST AND SECOND FLOOR PLANS
M104	DETAILS
M105	SPECIFICATIONS



UAF COMUNITY & TECHNICAL COLLEGE DOWNTOWN LOCATION

**RECORD DRAWING**  
THIS DRAWING HAS BEEN MODIFIED TO CONFORM TO AS-BUILT CONSTRUCTION CONDITION, ACCORDING TO REQUIREMENTS OF THE CONSTRUCTION CONTRACTOR, XACTA CONSTRUCTION CO., AND UNIVERSITY REPRESENTATIVE.  
UNIVERSITY OF ALASKA FAIRBANKS  
FACILITIES SERVICES - DIVISION OF DESIGN AND CONSTRUCTION  
SEPTEMBER 20, 2018

**ABBREVIATIONS**

<b>ENGLISH UNITS</b>		GCHWS(R) GLYCOL CHILLED WATER SUPPLY (RETURN)	W WASTE
# POUNDS/PSI		GHS(R) GLYCOL HEATING SUPPLY (RETURN)	W/ WITH
BHP BRAKE HORSE POWER		GI GALVANIZED IRON	W/O WITHOUT
BTUH BRITISH THERMAL UNITS PER HOUR		GT GLYCOL TANK	WB WET BULB
CFM CUBIC FEET PER MINUTE		GWB GYPSUM WALL BOARD	WC WATER CLOSET
F DEGREES FAHRENHEIT			WCO WALL CLEAN OUT
FPM FEET PER MINUTE			WH WATER HEATER
FT FEET			WHA WATER HAMMER ARRESTOR
FT WG FEET OF WATER GAUGE		H2O WATER	
GAL GALLONS		HB HOSE BIBB	
GPH GALLONS PER HOUR		HPS HIGH PRESSURE STEAM	
GPM GALLONS PER MINUTE		HR HOUR	
HP HORSEPOWER		HTG HEATING	
IN INCH		HW HOT WATER	
IN WG INCHES OF WATER GAUGE		HWS(R) HEATING WATER SUPPLY (RETURN)	
KW KILOWATT			
LB POUNDS		ID INSIDE DIAMETER	
LF LINEAR FOOT		IE INVERT ELEVATION	
MBH ONE THOUSAND BTU PER HOUR		INSUL INSULATION	
PSI POUNDS PER SQUARE INCH		IPS IRON PIPE SIZE	
WG WATER GAUGE			
<b>STANDARD ABBREVIATIONS</b>		LAT LEAVING AIR TEMPERATURE	
& AND		LAV LAVATORY	
@ AT		LGT LEAVING GLYCOL TEMPERATURE	
# NUMBER		LPS LOW PRESSURE STEAM	
A AIR			
AFF ABOVE FINISHED FLOOR		M MINUTES	
AGT AVERAGE GLYCOL TEMPERATURE		MAX MAXIMUM	
AHU AIR HANDLING UNIT		MECH MECHANICAL	
APD AIR PRESSURE DROP		MIN MINIMUM	
APPR APPROVED		MTR MOTOR	
APPROX APPROXIMATE			
ARCH ARCHITECTURAL		NC NORMALLY CLOSED OR NOISE CRITERIA	
AUTO AUTOMATIC		NG NATURAL GAS	
AV ACID VENT		NIC NOT IN CONTRACT	
AW ACID WASTE		NO NORMALLY OPEN	
		NOM NOMINAL	
BAL BALANCING		NPSH NET PUMP SUCTION HEAD	
BFF BELOW FINISHED FLOOR		NTS NOT TO SCALE	
BFW BOILER FEED WATER			
C COMMON		OBVD OPPOSED BLADE VOLUME DAMPER	
CA COMPRESSED AIR		OC ON CENTER	
CAPAC CAPACITY		OD OUTSIDE DIAMETER	
CI CAST IRON		OFCI OWNER FURNISHED CONTRACTOR INSTALLED	
CHWS(R) CHILLED WATER SUPPLY AND RETURN		OFOI OWNER FURNISHED OWNER INSTALLED	
CLG COOLING		ORD OVERFLOW ROOF DRAIN	
CO CLEAN OUT		ORL OVERFLOW RAIN LEADER	
COORD. COORDINATE		OSA(D) OUTSIDE AIR (DAMPER)	
CR CONDENSATE RETURN		OSAT OUTSIDE AIR TEMPERATURE	
CUH CABINET UNIT HEATER			
Cv VALVE COEFFICIENT		P&TRV PRESSURE AND TEMPERATURE RELIEF VALVE	
CW COLD WATER		PD PRESSURE DROP	
CWS(R) CONDENSER WATER SUPPLY (RETURN)		PH PHASE	
		PRDV PRESSURE REDUCING VALVE	
		PRV PRESSURE RELIEF VALVE	
DB DECIBEL		RA(D) RETURN AIR (DAMPER)	
DB DRYBULB		RD ROOF DRAIN	
DIA DIAMETER		RHW RECIRCULATED HOT WATER	
DN DOWN		RL RAIN LEADER	
DWDI DOUBLE WIDTH DOUBLE INLET		RPM REVOLUTIONS PER MINUTE	
E EXISTING		S SECONDS	
EA EACH		SG SUPPLY GRILLE	
EA(D) EXHAUST AIR (DAMPER)		SH SHOWER	
EAT ENTERING AIR TEMP		SIM SIMILAR	
EF EXHAUST FAN		SP STATIC PRESSURE	
EG EXHAUST GRILLE		SS STAINLESS STEEL	
EGT ENTERING GLYCOL TEMP		ST STEAM	
ELEC ELECTRICAL		SWSI SINGLE WIDTH SINGLE INLET	
ELEV ELEVATOR			
EQPM EQUIPMENT		TG TRANSFER GRILLE	
ESP EXTERNAL STATIC PRESSURE		THW TEMPERED HOT WATER	
ETR EXISTING TO REMAIN		TP TRAP PRIMER	
EWT ENTERING WATER TEMPERATURE		TYP TYPICAL	
EXIST EXISTING			
		U URINAL	
FC FORWARD CURVED		UH UNIT HEATER	
FCO FLOOR CLEAN OUT			
FD FLOOR DRAIN		V VOLTS OR VENT	
FTR FINNED TUBE RADIATION		VAV VARIABLE AIR VOLUME	
FLA FULL LOAD AMPERAGE		VERT VERTICAL	
FLEX FLEXIBLE		VFD VARIABLE FREQUENCY DRIVE	
		VOL VOLUME	
GA GAUGE		VTR VENT THROUGH ROOF	

**SYMBOLS LEGEND**

**PIPING SYMBOLS**

SYMBOL	ABBREV	SYSTEM
		CONNECTION TO EXISTING
		DIRECTION OF FLOW
		PIPE CONNECTION
		ELBOW TURNED DOWN
		ELBOW TURNED UP
		TEE DOWN
		TEE TURNED UP
		UNION
		CHECK VALVE
		ISOLATION VALVE
		FLOOR DRAIN
		FLOOR CLEAN OUT
		PRESSURE RELIEF VALVE
		PRESSURE REDUCING VALVE
		STRAINER
		METER
		THERMOSTAT
		FINNED TUBE RADIATION
		CONVECTOR/CABINET UNIT HEATER
		PRESSURE GAUGE WITH ISOLATION VALVE
		ISOLATION VALVE WITH 3/8" HOSE END AND CAP
		CONCENTRIC REDUCER
		ECCENTRIC REDUCER
		PIPE CAP
		AIR VENT WITH AIR VENT ISOLATION VALVE
		BALANCING VALVE
		THERMOSTATIC CONTROL VALVE W/ REMOTE SENSOR



FACILITIES SERVICES  
DESIGN & CONSTRUCTION  
P.O. BOX 758160  
FAIRBANKS, AK 99775-8160  
907-474-5299  
907-474-7554 (fax)  
www.uaf.edu/ddc

Consultant:

Stamp:


Project Phase:  
RECORD DRAWINGS  
Project Title:  
**UAF CTC BARNETTE  
PARKING GARAGE HEATING**

Sheet Contents:  
ABBREVIATIONS AND  
LEGENDS

DATE	REVISIONS:	BY:
DRAWN	AMK/RCL	
CHECKED	PMB/JVK	
DATE	SEPTEMBER 20, 2018	
SCALE	0" = 1"	
Project Number:	D18032-CTCGH	
SHEET NO.	M001	
	2 OF 6	

**RECORD DRAWING**  
THIS DRAWING HAS BEEN MODIFIED TO CONFORM TO AS-BUILT CONSTRUCTION CONDITIONS, ACCORDING TO REQUIREMENTS OF THE CONSTRUCTION CONTRACTOR, XADTA CONSTRUCTION CO., AND UNIVERSITY REPRESENTATIVE.  
UNIVERSITY OF ALASKA FAIRBANKS  
FACILITIES SERVICES - DIVISION OF DESIGN AND CONSTRUCTION  
SEPTEMBER 20, 2018



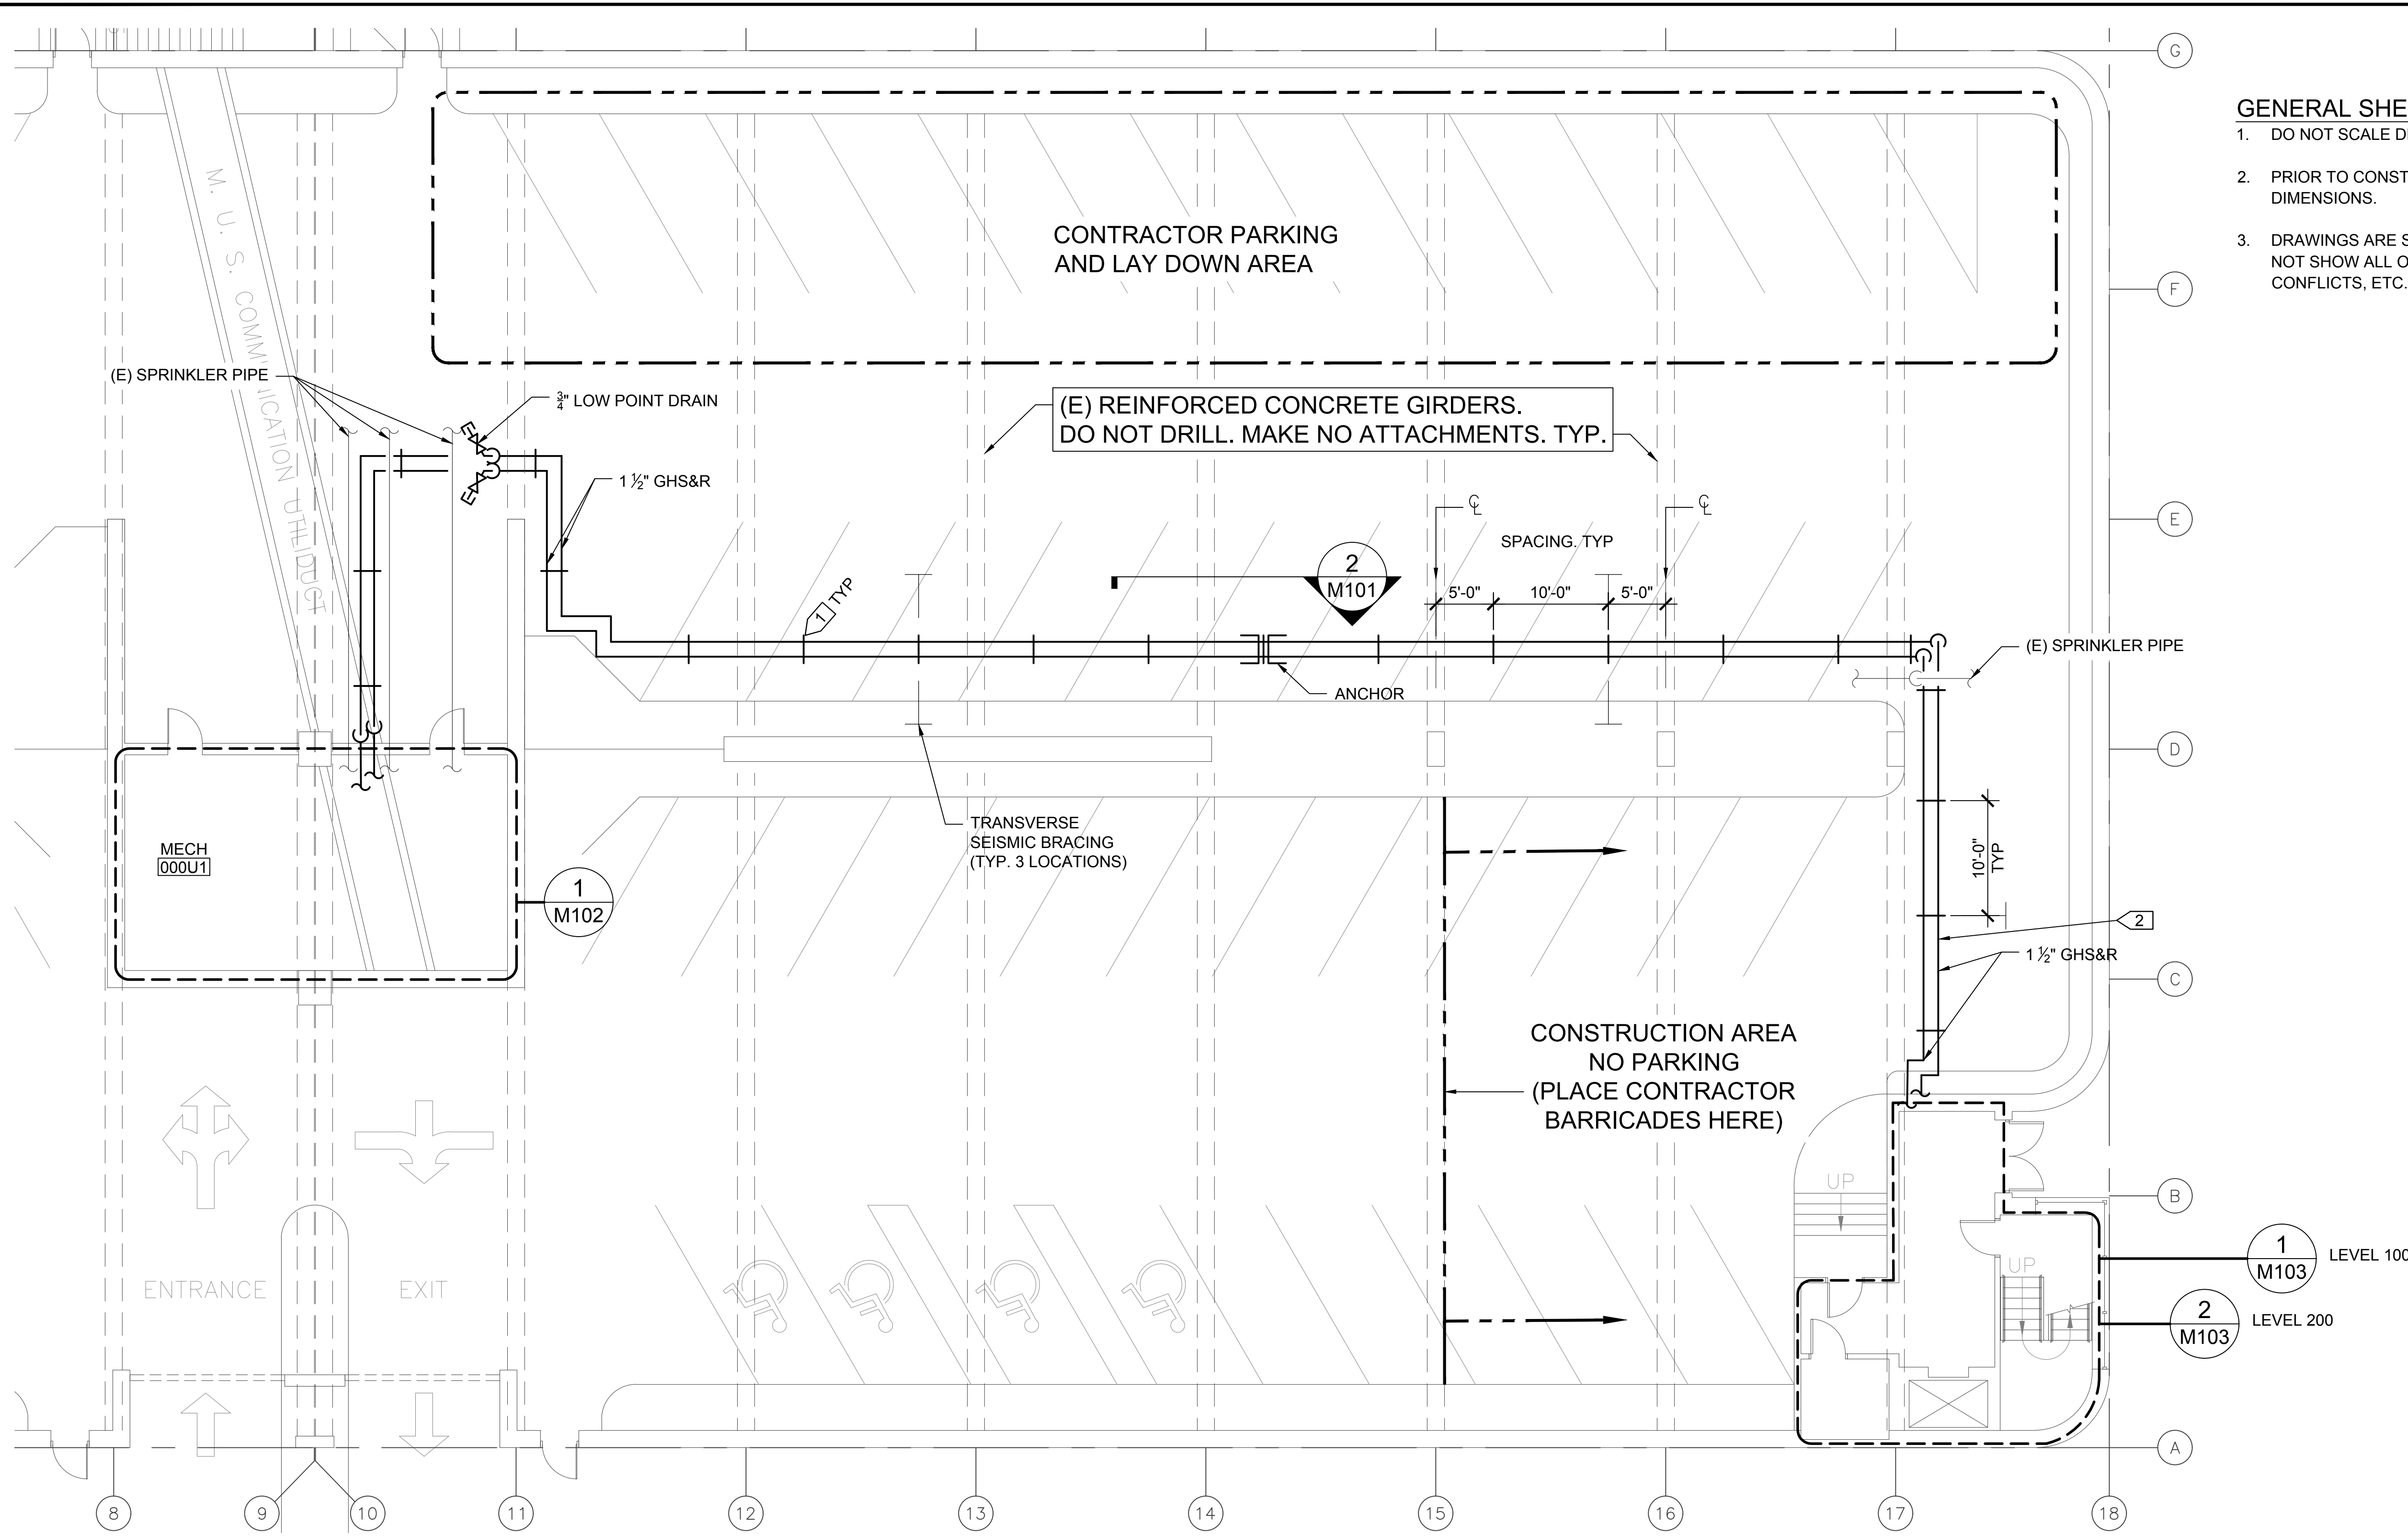

**GENERAL SHEET NOTES:**

- DO NOT SCALE DRAWINGS.
- PRIOR TO CONSTRUCTION FIELD VERIFY ALL DIMENSIONS.
- DRAWINGS ARE SOMEWHAT DIAGRAMATIC AND DO NOT SHOW ALL OFFSETS, BRANCH PIPING, CONFLICTS, ETC.

**UAF**  
Facilities Services

FACILITIES SERVICES  
DESIGN & CONSTRUCTION  
P.O. BOX 758160  
FAIRBANKS, AK 99775-8160  
907-474-5299  
907-474-7554 (fax)  
www.uaf.edu/ddc

Consultant:

Stamp:

Project Phase:  
RECORD DRAWINGS

Project Title:  
**UAF CTC BARNETTE  
PARKING GARAGE HEATING**

- SPECIFIC NOTES:**
- PROVIDE TRAPEZE HANGER WITH 3/8" ROD ANCHORED TO CONCRETE DECK ABOVE. CLAMP PIPE DIRECTLY TO STRUT.
  - INSTALL NEW 1 1/2" GHS&R PIPING AND INSULATION ASSEMBLY WITH BOTTOM HIGHER THAN BOTTOM OF ADJACENT CONCRETE GIRDER.

**RECORD DRAWING**

THIS DRAWING HAS BEEN MODIFIED TO CONFORM TO AS-BUILT CONSTRUCTION CONDITION, ACCORDING TO REQUIREMENTS OF THE CONSTRUCTION CONTRACTOR, XACTA CONSTRUCTION CO., AND UNIVERSITY REPRESENTATIVE.


UNIVERSITY OF ALASKA FAIRBANKS  
FACILITIES SERVICES-DIVISION OF DESIGN AND CONSTRUCTION  
SEPTEMBER 20, 2018

**1**  
M101

**OVERALL PIPING PLAN**  
SCALE: 1/8" = 1'-0" @ 22X34

**2**  
M101

**PIPE ANCHOR DETAIL**  
SCALE: NTS

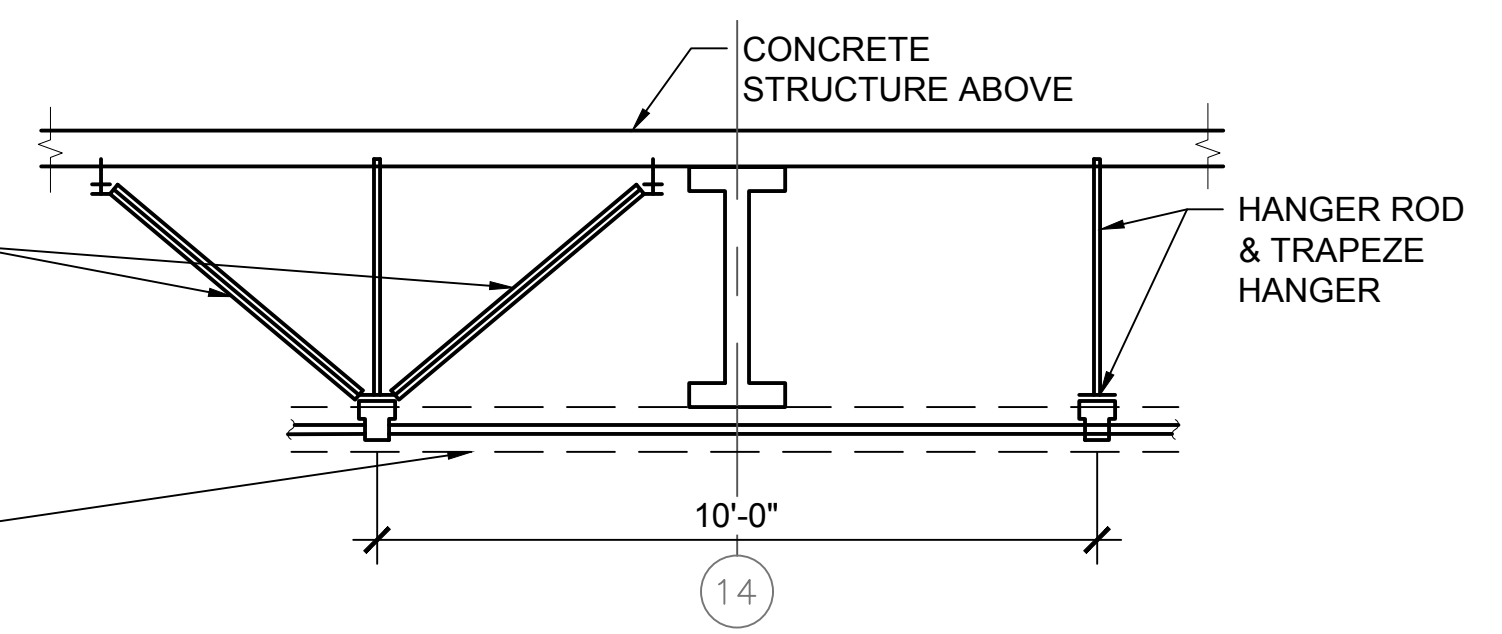


Sheet Contents:  
**OVERALL PIPING PLAN**

DATE	REVISIONS:	BY:

DRAWN: AMK/RCL  
CHECKED: JVK/PMB  
DATE: SEPTEMBER 20, 2018  
SCALE: 0" = 1'-0"


Project Number:  
**D18032-CTCGH**

SHEET NO.  
**M101**  
3 OF 6

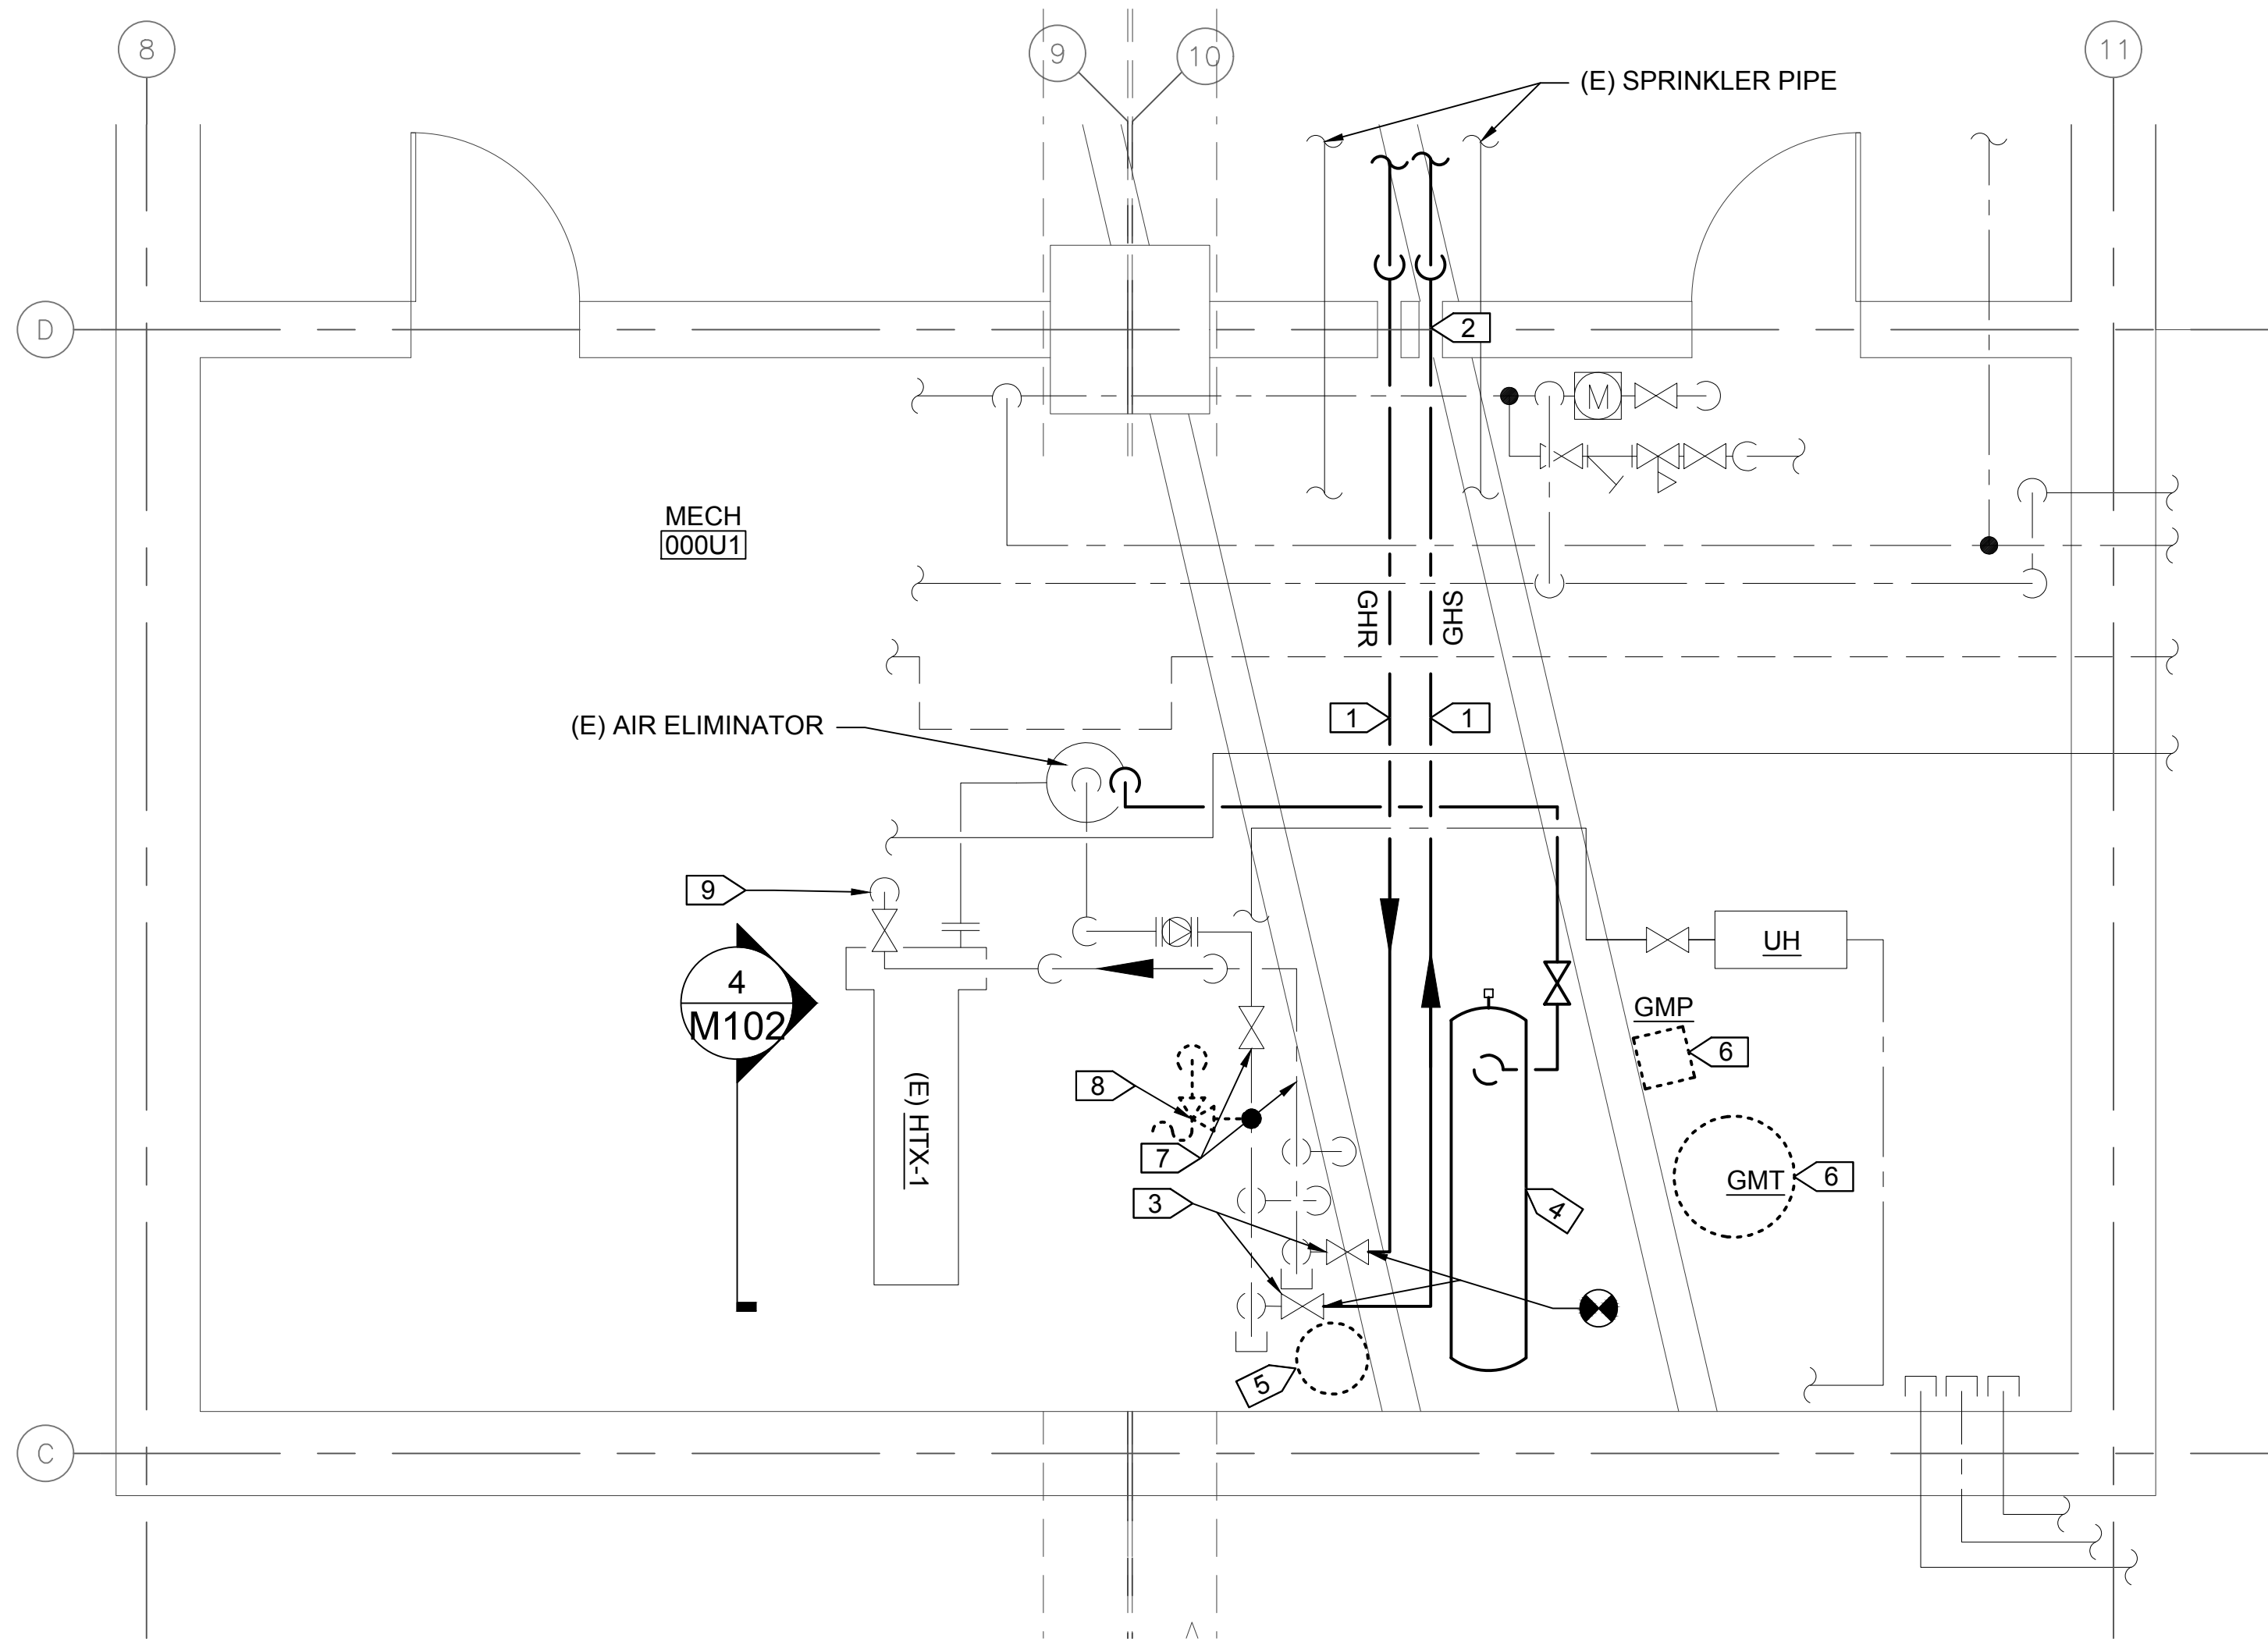


**SPECIFIC NOTES:**

- 1 1 1/2" GHS&R. COORDINATE ROUTING TO AVOID INTERFERENCE WITH NEW HEATING SYSTEM COMPRESSION TANK.
- 2 PIPE INSULATION AND FIRE CAULK.
- 3 (E) 1 1/2" BALL VALVE ISOLATION.
- 4 COMPRESSION TANK, (OFCI). SEE 2/M102.
- 5 REMOVE (E) DIAPHRAGM EXPANSION TANK. SEE 3/M102.
- 6 REMOVE (E) GLYCOL MAKE-UP PUMP AND (E) GLYCOL MAKE-UP TANK. SEE 3/M102. SALVAGE GMT FOR NEW PRV LOCATION.
- 7 GLYCOL HEATING SUPPLY AND RETURN HEADERS ARE STACKED VERTICALLY, SHOWN OFFSET HERE FOR CLARITY.
- 8 (E) PRESSURE RELIEF VALVE. REMOVE AND PLUG/CAP AS CLOSE TO RETURN MANIFOLD AS POSSIBLE.
- 9 PROVIDE PRESSURE RELIEF VALVE. SIZE TO MATCH PRESSURE RELIEF VALVE REMOVED. PROVIDE THREAD-O-LET, WELDED TO ELBOW, SIZED TO RECEIVE PRV. PROVIDE DISCHARGE PIPING ROUTED TO SALVAGED & RELOCATED GMT. SIZE DISCHARGE PIPE TO MATCH PRV DISCHARGE

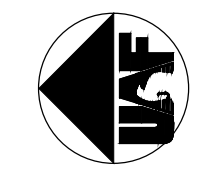


**1 MECH ROOM 000U1 NEW WORK PLAN**  
SCALE: 3/8" = 1'-0" @ 22X34

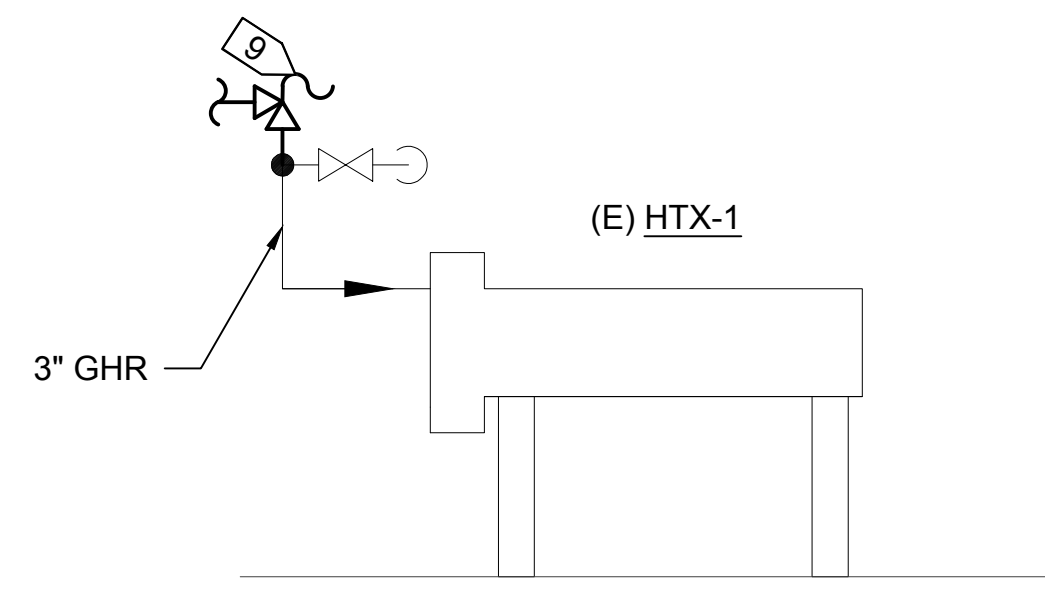


**4 HEAT TRANSFER UNIT DETAIL**  
SCALE: NTS

**RECORD DRAWING**  
THIS DRAWING HAS BEEN MODIFIED TO CONFORM TO AS-BUILT CONSTRUCTION CONDITION, ACCORDING TO RED-LINES OF THE CONSTRUCTION CONTRACTOR, VACTA CONSTRUCTION CO., AND UNIVERSITY REPRESENTATIVE.  
UNIVERSITY OF ALASKA FAIRBANKS FACILITIES SERVICES-DIVISION OF DESIGN AND CONSTRUCTION  
SEPTEMBER 20, 2018

- GENERAL SHEET NOTES:**
- DO NOT SCALE DRAWINGS.
  - PRIOR TO CONSTRUCTION FIELD VERIFY ALL DIMENSIONS.
  - DRAWINGS ARE SOMEWHAT DIAGRAMATIC AND DO NOT SHOW ALL OFFSETS, BRANCH PIPING, CONFLICTS, ETC.

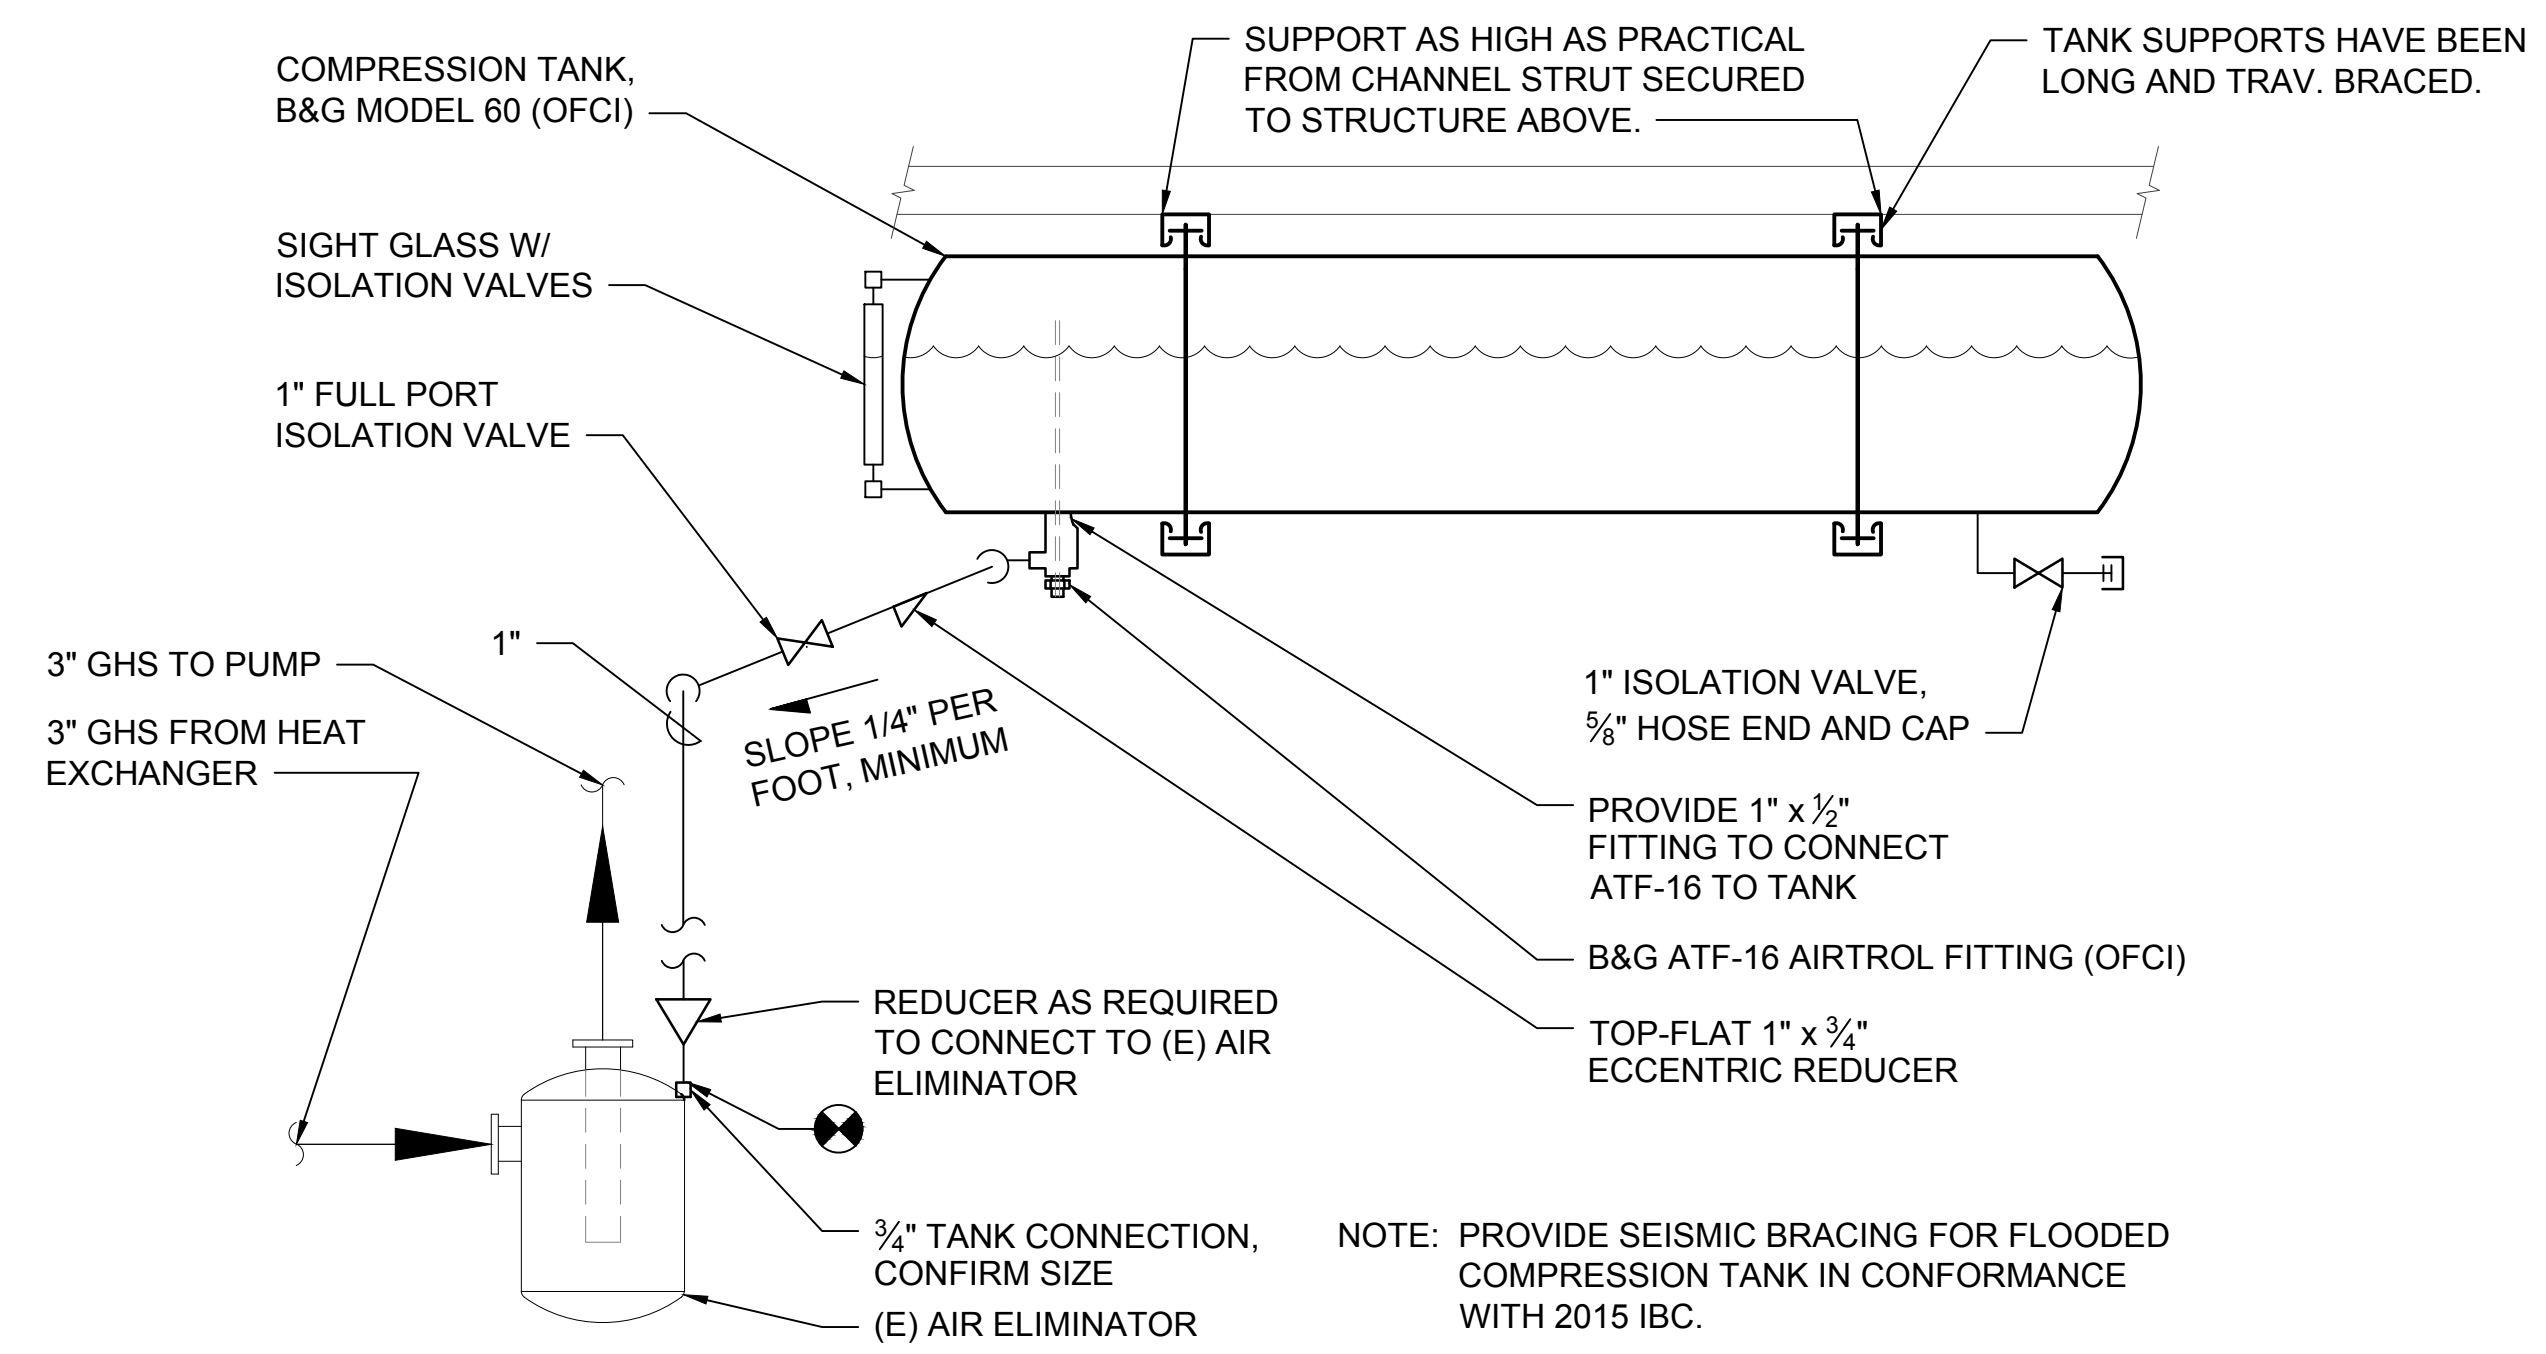

**2 COMPRESSION TANK PIPING & INSTALLATION DETAIL**  
SCALE: NTS

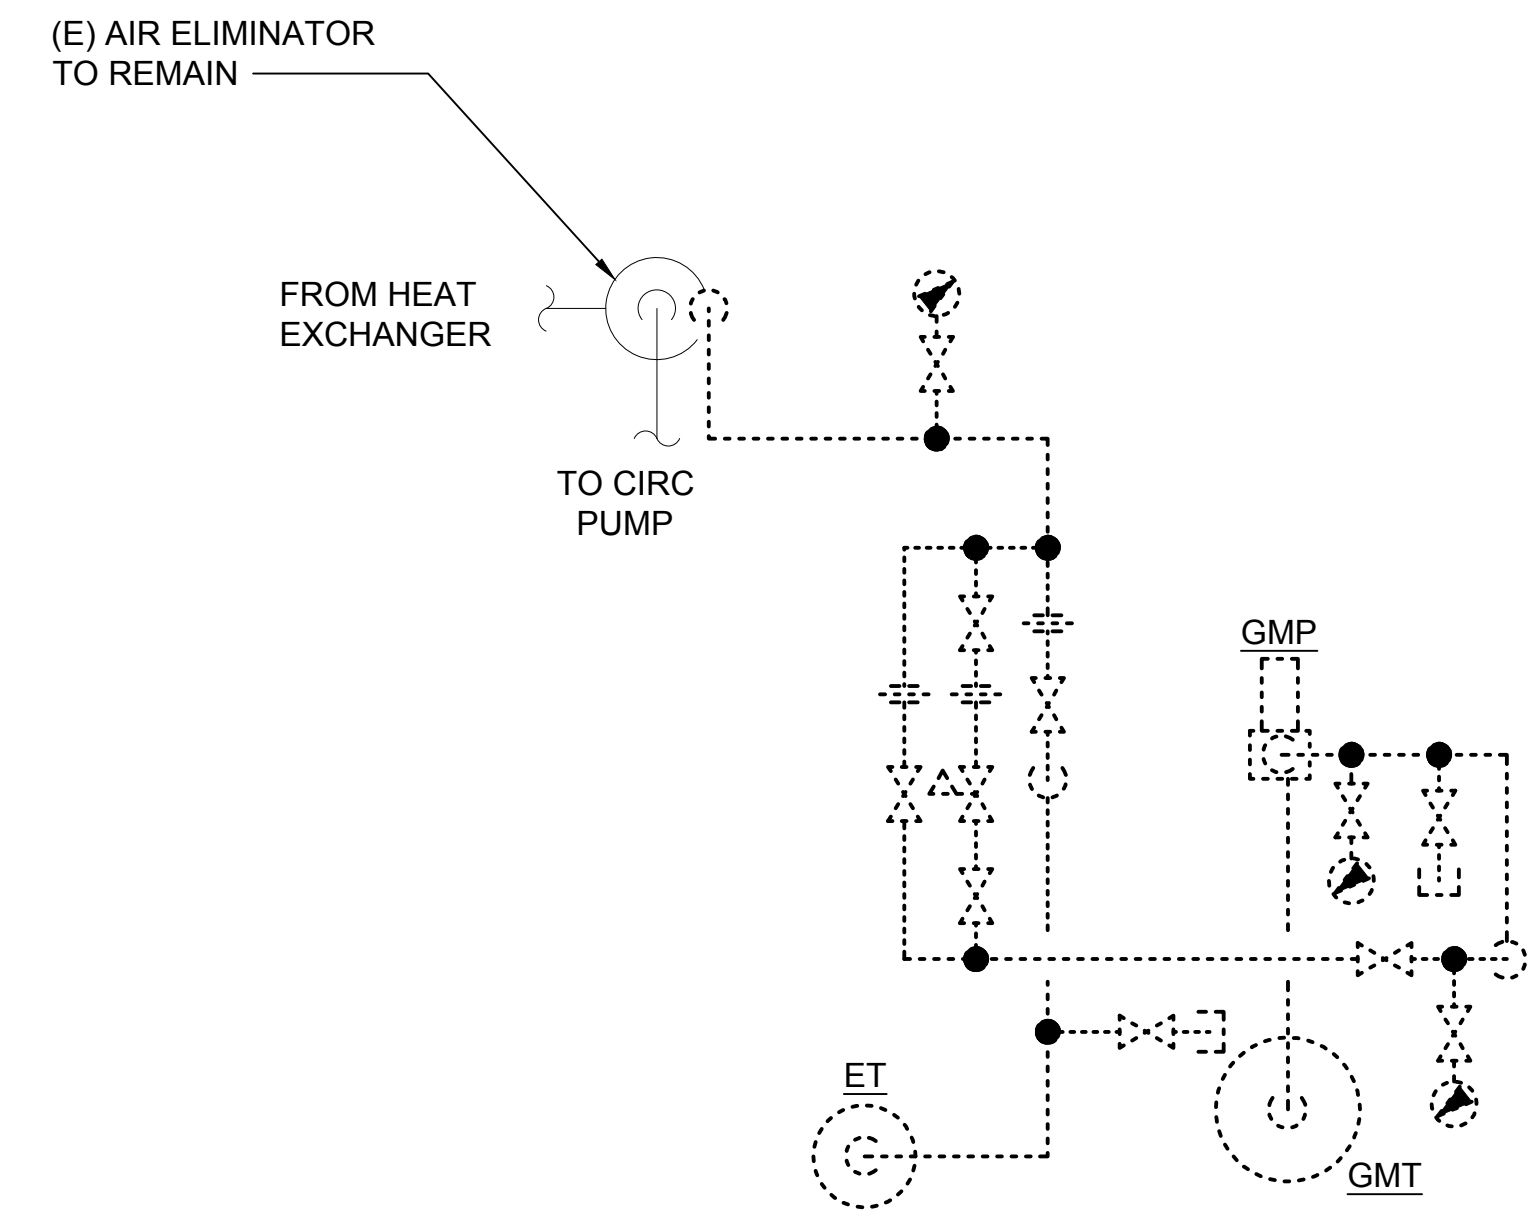

**3 GLYCOL MAKE-UP & EXPANSION TANK DEMOLITION PLAN**  
SCALE: NTS



FACILITIES SERVICES  
DESIGN & CONSTRUCTION  
P.O. BOX 758160  
FAIRBANKS, AK 99775-8160  
907-474-5299  
907-474-7554 (fax)  
www.uaf.edu/ddc

Consultant:

Stamp:

Project Phase:  
RECORD DRAWINGS  
Project Title:  
**UAF CTC BARNETTE  
PARKING GARAGE HEATING**

Sheet Contents:  
MECH ROOM 000U1  
PLAN AND DETAILS

DATE	REVISIONS:	BY:

DRAWN AMK/RCL  
CHECKED JVK/PMB  
DATE SEPTEMBER 20, 2018  
SCALE 0" = 1"

Project Number:  
D18032-CTCGH  
SHEET NO.

**M102**  
4 OF 6





**RECORD DRAWING**  
 THIS DRAWING HAS BEEN MODIFIED TO CONFORM TO AS-BUILT CONSTRUCTION CONDITION, ACCORDING TO REQUIREMENTS OF THE CONSTRUCTION CONTRACTOR, XACTA CONSTRUCTION CO., AND UNIVERSITY REPRESENTATIVE.  
 UNIVERSITY OF ALASKA FAIRBANKS FACILITIES SERVICES - DIVISION OF DESIGN AND CONSTRUCTION  
 SEPTEMBER 20, 2018

**GENERAL SHEET NOTES:**


- DO NOT SCALE DRAWINGS.
- PRIOR TO CONSTRUCTION FIELD VERIFY ALL DIMENSIONS.
- DRAWINGS ARE SOMEWHAT DIAGRAMATIC AND DO NOT SHOW ALL OFFSETS, BRANCH PIPING, CONFLICTS, ETC.



FACILITIES SERVICES  
 DESIGN & CONSTRUCTION  
 P.O. BOX 758160  
 FAIRBANKS, AK 99775-8160  
 907-474-5299  
 907-474-7554 (fax)  
 www.uaf.edu/ddc


Consultant:

Stamp:

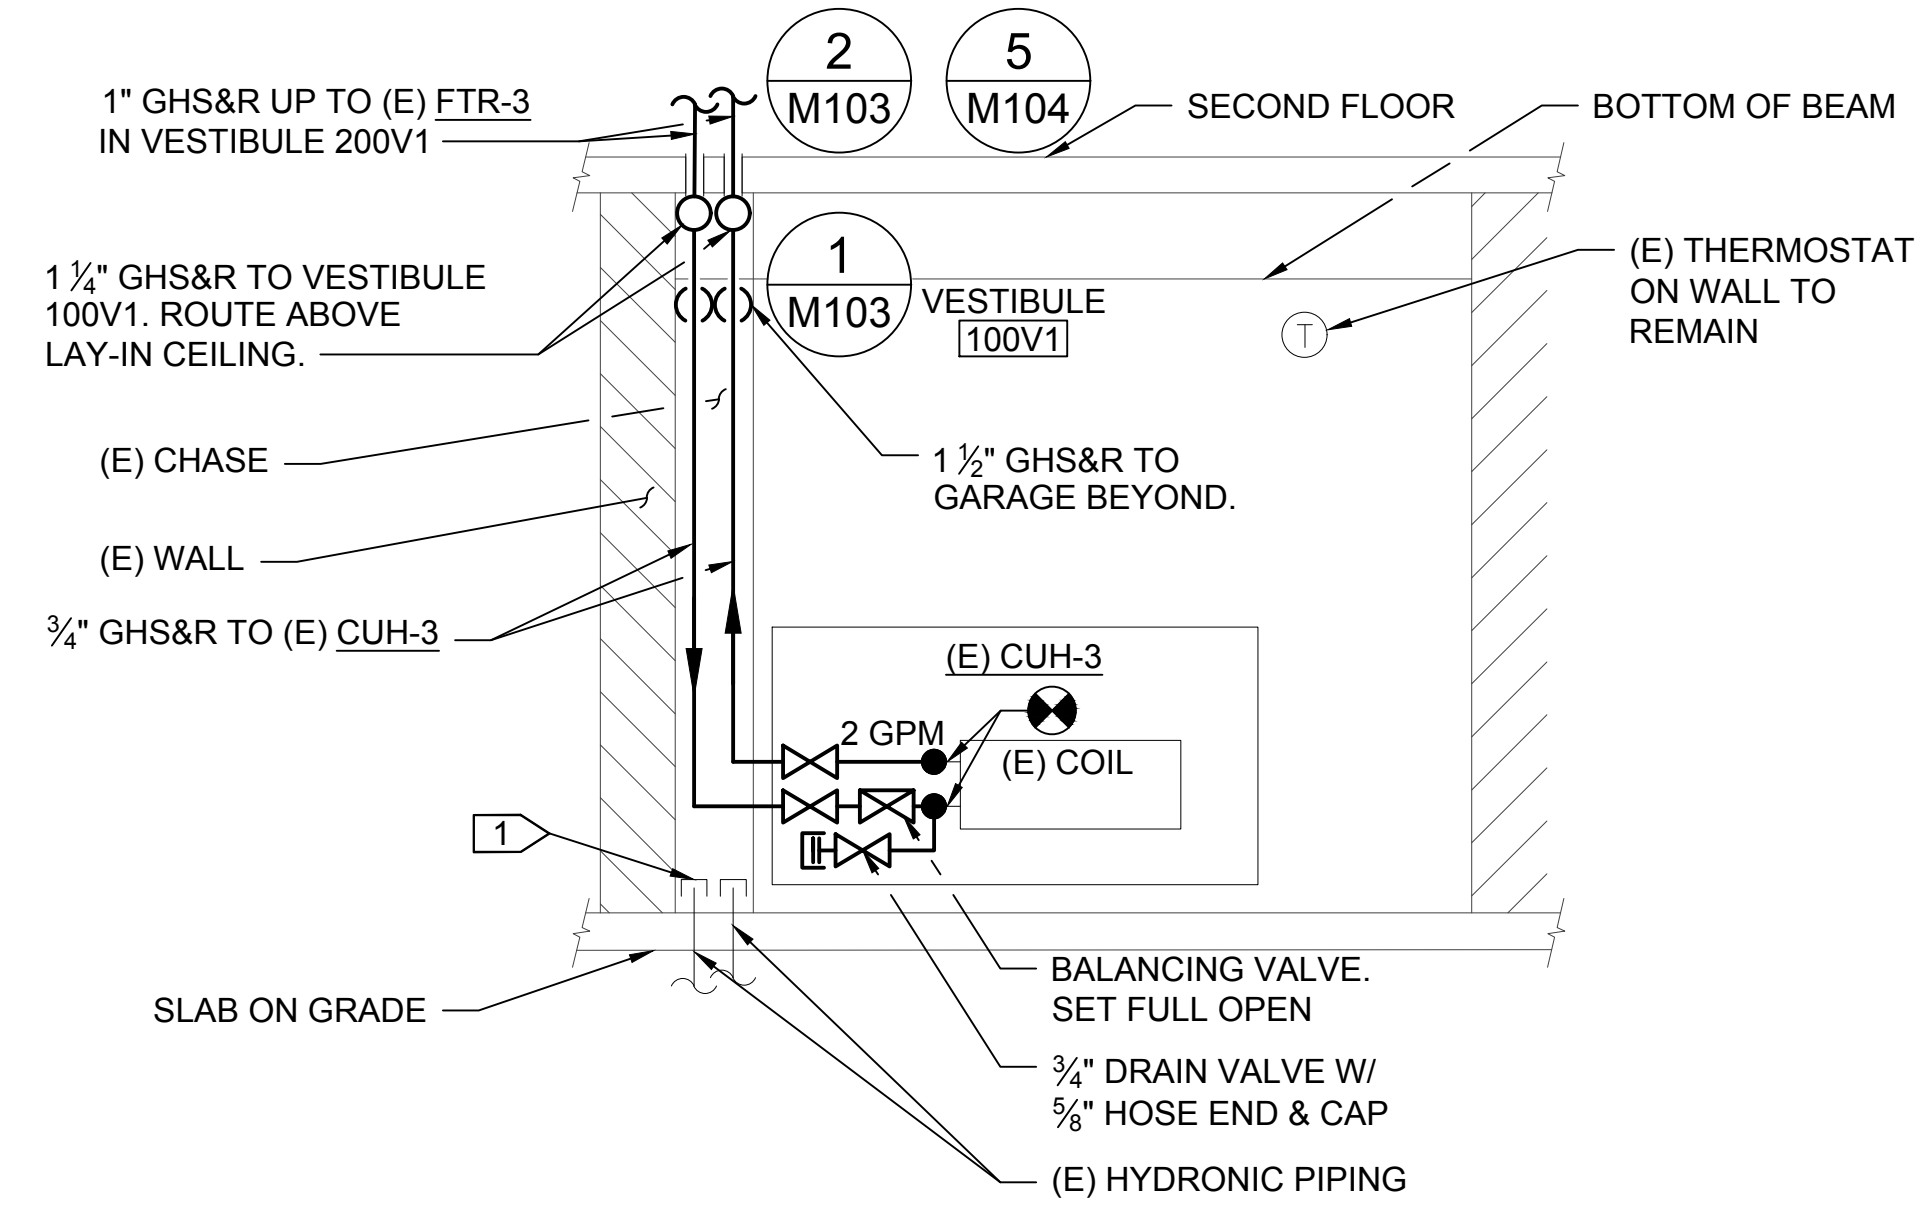


**SPECIFIC NOTES:**

- REMOVE (E) HYDRONIC PIPING ABOVE FLOOR TO (E) FTR-3 ABOVE. CAP/PLUG PIPING AT SLAB.

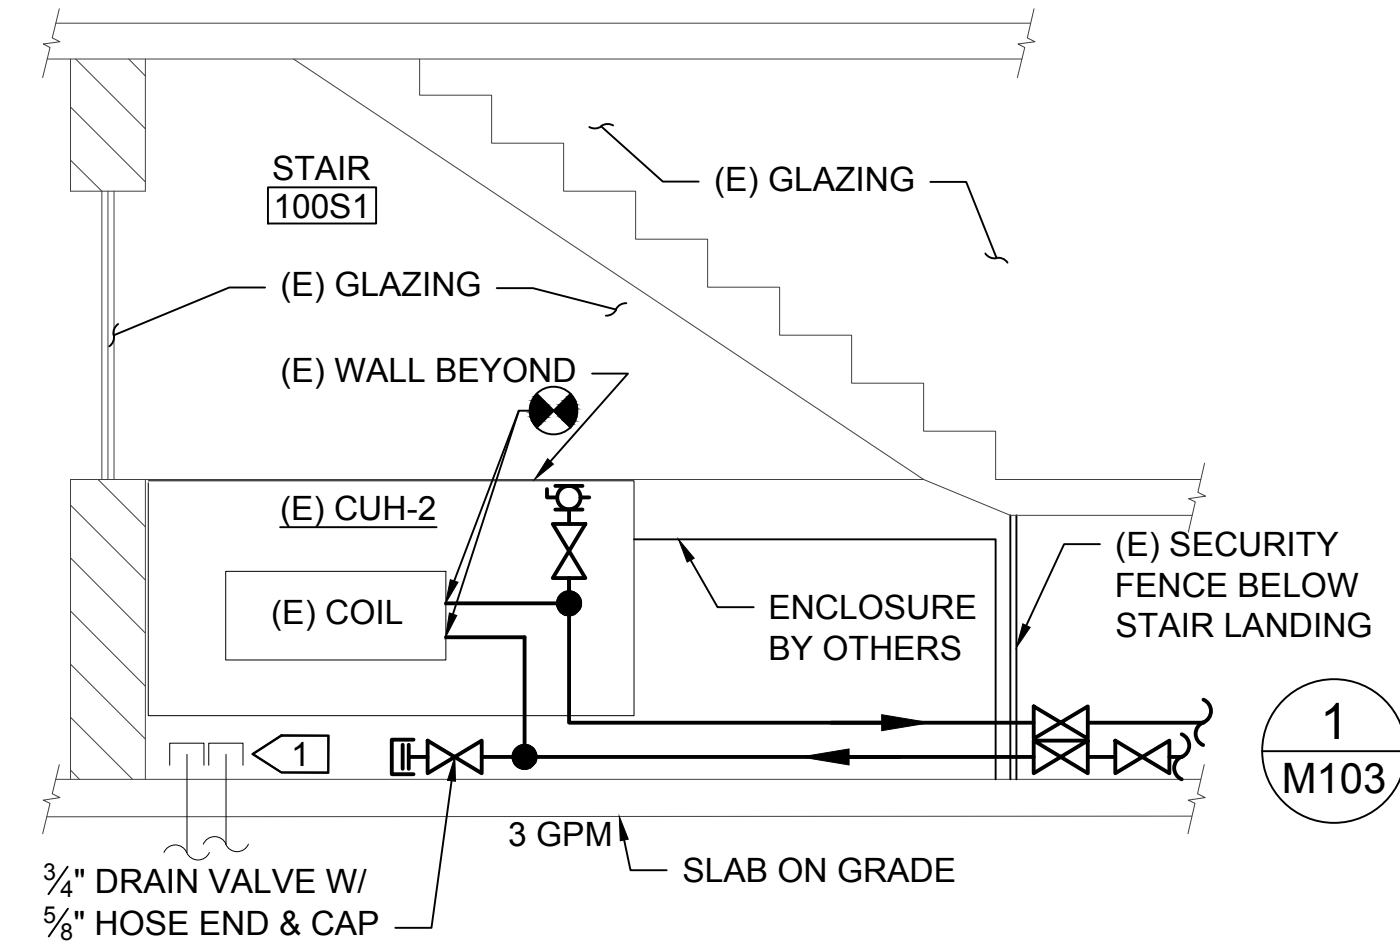

**SPECIFIC NOTES:**

- REMOVE (E) HYDRONIC PIPING ABOVE FLOOR TO (E) CUH-2. CAP/PLUG PIPING AT SLAB.

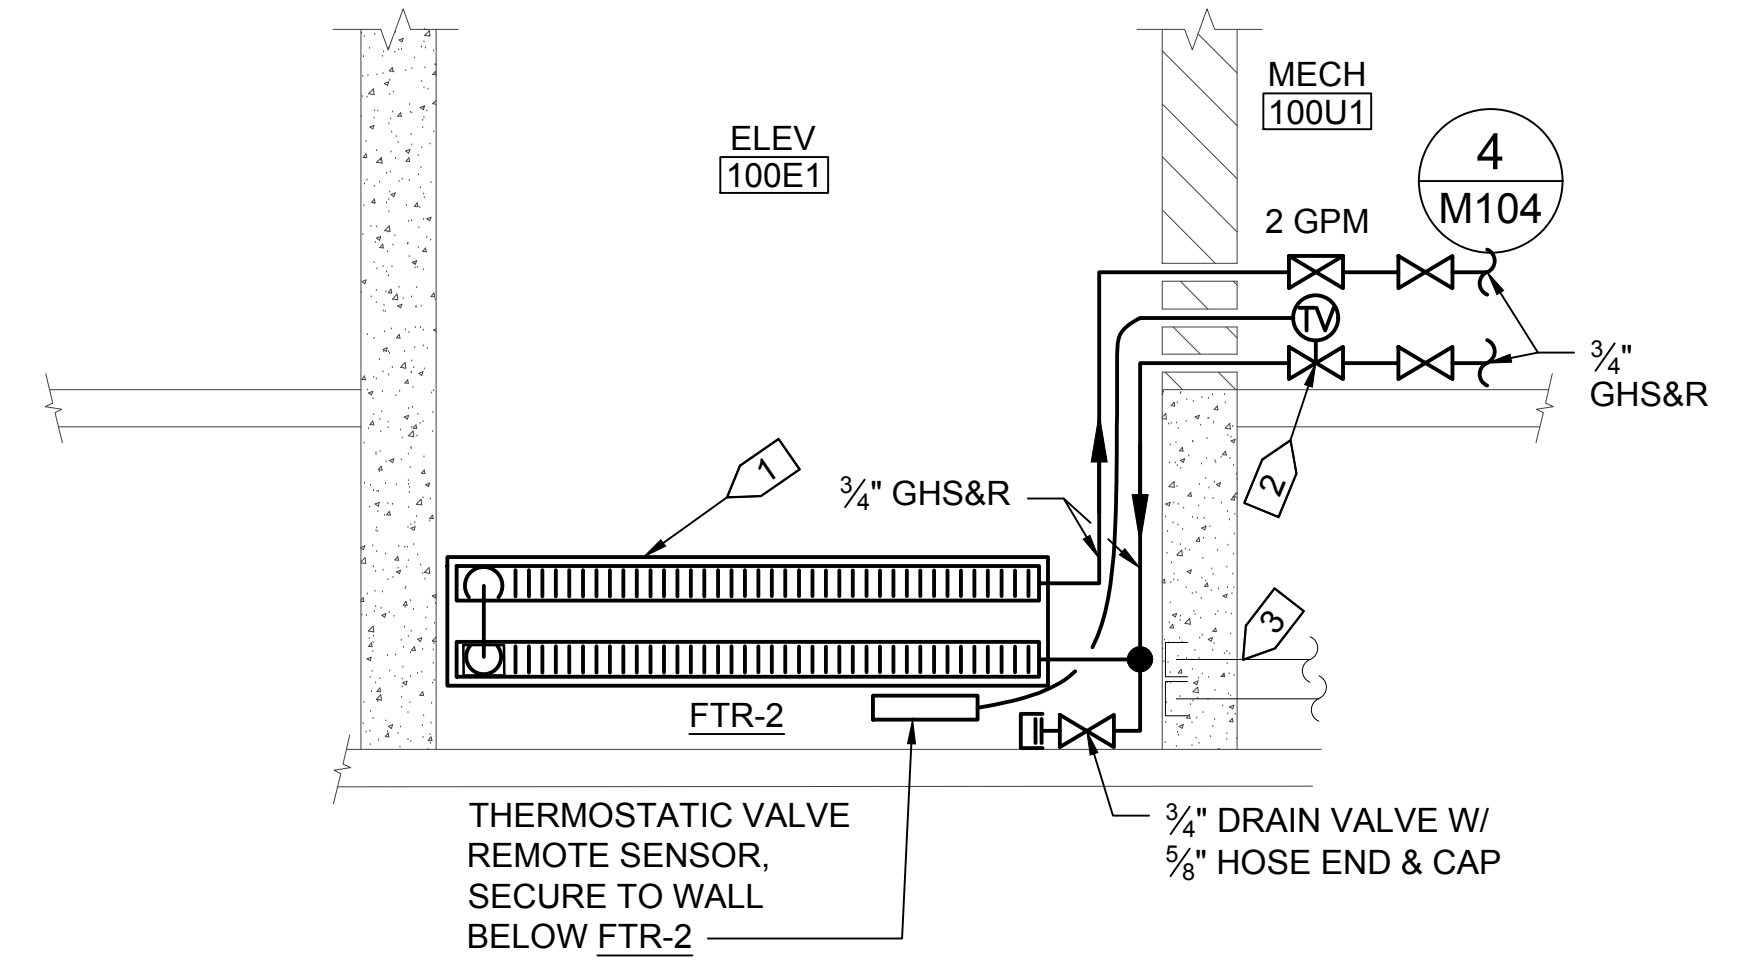

**SPECIFIC NOTES:**

- SUPPORT FINNED TUBE RADIATION ENCLOSURE AND PIPING FROM ADJACENT WALL WITH MANUFACTURER BRACKETS.
- 3/4" THERMOSTATIC CONTROL VALVE WITH REMOTE SENSOR
- REMOVE (E) FINNED TUBE RADIATION, SUPPORTS, ETC. CAP/PLUG PIPING AT WALL PENETRATION.

**1 CUH-3 PIPING DETAIL**


M104 SCALE: NTS

**2 CUH-2 PIPING DETAIL**

M104 SCALE: NTS


**3 ELEVATOR PIT FINNED TUBE RADIATION PIPING DETAIL**

M104 SCALE: NTS

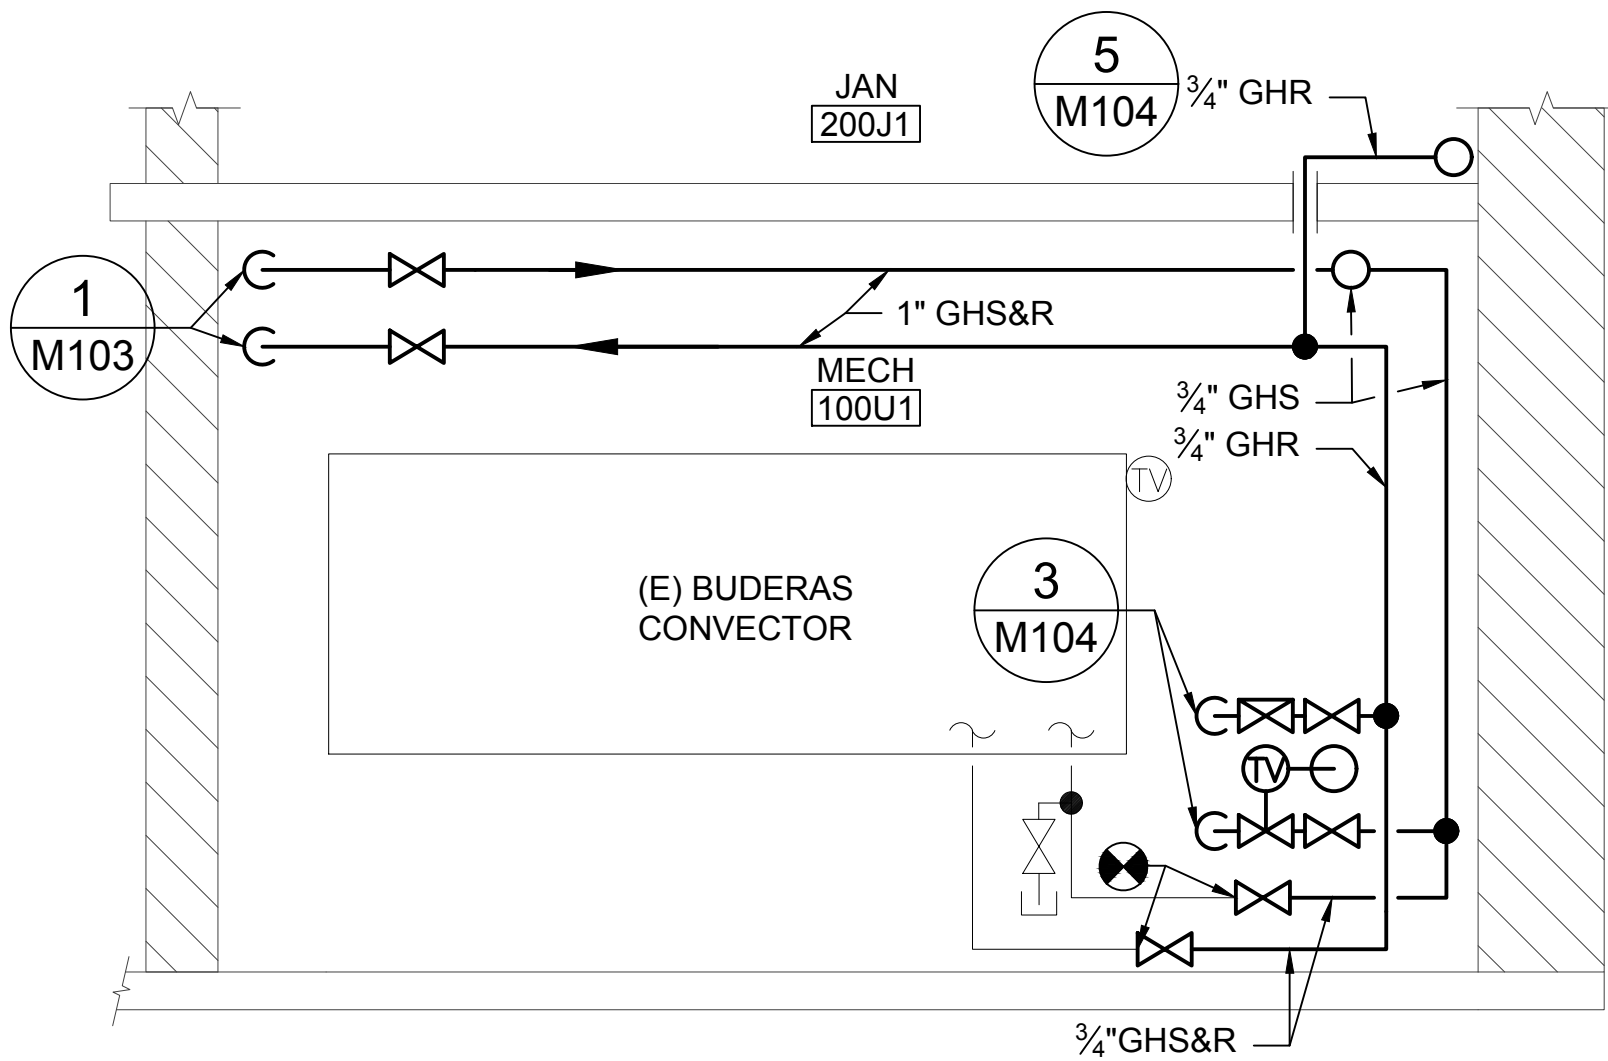

**4 MECH ROOM 100U1 PIPING DETAIL**

M104 SCALE: NTS

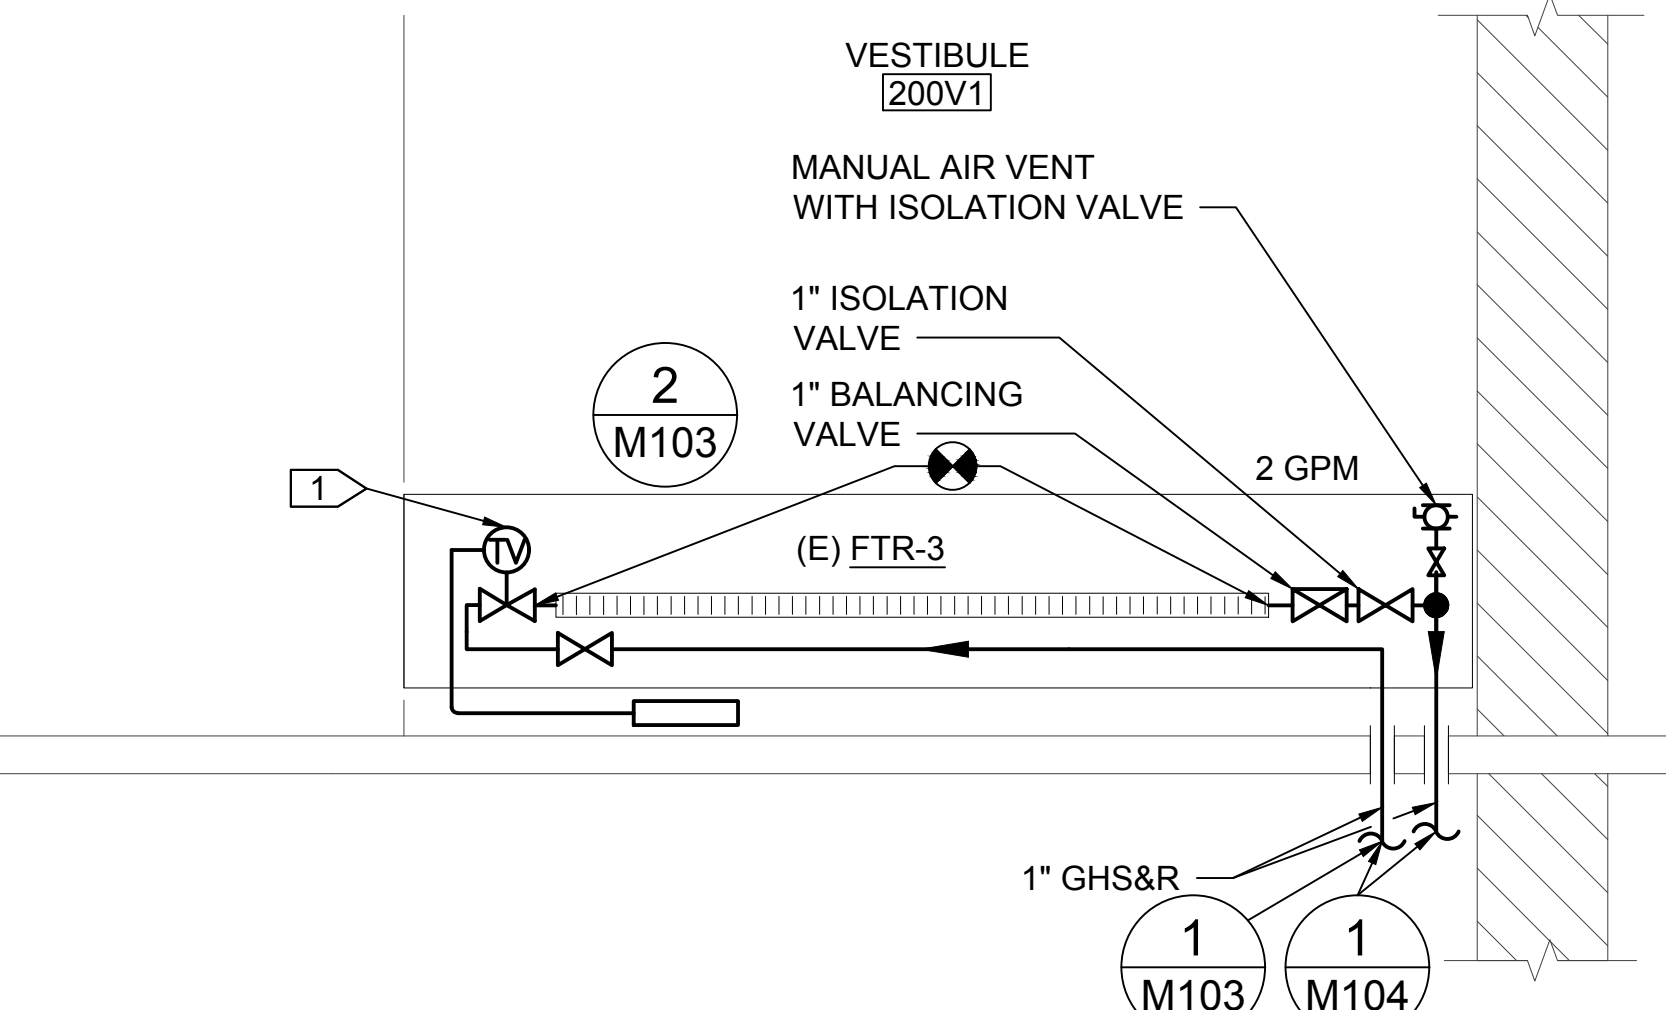


**SPECIFIC NOTES:**

- 3/4" THERMOSTATIC CONTROL VALVE WITH REMOTE SENSOR SECURED TO WALL BELOW (E) FTR-3.

**5 VESTIBULE 200V1 PIPING DETAIL**

M104 SCALE: NTS

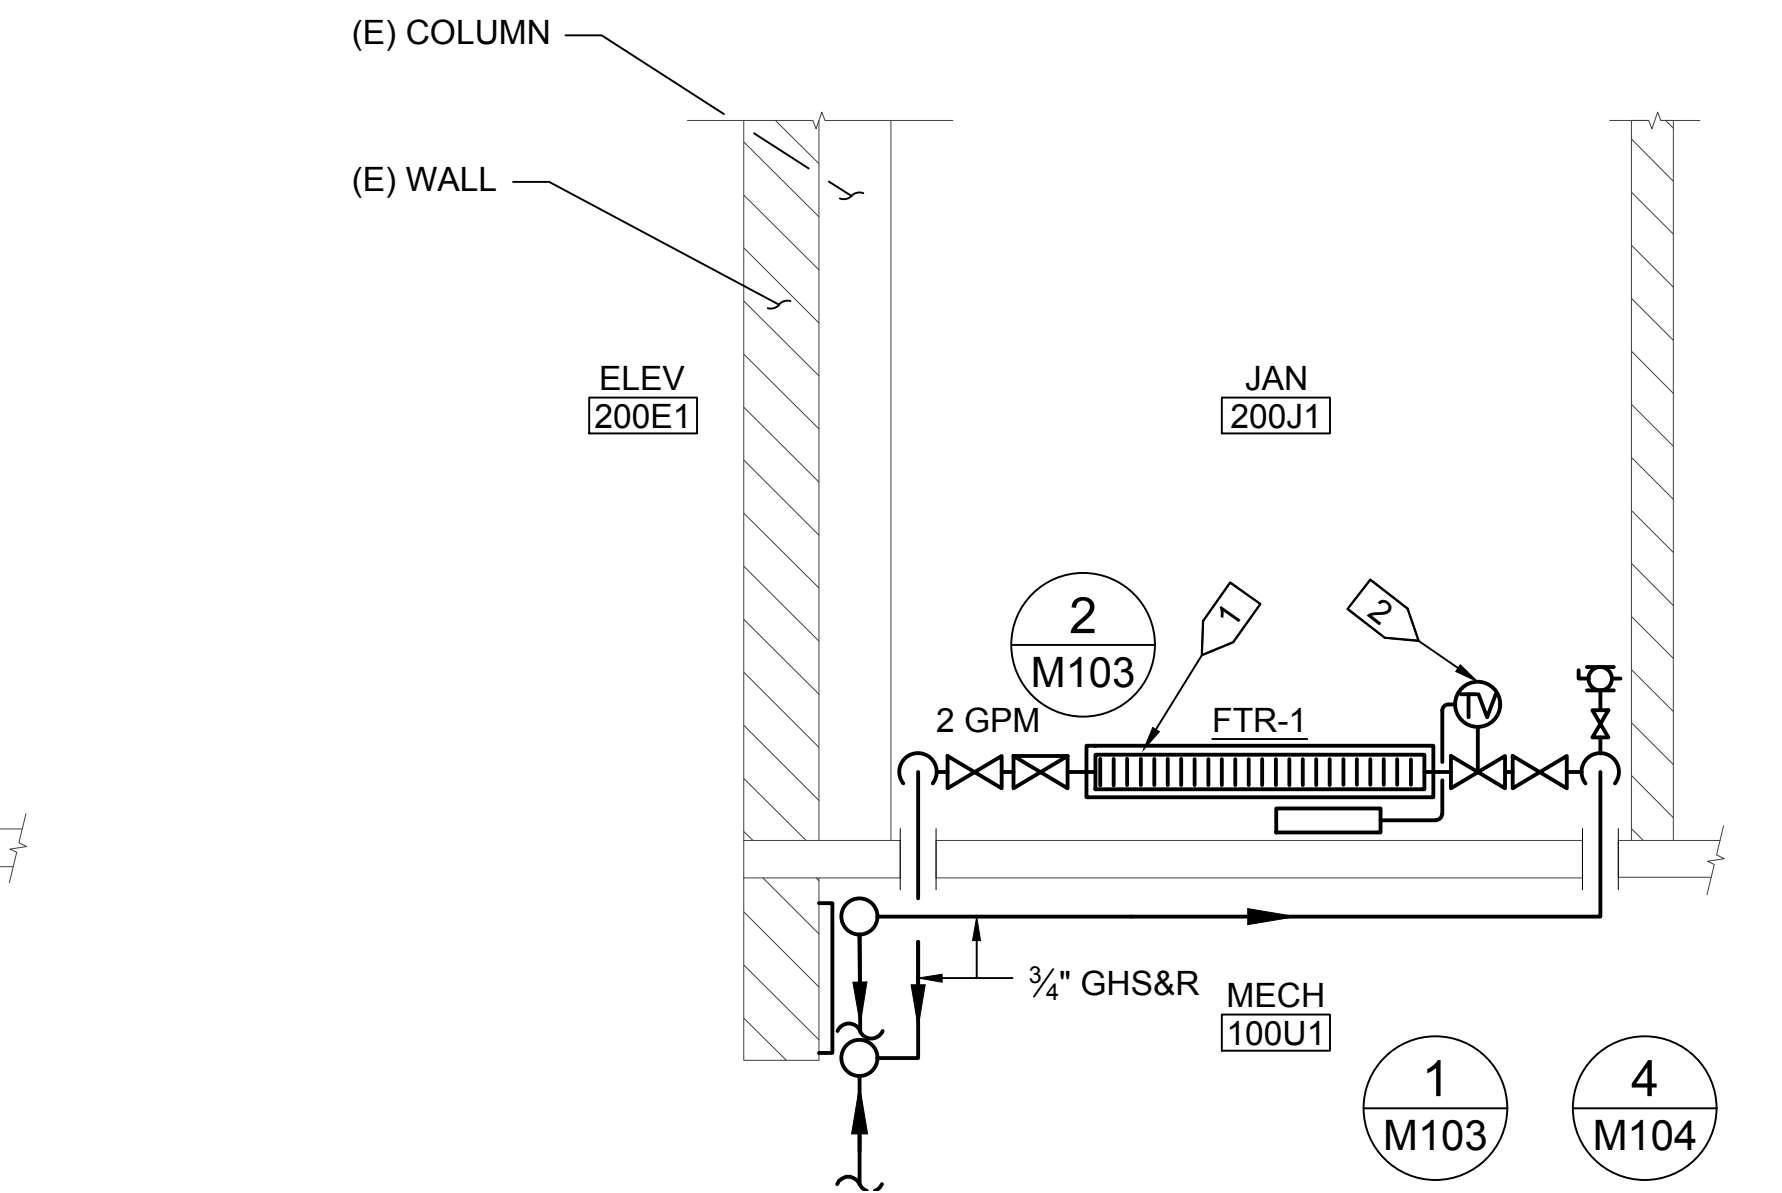

**SPECIFIC NOTES:**

- SUPPORT FINNED TUBE RADIATION ENCLOSURE AND PIPING FROM ADJACENT WALL WITH MANUFACTURER BRACKETS.
- 1/2" THERMOSTATIC CONTROL VALVE WITH REMOTE SENSOR SECURED TO WALL BELOW FTR-1.

**6 JANITOR 200J1 PIPING DETAIL**

M104 SCALE: NTS

Project Phase:  
 RECORD DRAWINGS  
 Project Title:  
**UAF CTC BARNETTE  
 PARKING GARAGE HEATING**

Sheet Contents:  
**DETAILS**

DATE	REVISIONS:	BY:

DRAWN AMK/RCL  
 CHECKED JVK/PMB  
 DATE SEPTEMBER 20, 2018  
 SCALE 0"=1"  
 Project Number:  
**D18032-CTCGH**  
 SHEET NO.

**M104**  
 6 OF 6



SPECIFICATIONS:

SECTION 23 02 00 - COMMON SUBMITTAL REQUIREMENTS

- 1. OWNER HAS PROVIDED FORMAT FOR ITEM DATA SHEETS AND SUBMITTAL REGISTER. REFER TO SCOPE OF WORK.
- 2. PROVIDE ONE ITEM DATA SHEET FOR EACH ITEM SUBMITTED.
- 3. SUBMITTAL INFORMATION IS REQUIRED FOR ALL MATERIAL AND EQUIPMENT INDICATED ON THE SUBMITTAL REGISTER, SPECIFIED OR INDICATED ON THE DRAWINGS.

SECTION 23 05 00 - COMMON WORK RESULTS

- 1. PROVIDE THE OWNER WITH A COMPLETE, OPERATING, TESTED SYSTEM.
- 2. THE DRAWINGS ARE SOMEWHAT DIAGRAMMATIC AND DO NOT ATTEMPT TO SHOW ALL OFFSETS OR FITTINGS REQUIRED FOR INSTALLATION OF THE MECHANICAL SYSTEM. FURNISH AND INSTALL PIPES WITH FITTINGS REQUIRED FOR COMPLETE AND PROPER INSTALLATION OF MECHANICAL SYSTEMS SPECIFIED OR REQUIRED UNDER THIS DIVISION.
- 3. DO NOT SCALE THE MECHANICAL DRAWINGS. VERIFY DIMENSIONS AS THE CONSTRUCTION PROGRESSES.
- 4. COORDINATE THE INSTALLATION OF THE MECHANICAL SYSTEMS WITH EXISTING CONDITIONS.
- 5. REPORT ANY ERRORS, DISCREPANCIES, OR AMBIGUITIES TO THE OWNER, WHO WILL ANSWER ALL QUESTIONS AND INTERPRET INTENDED MEANING OF THESE DOCUMENTS. ACCEPT OWNER INTERPRETATION AS FINAL.
- 6. PERFORM WORK IN A NEAT AND WORKMANLIKE MANNER WITH SKILLED CRAFTSMEN SPECIALIZING IN SAID WORK.
- 7. MAINTAIN CONSTRUCTION AREA IN CLEAN CONDITION. REMOVE TRASH DAILY. THOROUGHLY CLEAN CONSTRUCTION AREA PRIOR TO PROJECT COMPLETION.
- 8. REPLACE EXISTING MECHANICAL INSULATION THAT IS REMOVED TO ACCOMPLISH WORK WITH NEW INSULATION TO MATCH EXISTING.

SECTION 23 05 10 - COMMON WORK RESULTS FOR HVAC PIPING

- 1. DIELECTRIC PIPE TAPE: WESTAPE, CALPICO, 3M OR EQUAL. WHERE PLACED IN CONTACT WITH DISSIMILAR METAL OR CONCRETE, PROTECT COPPER PIPE WITH MINIMUM 2 WRAPS OF SELF-ADHESIVE DIELECTRIC PIPE TAPE.
- 2. TYPE 'M' HARD COPPER TUBING WITH WROUGHT COPPER SOLDER FITTINGS AND LEAD FREE SOLDER.
- 3. MECHANICAL CONNECTORS SUCH AS PROGRESS, SHARKBITE, ETC. ARE NOT ALLOWED.
- 4. DIELECTRIC FITTINGS ARE NOT ALLOWED.
- 5. AIR VENTS AND AIR VENT ISOLATION VALVES: MANUAL AIR VENTS - B&G NO. 4V OR EQUAL. AIR VENT ISOLATION VALVES - BRONZE BODY, TEFLON SEATS, VITON O-RING STEM SEAL, CHROME PLATED BALL, NON-BLOWOUT STEM. JOMAR T-82 MINI OR EQUAL. PROVIDE WHERE INDICATED.
- 6. BALANCING VALVES: B&G CIRCUIT SETTER PLUS, ARMSTRONG CBV, TACO ACCU-FLOW, T&A HYDRONICS, OR EQUAL. PROVIDE WHERE INDICATED.
- 7. THERMOSTATIC CONTROL VALVE WITH REMOTE SENSOR: CONFORMING TO ASHRAE / ANSI STANDARD 102-1983. DANFOSS RA-2000 OR EQUAL. VALVE MOUNTED DIAL WITH REMOTE SENSOR, CODE NO. 013G8252, WITH STRAIGHT OR SIDE MOUNT ANGLE VALVE AS REQUIRED. SIZE AS INDICATED. PROVIDE WHERE INDICATED.
- 8. FINNED TUBE RADIATION: SEE DRAWING M103, FINNED TUBE RADIATION SCHEDULE, FOR BASIS OF DESIGN OR EQUAL.
- 9. FIRESTOPPING: TO THE EXTENT POSSIBLE, UTILIZE THE PRODUCTS OF ONLY ONE MANUFACTURER. METALINES, DOW, STI, 3M, HILTI, OR EQUAL. WITH SUBMITTAL PROVIDE MANUFACTURER'S LISTED INSTALLATION INSTRUCTIONS FOR EACH SYSTEM USED. WHERE PIPING RISES FROM FIRST FLOOR TO SECOND FLOOR, UTILIZE EXISTING PIPE SLEEVES/PENETRATIONS, PACK WITH MINERAL WOOL AND APPLY FIRE STOPPING TO UPPER SIDE OF PENETRATION. WHERE PIPING PENETRATES COLD WALLS, FROM THE PARKING GARAGE INTO MECH RM AND FROM THE PARKING GARAGE INTO VESTIBULE 100V1, EXTEND WARM SIDE INSULATION FULL SIZE THROUGH THE WALL AND APPLY FIRESTOPPING. WHERE PIPING PENETRATES WARM WALLS IN THE STAIR TOWER AND ELEVATOR ROOMS RUN BARE PIPING THROUGH WALLS AND APPLY FIRESTOPPING.

- 10. MAKE ALL CONNECTIONS DIRECTLY TO EQUIPMENT. UNIONS ARE NEITHER REQUIRED, NOR DESIRED.
- 11. REAM PIPES THOROUGHLY AND CLEAN BEFORE INSTALLATION. MAKE EVERY ATTEMPT TO KEEP NEW AND EXISTING HYDRONIC PIPING CLEAN AND FREE OF FOREIGN MATERIALS AND DEBRIS.
- 12. OWNER WILL DRAIN AND REFILL HYDRONIC SYSTEM. NOTIFY OWNER OF NEED FOR HYDRONIC SYSTEM DRAIN AND REFILL MINIMUM THREE WORKING DAYS PRIOR TO WORK.
- 13. SYSTEM FLUSH WILL NOT BE REQUIRED.
- 14. PERFORM AIR PRESSURE TEST AT TWO TIMES SYSTEM NORMAL OPERATING PRESSURE, 60 PSI, FOR 12 HOURS WITH NO PRESSURE DROP. OWNER TO WITNESS TEST. CONTRACTOR WILL BE RESPONSIBLE FOR REPAIR OF ALL LEAKS IDENTIFIED IN NEW PIPING AND CONNECTIONS TO EXISTING.
- 15. OWNER WILL BALANCE HYDRONIC SYSTEM. SET ALL BALANCE VALVES TO FULL OPEN POSITION.

SECTION 23 05 23 - GENERAL DUTY VALVES

- 1. STANDARDIZE ON ONE MAKE OF VALVE. APOLLO, MILWAUKEE, NIBCO OR EQUAL.
- 2. PROVIDE BALL VALVES ONLY, GATE VALVES ARE NOT ALLOWED.
- 3. ISOLATION VALVES: ASME CLASS 125, FULL PORT, TWO PIECE, BRONZE BODY WITH BRASS INTERNALS, CHROME PLATED OR STAINLESS STEEL BALL, REINFORCED TEFLON SEATS AND SEALS, NON-BLOWOUT STEM. NIBCO S585-70 IS THE BASIS OF DESIGN.
- 4. PROVIDE WHERE INDICATED ON THE DRAWINGS.

SECTION 23 05 29 - HANGERS AND SUPPORTS

- 1. PROVIDE FACTORY STANDARD HANGERS AND SUPPORTS COMPLETE WITH NECESSARY INSERTS, BOLTS, NUTS, RODS, WASHERS, AND OTHER ACCESSORIES.
- 2. COPPER PIPE HANGERS: SWIVEL LOOP STYLE CARBON STEEL, EPOXY COATED, COPPER COLORED. TOLCO FIGURE 202 OR EQUAL.
- 3. HANGER ROD: ELECTRO-GALVANIZED CARBON STEEL. TOLCO FIGURE 100 OR EQUAL.
- 4. CHANNEL STRUT: ZINC PLATED ELECTROSTATICALLY. UNISTRUT, ERICO CADDY, POWER STRUT OR EQUAL.
- 5. PLACE HANGERS OR SUPPORTS IN DIRECT CONTACT WITH PIPE. SEE SPECIFICATION SECTION 23 07 00, INSULATION, TO ADDRESS INSULATION WHERE PENETRATED BY HANGERS OR SUPPORTS.
- 6. SUPPORT PIPING IN ACCORDANCE WITH 2015 UMC.

SECTION 23 05 53 - IDENTIFICATION

- 1. PIPE MARKERS: PRESSURE SENSITIVE IDENTIFICATION MARKERS SECURED WITH COLOR CODED TAPE INCORPORATING DIRECTION OF FLOW ARROWS. SETON NAME PLATE CORP., BRADY, BRIMAR OR EQUAL.
- 2. PROVIDE PIPE LABELING ON GLYCOL HEATING SUPPLY AND RETURN (GHS&R) COLORED AND LETTERED IN ACCORDANCE WITH ANSI A13.1 ("SCHEME FOR THE IDENTIFICATION OF PIPING SYSTEMS").
- 3. PROVIDE PIPE LABELING SO THAT IT CAN BE EASILY READ FROM SIDE OR BELOW AND SECURED AT EACH END WITH TWO WRAPS OF "ARROWS ON A ROLL".
- 4. LABEL ONLY THAT PIPING IN MECHANICAL ROOM 000U1 AND THE HEATED AREA OF THE SOUTHWEST STAIR TOWER. LABELING IS NOT REQUIRED ON METAL JACKETED HYDRONIC PIPING IN THE PARKING GARAGE COLD SPACE.

SECTION 23 07 00 - INSULATION

- 1. INSULATION THICKNESS: MECH ROOM 000U1 - 2 INCHES, PARKING GARAGE - 3 INCHES, ALL OTHER LOCATIONS - 1 INCH.
- 2. WHERE INSULATION JACKET IS CUT OR PENETRATED BY PIPE HANGERS OR SUPPORTS, OR WHERE INSULATION IS CUT AND EXPOSED, FILL VOIDS FLUSH TO VAPOR RETARDER JACKET WITH INSULATING CEMENT AND SEAL WITH THERMAL INSULATION COATING.
- 3. INSULATION: FIBERGLAS PIPE INSULATION: OWENS/CORNING FIBERGLASS 25 ASJ, JOHNS-MANVILLE MICRO-LOCK 650 WITH AP-T SELF-SEALING JACKET, KNAUF ASJ, OR EQUAL.

- 4. INSULATING CEMENT: MINERAL FIBER BASE WITH MAXIMUM OF 0.90 (BTU-INCH)/(SQUARE FOOT-HOUR-FAHRENHEIT) CONDUCTIVITY AT 200 DEGREES FAHRENHEIT MEAN TEMPERATURE.
- 5. THERMAL INSULATION COATING: WASHABLE, ABRASION RESISTANT COATING FOR THERMAL INSULATION. MINIMUM CONTINUOUS SERVICE RATING OF 180 DEGREES FAHRENHEIT. FOSTER #30-36 SEALFAS, MEI #11-02, OR EQUAL.
- 6. PREFORMED PLASTIC INSULATION COVERS AND INSERTS FOR WARM SPACES: PVC WITH FIBERGLASS INSERTS PROVIDED BY COVER MANUFACTURER. ACCEPTABLE MANUFACTURERS ARE JOHNS-MANVILLE ZESTON, FULLER SPEEDLINE, PROTO.
- 7. INSULATION JACKET FOR PARKING GARAGE: ALUMINUM JACKET - 0.016 INCH THICK, EMBOSSED. PROVIDE ALUMINUM JACKET OVER INSULATION WITH SEAMS LAPPED AND SEALED TO PROVIDE WATER TIGHT INSTALLATION. NOTCH JACKET CLOSELY WHERE PENETRATED BY HANGER RODS OR CHANNEL STRUT. SECURE WITH 1/2 INCH WIDE STAINLESS STEEL BANDS AT 9 INCH CENTERS. AT FITTING OR OTHER LOCATIONS WHERE BANDS CANNOT BE USED, SECURE JACKET WITH GALVANIZED ZINC PLATED SCREWS AT 4 INCH CENTERS ALONG SEAMS. FILL ANY VOIDS WITH INSULATING CEMENT.



FACILITIES SERVICES  
 DESIGN & CONSTRUCTION  
 P.O. BOX 758160  
 FAIRBANKS, AK 99775-8160  
 907-474-5299  
 907-474-7554 (fax)  
 www.uaf.edu/ddc

Consultant:

Stamp:

Project Phase:  
 RECORD DRAWINGS  
 Project Title:  
**UAF CTC BARNETTE  
 PARKING GARAGE HEATING**

Sheet Contents:  
**SPECIFICATIONS**

DATE	REVISIONS:	BY:
DRAWN	AMK	
CHECKED	JVK/PMB	
DATE	SEPTEMBER 20, 2018	
SCALE	0"=1"	
Project Number:	D18032-CTCGH	
SHEET NO.	M105	

