

FAIRBANKS PARKING STRUCTURE


STATE OF ALASKA
DEPARTMENT OF PUBLIC WORKS
DIVISION OF BUILDINGS
JUNEAU, ALASKA

DBA-2-0130

**GRAY
ROGERS
MYERS &
PORGAN**
A DIVISION OF ELLERBE

SCHEDULE OF DRAWINGS

SHEET NO.	TITLE	SHEET NO.	TITLE	SHEET NO.	TITLE
CIVIL					
C-1	SITE PLAN				
C-2	GRADING PLAN				
ARCHITECTURAL					
A-1	LEVELS L (LOWER), & I FLOOR PLANS				
A-2	LEVEL 2 FLOOR PLAN				
A-3	LEVEL R (ROOF) FLOOR PLAN & SIGN SCHEDULE				
A-4	EXTERIOR ELEVATIONS				
A-5	BUILDING SECTIONS				
A-6	INTERIOR ELEVATIONS				
A-7	STAIRS No. 1 & No. 2				
A-8	SECTIONS, STAIR No. 1				
A-9	STAIR No. 3 & DETAILS				
A-10	ELEVATOR HOISTWAY SECTIONS & STAIR DETAILS				
A-11	INSULATED METAL WALL DETAILS				
A-12	INSULATED METAL WALL DETAILS & MISC. DETAILS				
A-13	MISC. DETAILS				
A-14	DOOR SCHEDULE & DETAILS				
A-15	DOOR & WINDOW DETAILS				
A-16	WALL SECTIONS & DETAILS				
A-17	WALL SECTIONS				
STRUCTURAL					
S-1	TYPICAL DETAILS AND GENERAL STRUCTURAL NOTES				
S-2	FOUNDATION PLAN AND LEVEL I FLOOR PLAN				
S-3	STAIRS NO 2 & 3 - PLANS & SECTION				
S-4	LEVEL 2 & LEVEL R (ROOF) FLOOR PLANS				
S-5	STAIR No. 1 AND No. 2 PLANS AND DETAILS				
S-6	STAIR No. 1 SECTIONS AND DETAILS				
S-7	FOUNDATION DETAILS				
S-8	STRUCTURAL DETAILS				
S-9	PENTHOUSE FRAMING PLANS AND DETAILS				
S-10	BEAM AND COLUMN SCHEDULE AND DETAILS				
S-11	SHEAR WALL ELEVATIONS AND DETAILS				
S-12	SHEAR WALL ELEVATIONS				
S-13	SHEAR WALL ELEVATIONS				
S-14	POST-TENSION DETAILS				
S-15	PRECAST GIRDERS AND CONVENTIONAL REINFORCED SLAB DETAILS				
MECHANICAL					
M-1	PLOT PLAN				
M-2	FOUNDATION PLAN & DETAILS				
M-3	LEVEL 1 PLAN AND DETAILS				
M-4	LEVEL 2 PLAN AND DETAILS				
M-5	LEVEL R (ROOF) AND DETAILS				
M-6	DETAILS				
M-7	SECTIONS				
M-8	SCHEDULES AND DETAILS				
M-9	DETAILS				
M-10	LEVEL L (LOWER) MECHANICAL ROOM PLANS				
ELECTRICAL					
E-1	ELECTRICAL LIGHTING, POWER AND SIGNAL - LEVEL L (LOWER), AND LEVEL I FLOOR PLANS				
E-2	ELECTRICAL LIGHTING, POWER AND SIGNAL - LEVEL 2 AND LEVEL R (ROOF) FLOOR PLANS				
E-3	ELECTRICAL SIGNAL RISERS AND DETAILS				
E-4	ELECTRICAL PANELBOARD SCHEDULES, ONE LINE DIAGRAM, MISCELLANEOUS				

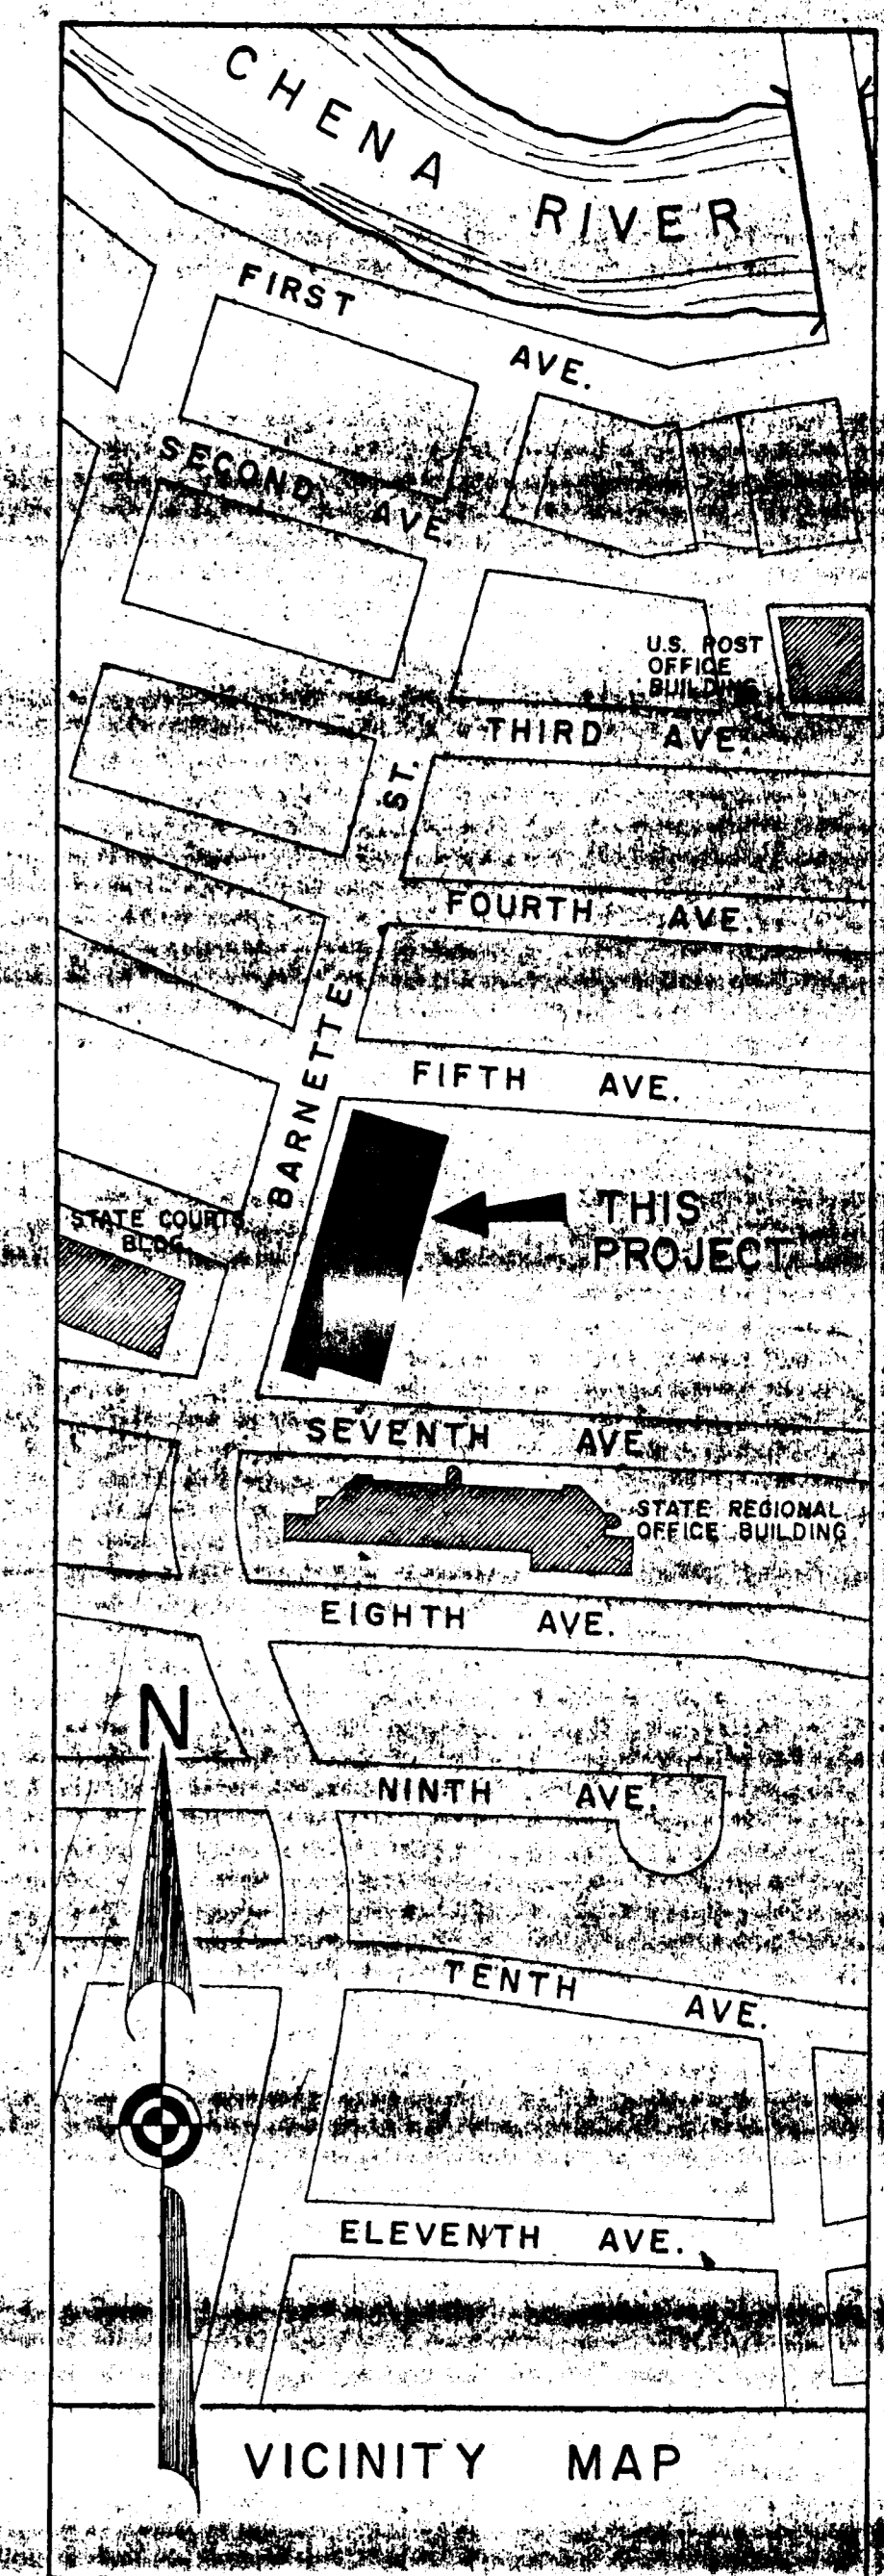

SEYED BROTHERS CO.
FAIRBANKS, ALASKA

RECOMMENDED BY:
W. H. [Signature]

CONTRACTOR'S NO. _____

DATE _____

AS-BUILT



THESE DRAWINGS HAVE BEEN
MODIFIED AS BUILT

GRAY ROGERS MYERS & TORGAN

A DIVISION OF ELLERBE

- LEGEND**
- CONCRETE RAMPS & SIDEWALKS THIS PROJECT
 - COMPACTED MATERIAL FROM EXCAVATION
 - (E) EXISTING
 - T.C. THIS CONTRACT
 - TEST HOLE LOCATION
 - TEMPORARY CONSTRUCTION FENCE

- NOTES**
1. LOGS OF TEST HOLES AVAILABLE AT OFFICE & AT DIVISION OF BUILDINGS OFF FAIRBANKS, ANCHORAGE & JUNEAU.
 2. SEE SHEET M-1 FOR UNDERGROUND UTILITIES.
 3. ALL ABANDONED UNDERGROUND HOUSE WIRING OR UTILITIES NOT DESIGNATED ARE TO BE REMOVED TO THE EXTENT THEY INTERFERE WITH CONTRACT WORK. VEI UTILITIES ARE ABANDONED WITH ARCHITECT CITY OF FAIRBANKS PRIOR TO REMOVAL.
 4. ALL SALVAGED MATERIAL TO BE TURNED OVER TO CITY OF FAIRBANKS @ CITY PUBLIC WORKS GARAGE.
 5. CONSTRUCTION FENCE TO BE MINIMUM HIGH LIGHT GAGE CHAIN LINK FENCE. TO BE CONTRACTORS PROPERTY AT END OF PROJECT.
 6. ALL AREAS ADJACENT TO THIS GARAGE NOT RECEIVING CONCRETE OR CURB ROCK BASE SHALL BE FILLED & COMPACTED MATERIAL FROM EXCAVATION.

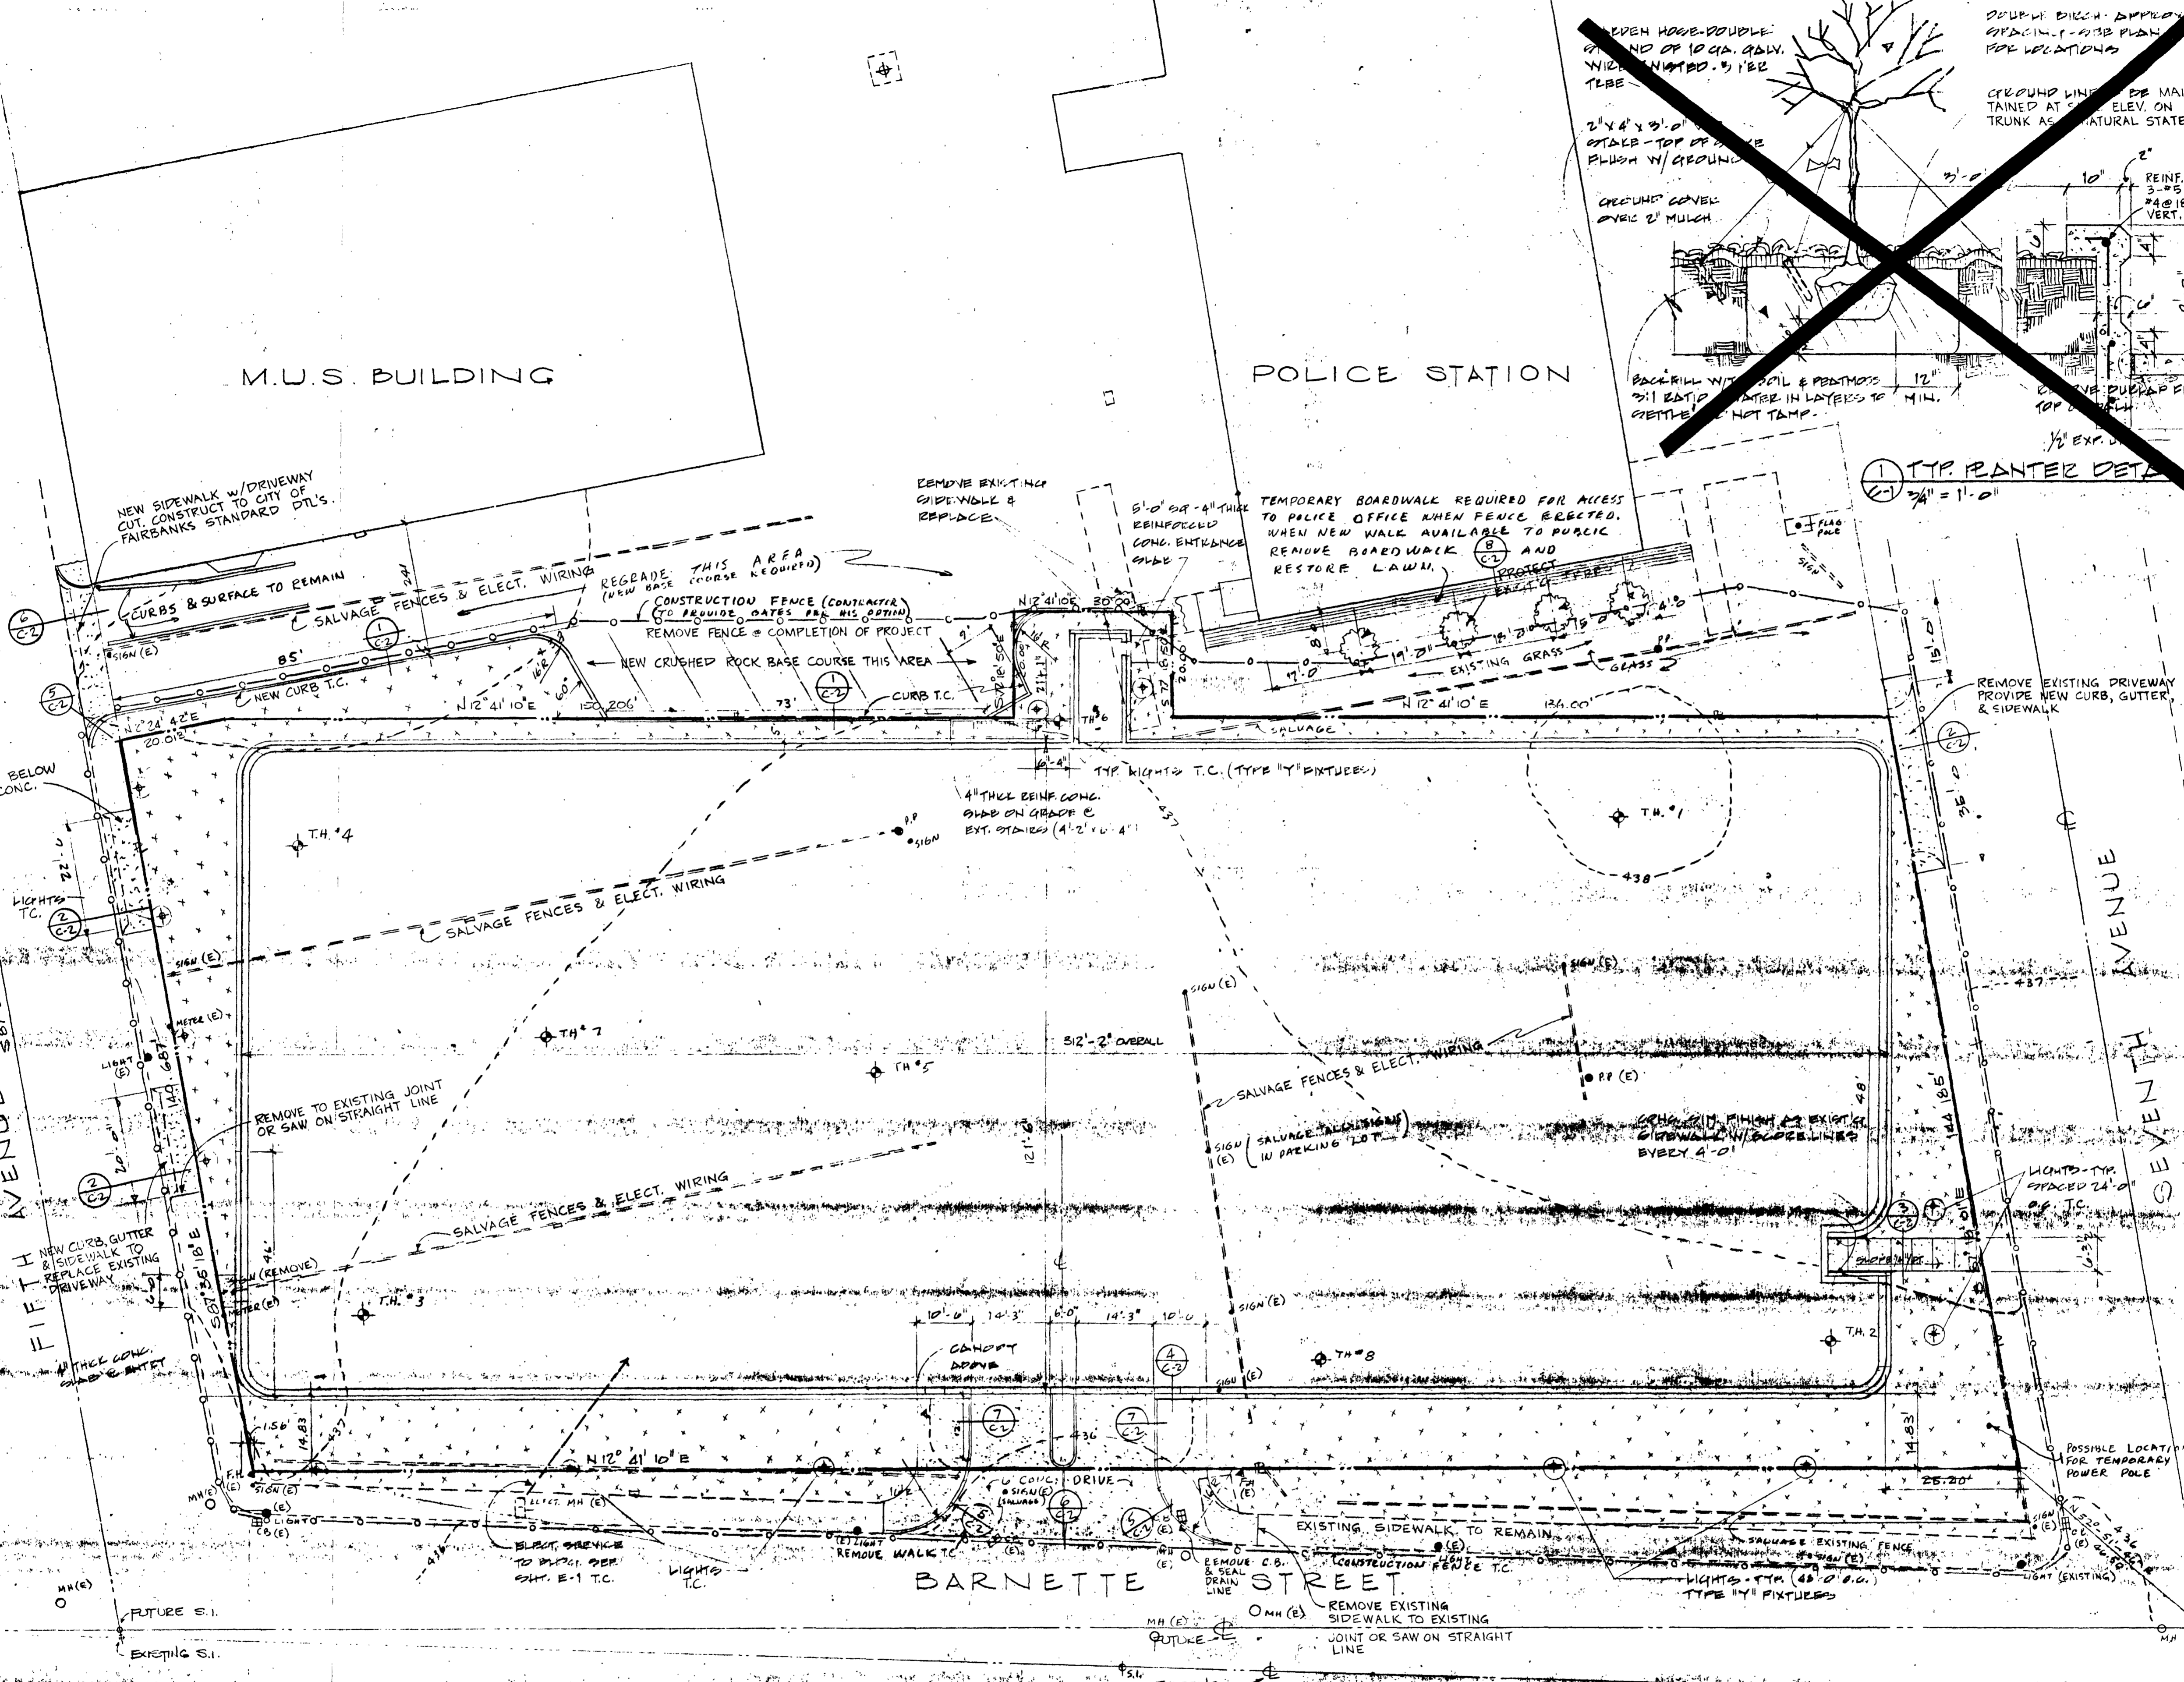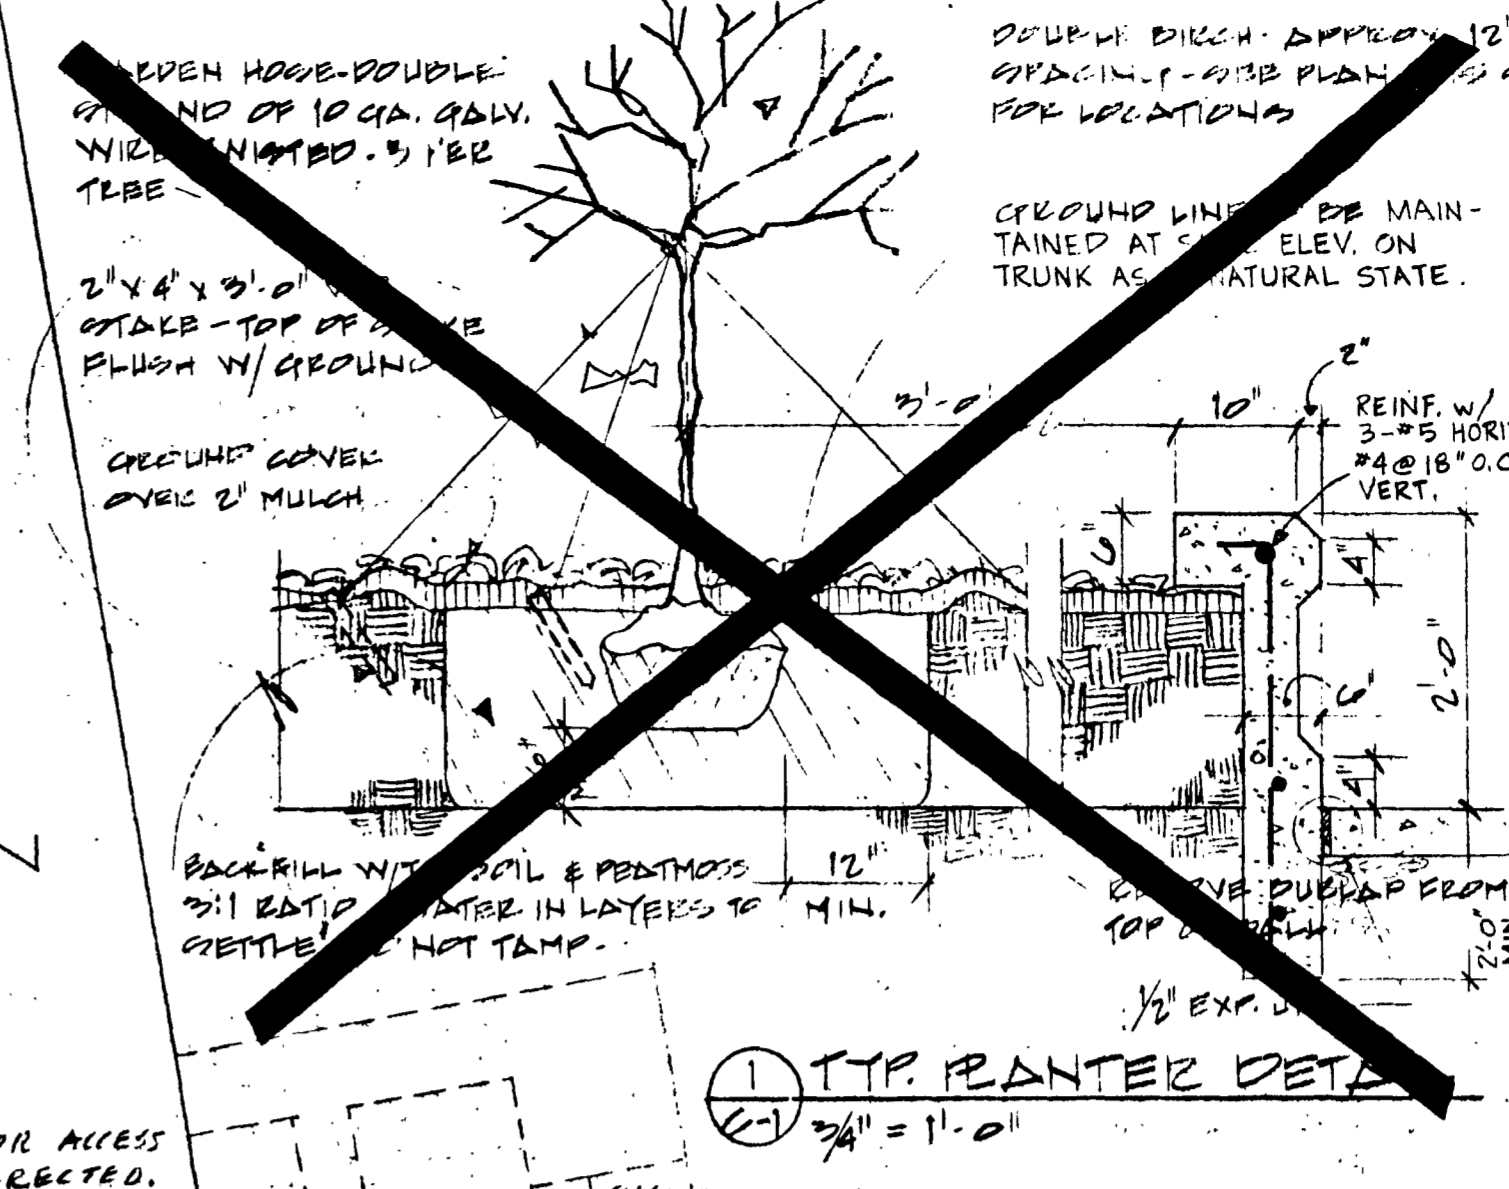


JOB NO: 7813-724
DATE: 6-27-74

ARCHITECTS • ENGINEERS • SURVEYORS
101 COLLEGE ROAD, FAIRBANKS, ALASKA 99701, PHONE: 452-1241

STATE OF ALASKA
DEPT. OF PUBLIC WORKS
DIVISION OF BUILDINGS
JUNEAU ALASKA

FAIRBANKS PARKING STRUCTURE
DBA-2-0130
FAIRBANKS, AK

PETER HUNYI SONS' CO.
C-1
AS-BLT SHEET 2 0

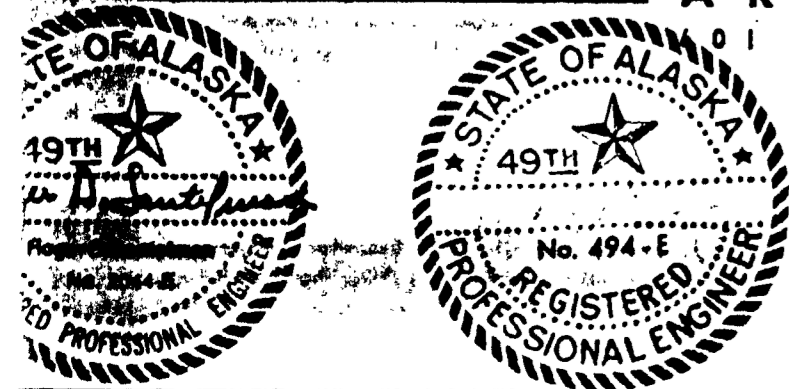


SCALE: 1/16" = 1'-0"


SEE ELECTRICAL SPECIFICATIONS FOR INFO ON TEMPORARY POWER FOR CONSTRUCTION

SEE SHEET C-2 FOR BLDG. LOCATION



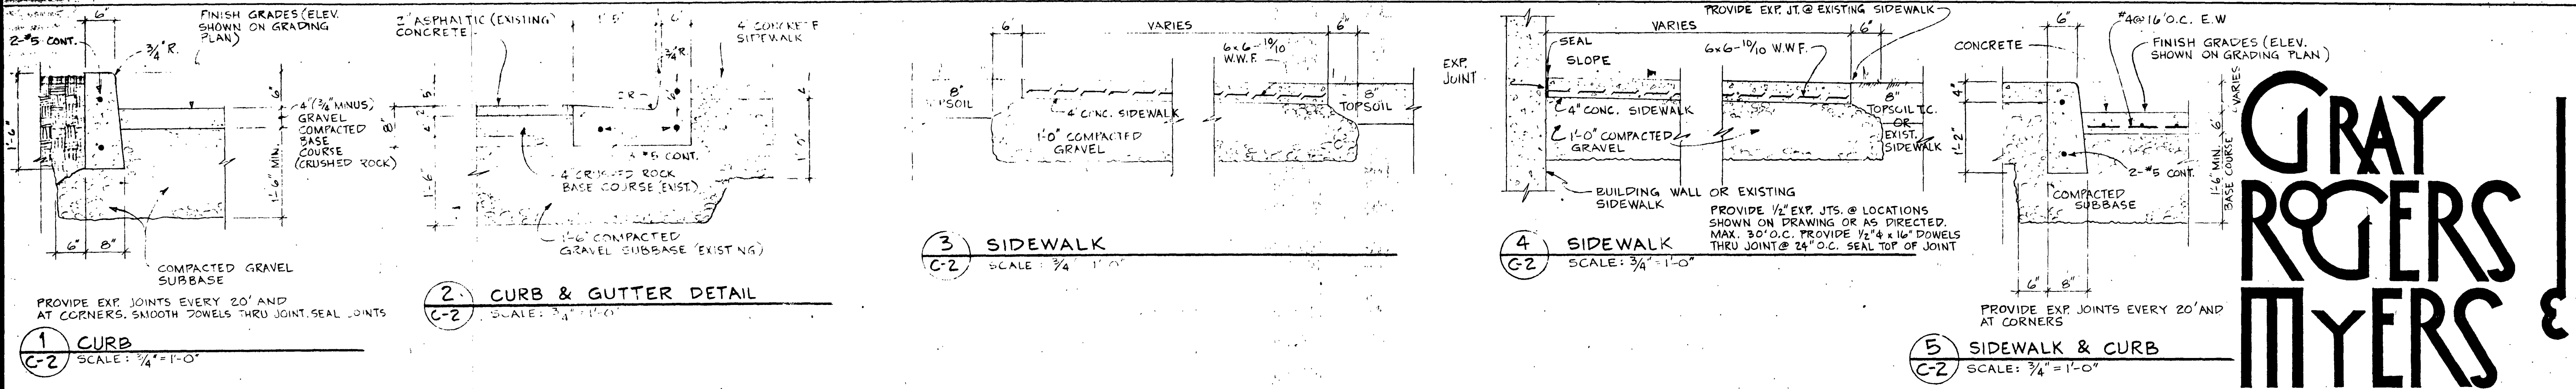


GRAY ROGERS MYERS & TORGAN

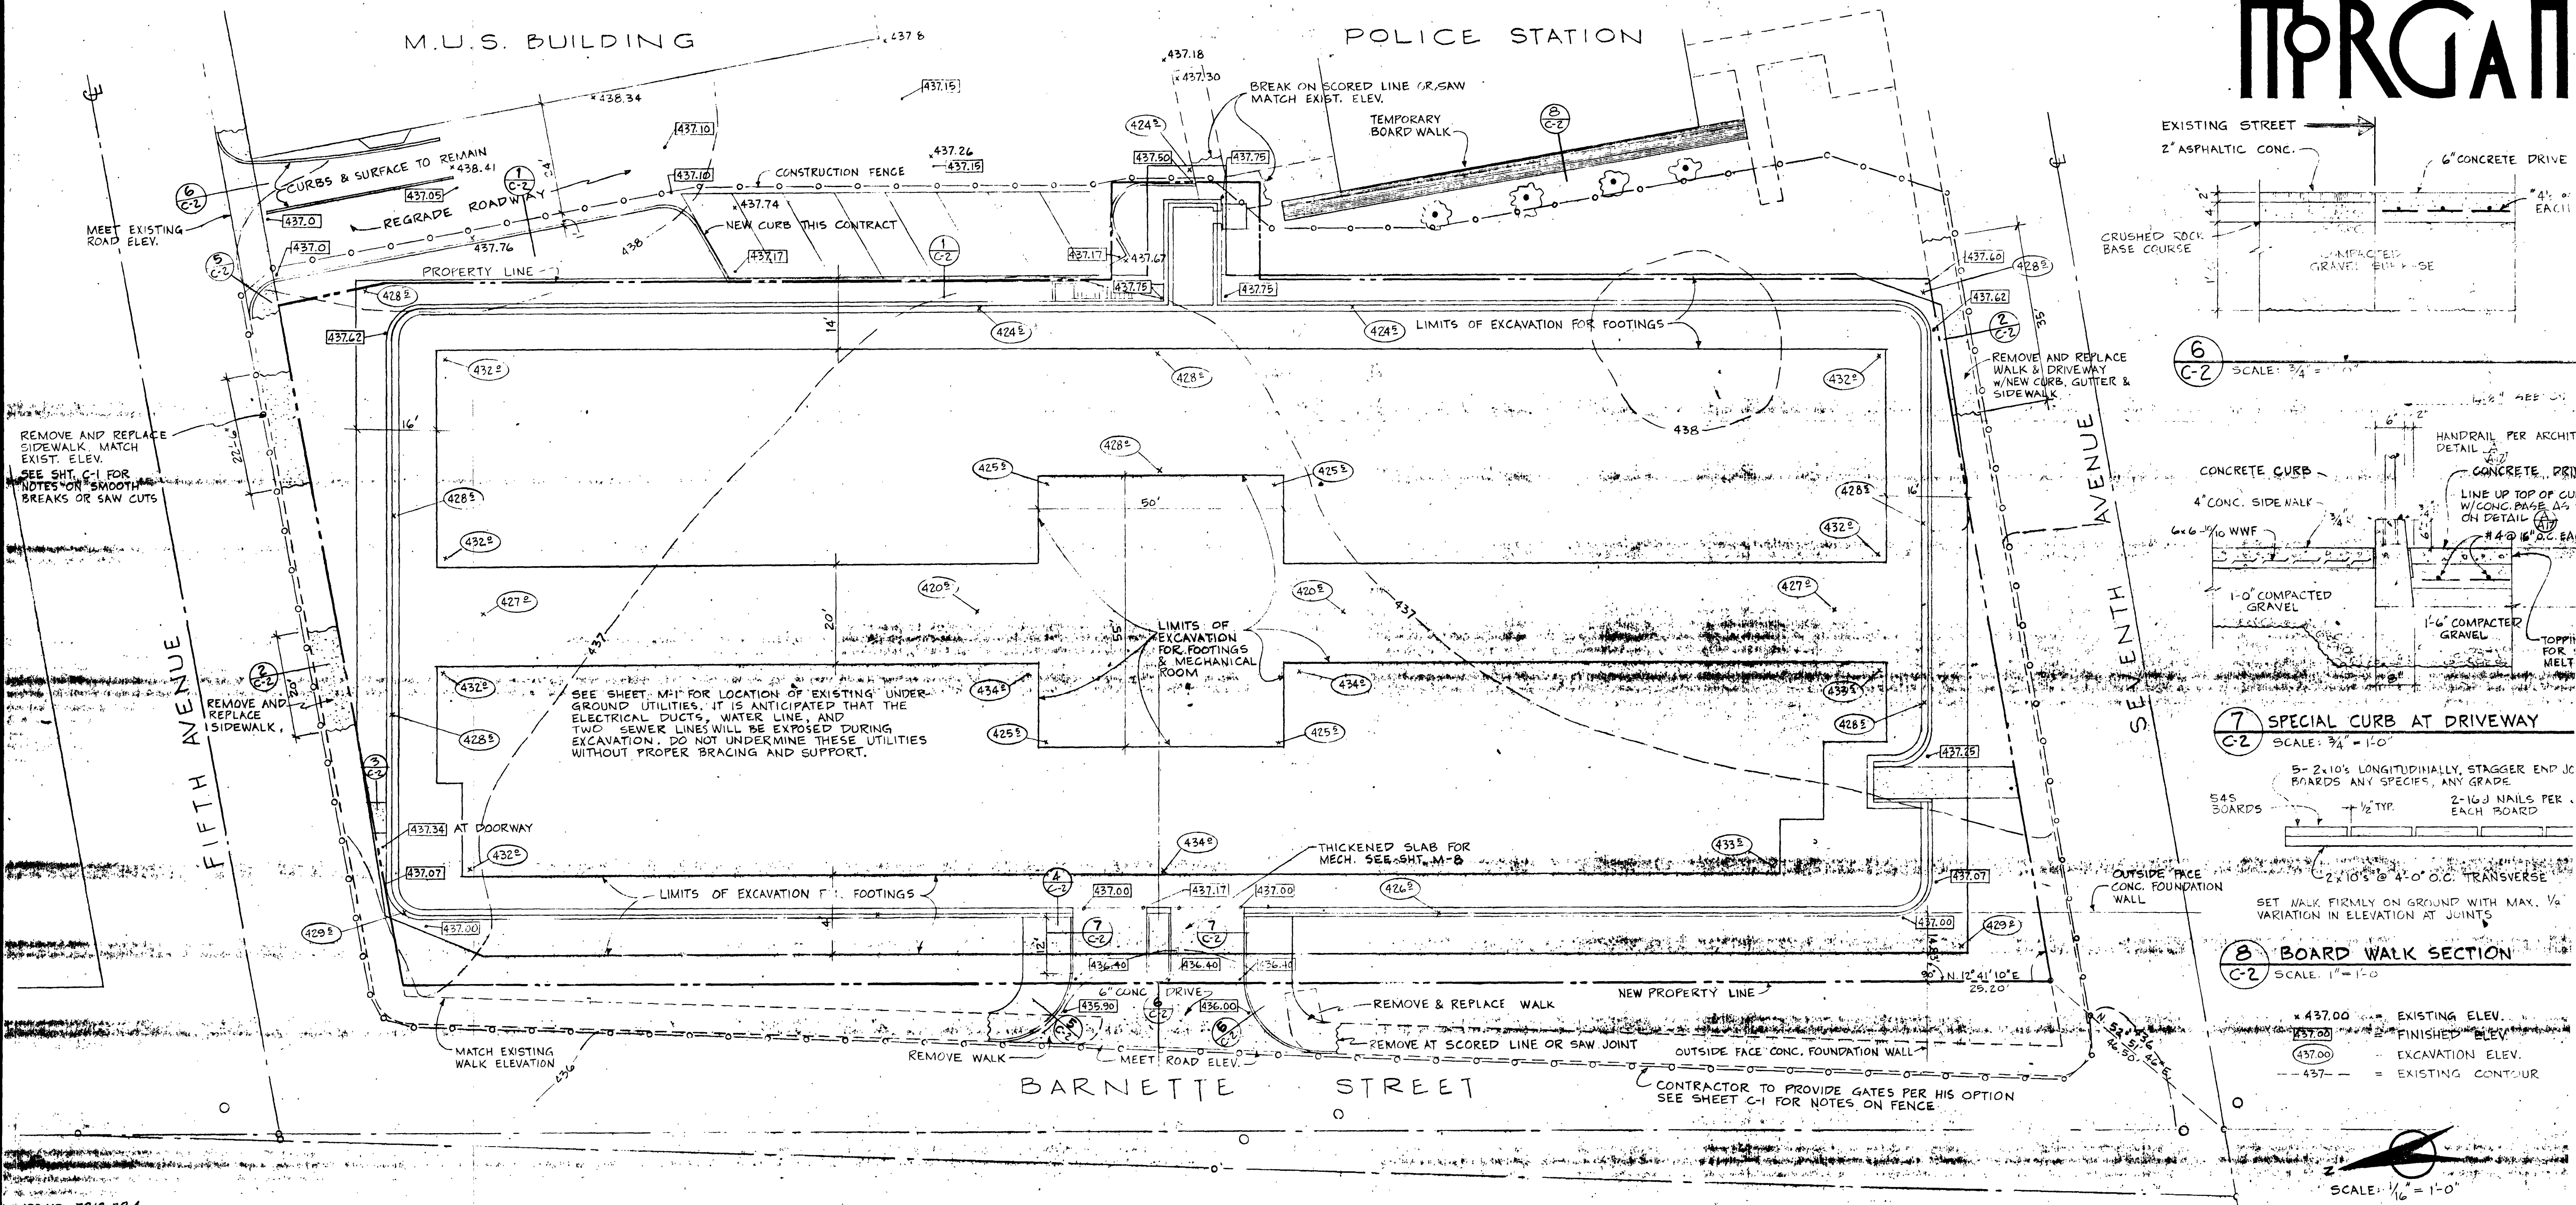

JOB NO: 78/3-734
DATE: 6-27-74

ARCHITECTS • ENGINEERS • SURVEYORS
COLLEGE ROAD, FAIRBANKS, ALASKA 99701, PHONE: 452-1241

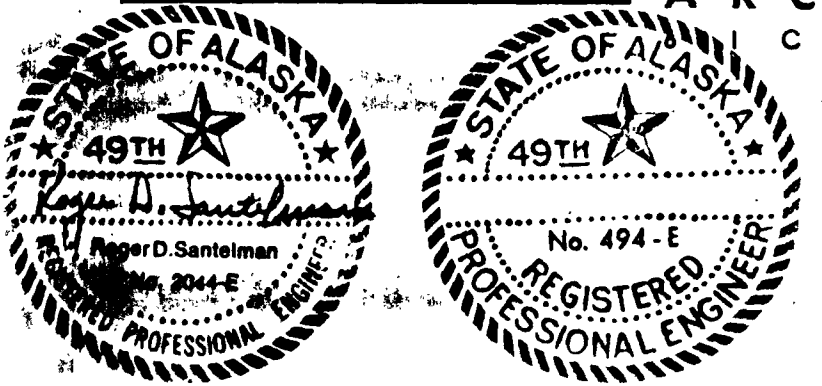

STATE OF ALASKA
DEPT. OF PUBLIC WORKS
DIVISION OF BUILDINGS
JUNE AU ALASKA

FAIRBANKS PARKING STRUCTURE


DBA - 2 - 0130
FAIRBANKS, AK.

PETER KIEWIT SONS' CO.
CONTRACTORS' REP.
DATE



C-2

AS-BLT SHEET 3 OF


GRADING P

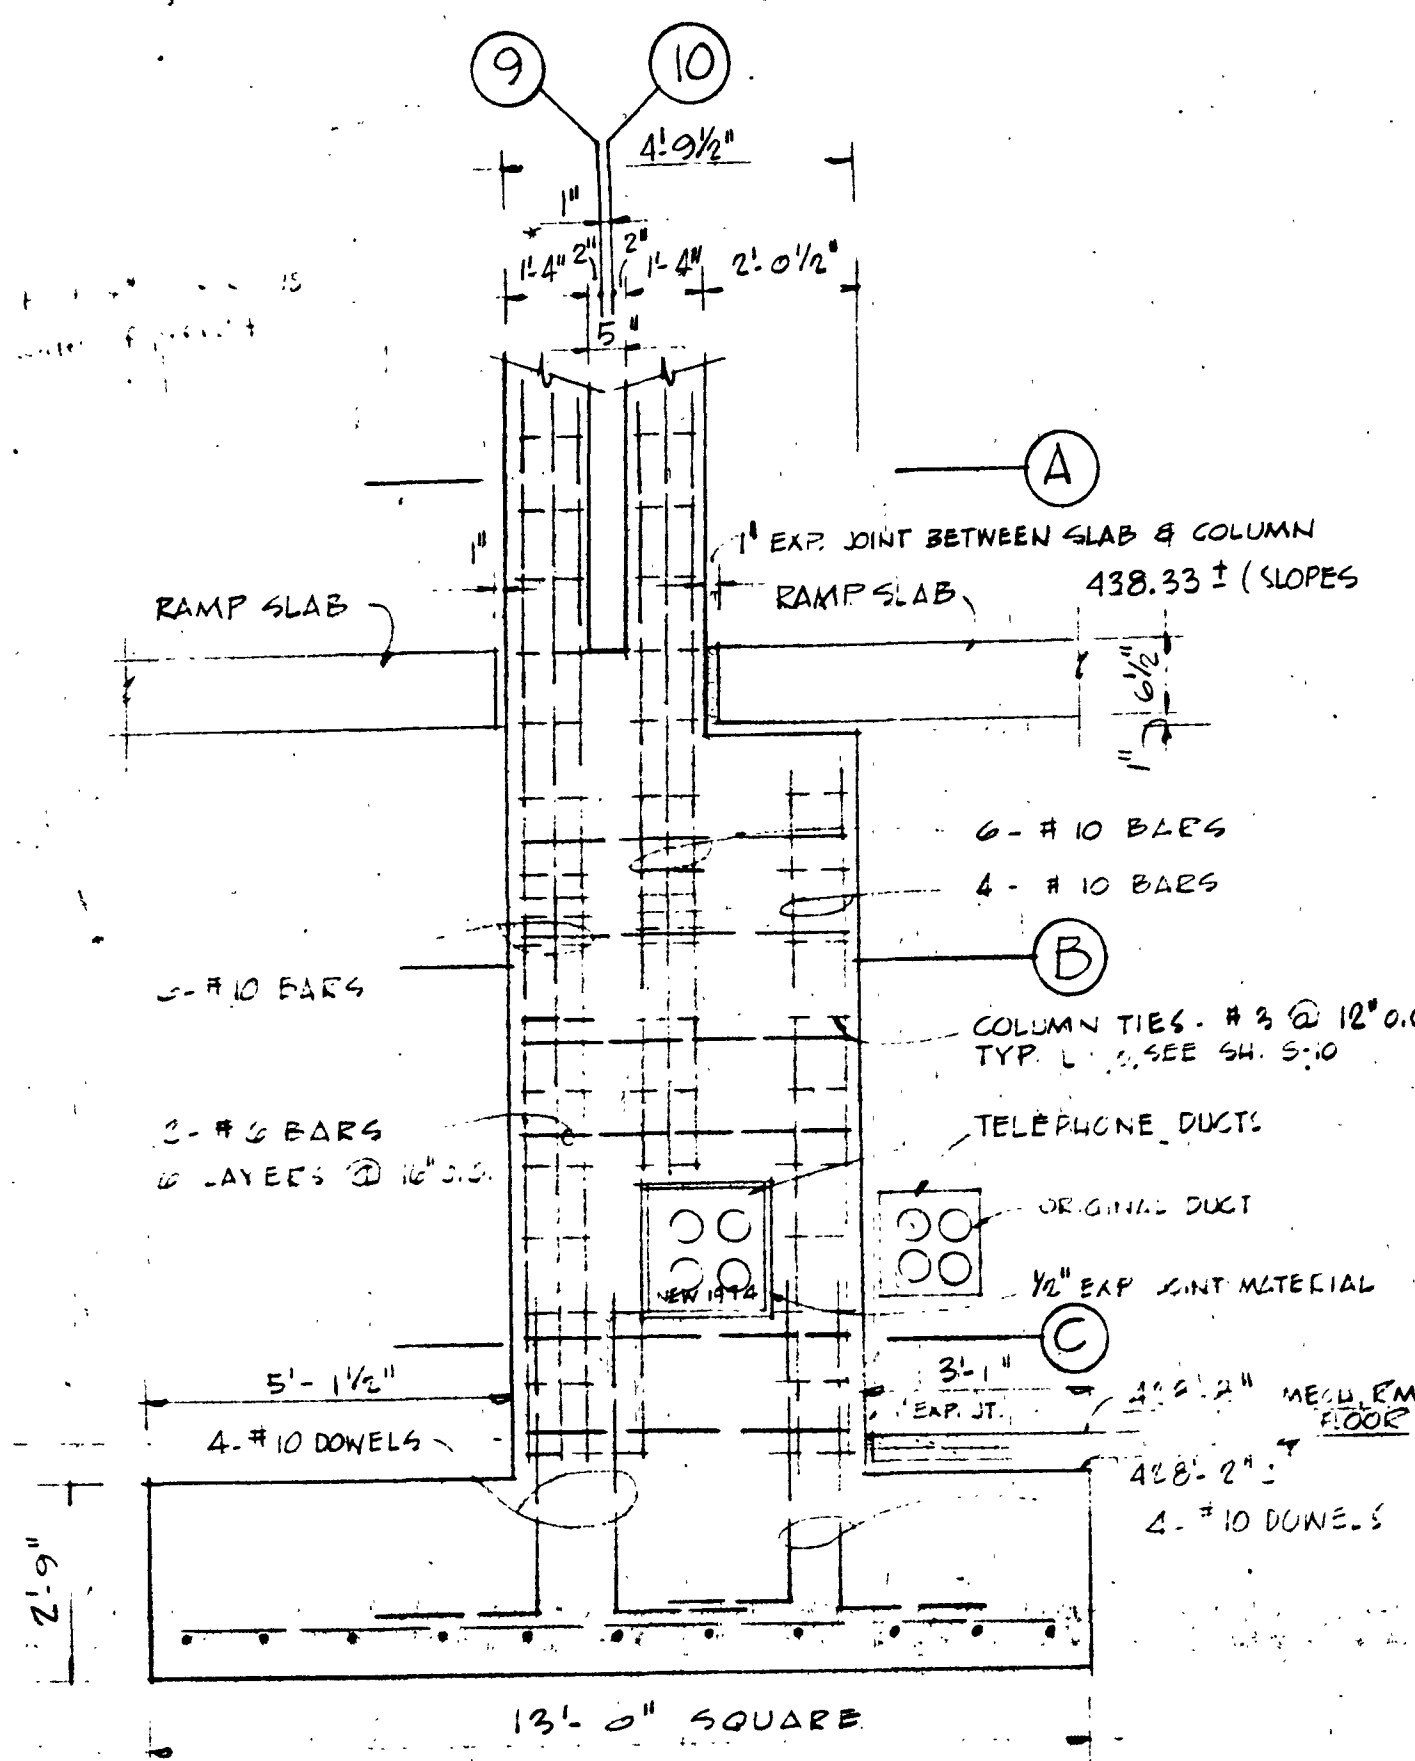


SECTION COLUMN D-9/10
SCALE - 3/8" = 1'-0"

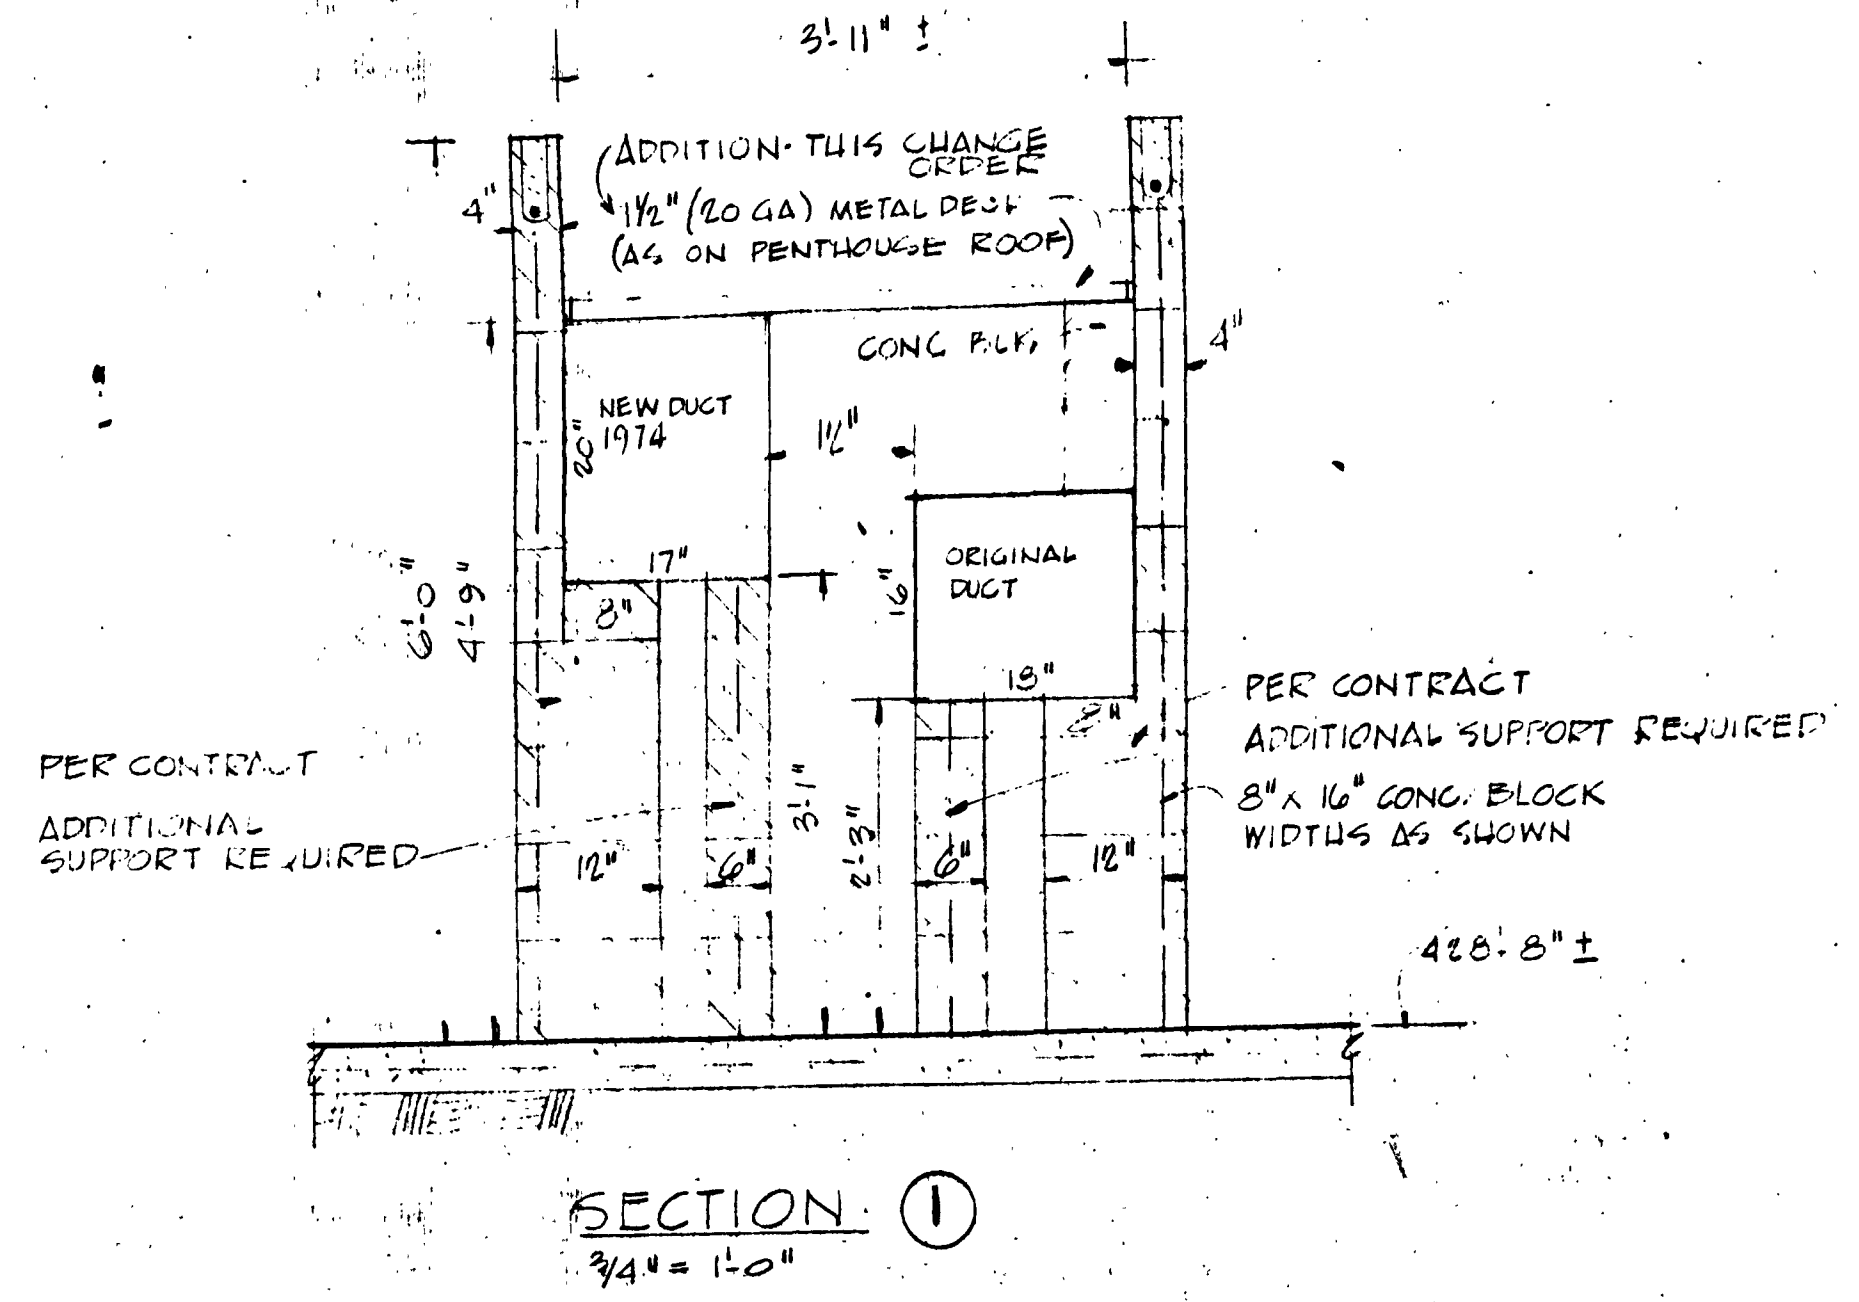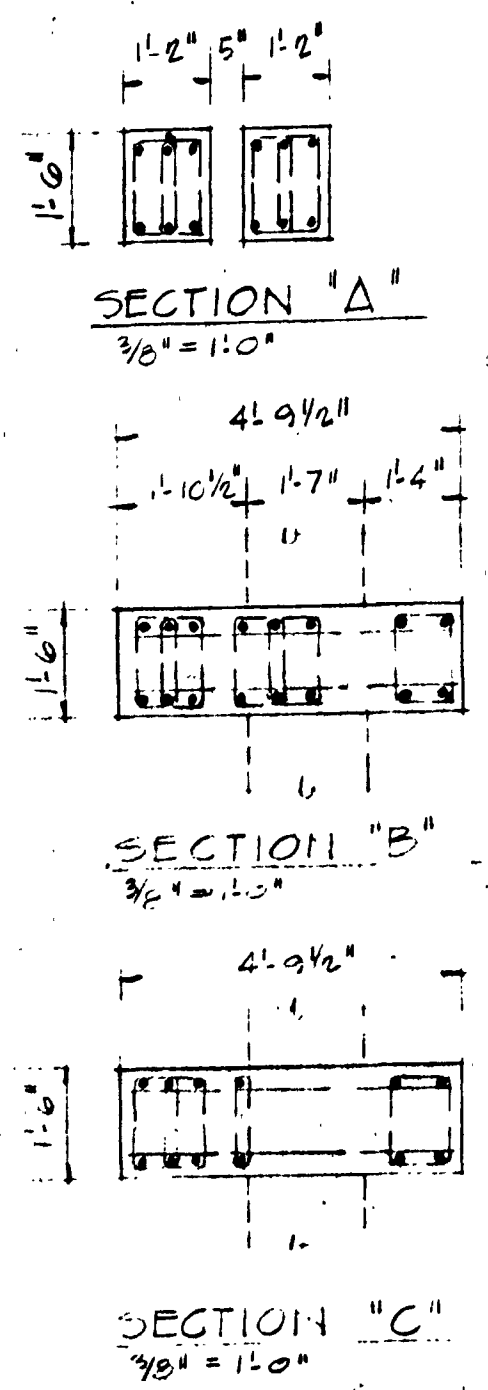


SECTION 1
3/4" = 1'-0"

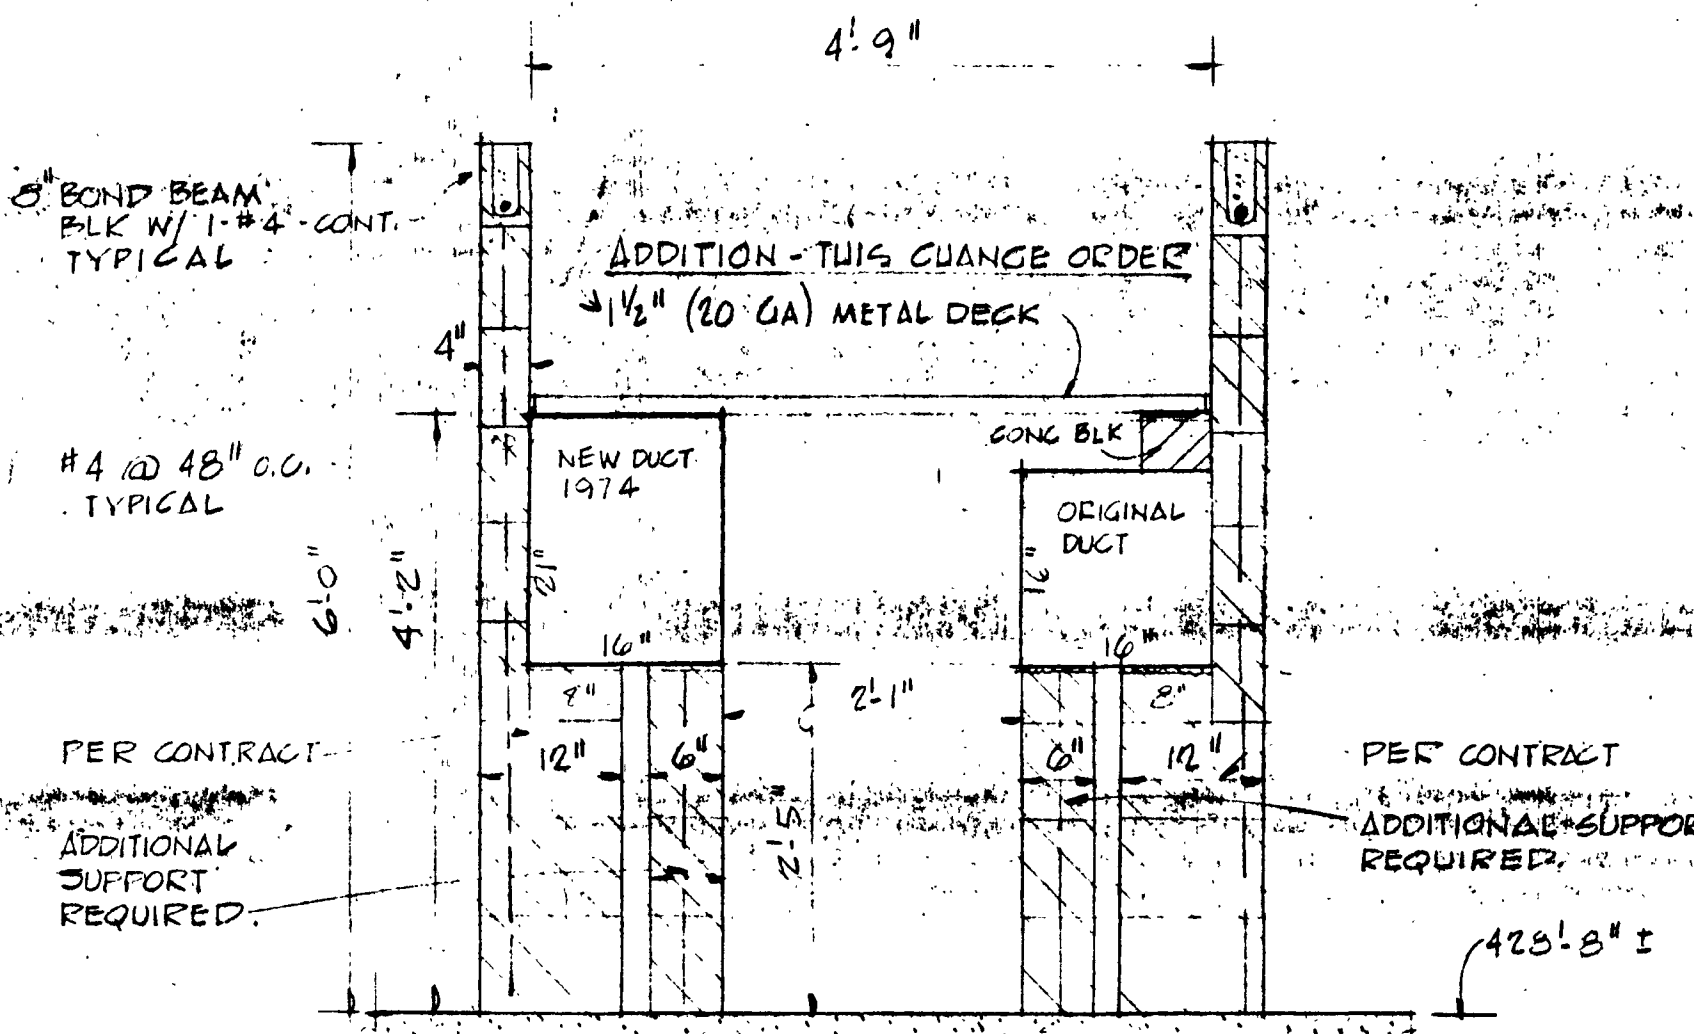

SECTION 2 SEE FL. PLAN
3/4" = 1'-0"

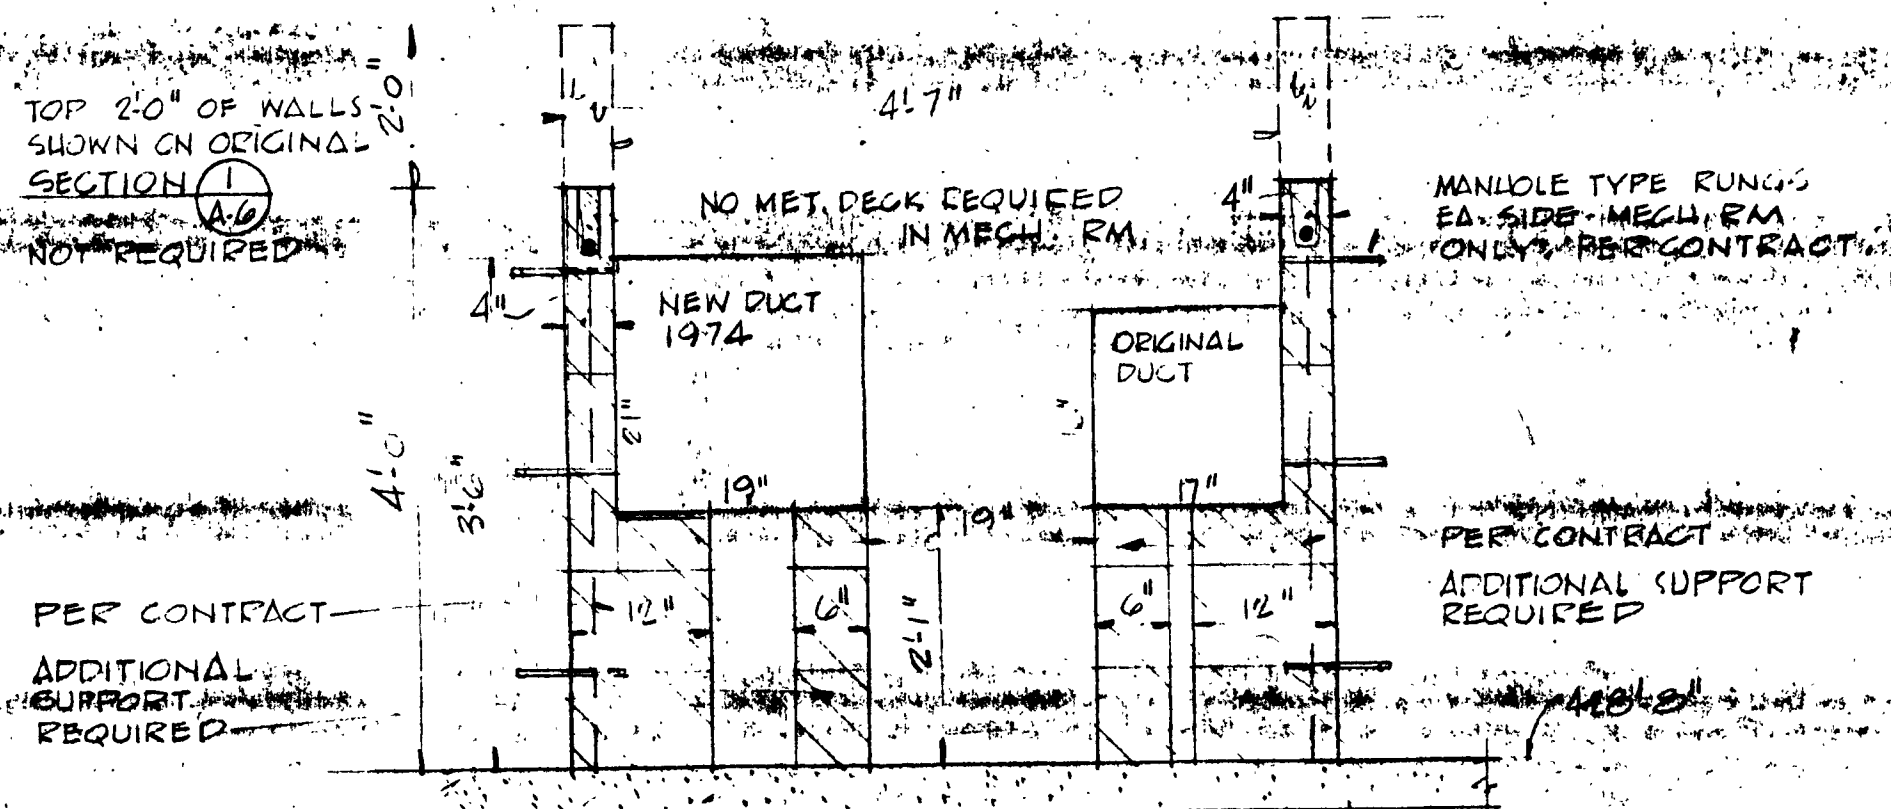

SECTION 3
3/4" = 1'-0"

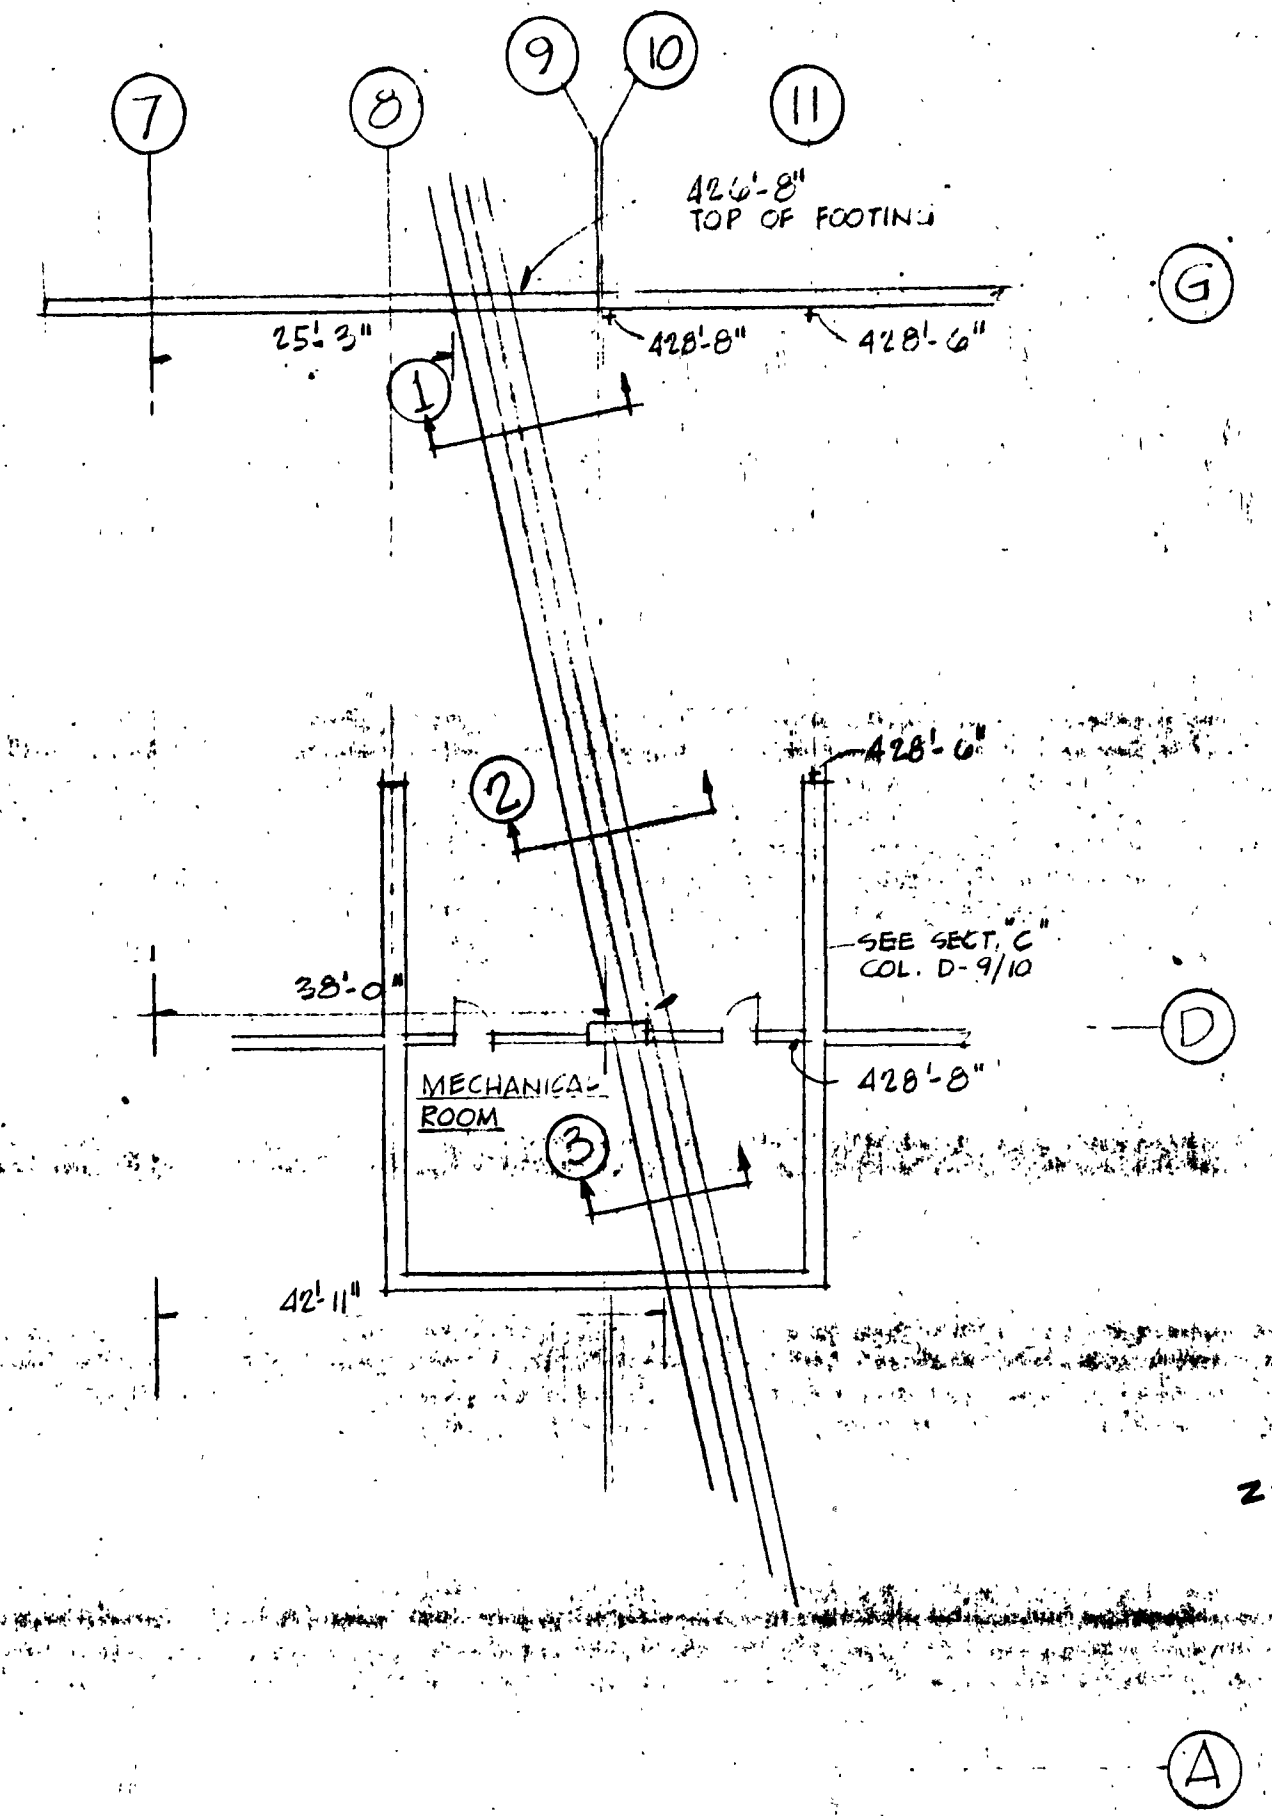

FLOOR PLAN - LEVEL L - LOWER
SCALE 1/16" = 1'-0"

JOB NO: 7813-734
DATE:

ARCHITECTS • ENGINEERS • SURVEYORS
601 COLLEGE ROAD, FAIRBANKS, ALASKA 99701. PHONE: 452-1241

STATE OF ALASKA
DEPT. OF PUBLIC WORKS
DIVISION OF BUILDINGS
JUNEAU ALASKA


FAIRBANKS PARKING STRUCTURE
FAIRBANKS, AK.
DBA - 2 - 0130

CHANGE ORDER DRAWING
NECESSARY REVISIONS DUE TO M.U.
CHANGING TELEPHONE DUCT LOCATION

CO-1

PETER KIEWIT SONS CO.	
DATE:	

GRAY ROGERS MYERS & MORGAN

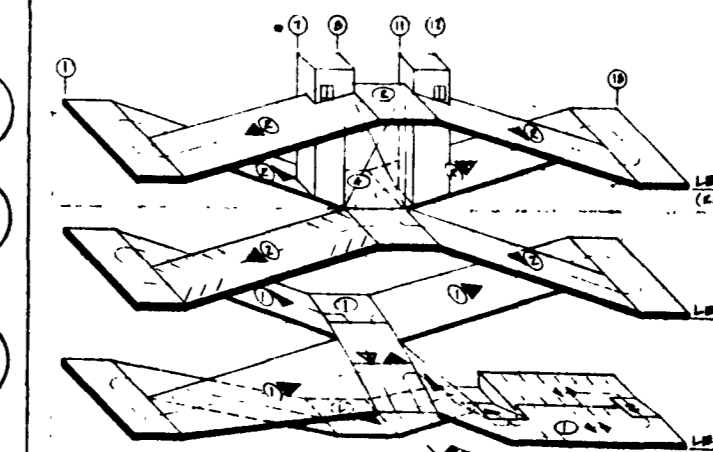

ROOM FINISH SCHEDULE

LETTER DESIGNATIONS:

- A. EXPOSED CONCRETE
- B. CONCRETE CURE
- C. 12" X 12" X 1/8" SMOOTH VINYL ADDRESSABLE
- D. RUBBER TREADS & RISERS (LANDINGS V.A.T.)
- E. 1" RUBBER BASE
- F. ENAMEL PAINT ON 3/4" PLASTER
- G. LATEX PAINT ON 5/8" GYP. BR.
- H. 5/8" GYP. BR. - NO FINISH
- I. METAL PANELS - FINISH BY MEGR.
- J. METAL LOUVER ENVELOPERS - FIN. BY MEGR.
- K. METAL DECK
- L. 3/4" SUSPENDED PLASTER CLCP.
- M. NONE
- N. SUSPENDED ACoustICAL TILE
- P. CEILING HEIGHT VARIES
- Q. PERIMETER




A DIVISION OF ELLERBE

FINISH SCHEDULE NOTES:

1. PAINT INTERIOR & EXTERIOR WOOD & METAL DECKING - TYP.
2. PAINT ALL FINE HANDRAILS, GUARDRAILS, LANDING...
3. PAINT GRAINWORK ON WALL FLOORS AS NOTED ON FLOOR PLANS & INTERIOR ELEVATIONS. PAINT ON FLOOR SHALL HAVE NON-SLIP FINISH.

FINISH SCHEDULE KEY

EXAMPLE	FLOOR	BASE	WALLS	COVER	COVER HGT.	NOTES
	A	B	L	A	P	1, 2, 3

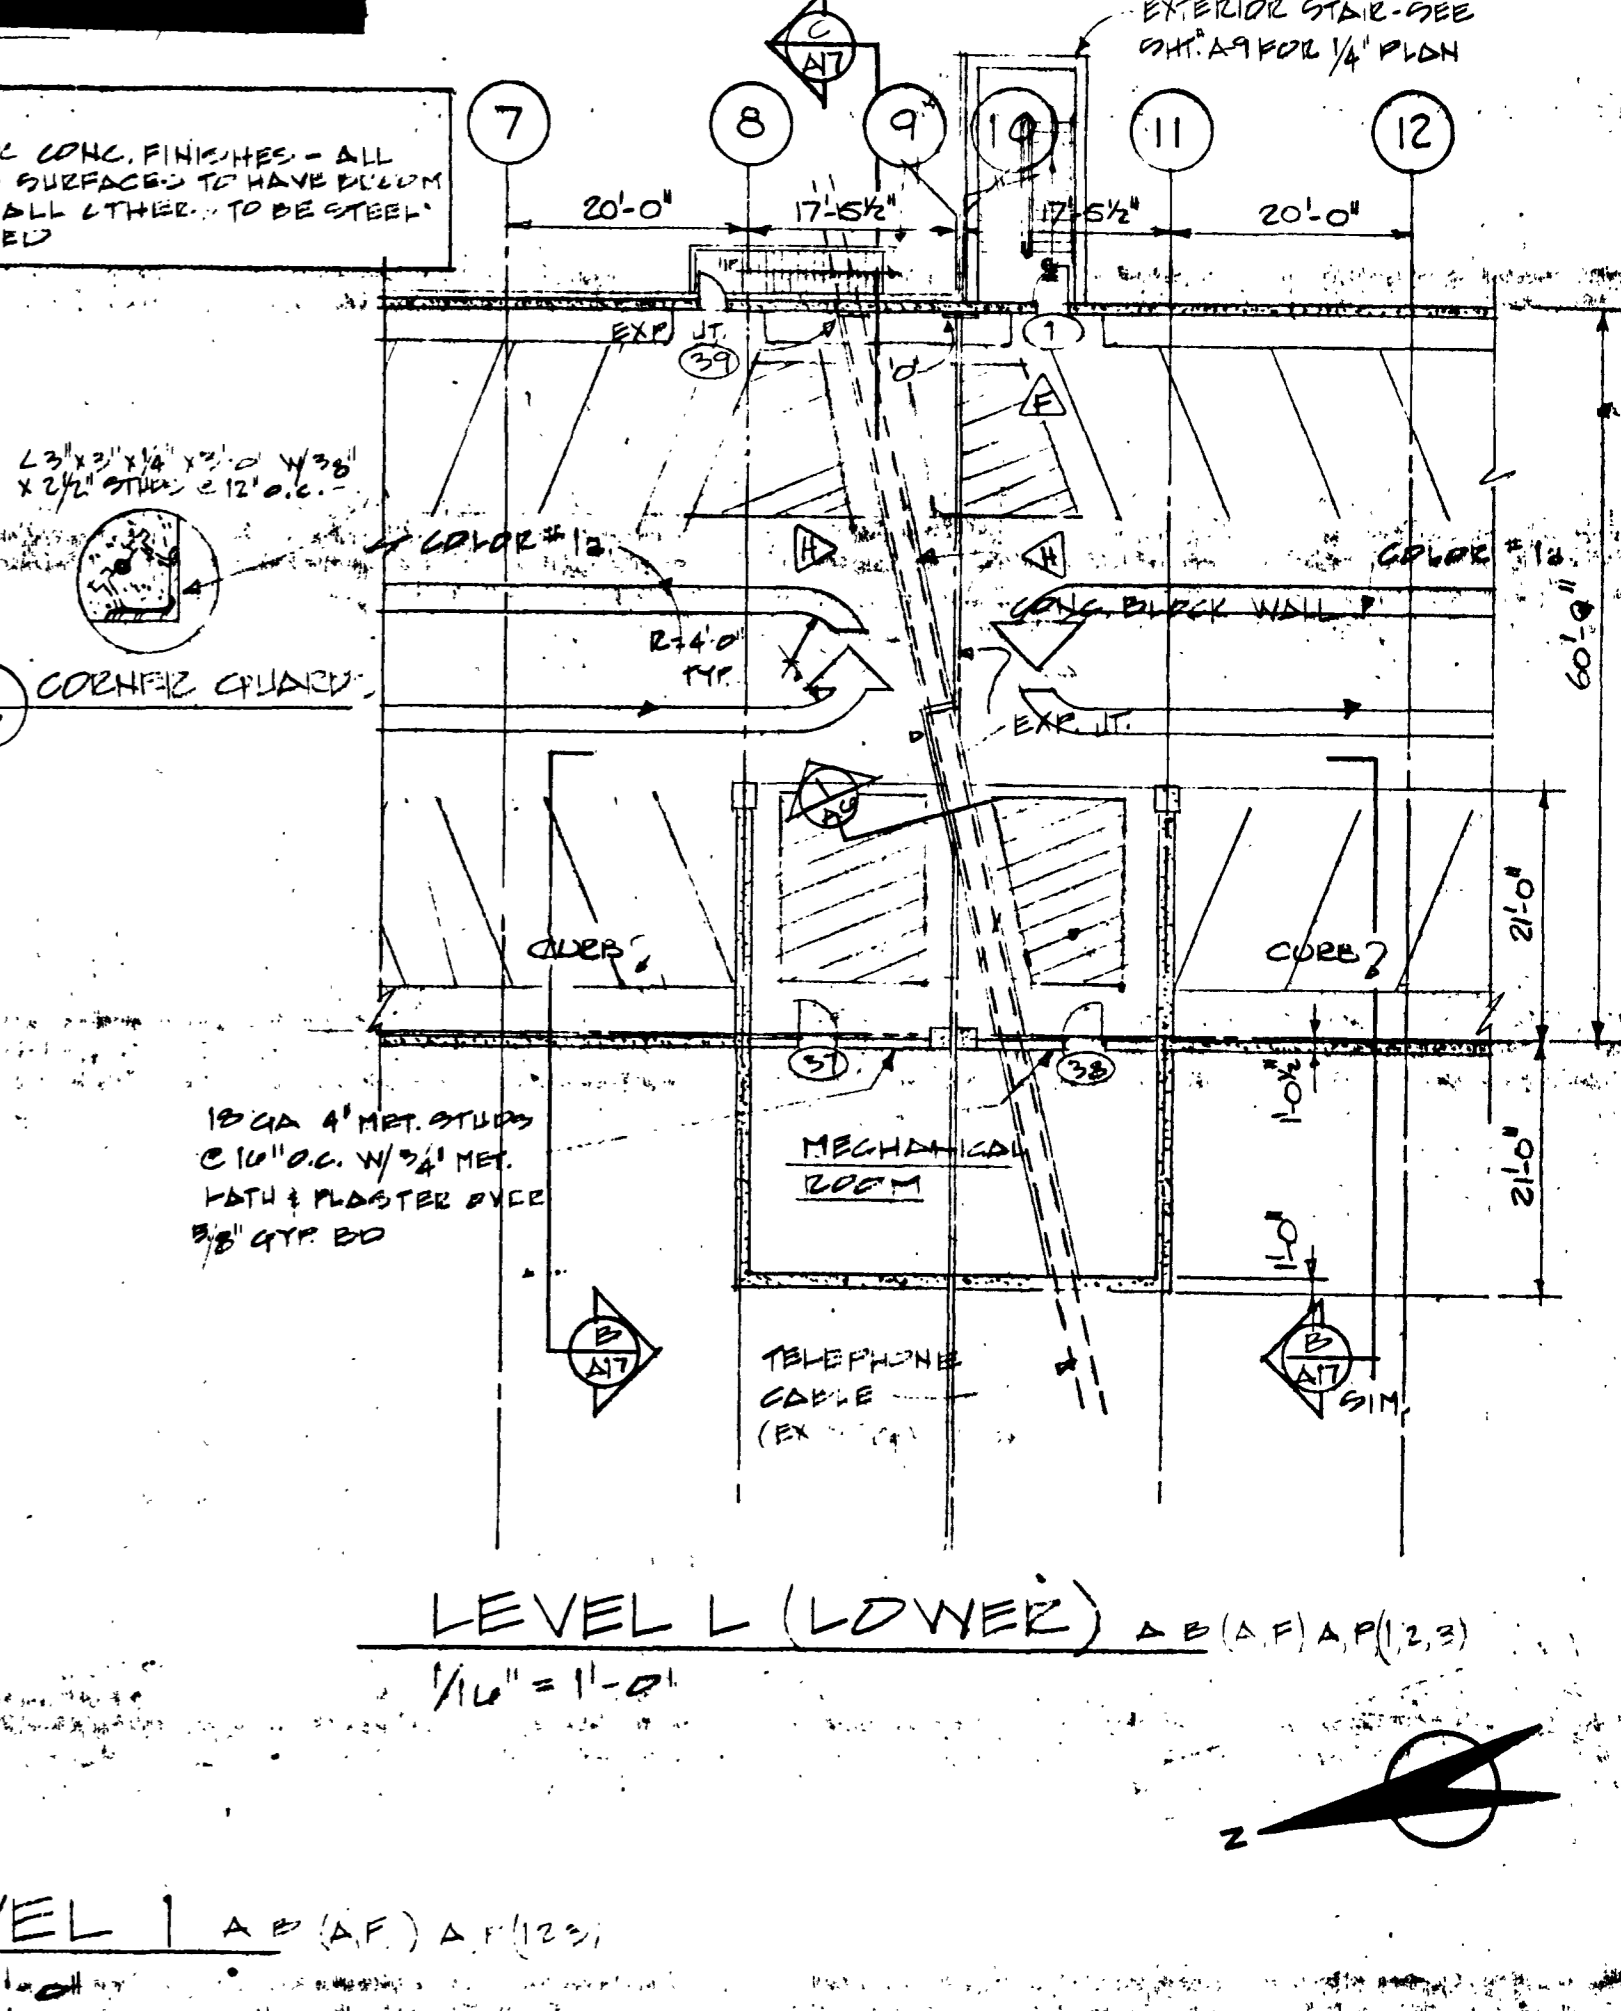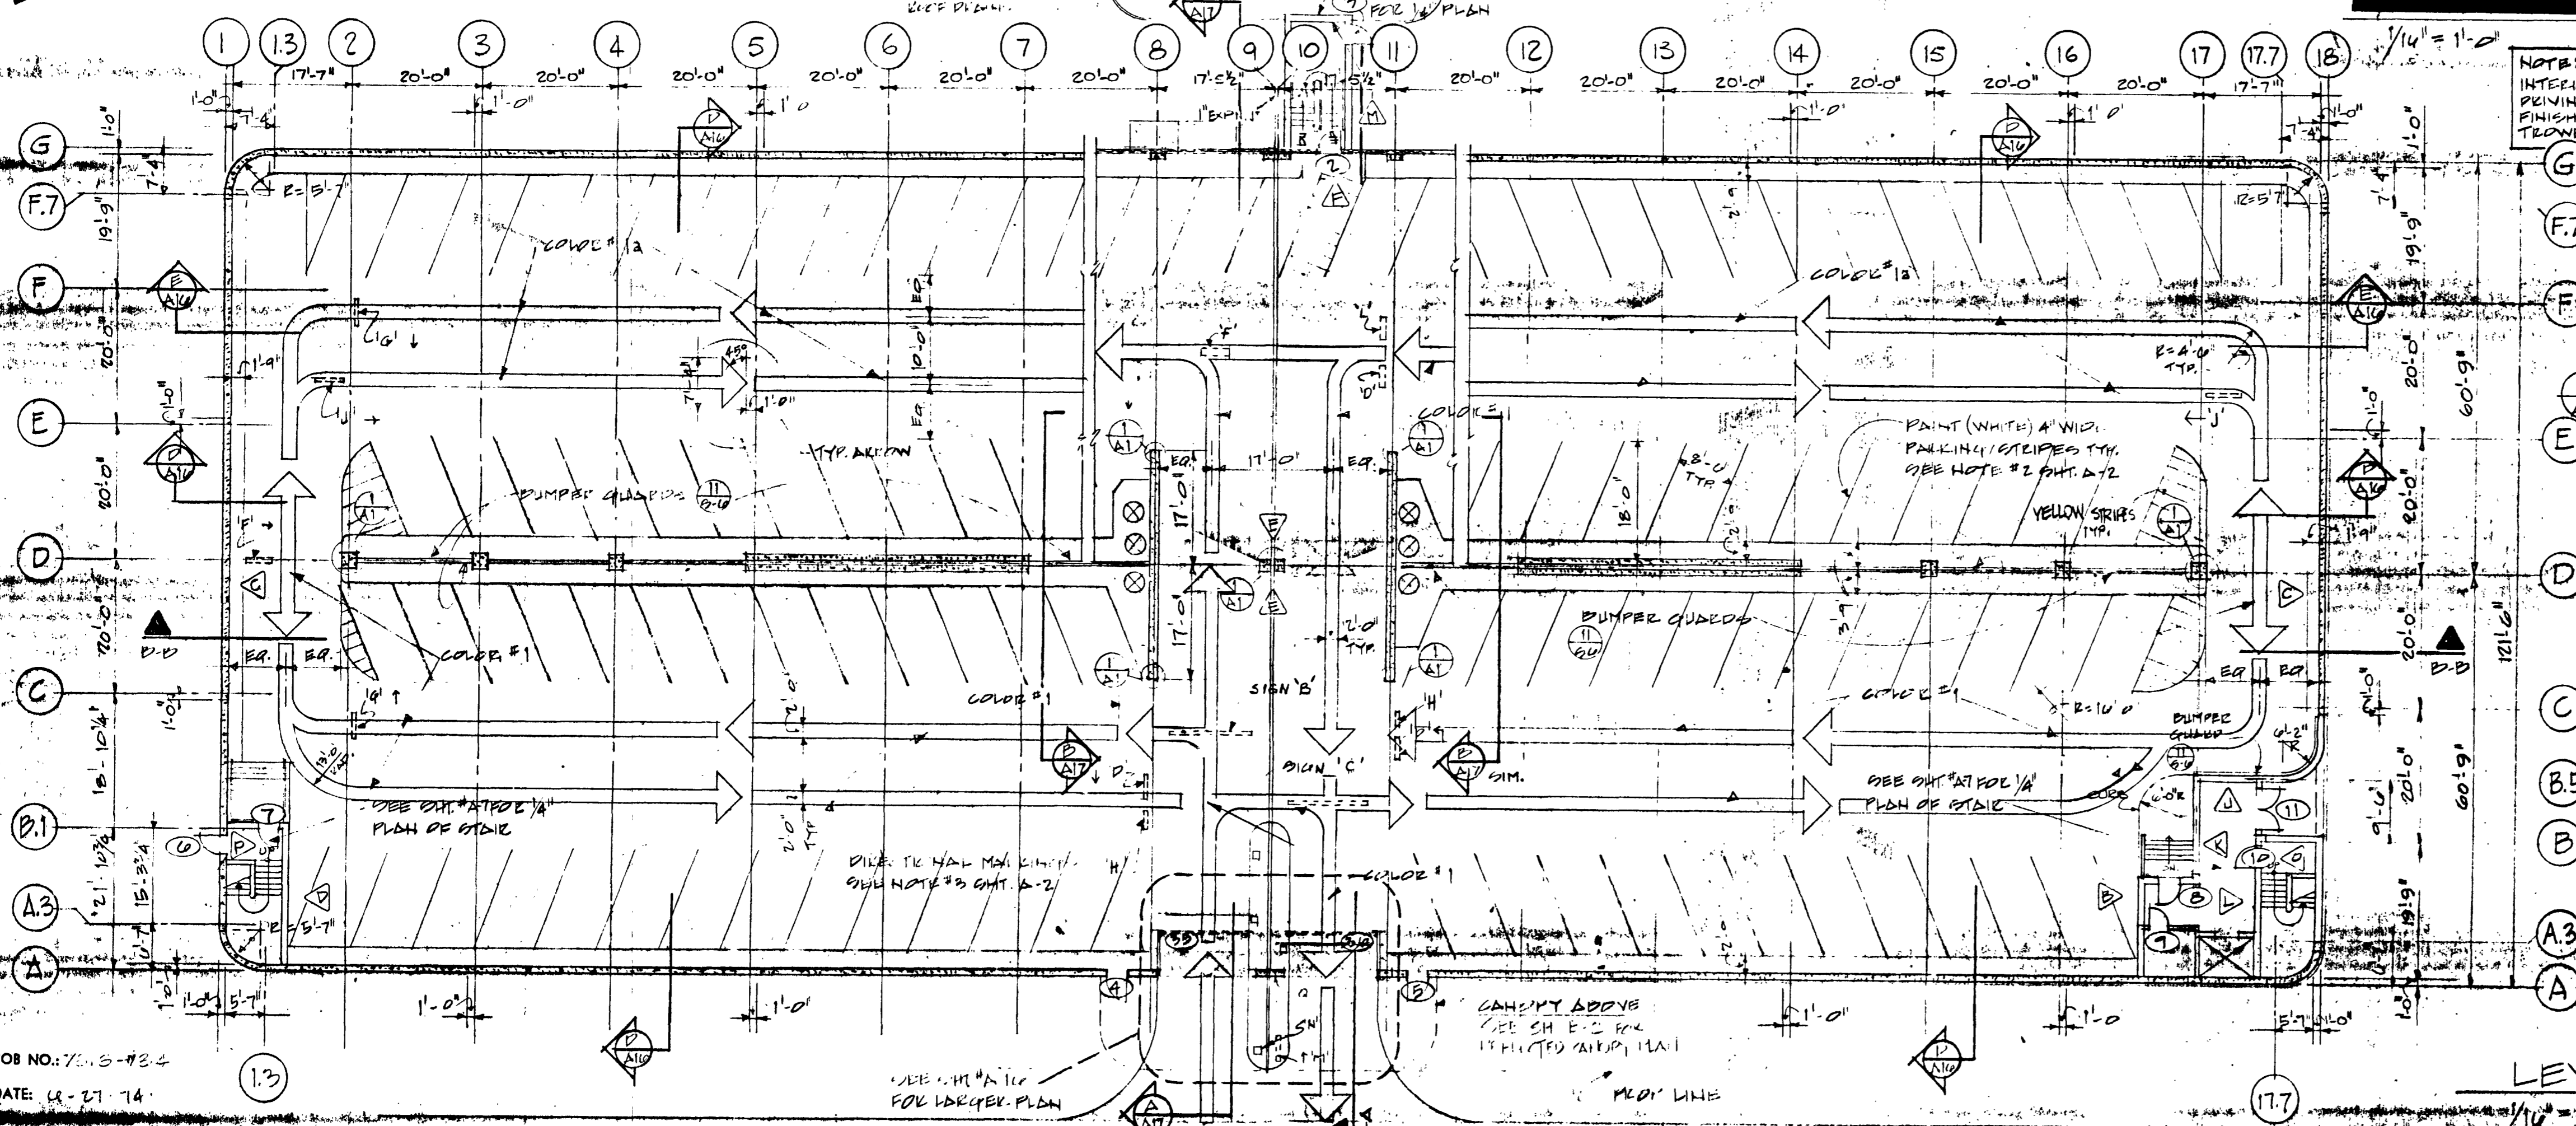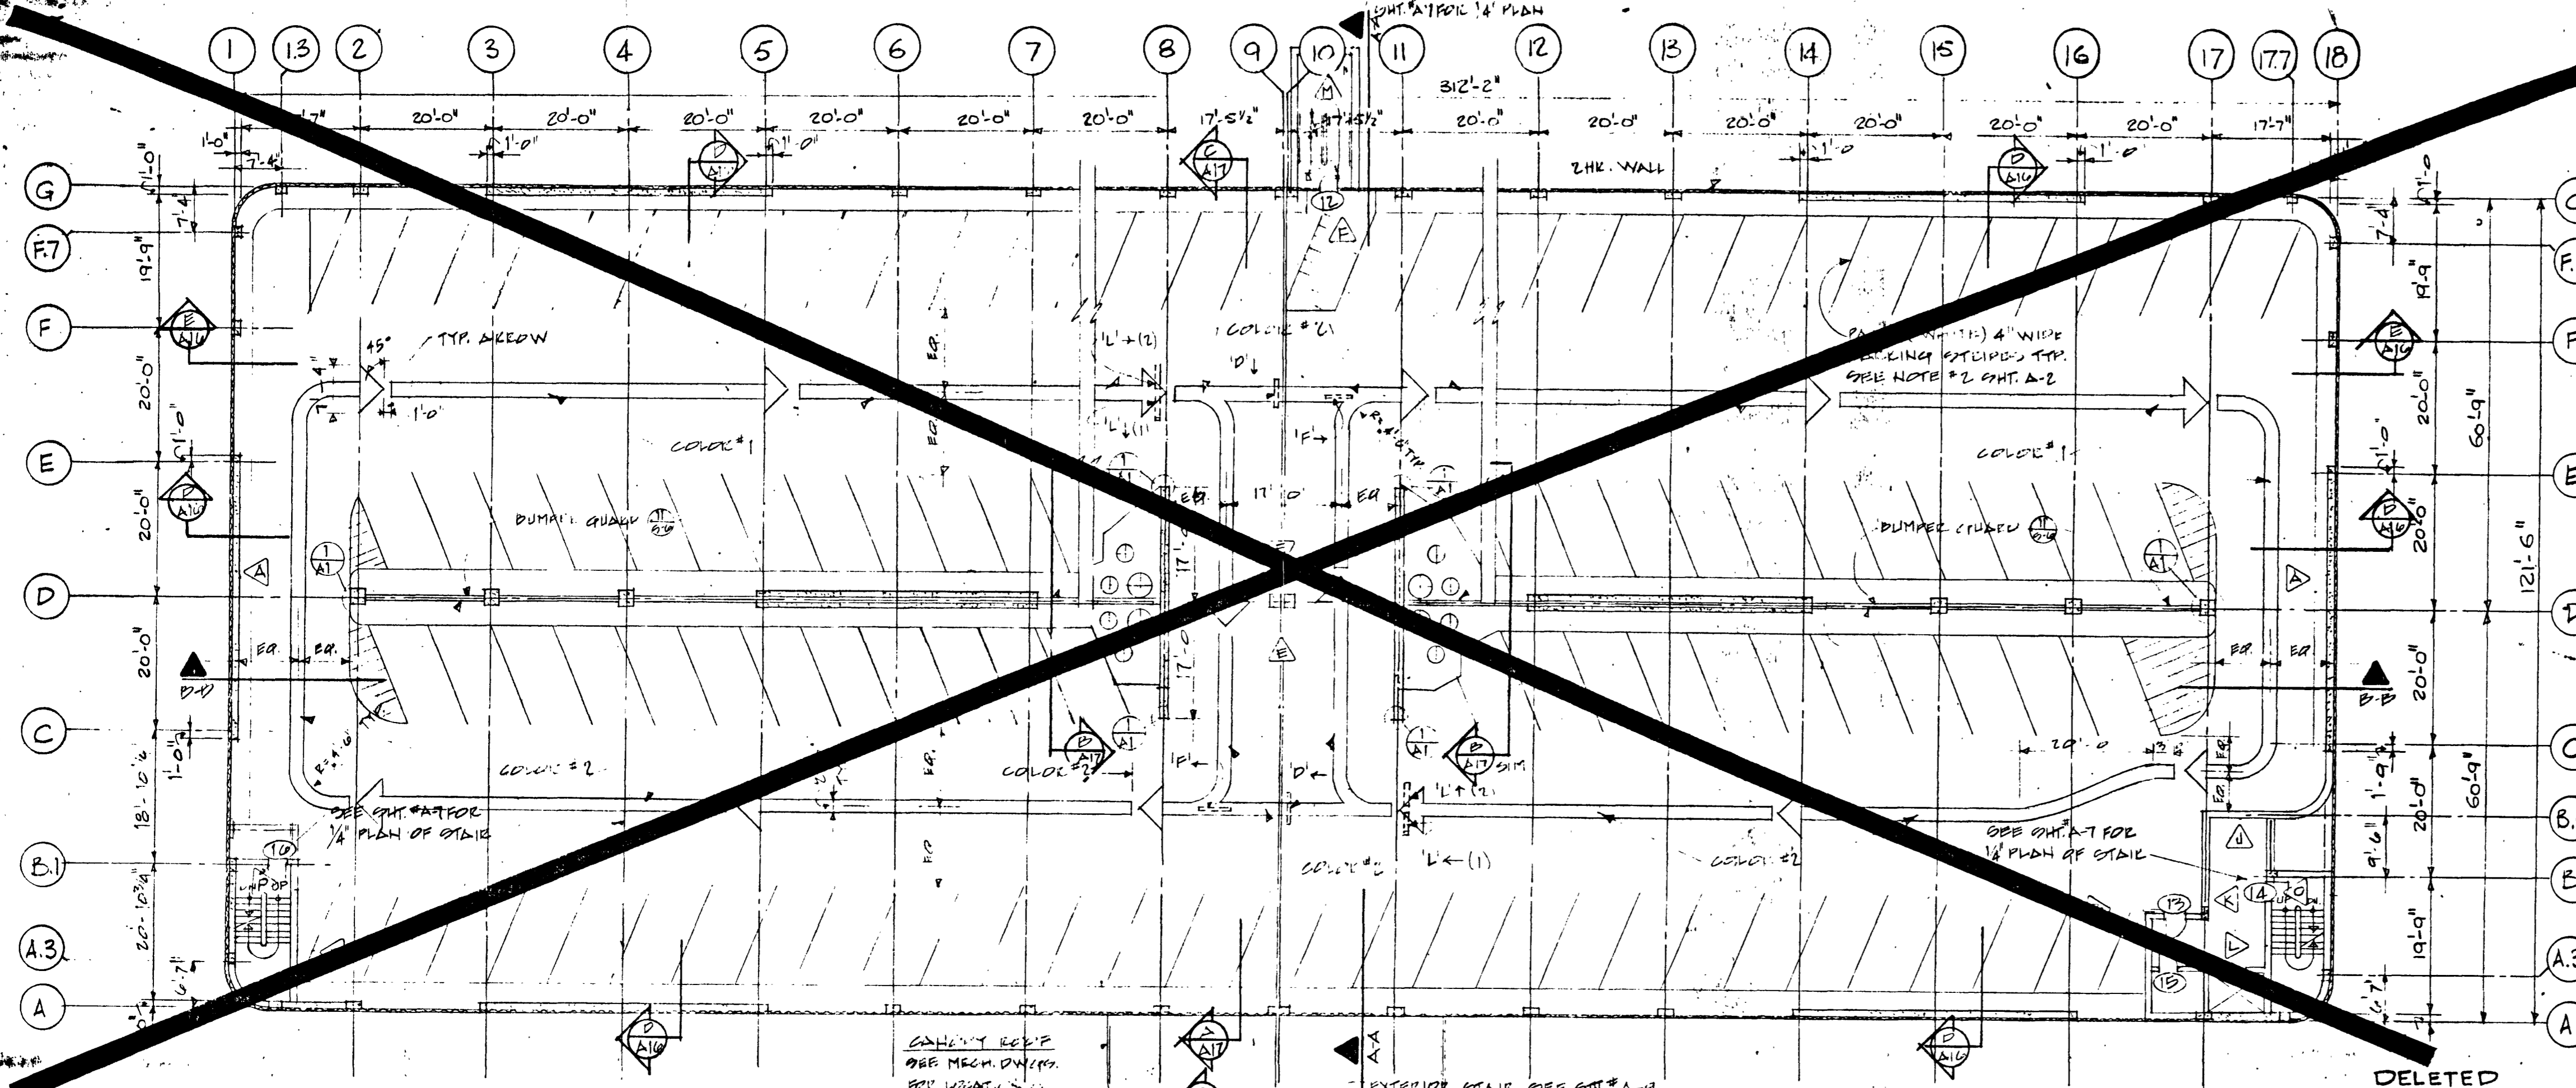

JOB NO. 72-3-734
DATE: 12-27-74

ARCHITECTS • ENGINEERS • SURVEYORS
601 COLLEGE ROAD, FAIRBANKS, ALASKA 99701. PHONE: 452-1241

FAIRBANKS PARKING STRUCTURE
FAIRBANKS, AK.
DBA - 2 - 0130

STATE OF ALASKA
DEPT. OF PUBLIC WORKS
DIVISION OF BUILDINGS
JUNEAU ALASKA


PETER MANNING SONS CO.

A-1

SHEET 4 OF 49

GRAY ROGERS MYERS & MORGAN


A DIVISION OF ELLERBE

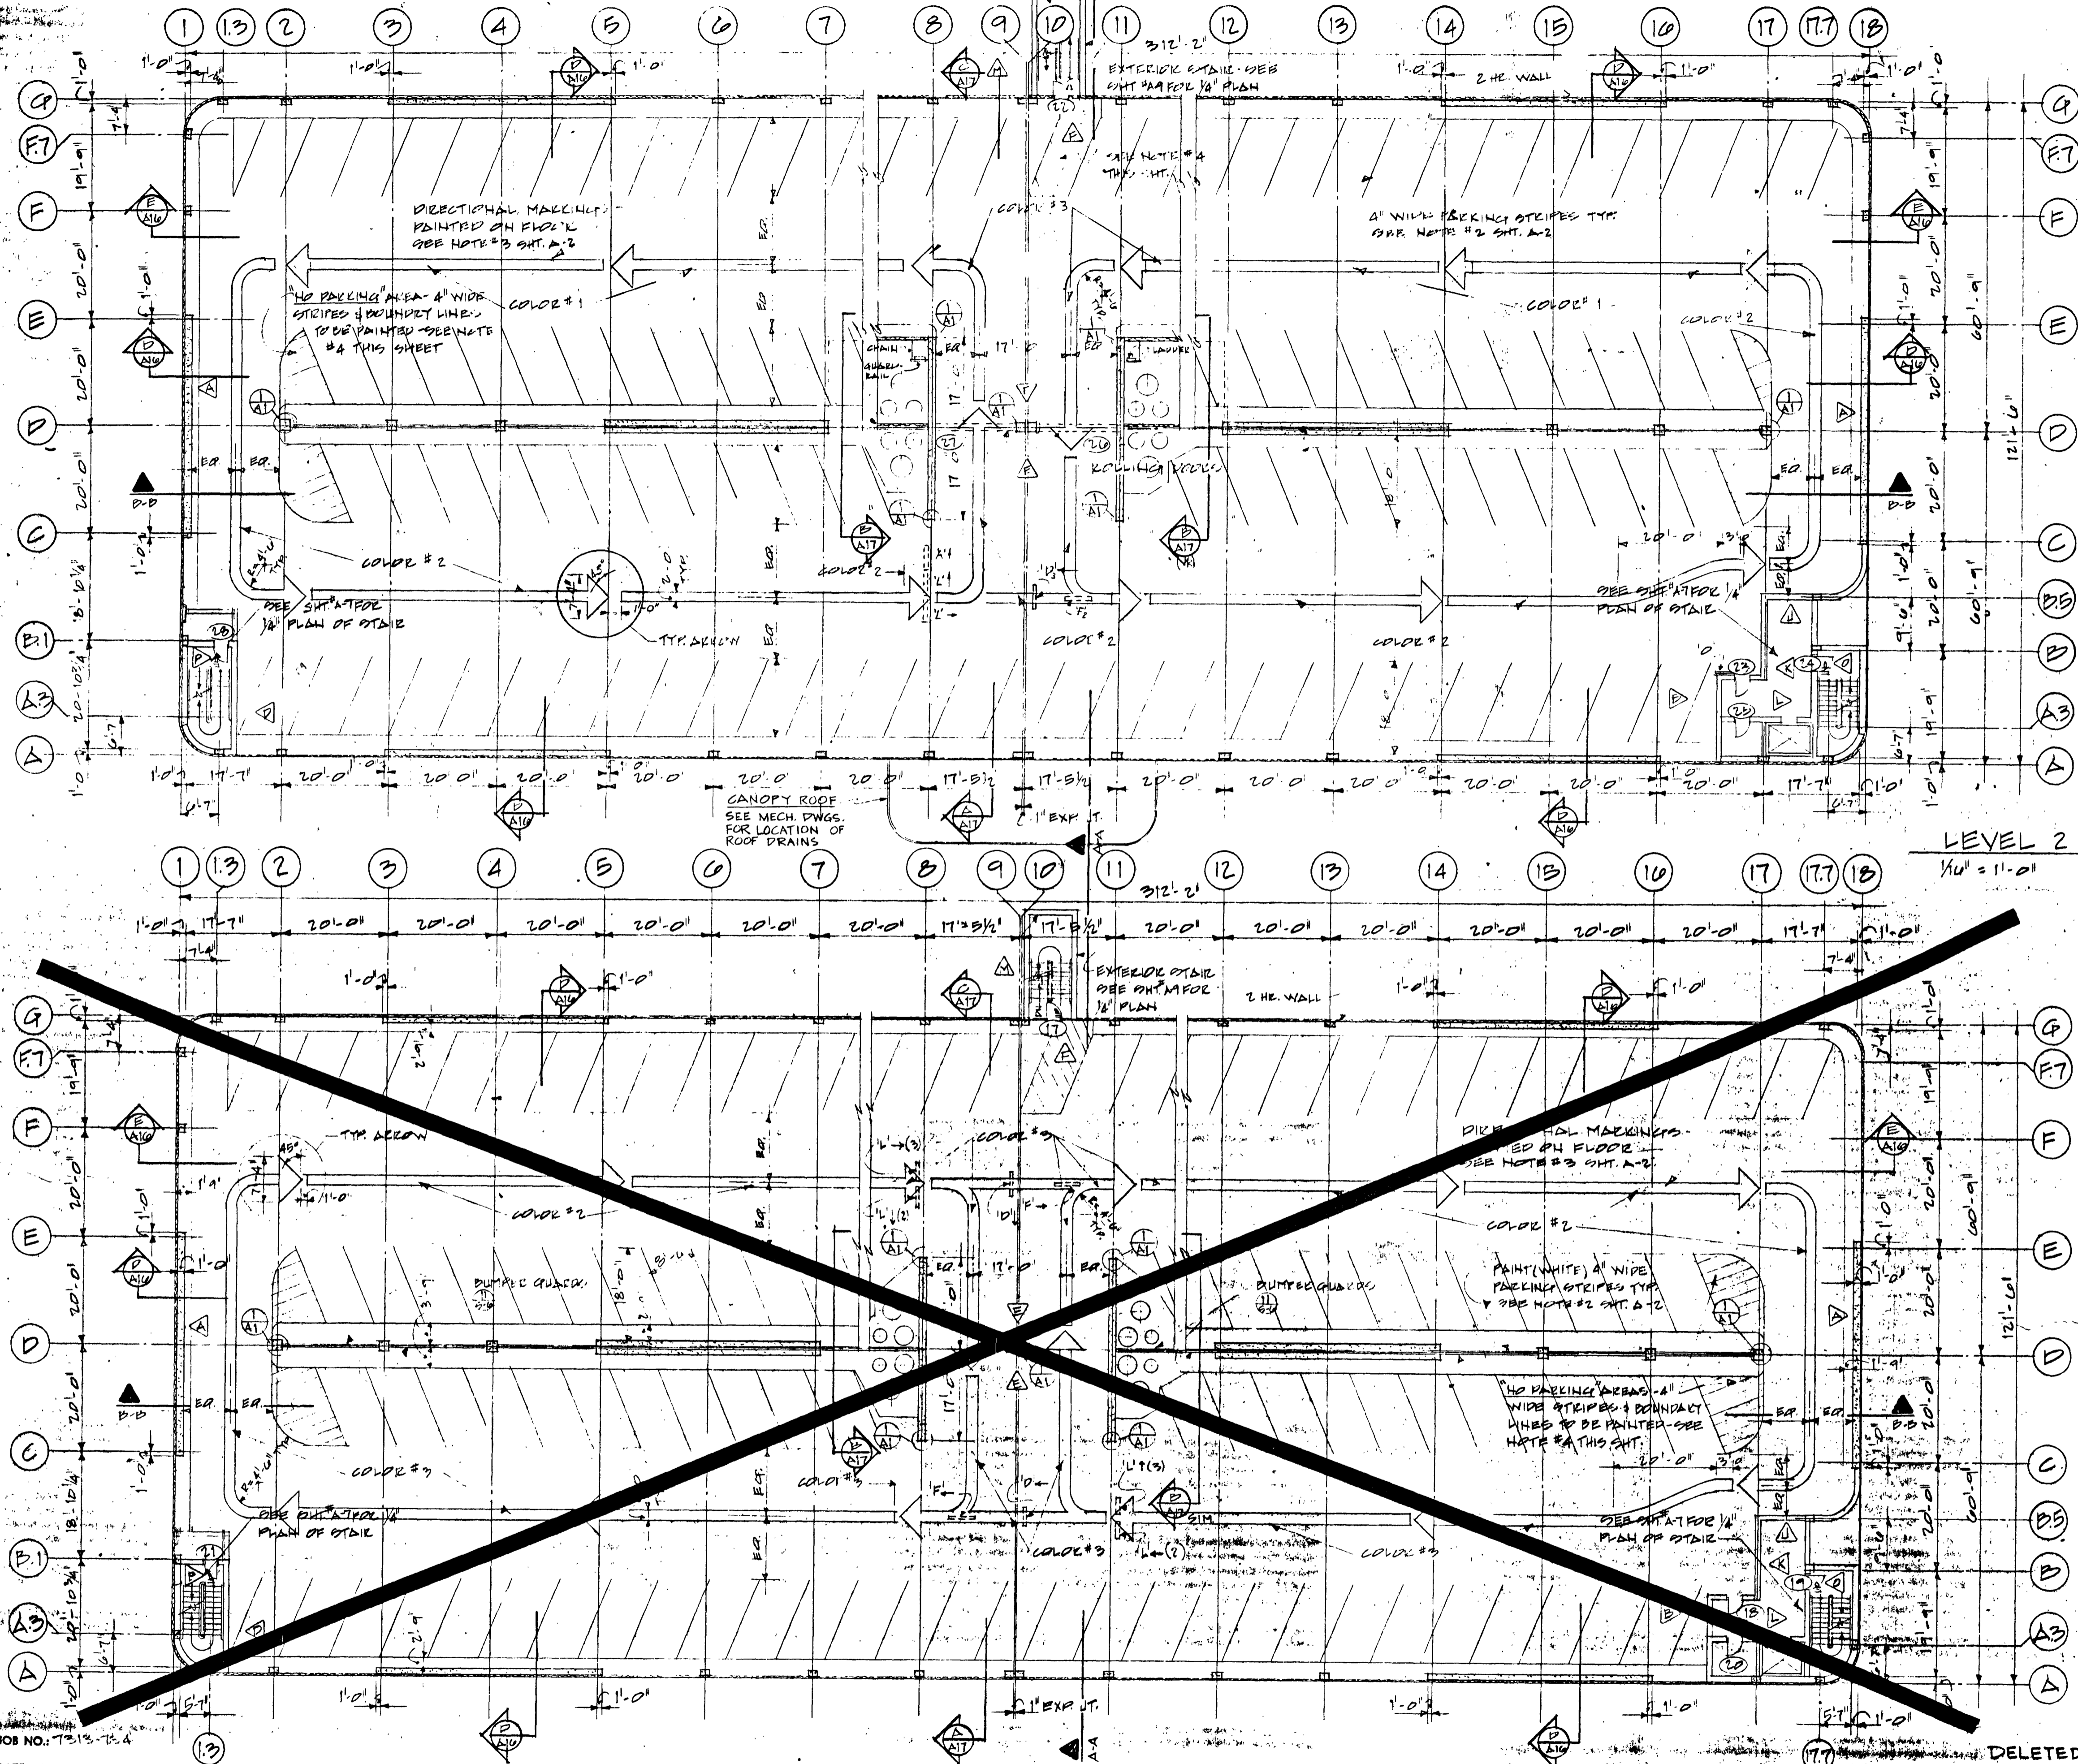

NOTES:


- 1) ALL WOOD DOORS SHALL BE GIVEN:
 - 1 COAT ENAMEL UNDERCOAT
 - 1 COAT 1/2 ENAMEL UNDERCOAT AND 1/2 ALKYD BAKR ENAMEL
 - 1 COAT ALKYL-PHENE ENAMEL
- 2) PARKING STRIPES PAINTED W/ "PAPCO" TRAFFIC LINE PAINT (WHITE NO. 8052) APPLY AS PER MFG. SPECIFICATIONS.
- 3) DIRECTIONAL MARKINGS PAINTED W/ "PAPCO" (OR EQUAL) TRAFFIC LINE PAINT (SPECIAL COLOURS) REQUIRED FOR EACH LEVEL - COLOURS TO MATCH SAMPLES SUBMITTED BY ARCHITECT
- 4) NO PARKING AREAS TO HAVE PAINTED STRIPES & BOUNDARY - USE "PAPCO" (YELLOW NO. 8053)

REF. SPEC. SECTION 03301, 12.14 & 7.1
 APPLY NON-SLIP ACCURATE (FRICTEX "H" OR EQUAL) TO ALL INTERIOR DRIVING SURFACES AND ENTRANCE DRIVEWAY. USE SPECIFIED 25#/100 FT² ALL AREAS EXCEPT PLACE 40#/100 FT² IN FOLLOWING LOCATIONS:
 1. ENTRANCE DRIVEWAY
 2. ENTRANCE AREA BETWEEN COLUMN LINES 1 & 2, 8 & 11, AND BETWEEN 17 & 18.
 3. 15'-0" WIDE STRIP ON ALL EDGES ALONG 4' OF DRIVING SURFACE

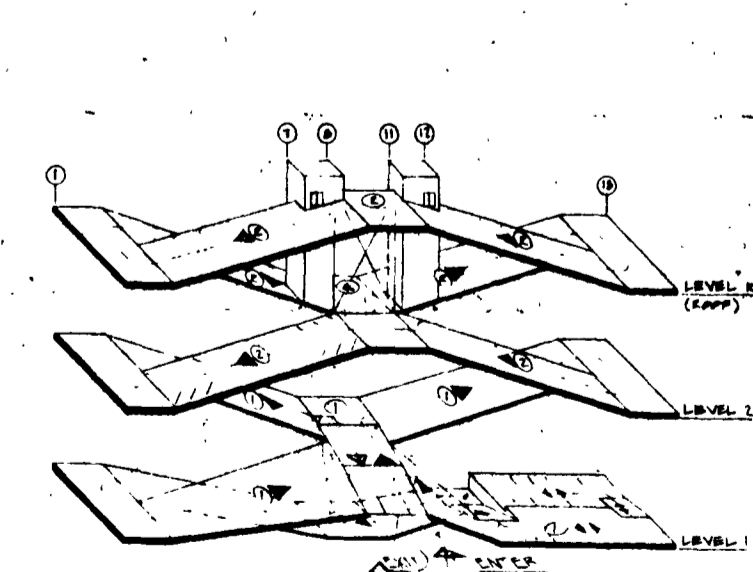

JOB NO: 7213-73.4
 DATE: 6-27-74

DELETED

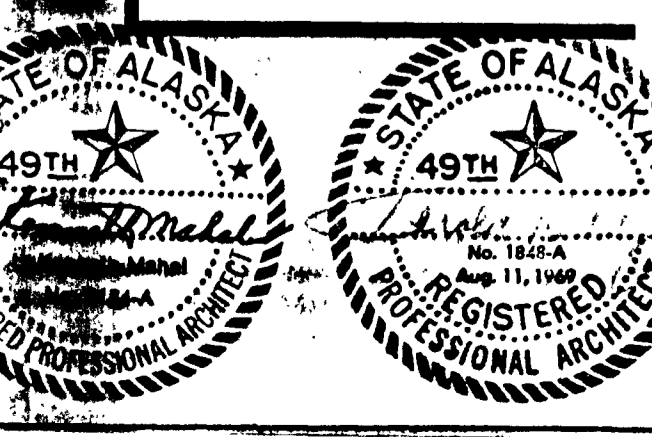

ARCHITECTS • ENGINEERS • SURVEYORS
 601 COLLEGE ROAD, FAIRBANKS, ALASKA 99701, PHONE: 452-1241

STATE OF ALASKA
 DEPT. OF PUBLIC WORKS
 DIVISION OF BUILDINGS
 JUNEAU ALASKA

FAIRBANKS PARKING STRUCTURE
 DBA - 2 - 0130
 FAIRBANKS, AK.

PETER KIEWIT SONS' CO.
 CONTRACTOR

A-2
 SHEET 5 OF 6

LEVEL 2 FLOOR PLAN

SIGN MARK	QTY.	DESCRIPTION	MOUNTING	REMARKS	SIGN MARK	QTY.	DESCRIPTION	MOUNTING	REMARKS	SIGN MARK	QTY.	DESCRIPTION	MOUNTING	REMARKS
A	1	18" x 42" SOLID ACRYLIC PLAS. PLACQUE W/STAMPED ON LETTERS (3"-BLACK) PLACQUE COLOR - WHITE (TRANSLUCENT)	DIACHROME BOLT SURFACE WALL MOUNT TO CONC.	SELF ILLUMINATED INCANDESCENT CRT ALUM. FLAME FINISH BLACK DURAMORIC INTERIOR	Q	2	18" x 42" SOLID ACRYLIC PLAS. PLACQUE W/STAMPED ON LETTERS (3"-WHITE) PLACQUE COLOR #10 (VOM&L)	LIQUID ADHESIVE ON CONC. BEAM	SEE SYMBOL TYPES SCHEDULE - THIS SHT.	M	1	18" x 42" SOLID ACRYLIC (TRANSLUCENT) PLAS. PLACQUE W/STAMPED ON LETTERS (3"-BLACK ALL CAPS) PLACQUE COLOR - WHITE	DIACHROME BOLT SURFACE WALL MOUNT TO CONC.	SELF ILLUMINATED INCANDESCENT CRT ALUM. FLAME FINISH BLACK DURAMORIC EXTERIOR
B	1	18" x 11" 0" - SOLID ACRYLIC PLAS. PLACQUE W/STAMPED ON LETTERS (3"-WHITE) PLACQUE COLOR #10 (BLUE/BLACK)	SUSPENDED TYPE 'A'	SEE SYMBOL TYPES SCHEDULE - THIS SHT. (DIM.)	H	2	STANDARD ALUMINUM YIELD SIGN			N	1	18" x 18" - SOLID ACRYLIC PLAS. BRACKETED PLACQUE - BLACK & WHITE PLACQUE COLOR #10 (VOM&L)	LIQUID ADHESIVE ON CONC. BEAM	SEE SYMBOL TYPES SCHEDULE - THIS SHT.
C	1	18" x 12" 0" - MATERIAL, ETC. SAME AS SIGN 'B' ABOVE			J	2	18" x 42" (1) EACH (1) EACH MATERIAL, ETC. SAME AS SIGN 'Q' ABOVE	SUSPENDED TYPE 'A'	SEE SYMBOL TYPES SCHEDULE - THIS SHT.	O	12	12" x 12" - SOLID ACRYLIC PLAS. BRACKETED PLACQUE - BLACK & WHITE PLACQUE COLOR #10 (VOM&L)	FRAM MOUNTED TAPE ON PLASTER	
D	4	(2) EACH 18" x 42" - SOLID ACRYLIC PLAS. PLACQUE W/STAMPED ON LETTERS (3"-WHITE) PLACQUE COLOR #10 (BLUE/BLACK)	LIQUID ADHESIVE ON CONC. BEAM		K	2	18" x 42" (1) EACH (1) EACH MATERIAL, ETC. SAME AS SIGN 'Q' ABOVE	LIQUID ADHESIVE ON CONC. BEAM		P	1	10" x 42" ALUM. FREE SWINGING SIGN PAINTED AS NOTED (3" BLACK LETTERS (VINYL DIE CUT)	SECURE HANGARS TO MET. FRAMING CHANNELS IN EXIST. SIGN TO EX. FLS SWINGING	
E	1	(1) EACH 18" x 42" - MATERIAL, ETC. SAME AS SIGN 'D' ABOVE			L	3	(1) EACH (1) EACH (1) EACH MATERIAL, ETC. SAME AS SIGN 'Q' ABOVE	LIQUID ADHESIVE ON CONC. BEAM		O	4	30" x 42" SOLID ACRYLIC PLAS. PLACQUE W/STAMPED ON LETTERS (3"-WHITE) PLACQUE COLOR #10	LIQUID ADHESIVE ON CONC. COLUMNS	SEE SYMBOL TYPES SCHEDULE - THIS SHT. FOR MOUNTING & LETTER SIZES
F	3	(2) EACH 18" x 42" - MATERIAL, ETC. SAME AS SIGN 'D' ABOVE	SUSPENDED TYPE 'A'	SEE SYMBOL TYPES SCHEDULE - THIS SHT.										

GENERAL NOTES:

- ALL ORDER NUMBERS BY VOM&L INDUSTRIES
- ALL TYPE STYLE TO BE HELVETICA MEDIUM W/ "TIGHT" SPACING - CAPS & LOWER CASE AS INDICATED ON SCHEDULE
- ALL PLACQUES 100 SERIES (UNFOAMED) UNLESS OTHER WISE NOTED - CORNERS TO BE SQUARE
- BOTTOM EDGE OF SIGNS AT BOTTOM EDGE OF BEAM. TYP. (APPHES. & SUSP. MOUNT.)
- SUBMIT SHOP DRAWINGS OF ALL SIGNS TO ARCHITECT FOR REVIEW

COLOR SCHEDULE

LEVEL	COLOR #	HUE
L (LOWEL)	10	
1	1	SEE SYMBOL TYPES SCHEDULE
2	2	SEE SYMBOL TYPES SCHEDULE
R (ROOF)	3	

1. COLOR #S REFER TO WALL GRAPHIC. & FLOOR ALLOW. (SEE ELEV. & F.L. PLANS FOR LAYOUT.)

2. PAINT ALL PARKING STRIPES WHITE - SEE NOTE # 2 SHT. A-2



GRAY ROGERS MYERS & TORGAN

A DIVISION OF ELLERBE

SIGN MOUNTING TYPES

1. COLOR #S REFER TO WALL GRAPHIC. & FLOOR ALLOW. (SEE ELEV. & F.L. PLANS FOR LAYOUT.)

2. PAINT ALL PARKING STRIPES WHITE - SEE NOTE # 2 SHT. A-2

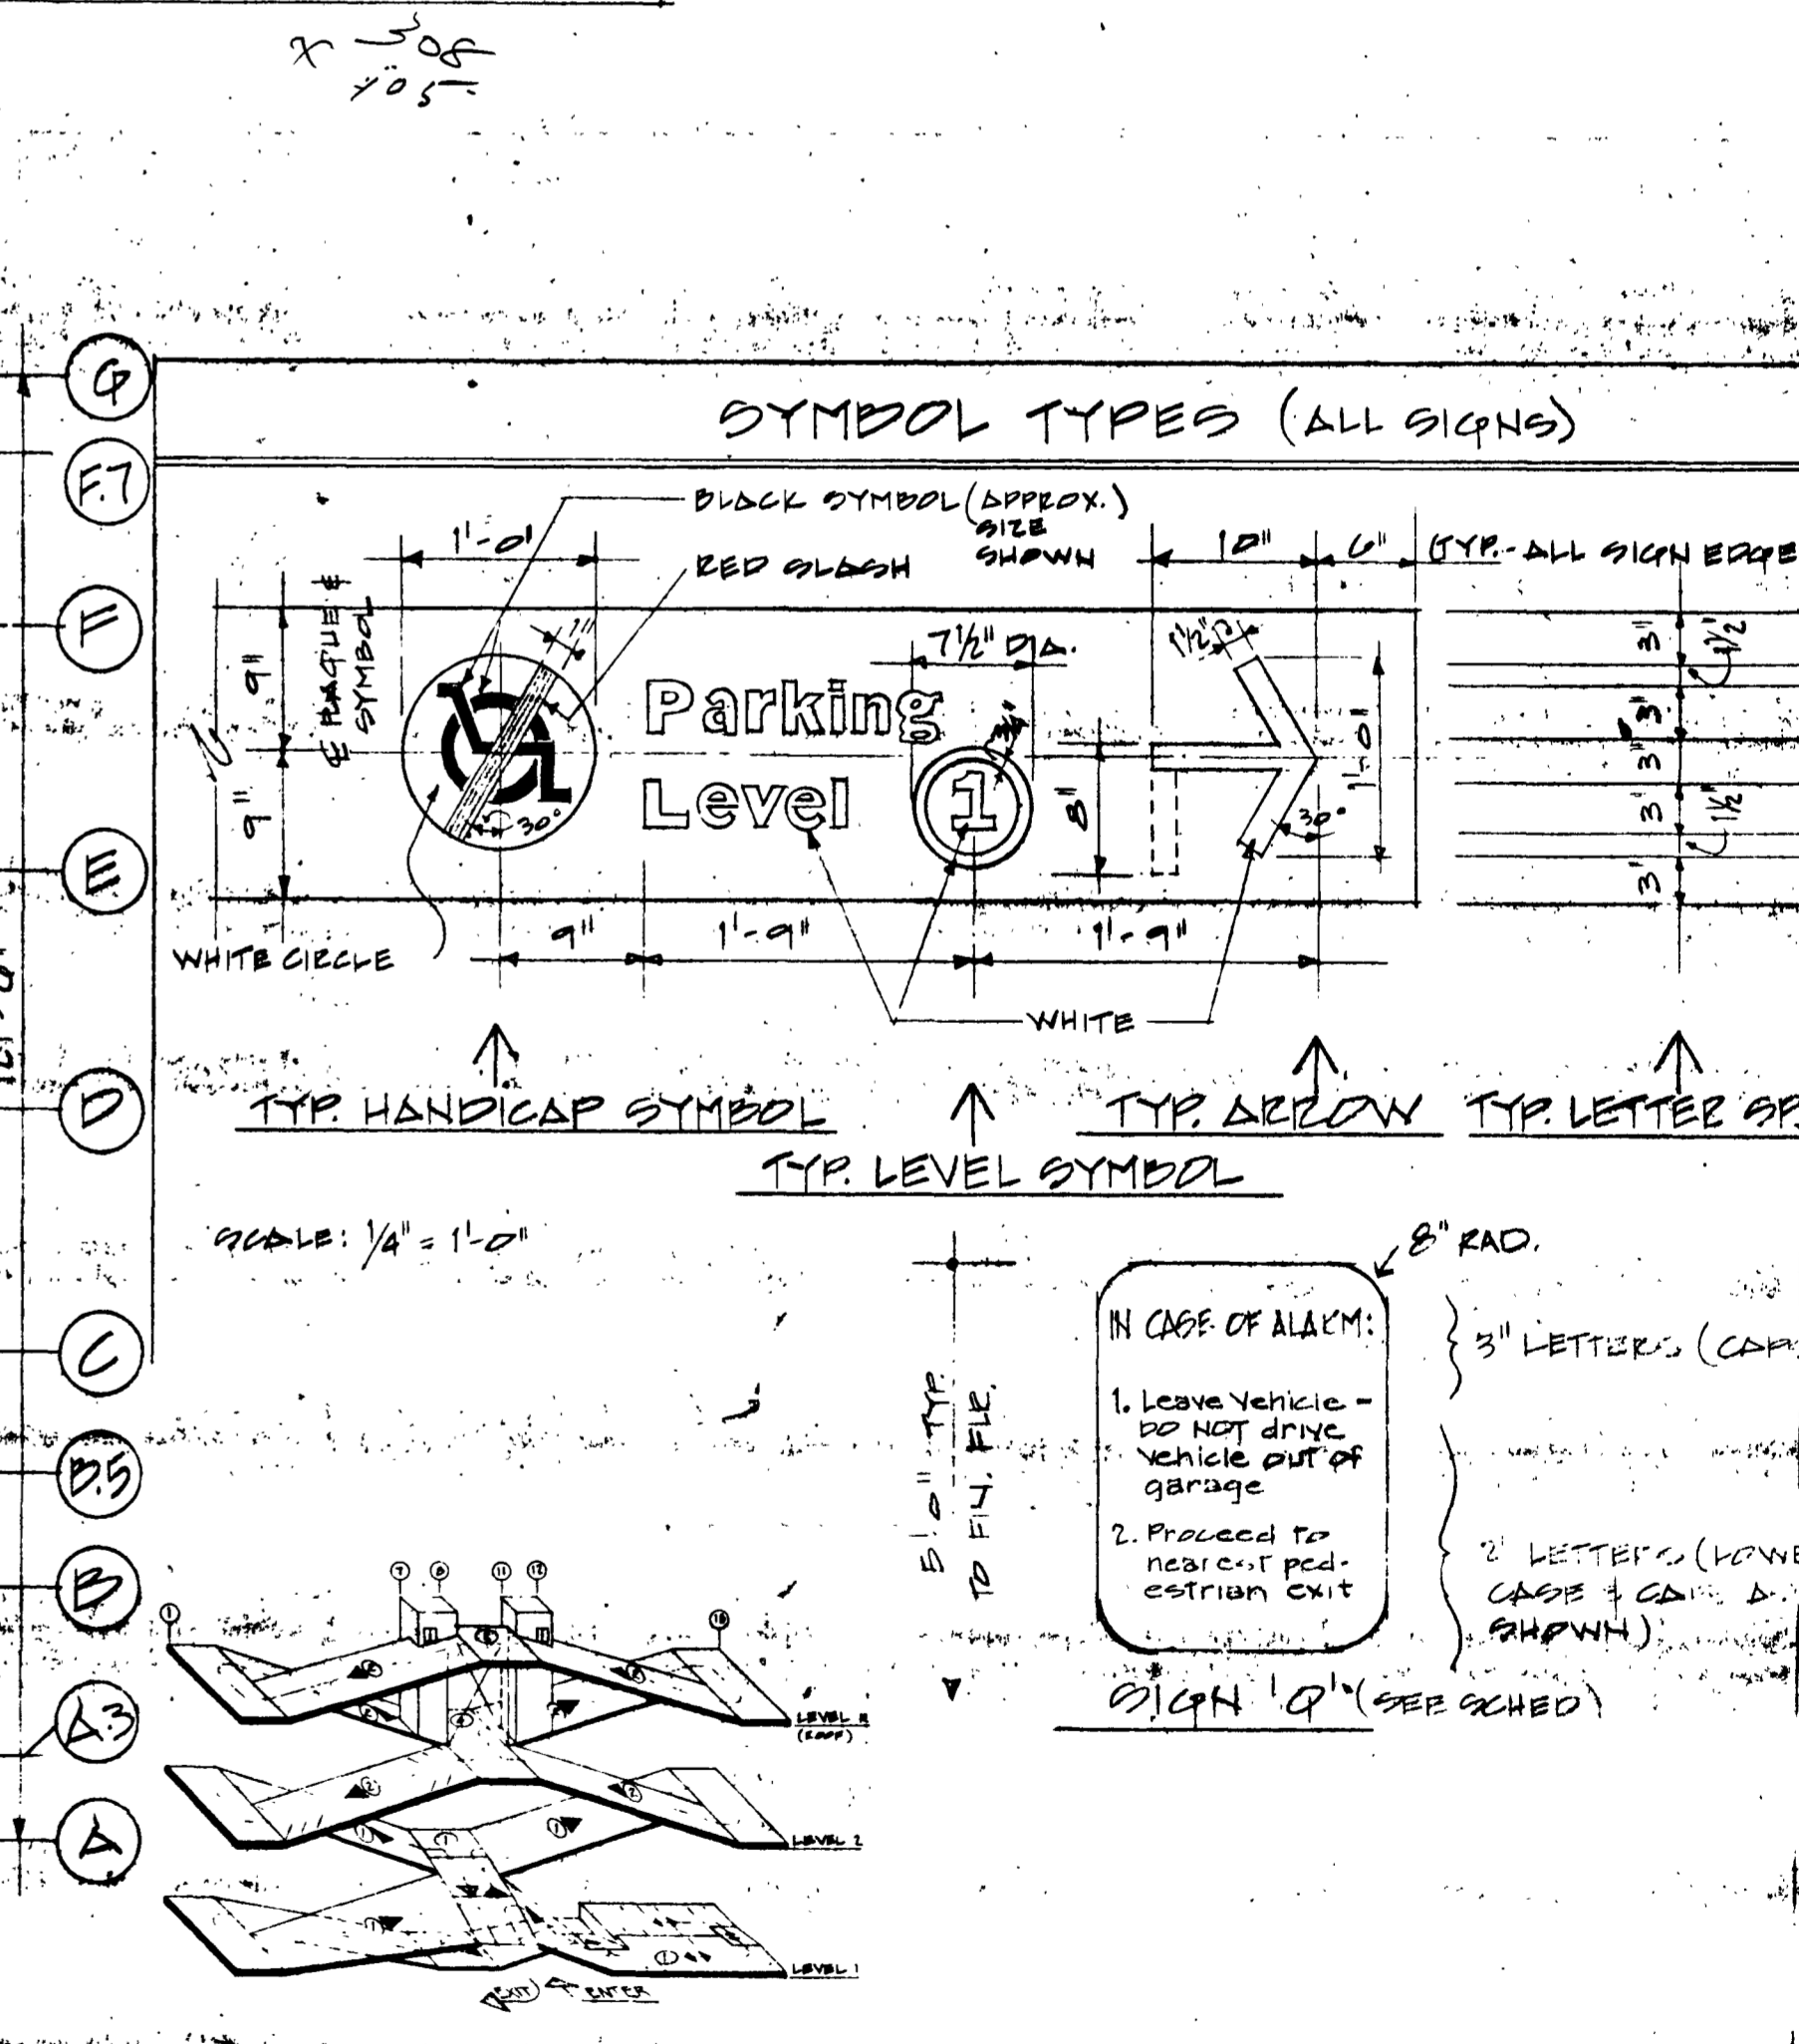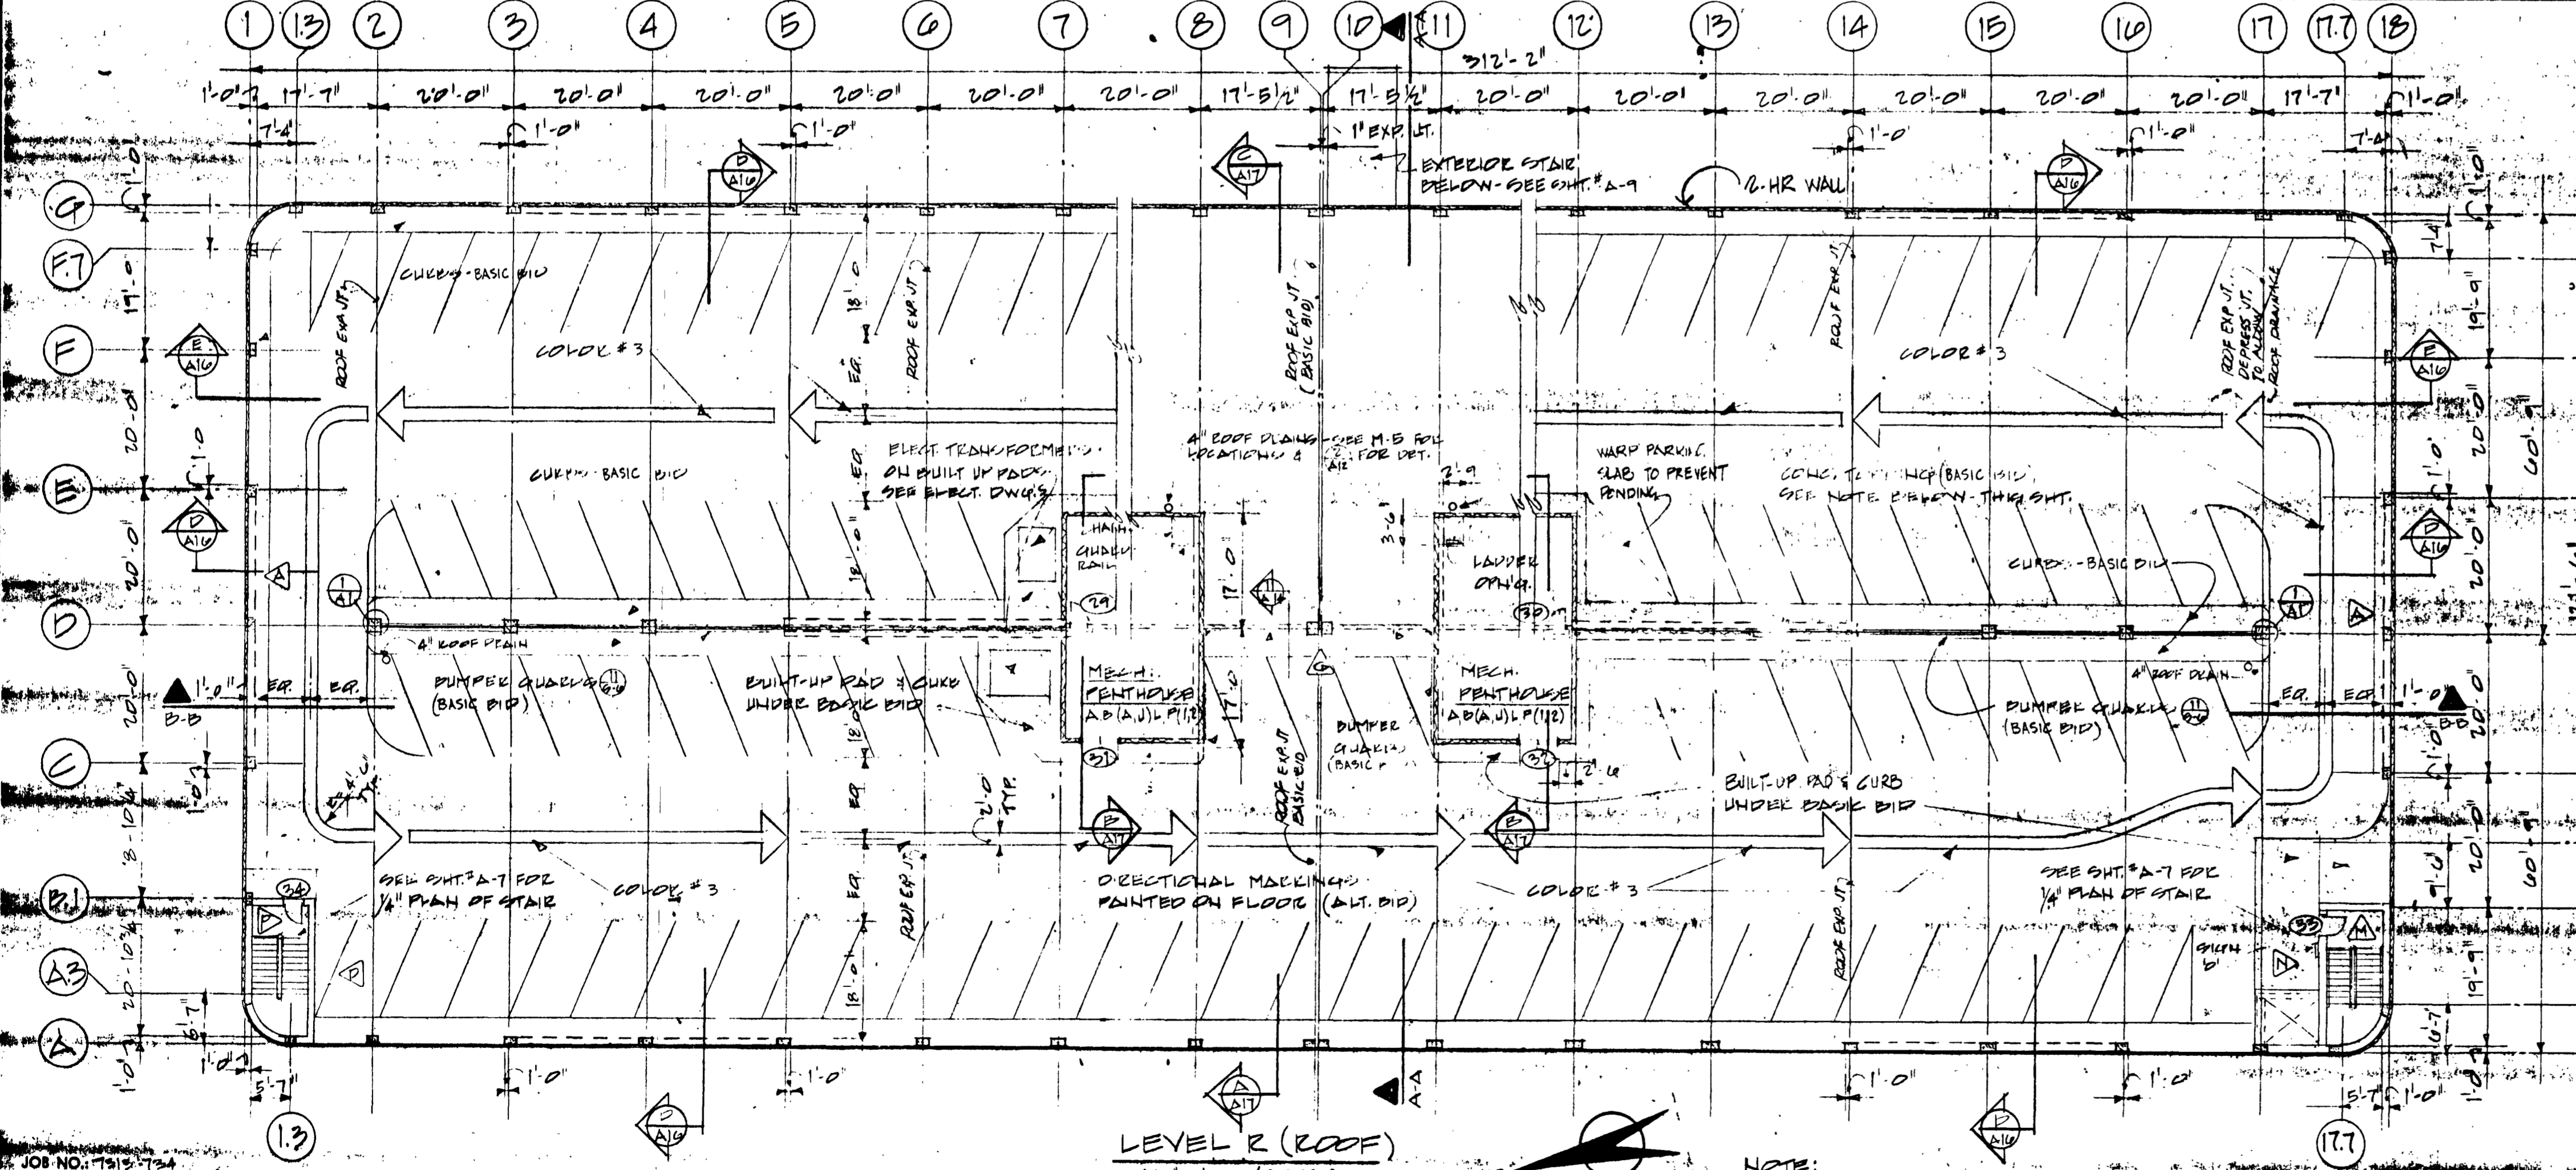

ARCHITECTS • ENGINEERS • SURVEYORS
101 COLLEGE ROAD, FAIRBANKS, ALASKA 99701, PHONE: 452-1241

STATE OF ALASKA
DEPT. OF PUBLIC WORKS
DIVISION OF BUILDINGS
JUNEAU ALASKA

FAIRBANKS PARKING STRUCTURE




FAIRBANKS, AK.

DBA - 2 - 0130

PETER KIEWIT SONS' CO.
ALASKA

DATE: 11/10/84

AS-BLT SHEET 6 OF 6

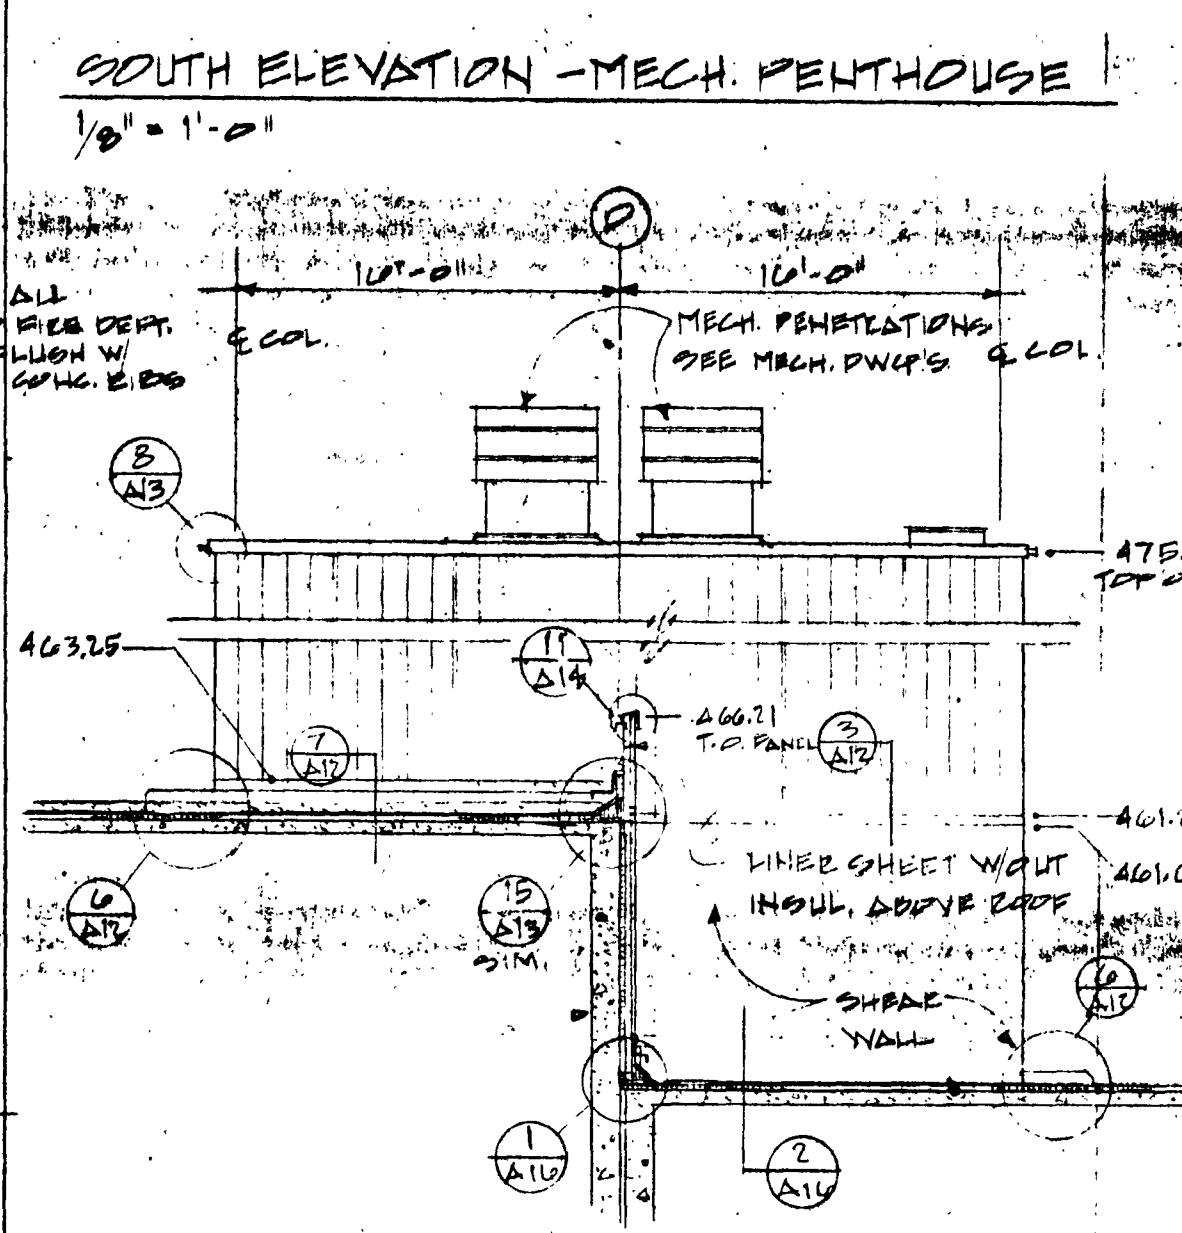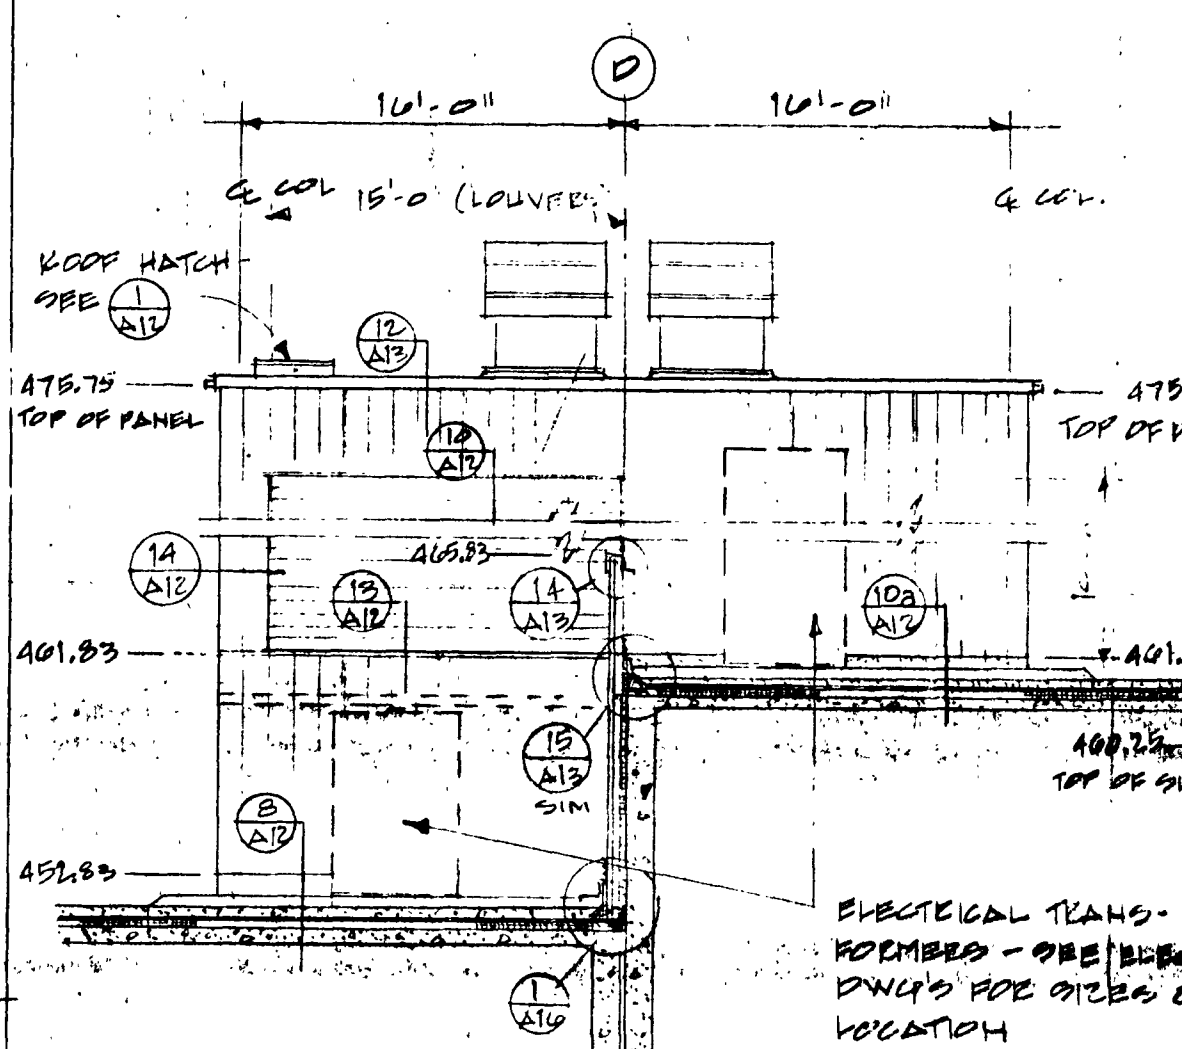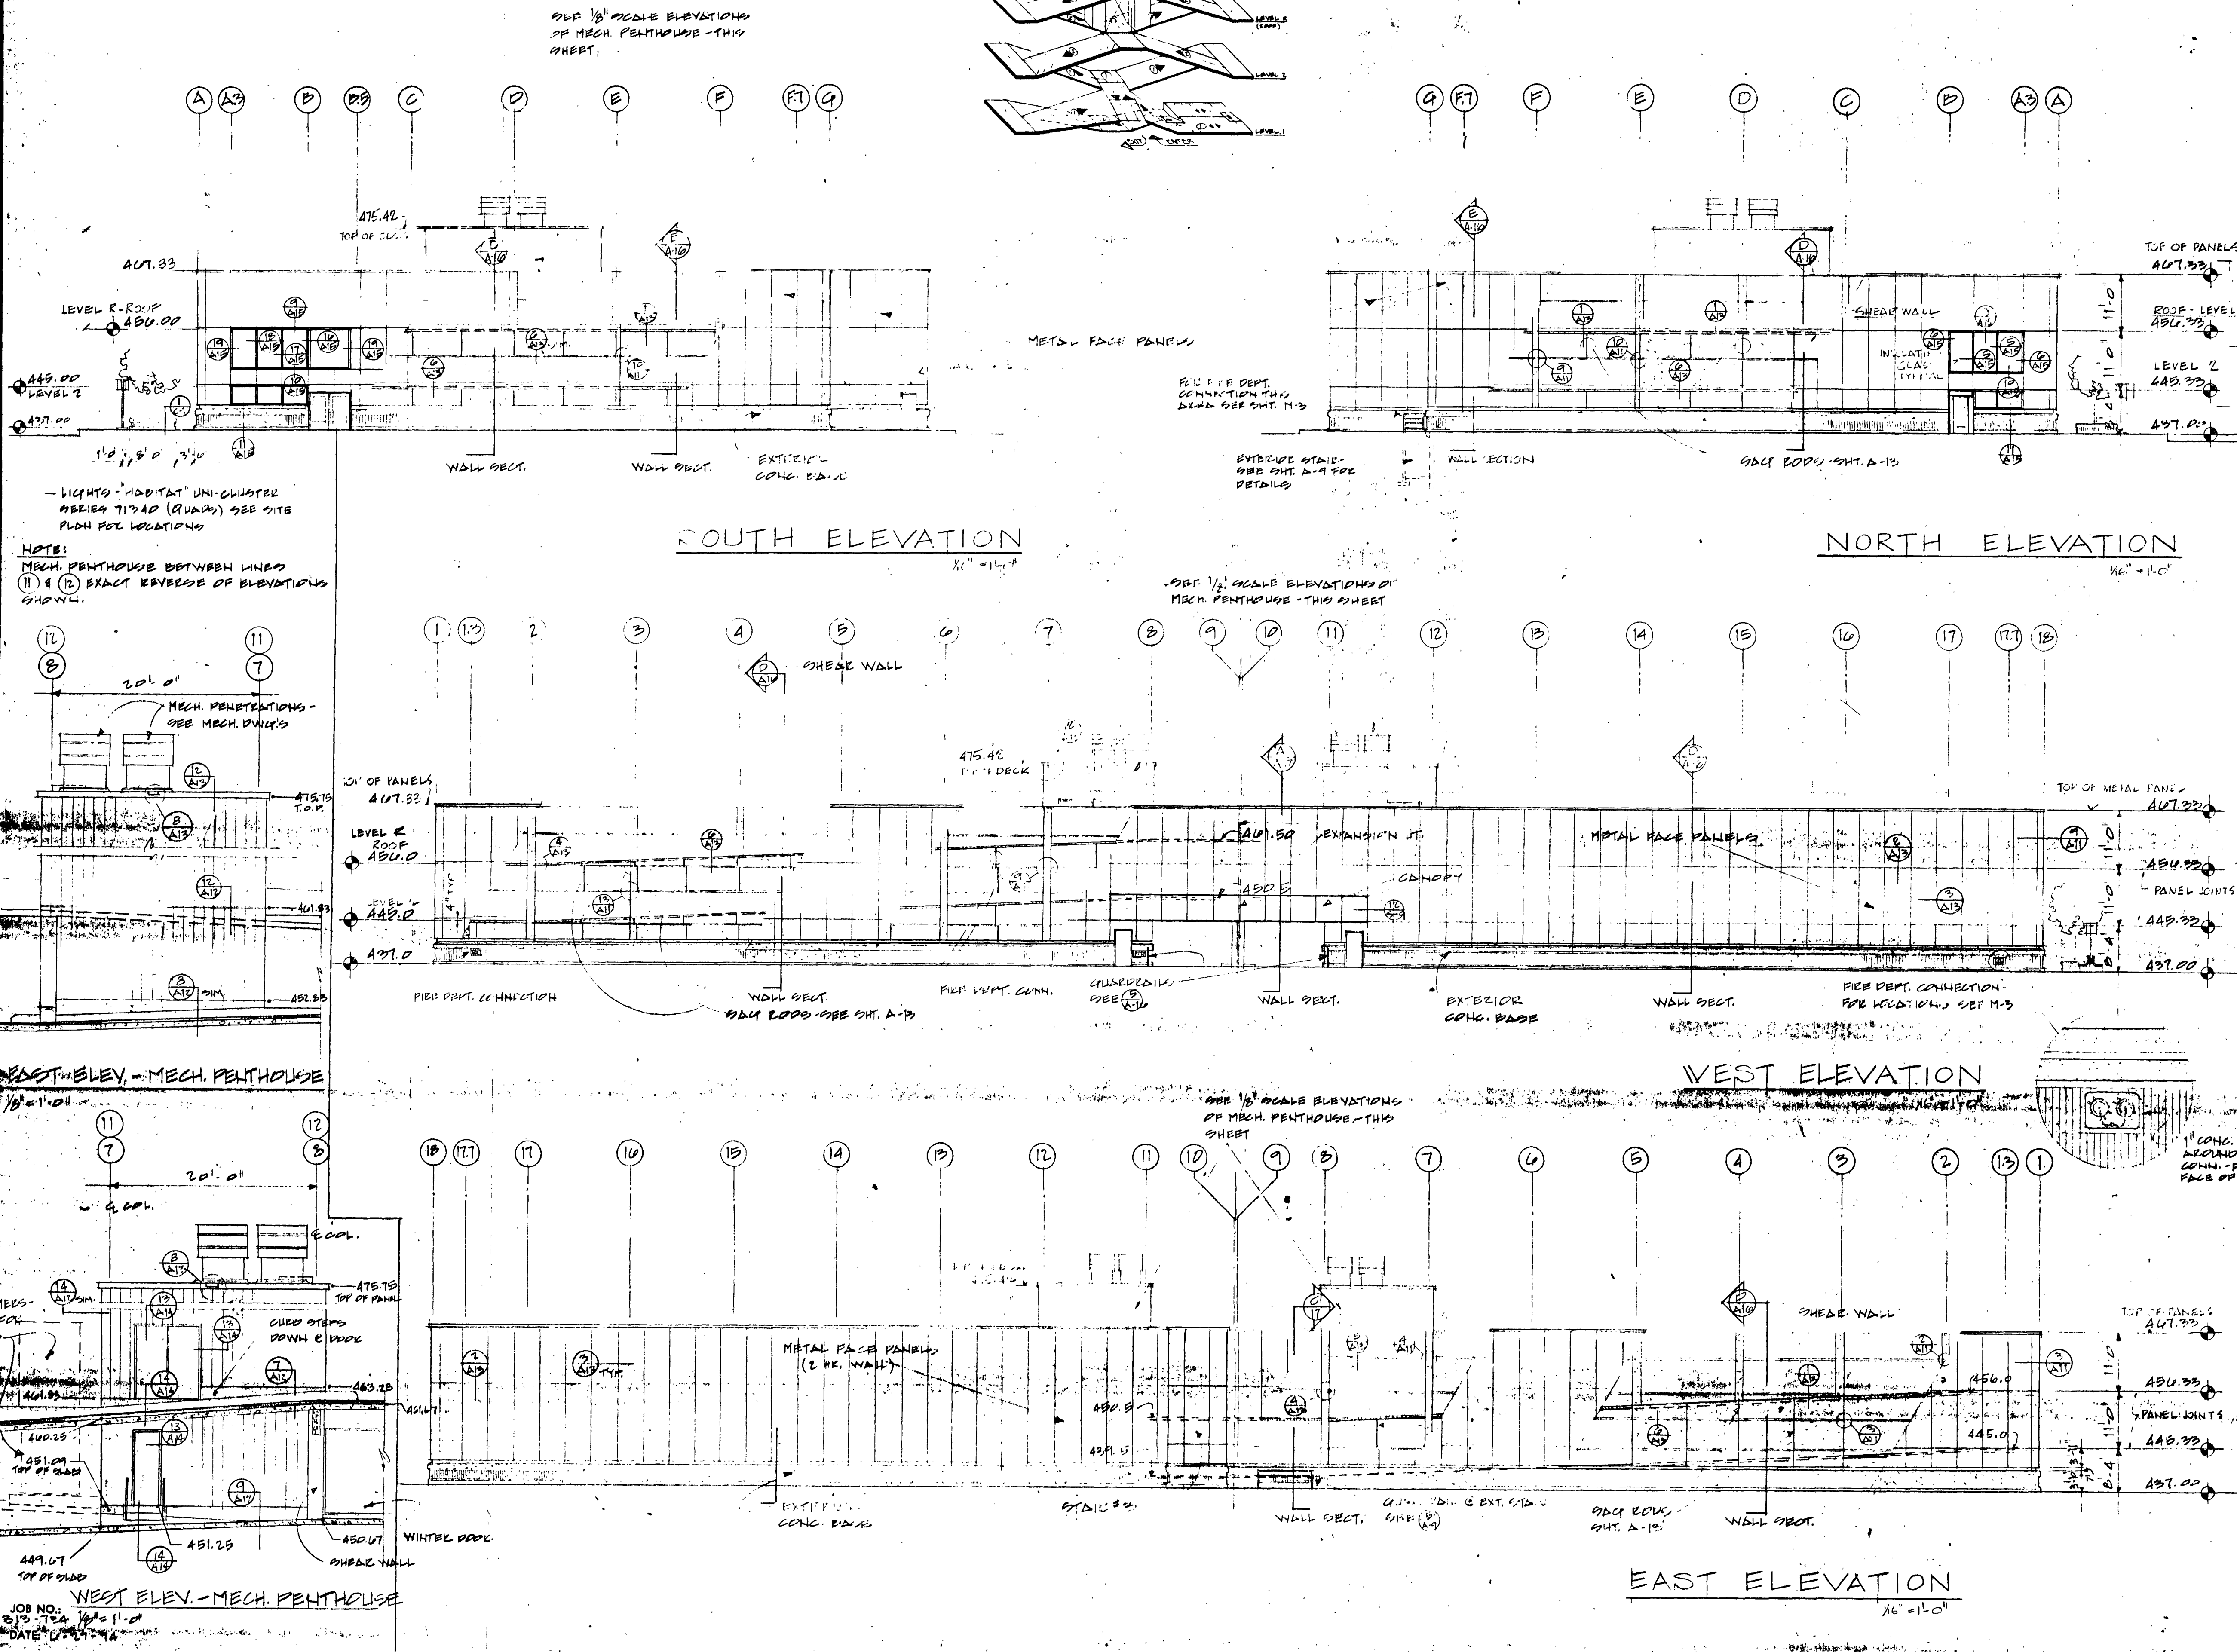

ARCHITECTS • ENGINEERS • SURVEYORS
 101 COLLEGE ROAD, FAIRBANKS, ALASKA 99701, PHONE: 452-1241

STATE OF ALASKA
 DEPT. OF PUBLIC WORKS
 DIVISION OF BUILDINGS
 JUNEAU ALASKA

STATE OF ALASKA
 49th Anniversary
 REGISTERED PROFESSIONAL ARCHITECT

JOB NO. 17615
 DATE 12/24/64

FAIRBANKS PARKING STRUCTURE

DBA - 2 - 0130
 FAIRBANKS, AK.

EXTERIOR ELEVATIONS

WATER MANLEY SONS CO.
 FAIRBANKS, ALASKA

DATE: _____

AS-BLT



A-4

SHEET 7 OF 49

GRAY ROGERS MYERS & PORGAN


A DIVISION OF ELLERBE

WHERE TEES ARE REQUIRED IN THE EXPANSION JOINT SYSTEM, THE EXP. JOINT MUST CONFORM TO THE DESIGN AND DIMENSIONS SHOWN BELOW. PROVIDE STANDARD END TERMINATION COVERS AT PERIMETER OF ROOF. 1" X 1/2" NEOPRENE SHEET ON TOP OF ROOFING. 2 ADDITIONAL FEET OVER NEOPRENE.

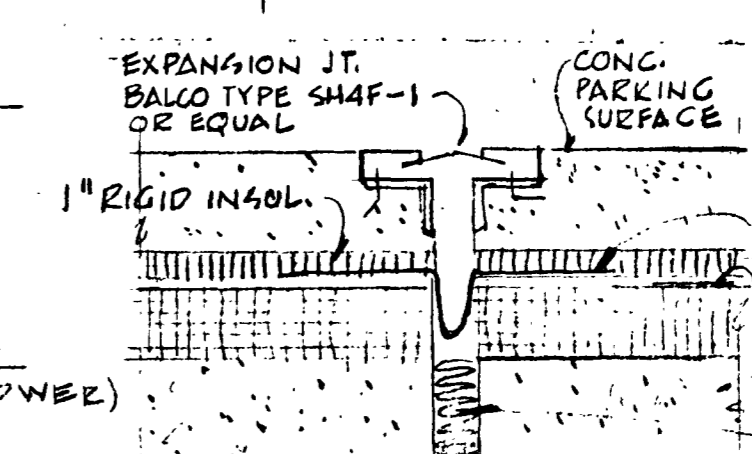
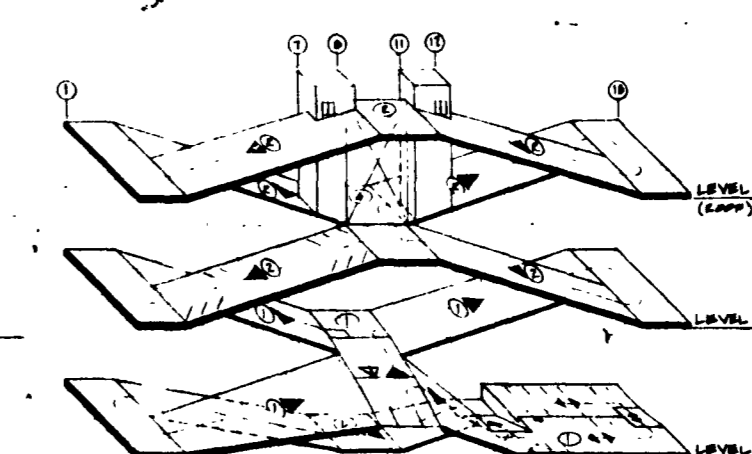


1 ROOF EXP. JT. - BASIC BID
1/2" = 1"

2 ROOF EXP. JT. - BASIC BID
1" = 1"

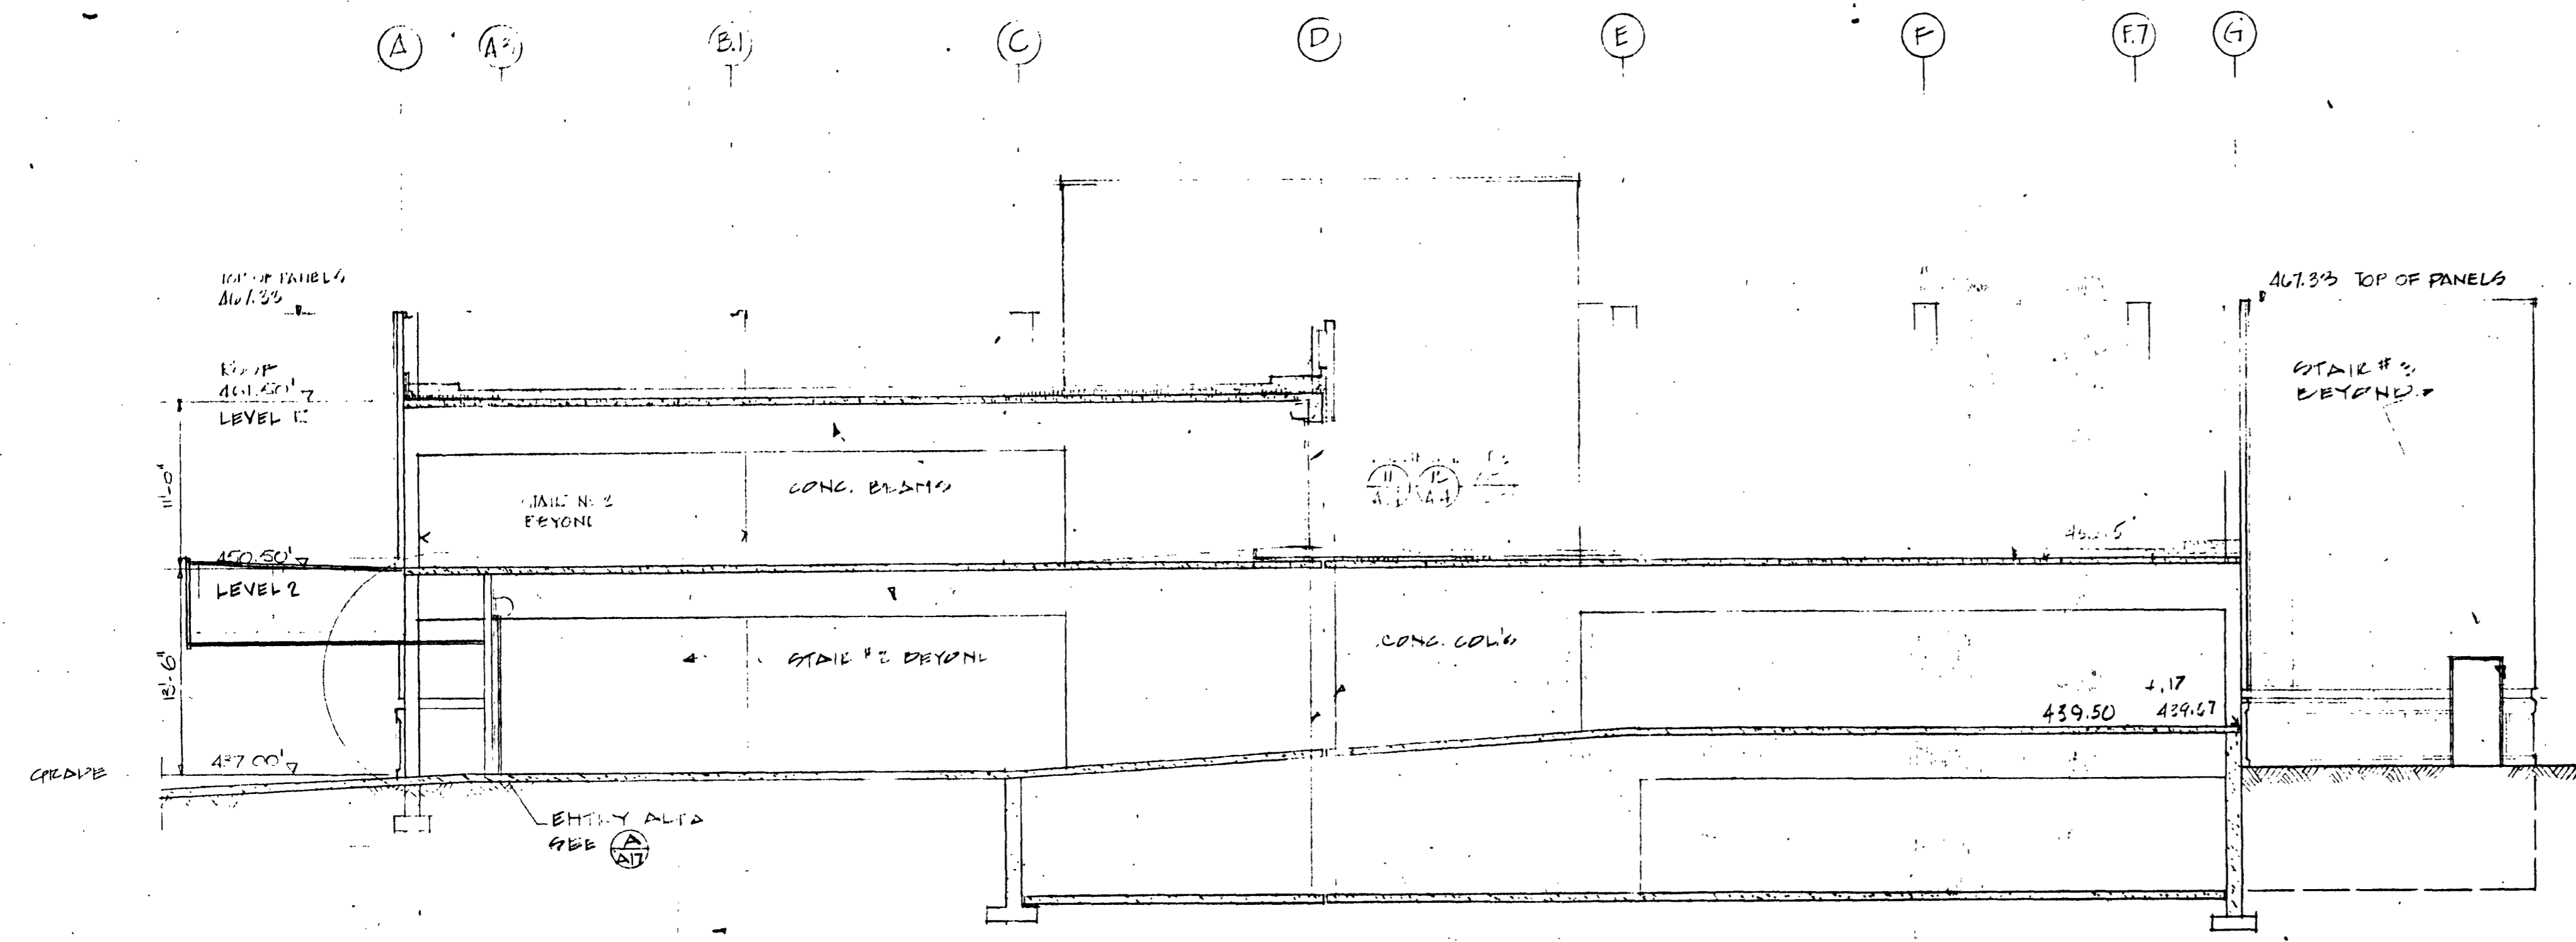

BUILDING SECTION A-A
1/2" = 1'-0"

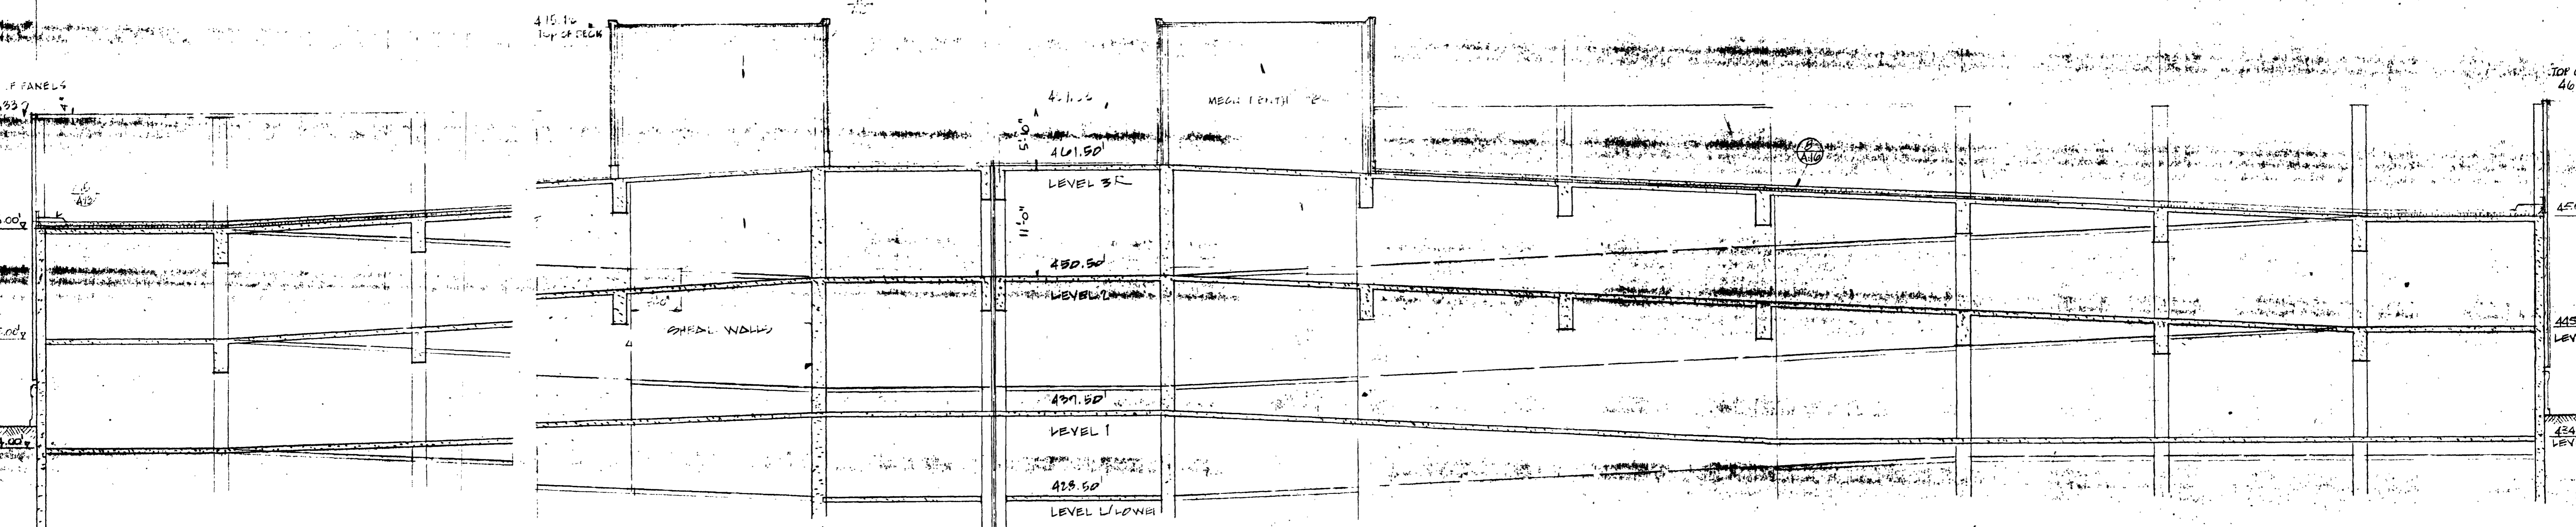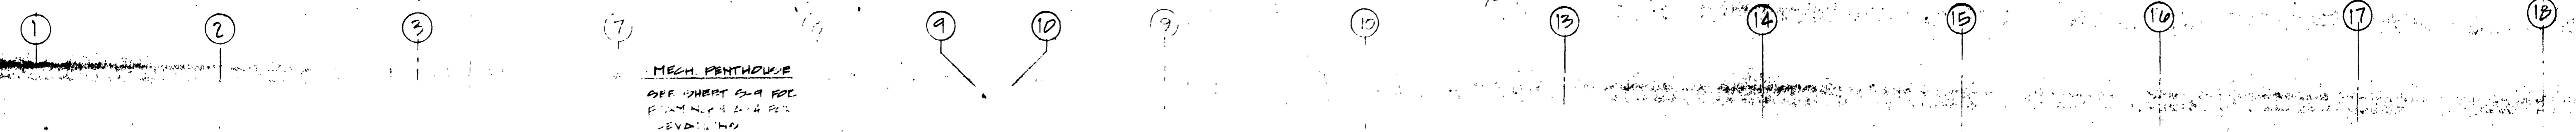

BUILDING SECTION B-B
1/2" = 1'-0"

JOB NO: 7313-734
DATE: 6-27-74

ARCHITECTS - ENGINEERS - SURVEYORS
401 COLLEGE ROAD, FAIRBANKS, ALASKA 99701, PHONE: 452-1241


STATE OF ALASKA
DEPT. OF PUBLIC WORKS
DIVISION OF BUILDINGS
JUNEAU ALASKA

FAIRBANKS PARKING STRUCTURE
FAIRBANKS, AK.
DBA - 2 - 0130



PETER KIEWIT SONS' CO.

A-5














SHEET 8 OF 49

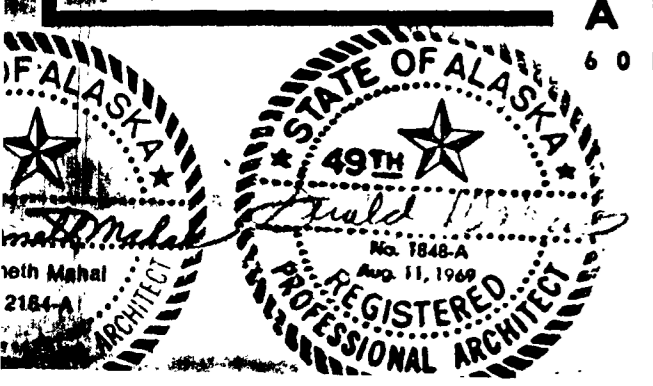

12-29-16

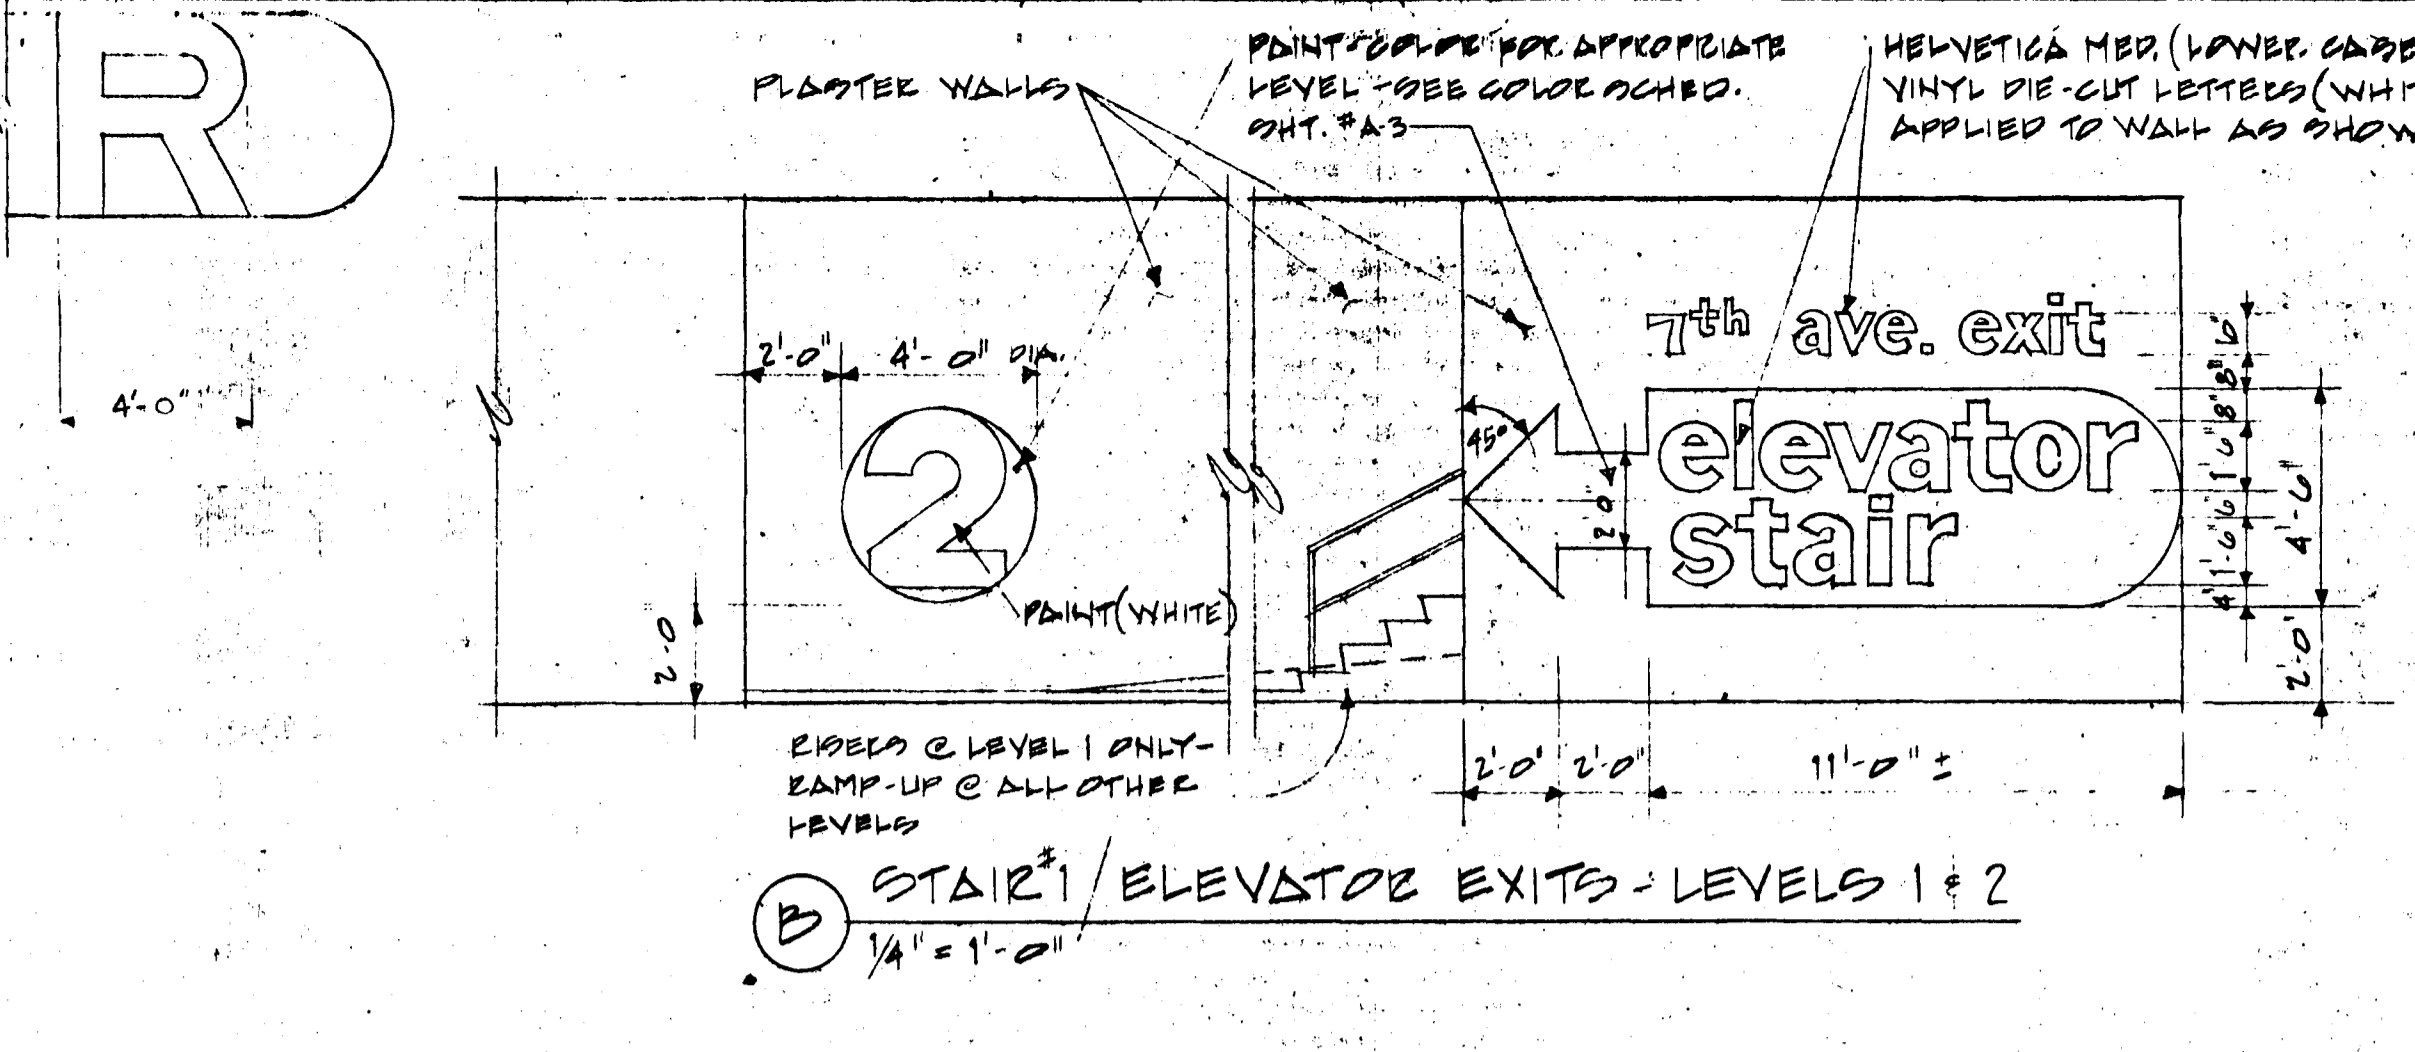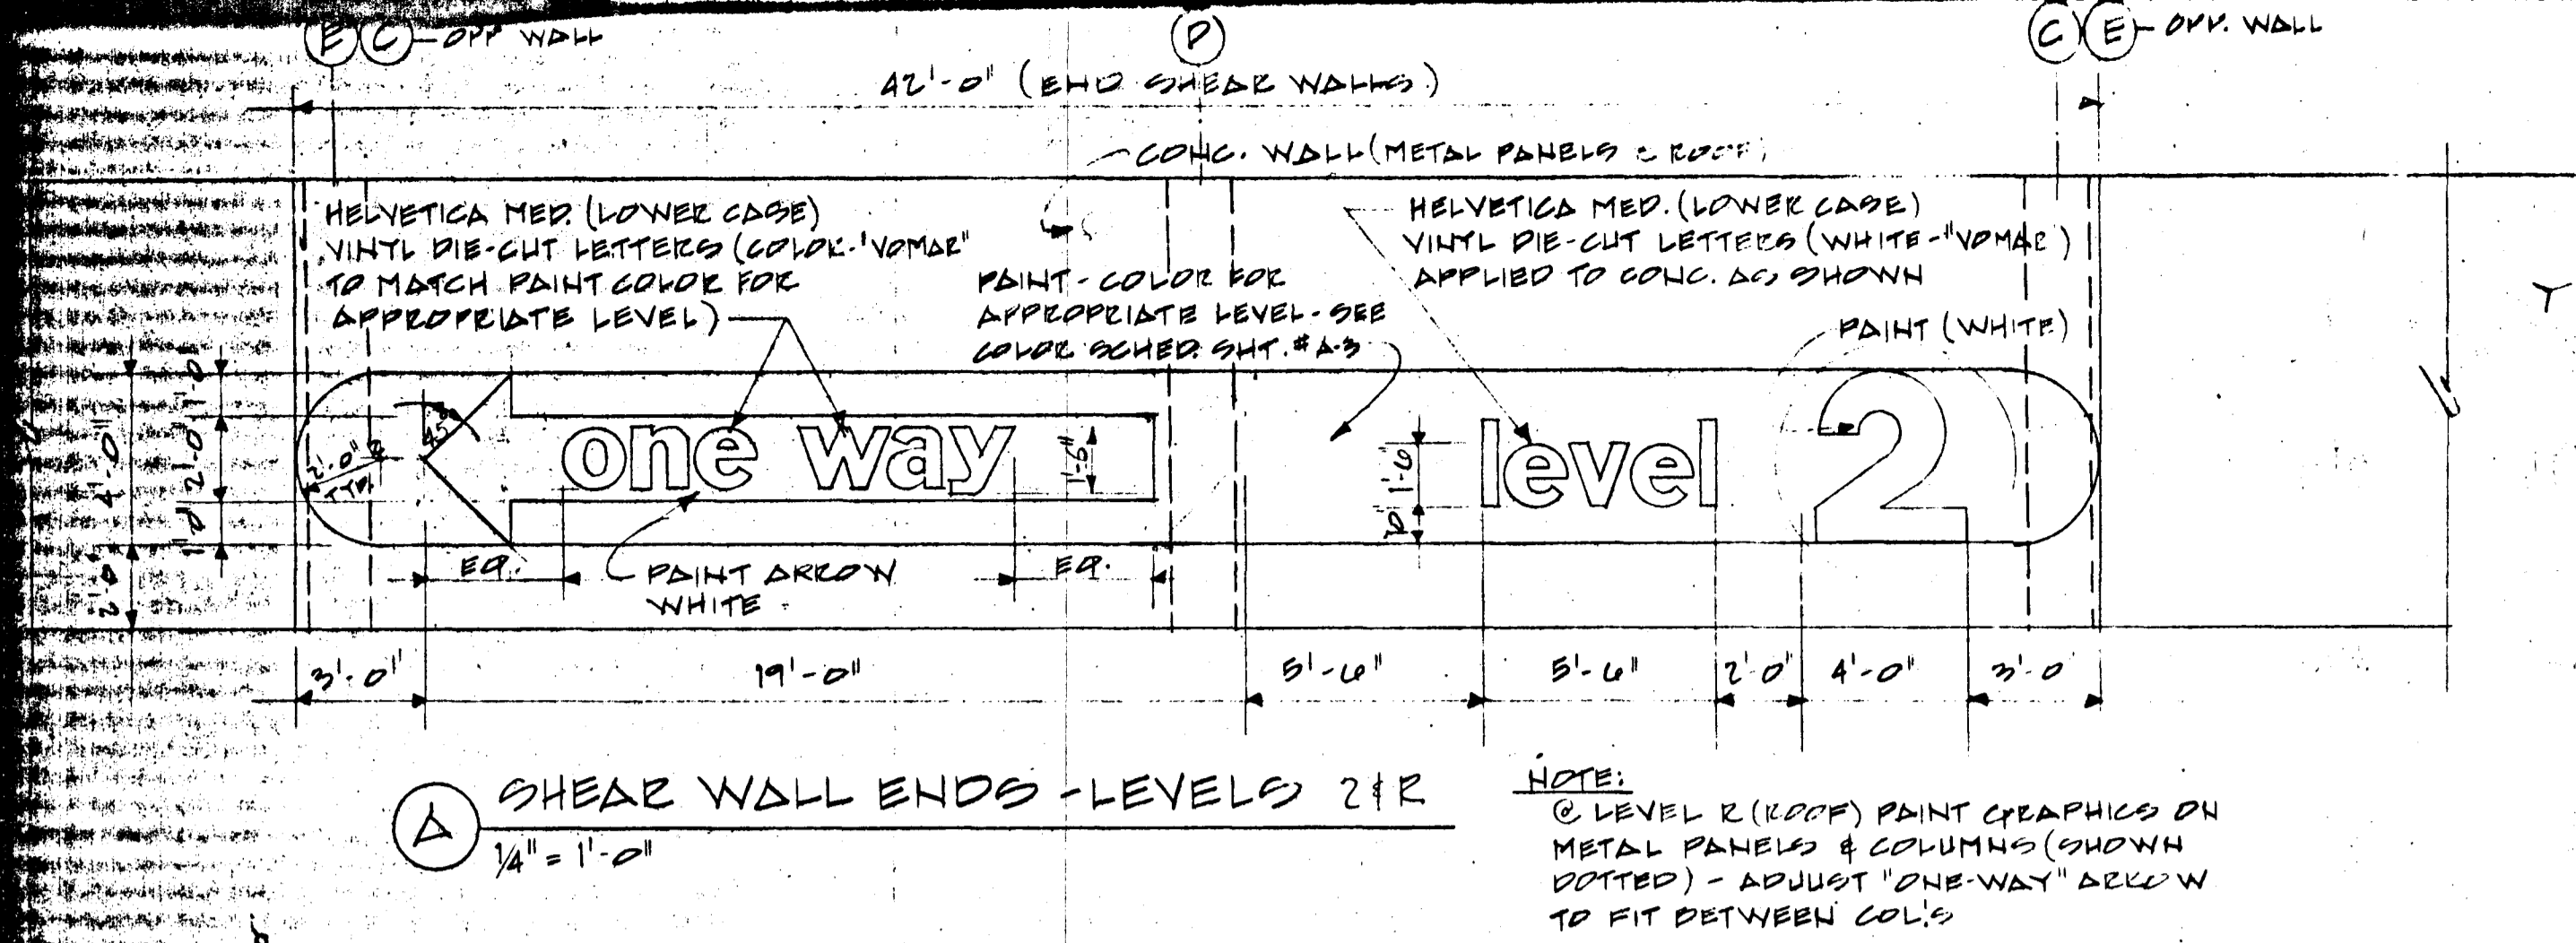


GRAY ROGERS MYERS & TORGAN

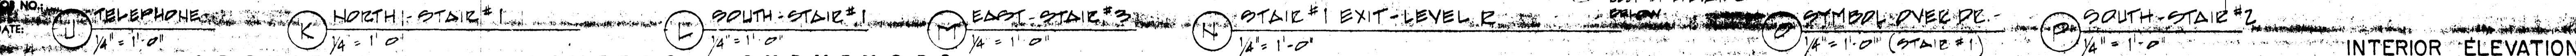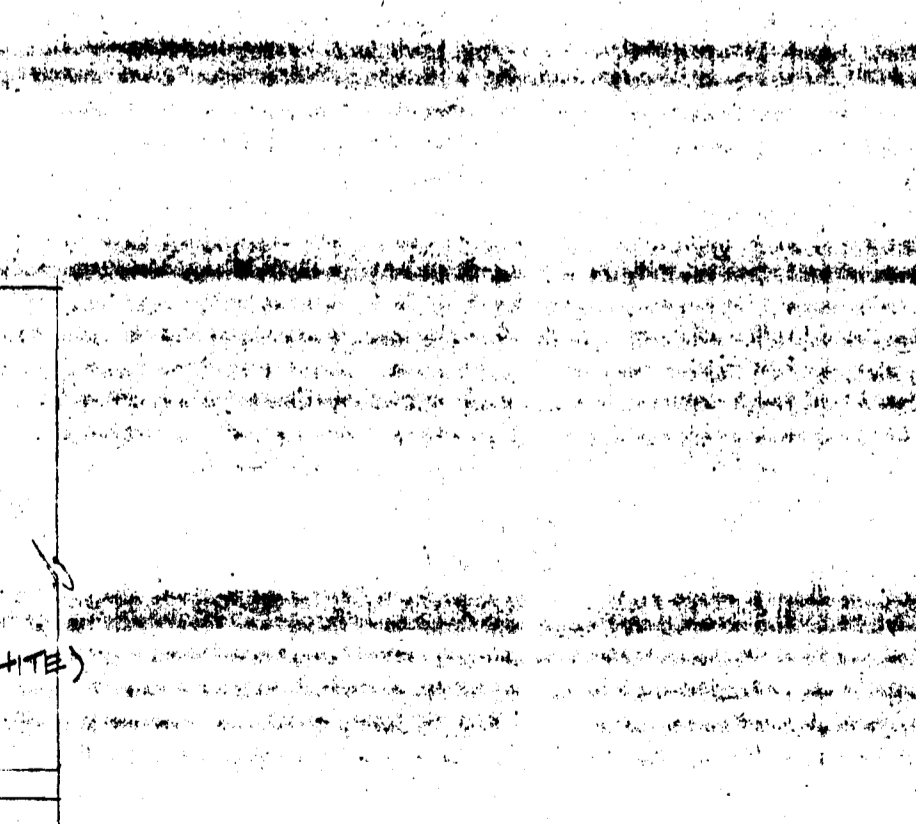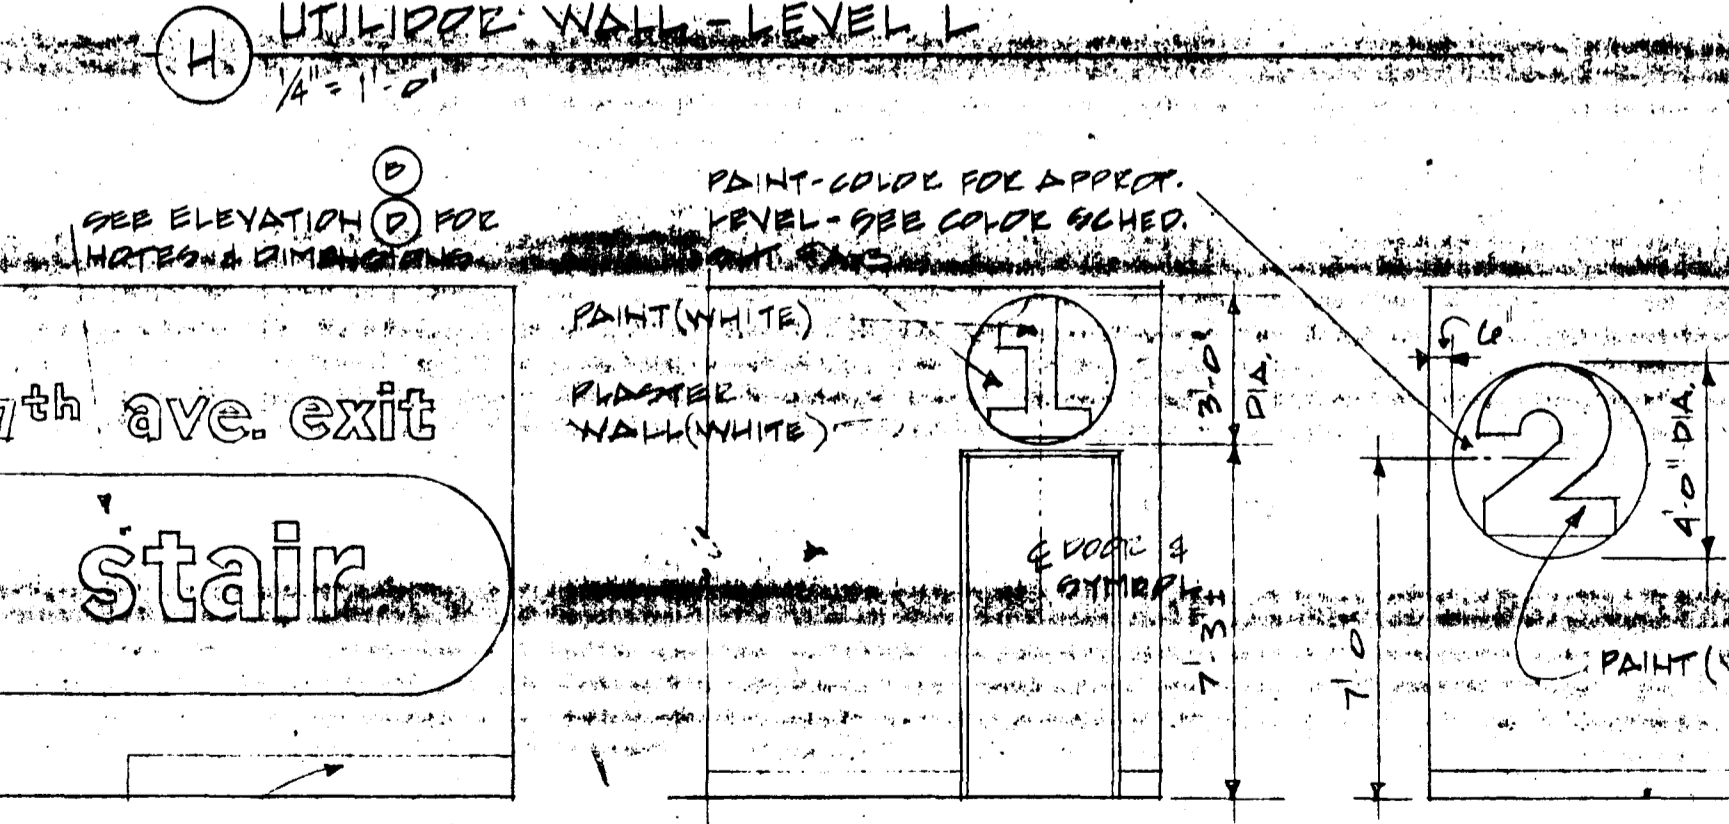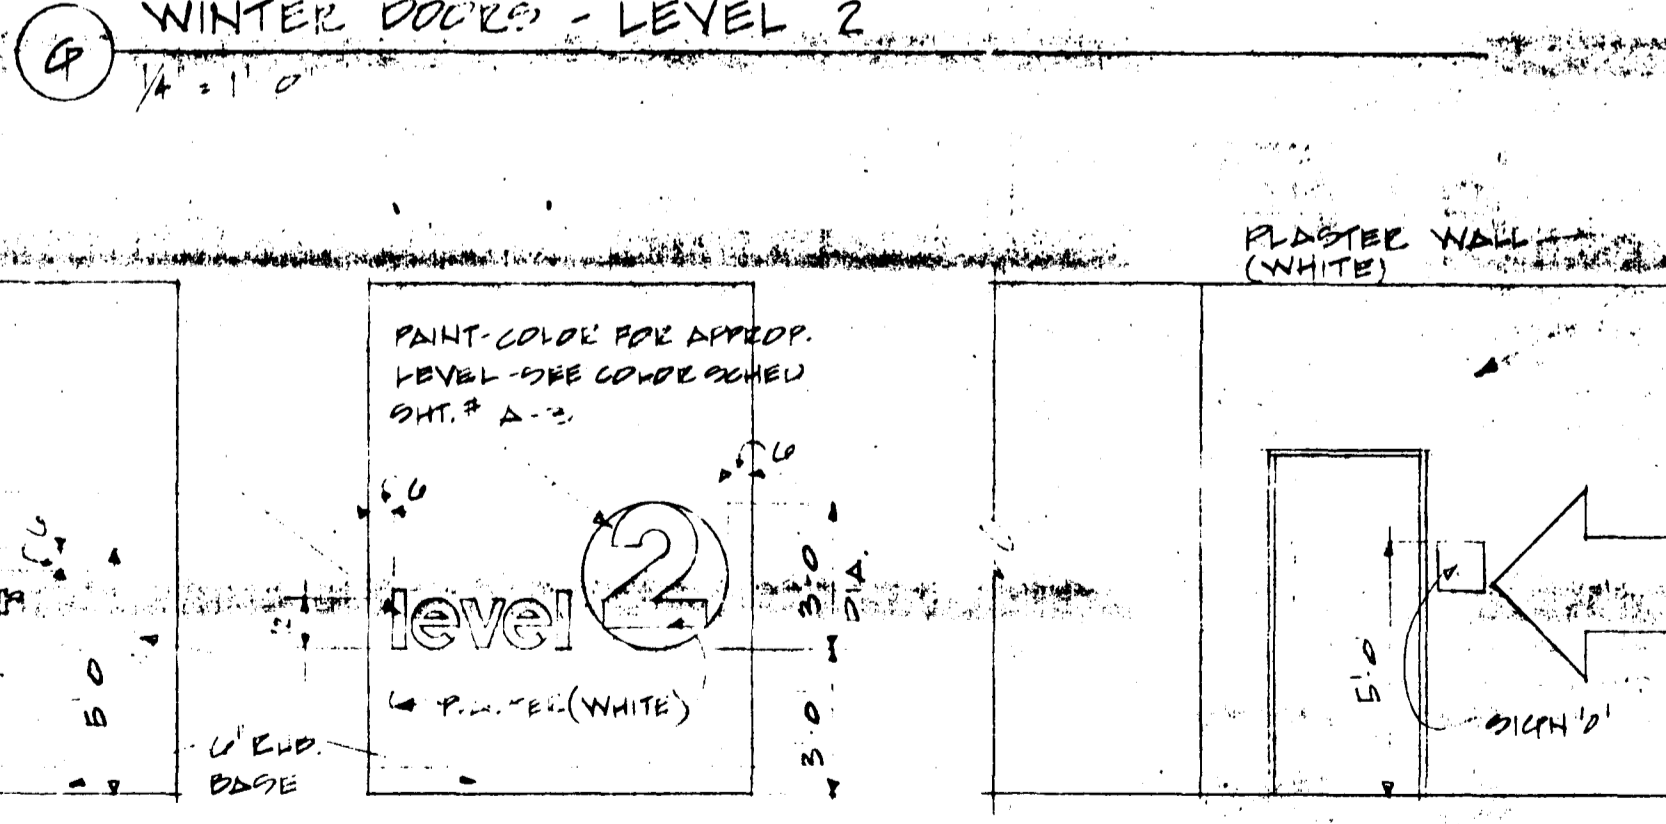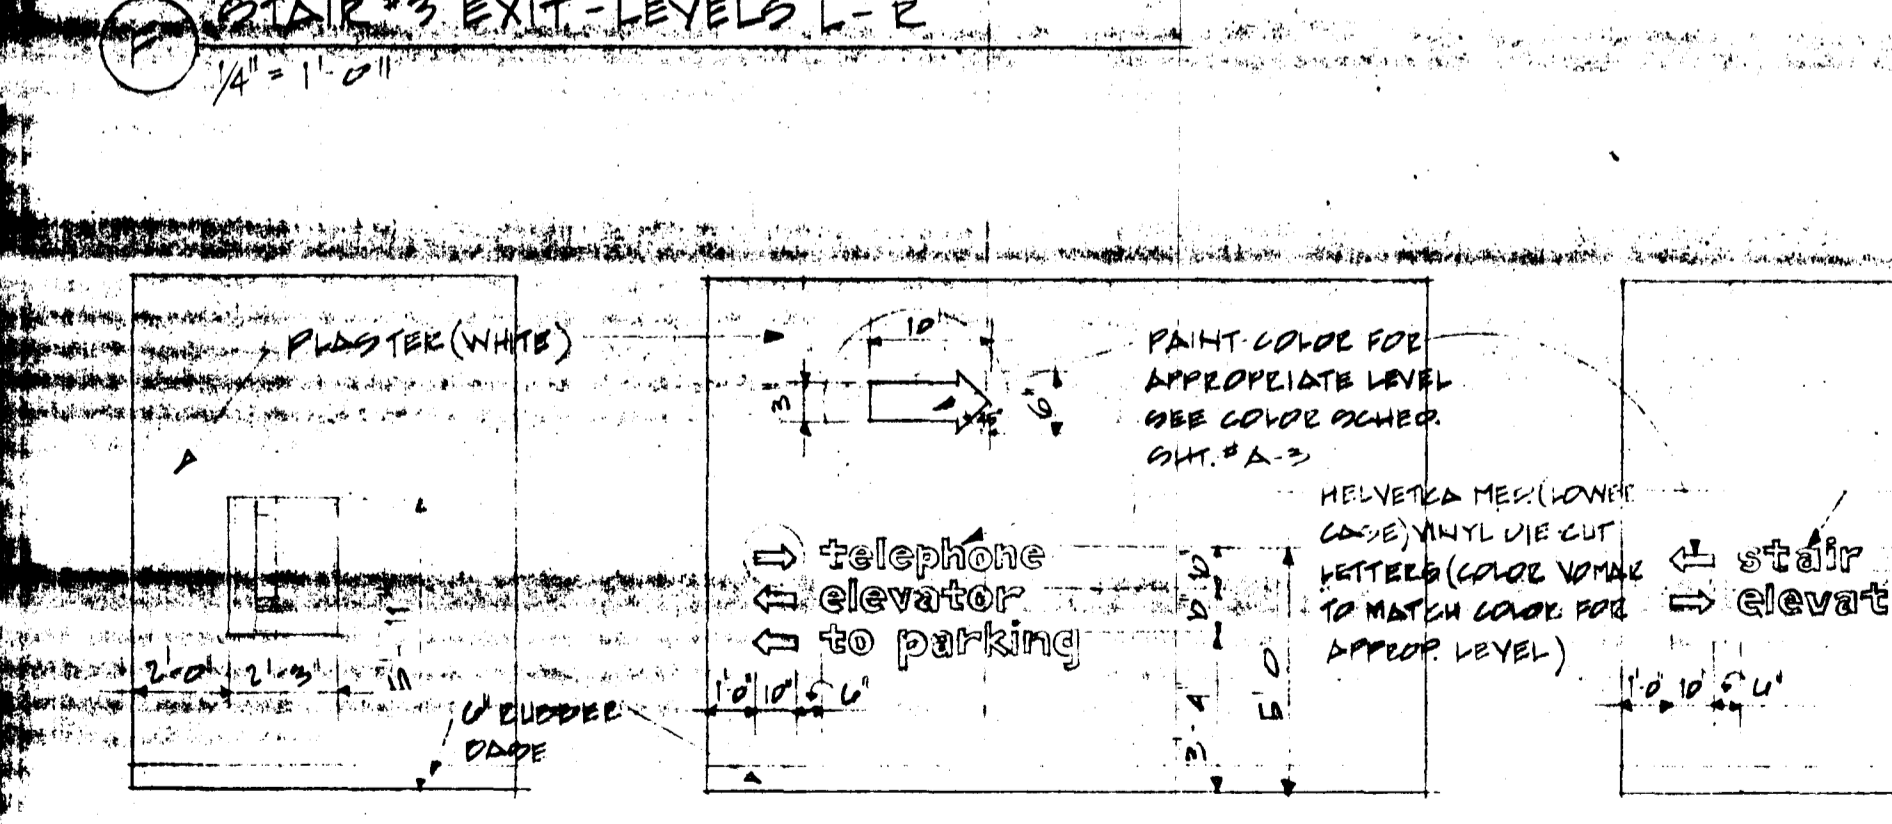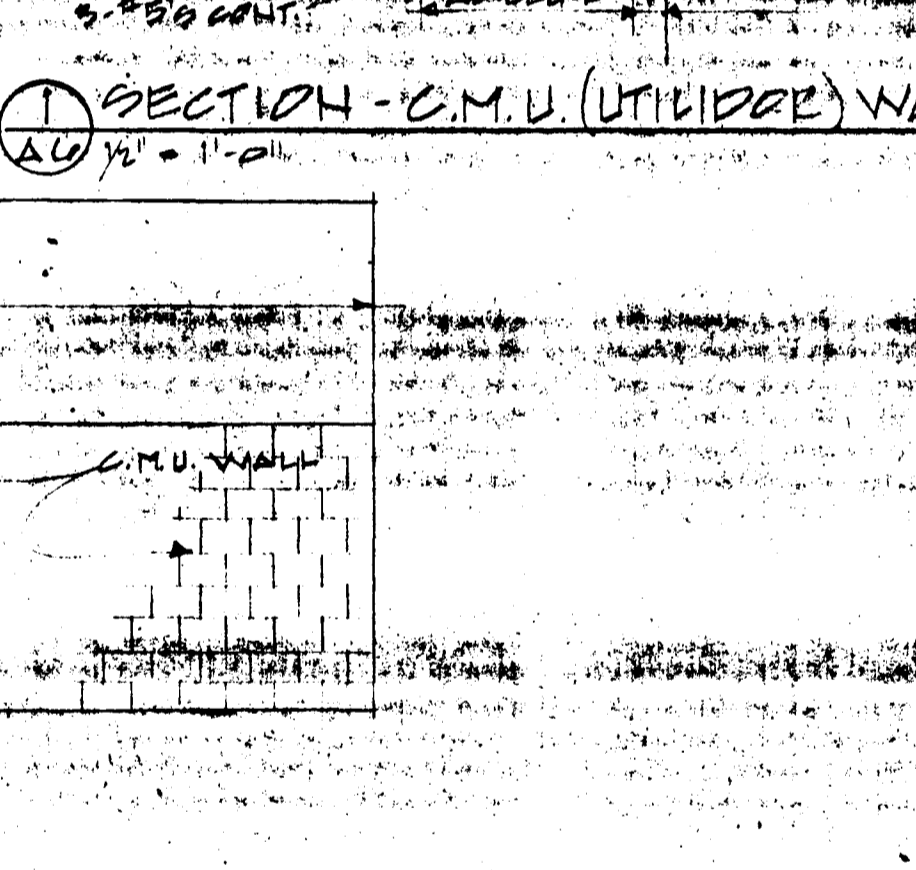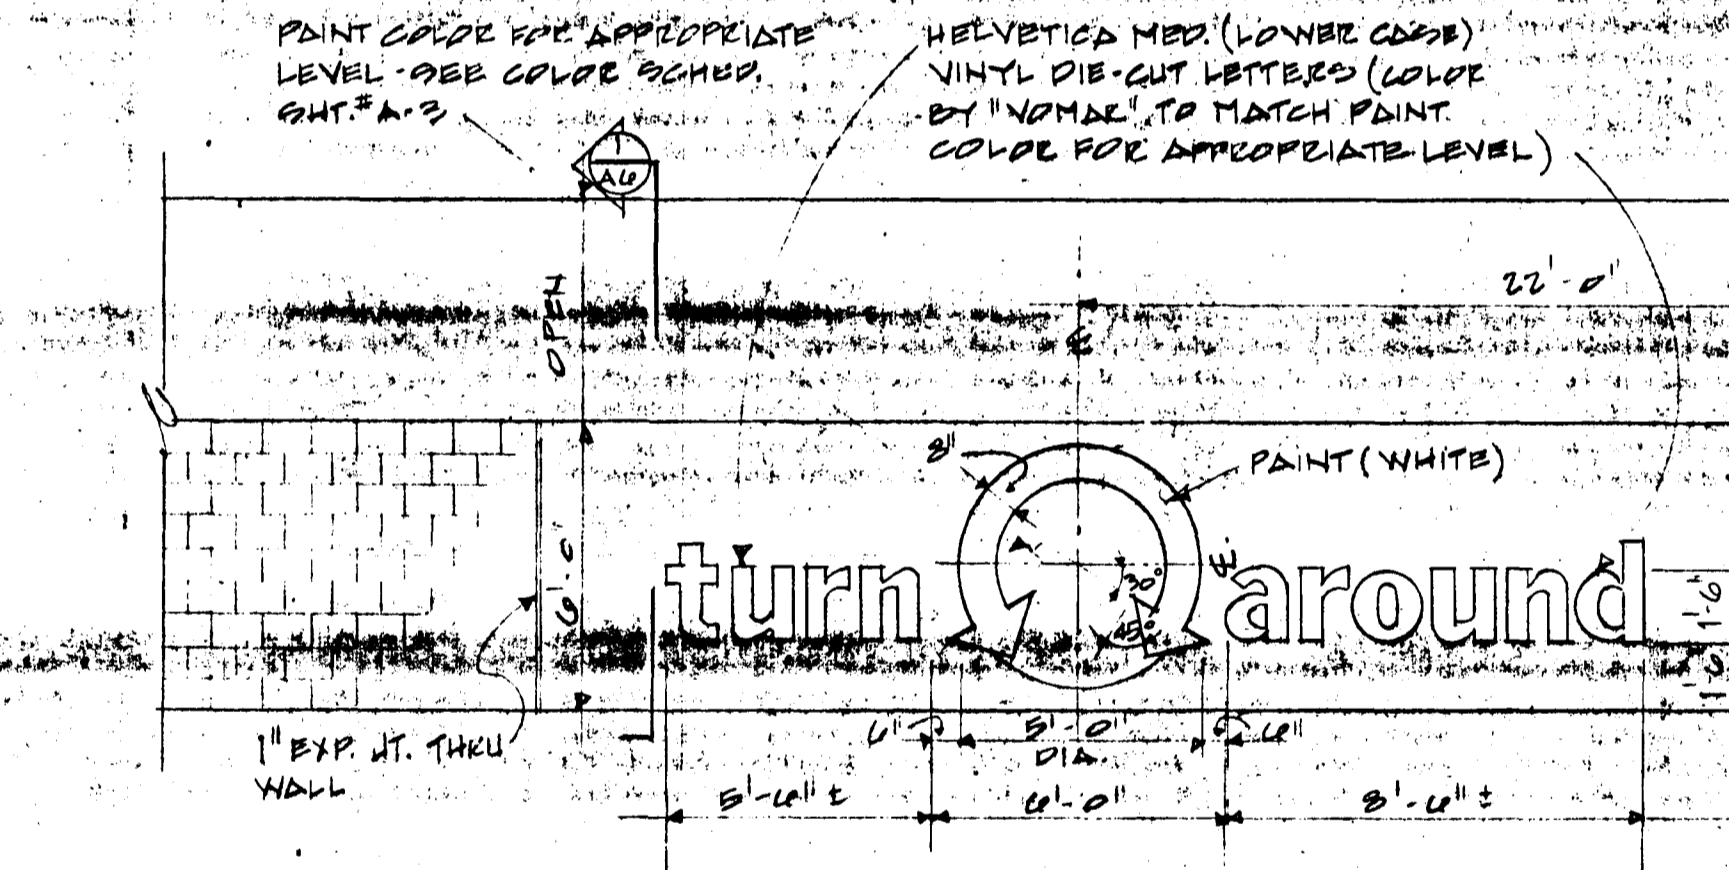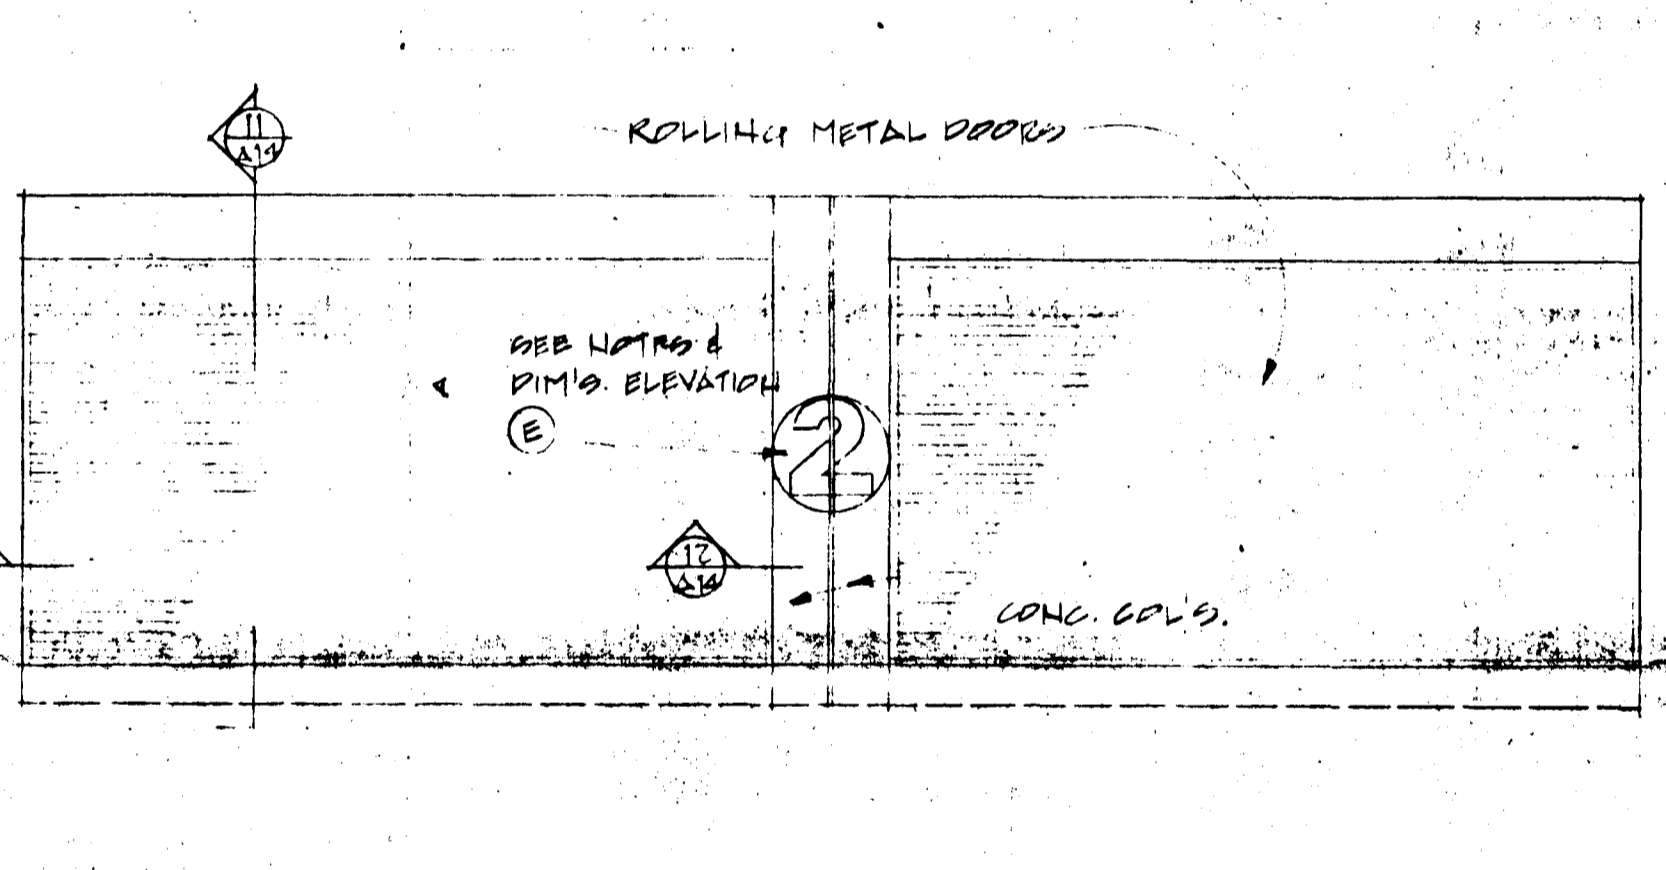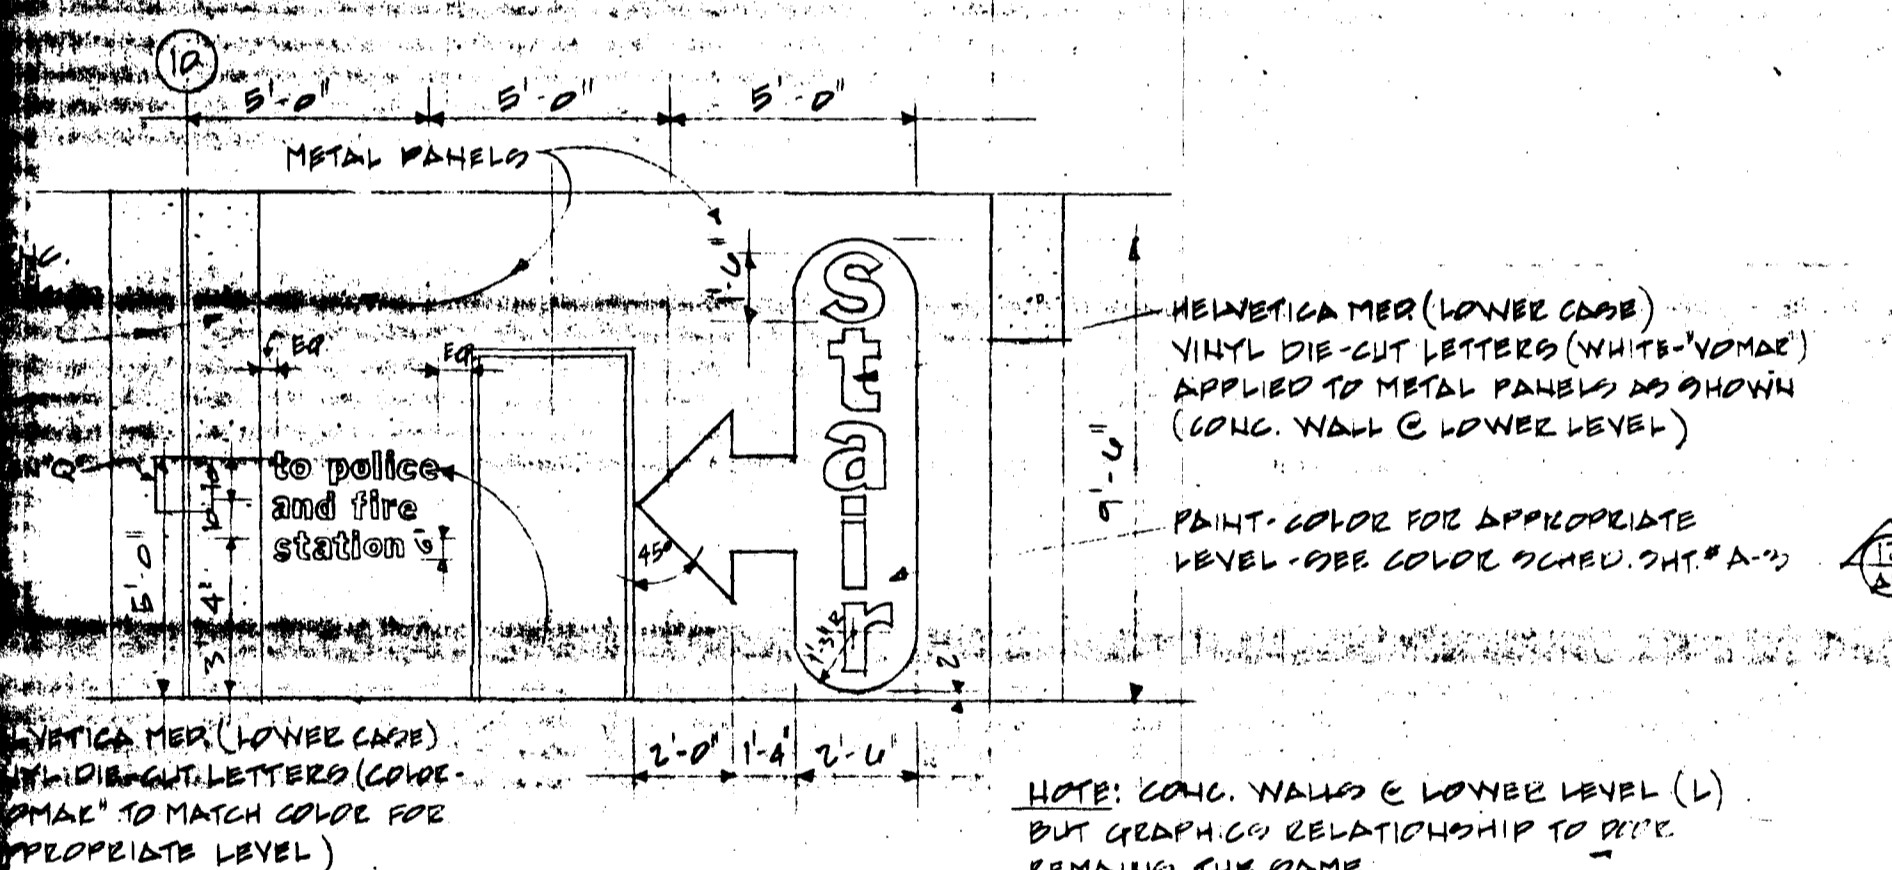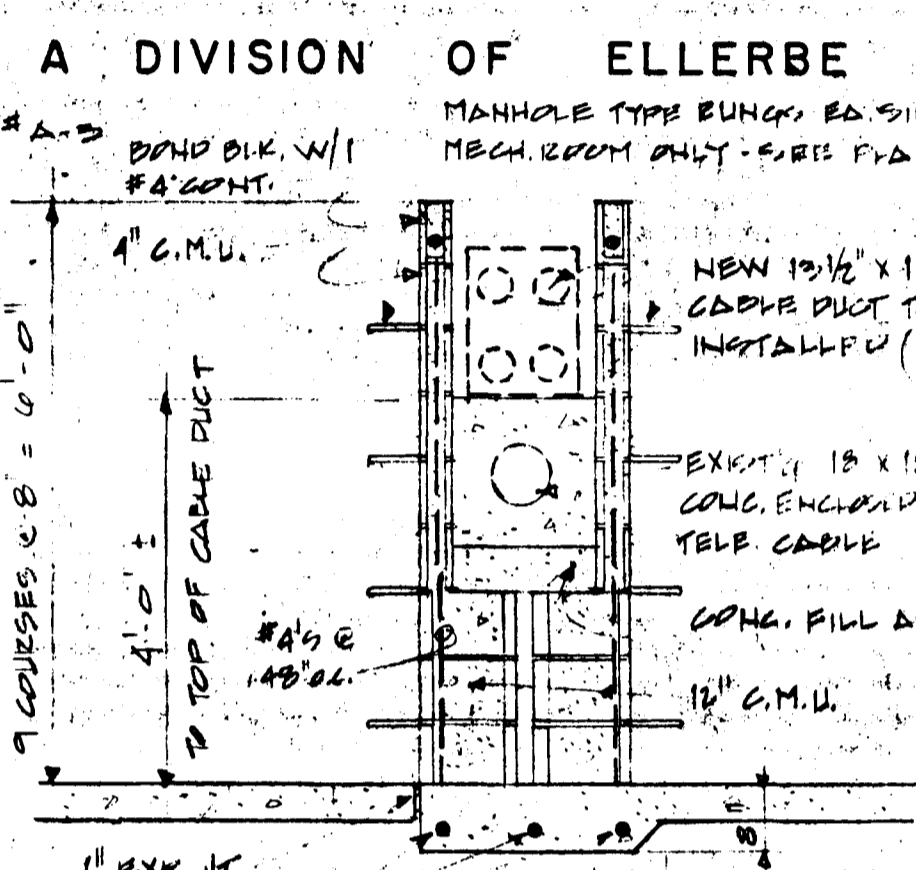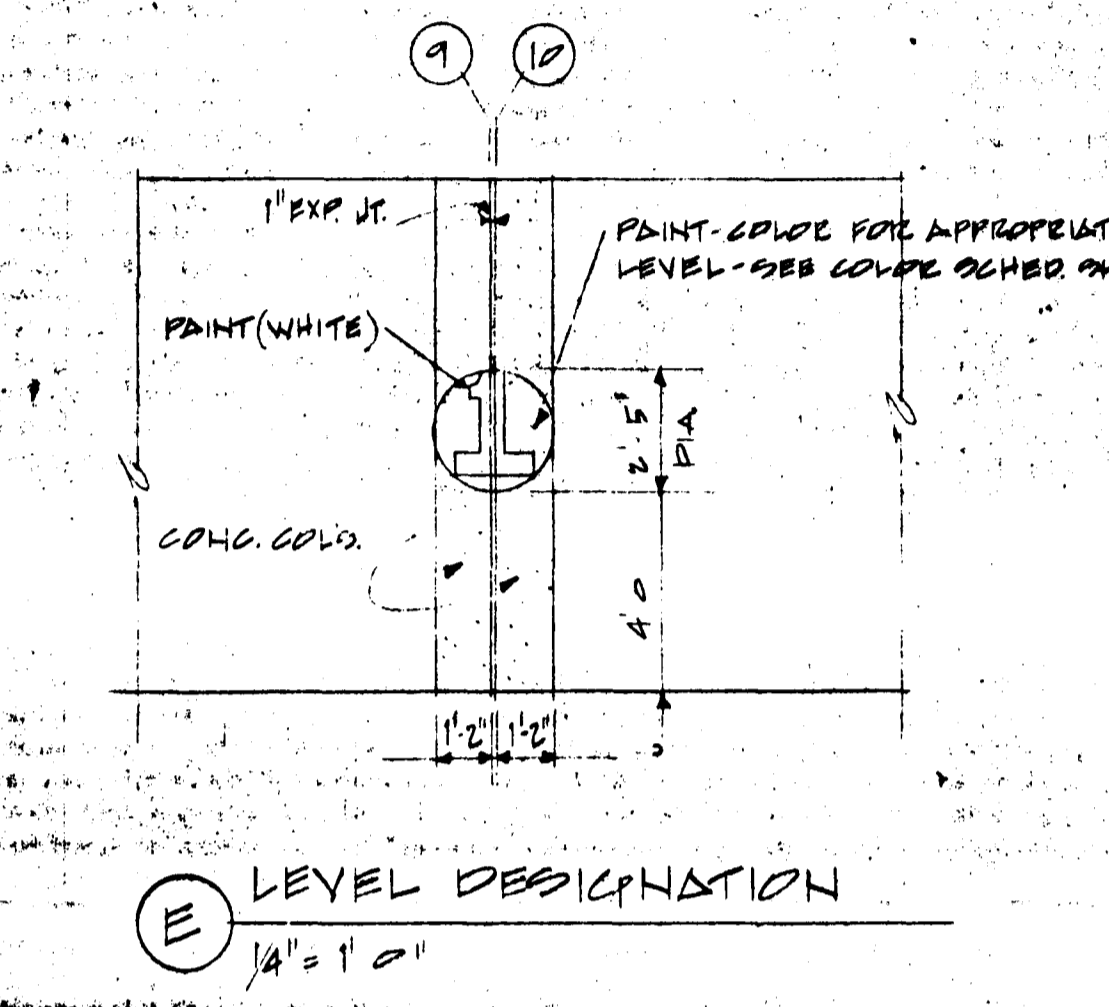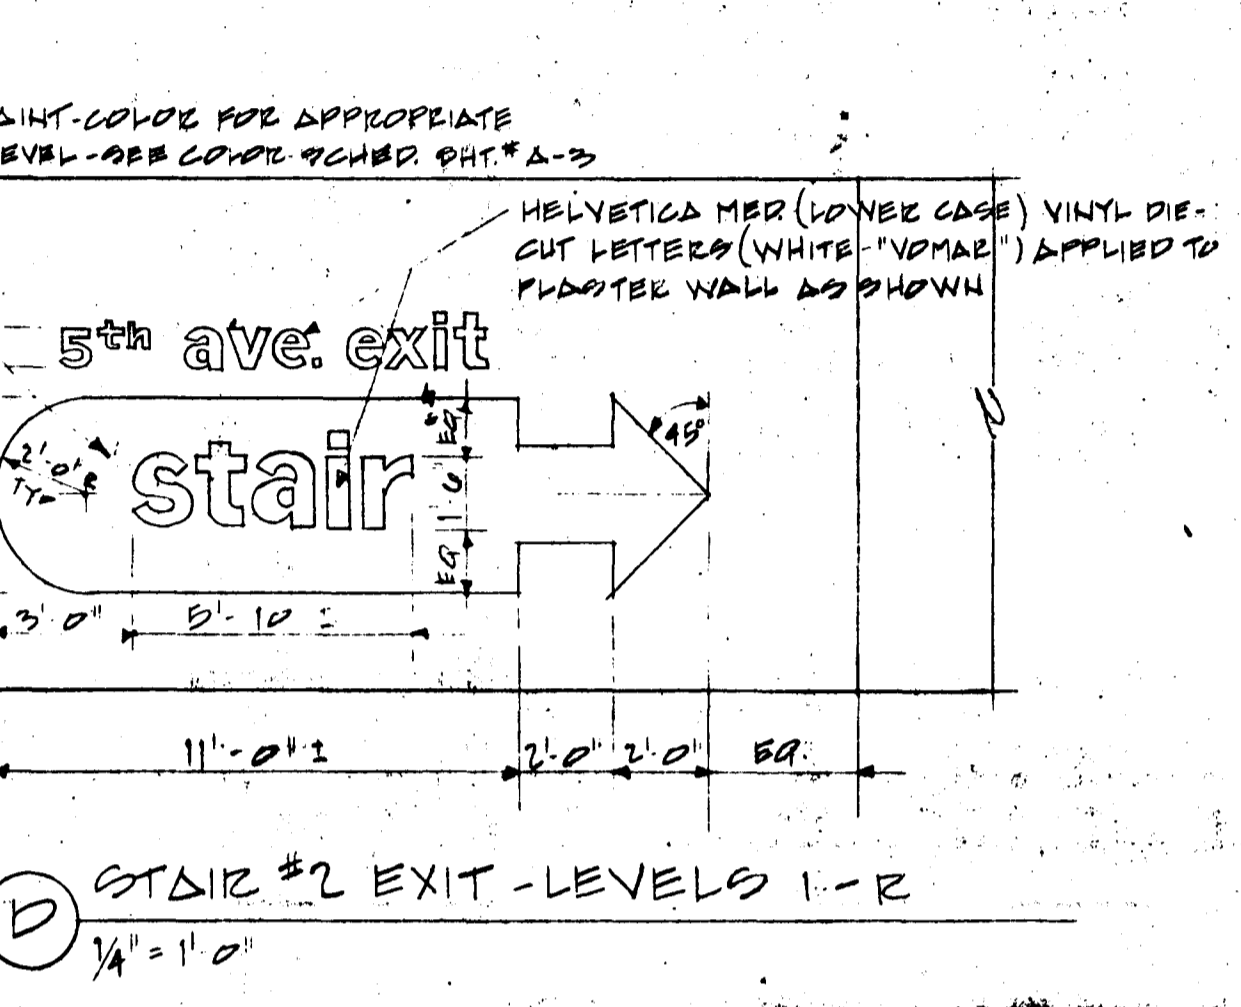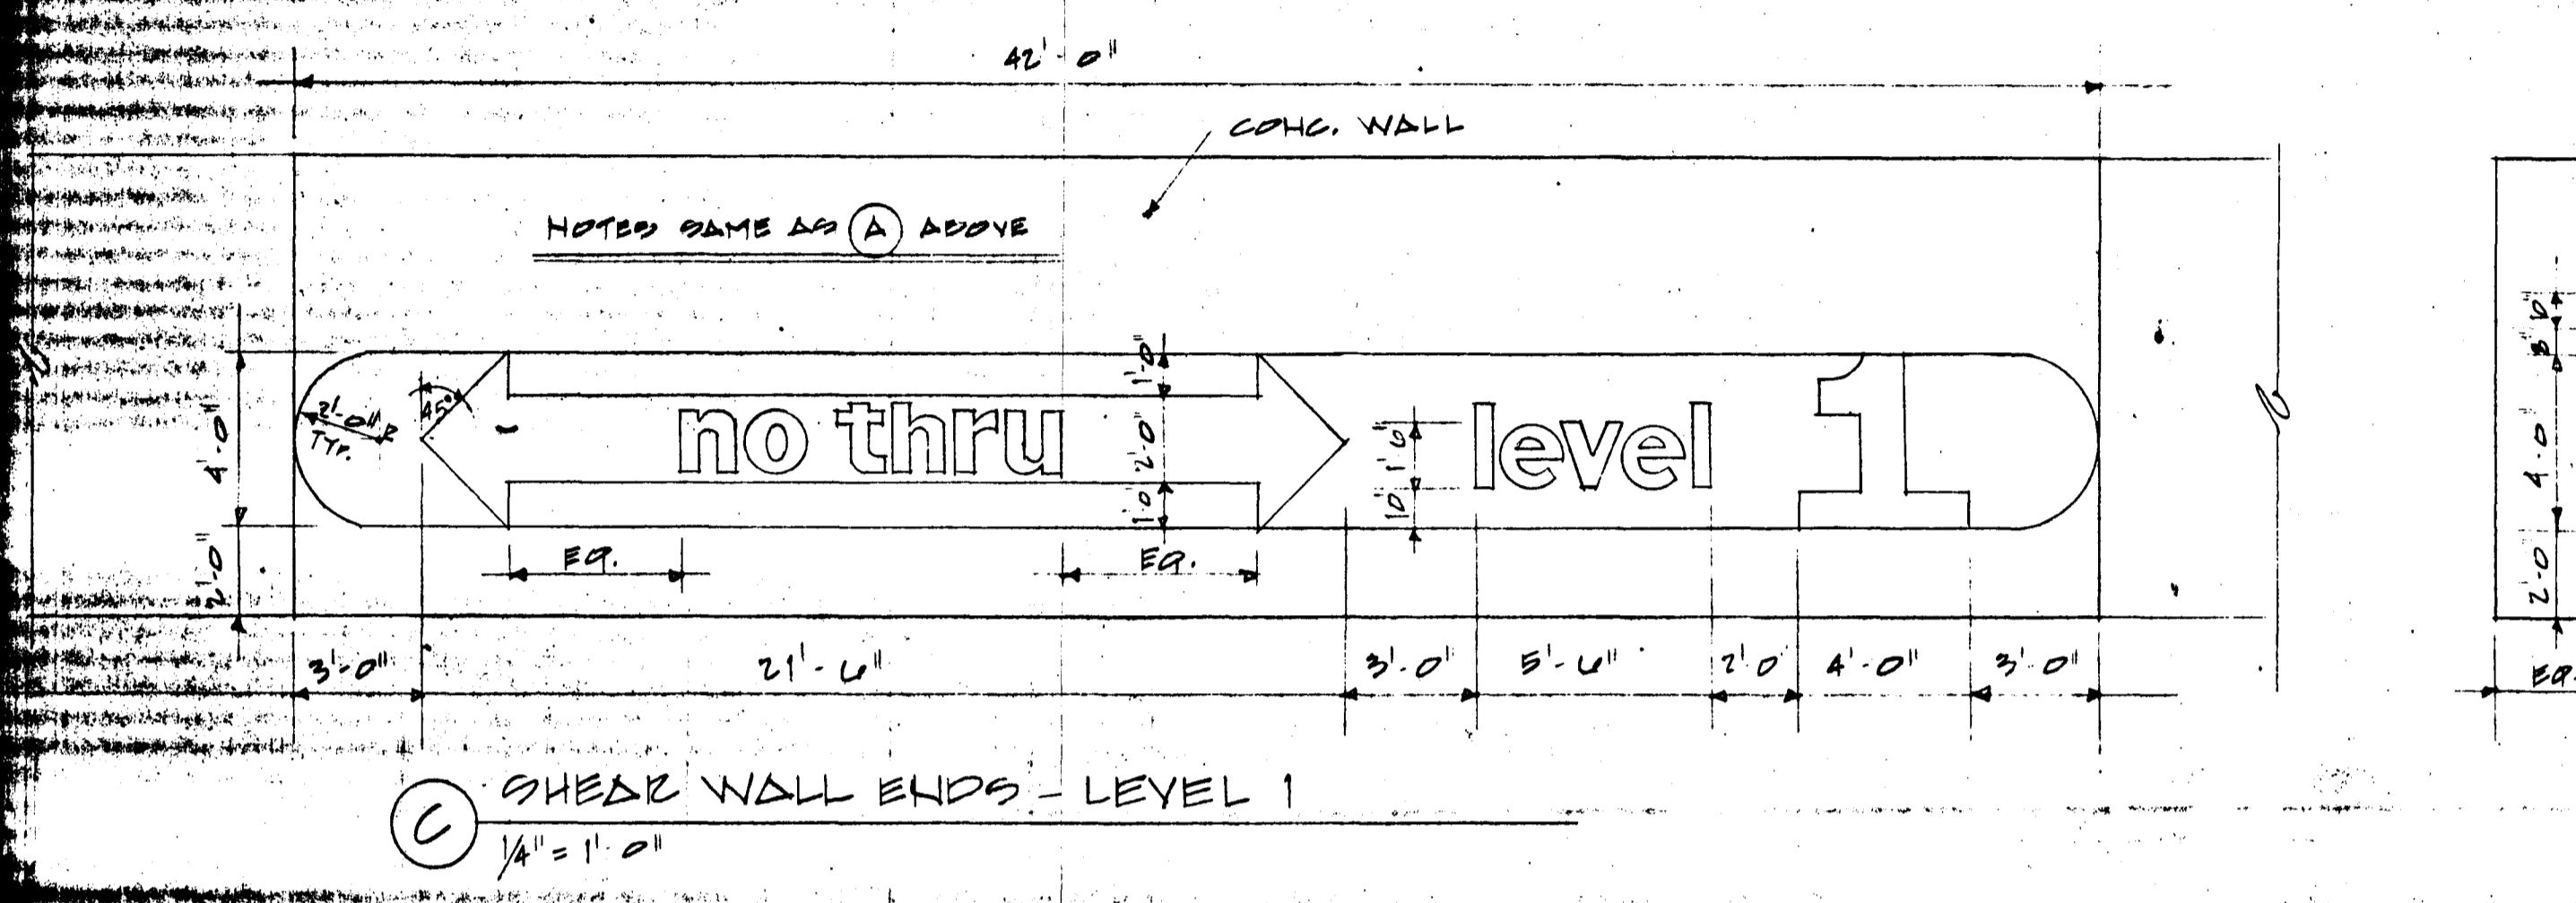

ARCHITECTS - ENGINEERS - SURVEYORS

601 COLLEGE ROAD, FAIRBANKS, ALASKA 99701, PHONE: 452-1241

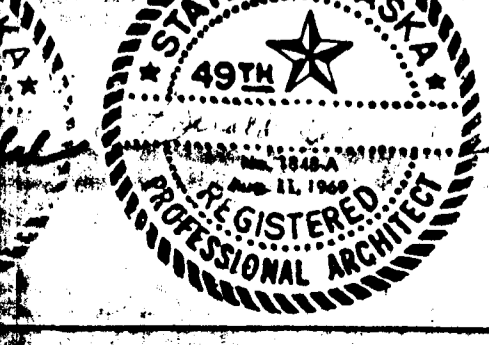

STATE OF ALASKA
DEPT. OF PUBLIC WORKS
DIVISION OF BUILDINGS
JUNEAU ALASKA


FAIRBANKS PARKING STRUCTURE
FAIRBANKS, A.K.
DBA - 2 - 0130

PETER KIEWIT SONS' CO.
ALASKA
OWNER'S COPY
DATE: _____
AS-BIT SHEET 9 OF 49

A-6
SHEET 9 OF 49

A DIVISION OF ELLERB

STAIR DETAILS - SEE 41.10
SEE 41. A-9 STAIR NO. 2 SIMILAR
HANDRAILS, CONSTRUCTION, ETC.
SEE STRUCT. SECT. 5-5

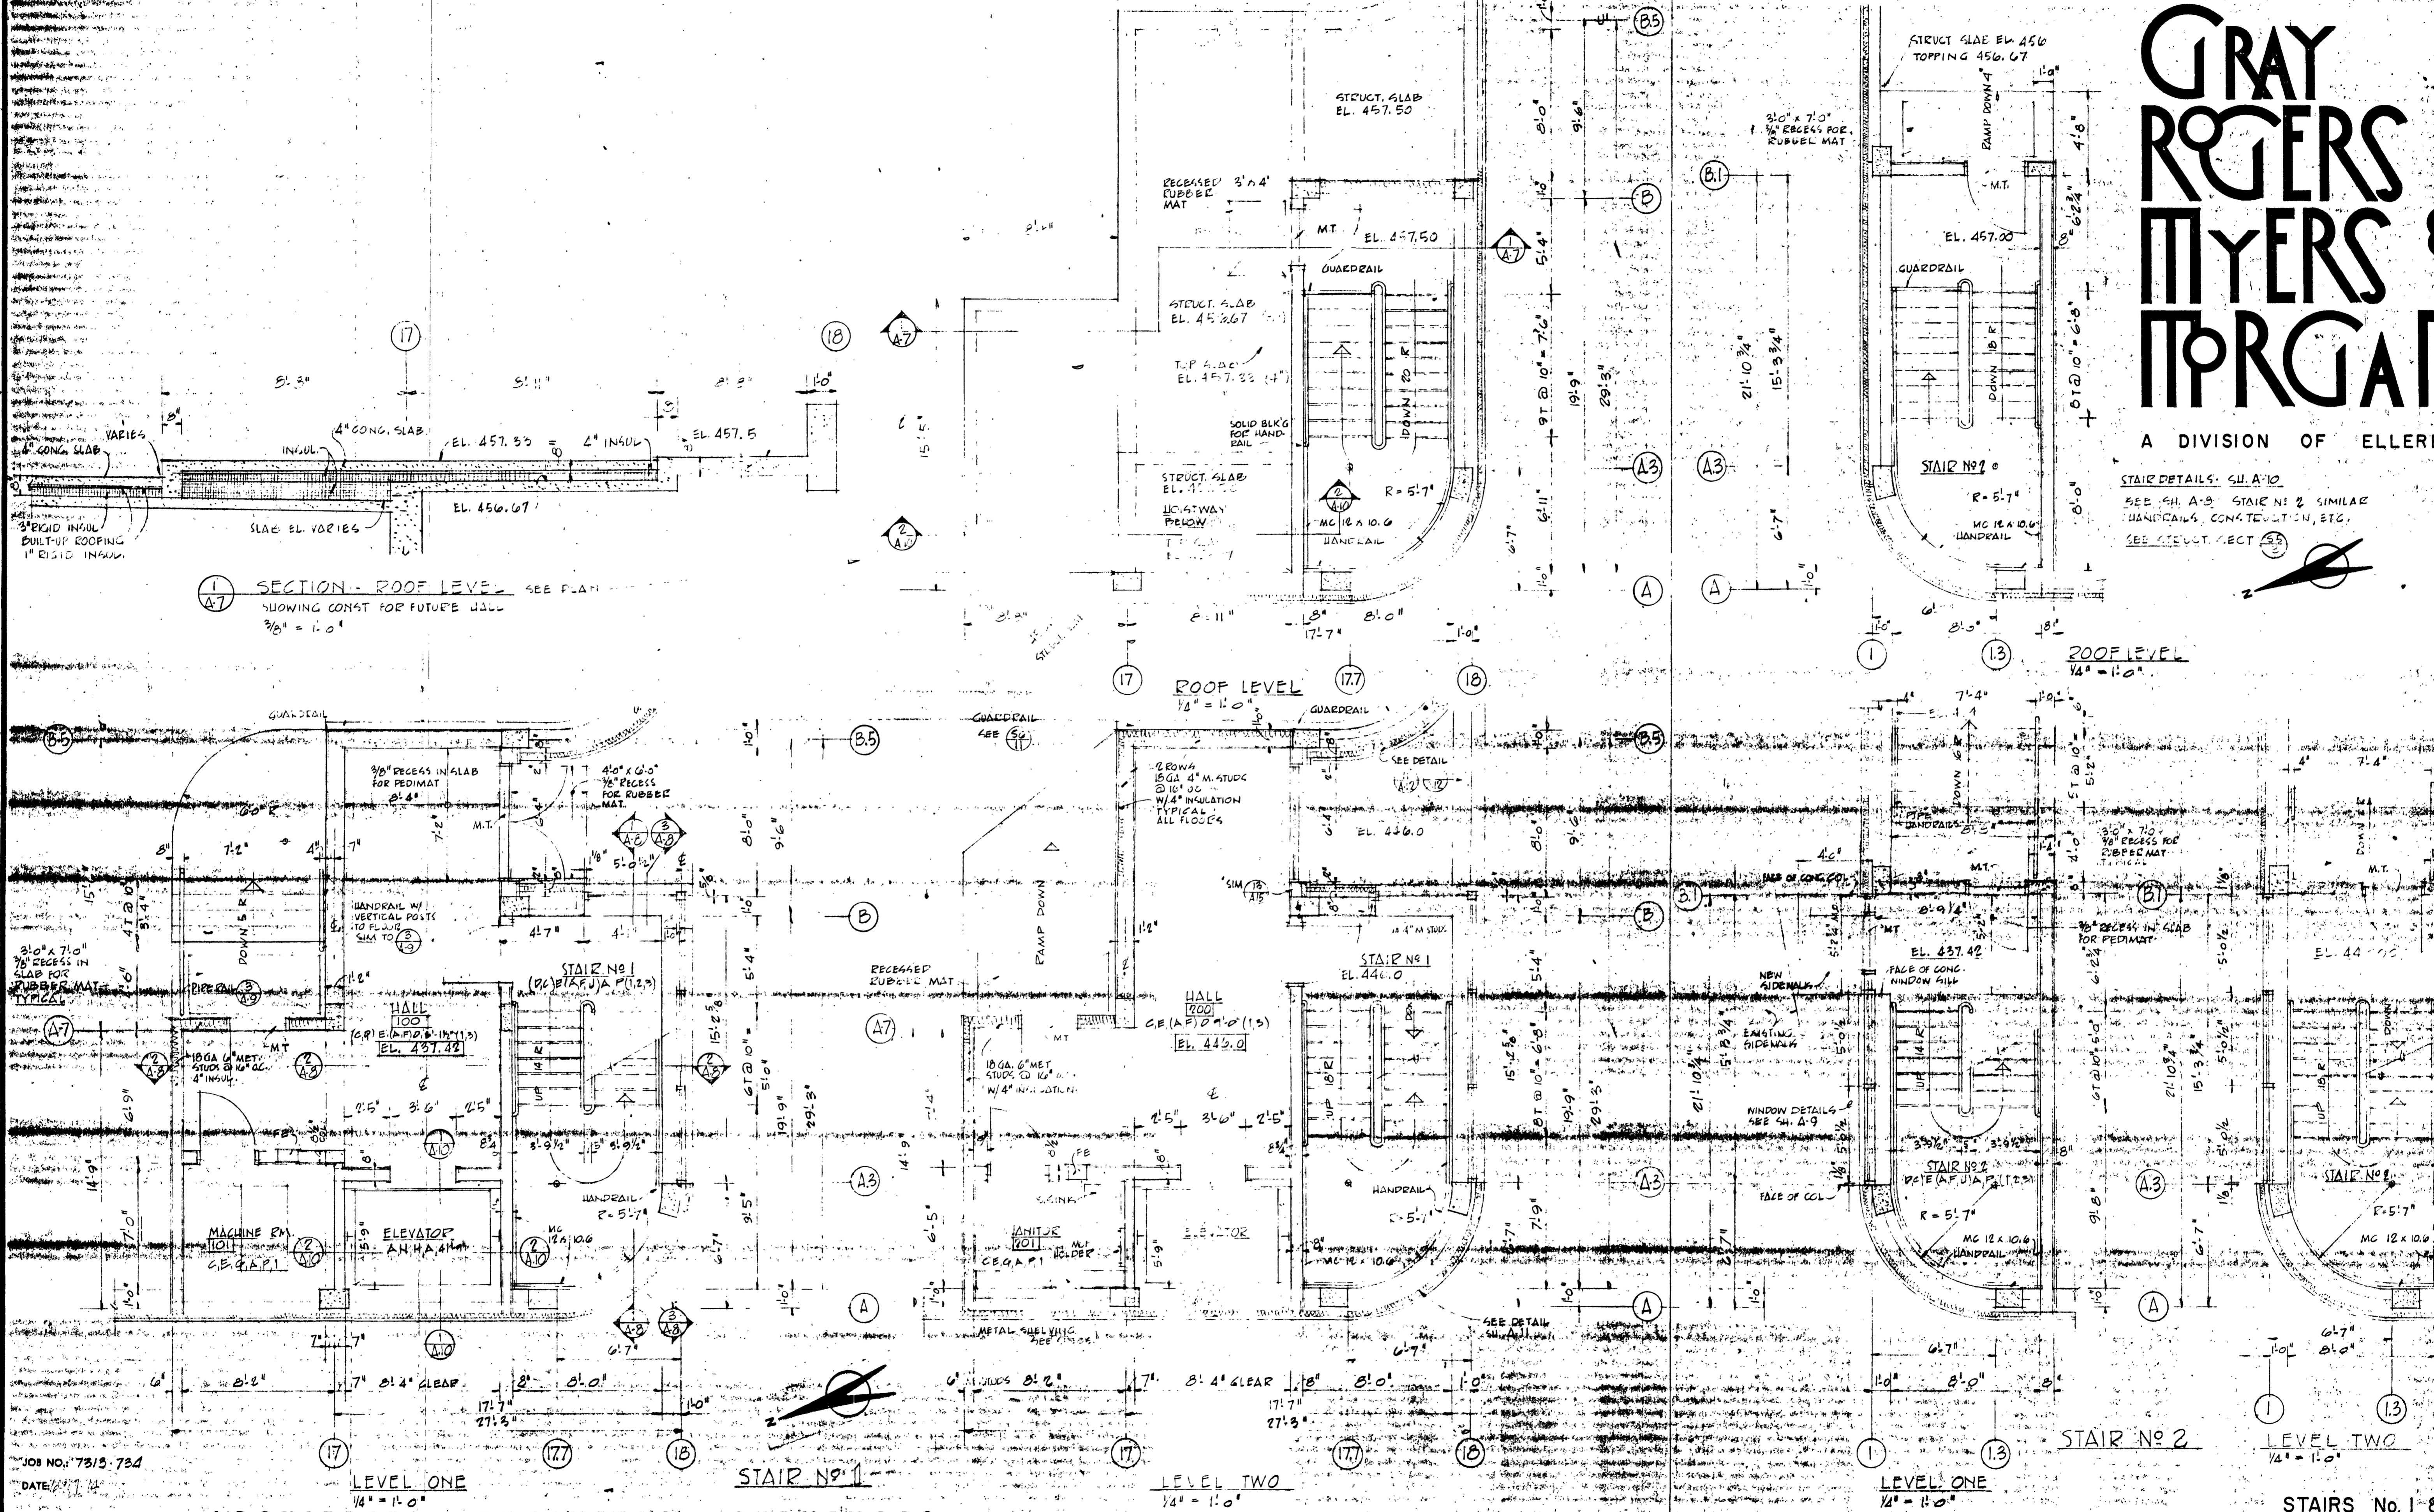

SECTION - ROOF LEVEL - SEE PLAN
SHOWING CONST. FOR FUTURE WALL
3/8" = 1'-0"

ROOF LEVEL
1/4" = 1'-0"

ROOF LEVEL
1/4" = 1'-0"

LEVEL ONE
1/4" = 1'-0"

LEVEL TWO
1/4" = 1'-0"

LEVEL ONE
1/4" = 1'-0"

STAIRS No. 1 & 2
1/4" = 1'-0"

ARCHITECTS - ENGINEERS - SURVEYORS

101 COLLEGE ROAD, FAIRBANKS, ALASKA 99701 - PHONE 452-1241

STATE OF ALASKA
DEPT. OF PUBLIC WORKS
DIVISION OF BUILDINGS
JUNEAU ALASKA


FAIRBANKS PARKING STRUCTURE
FAIRBANKS, AK
DBA - 2 - 0130

PETER KIEWIT SONS CO.


FAIRBANKS, ALASKA
W. H. HOPPE
CONTRACTORS

A-7

SHEET 10 OF 10

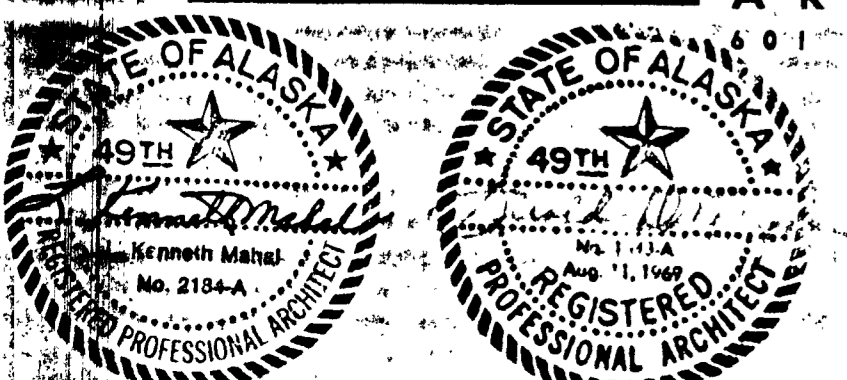

DIVISION OF ELLERBE

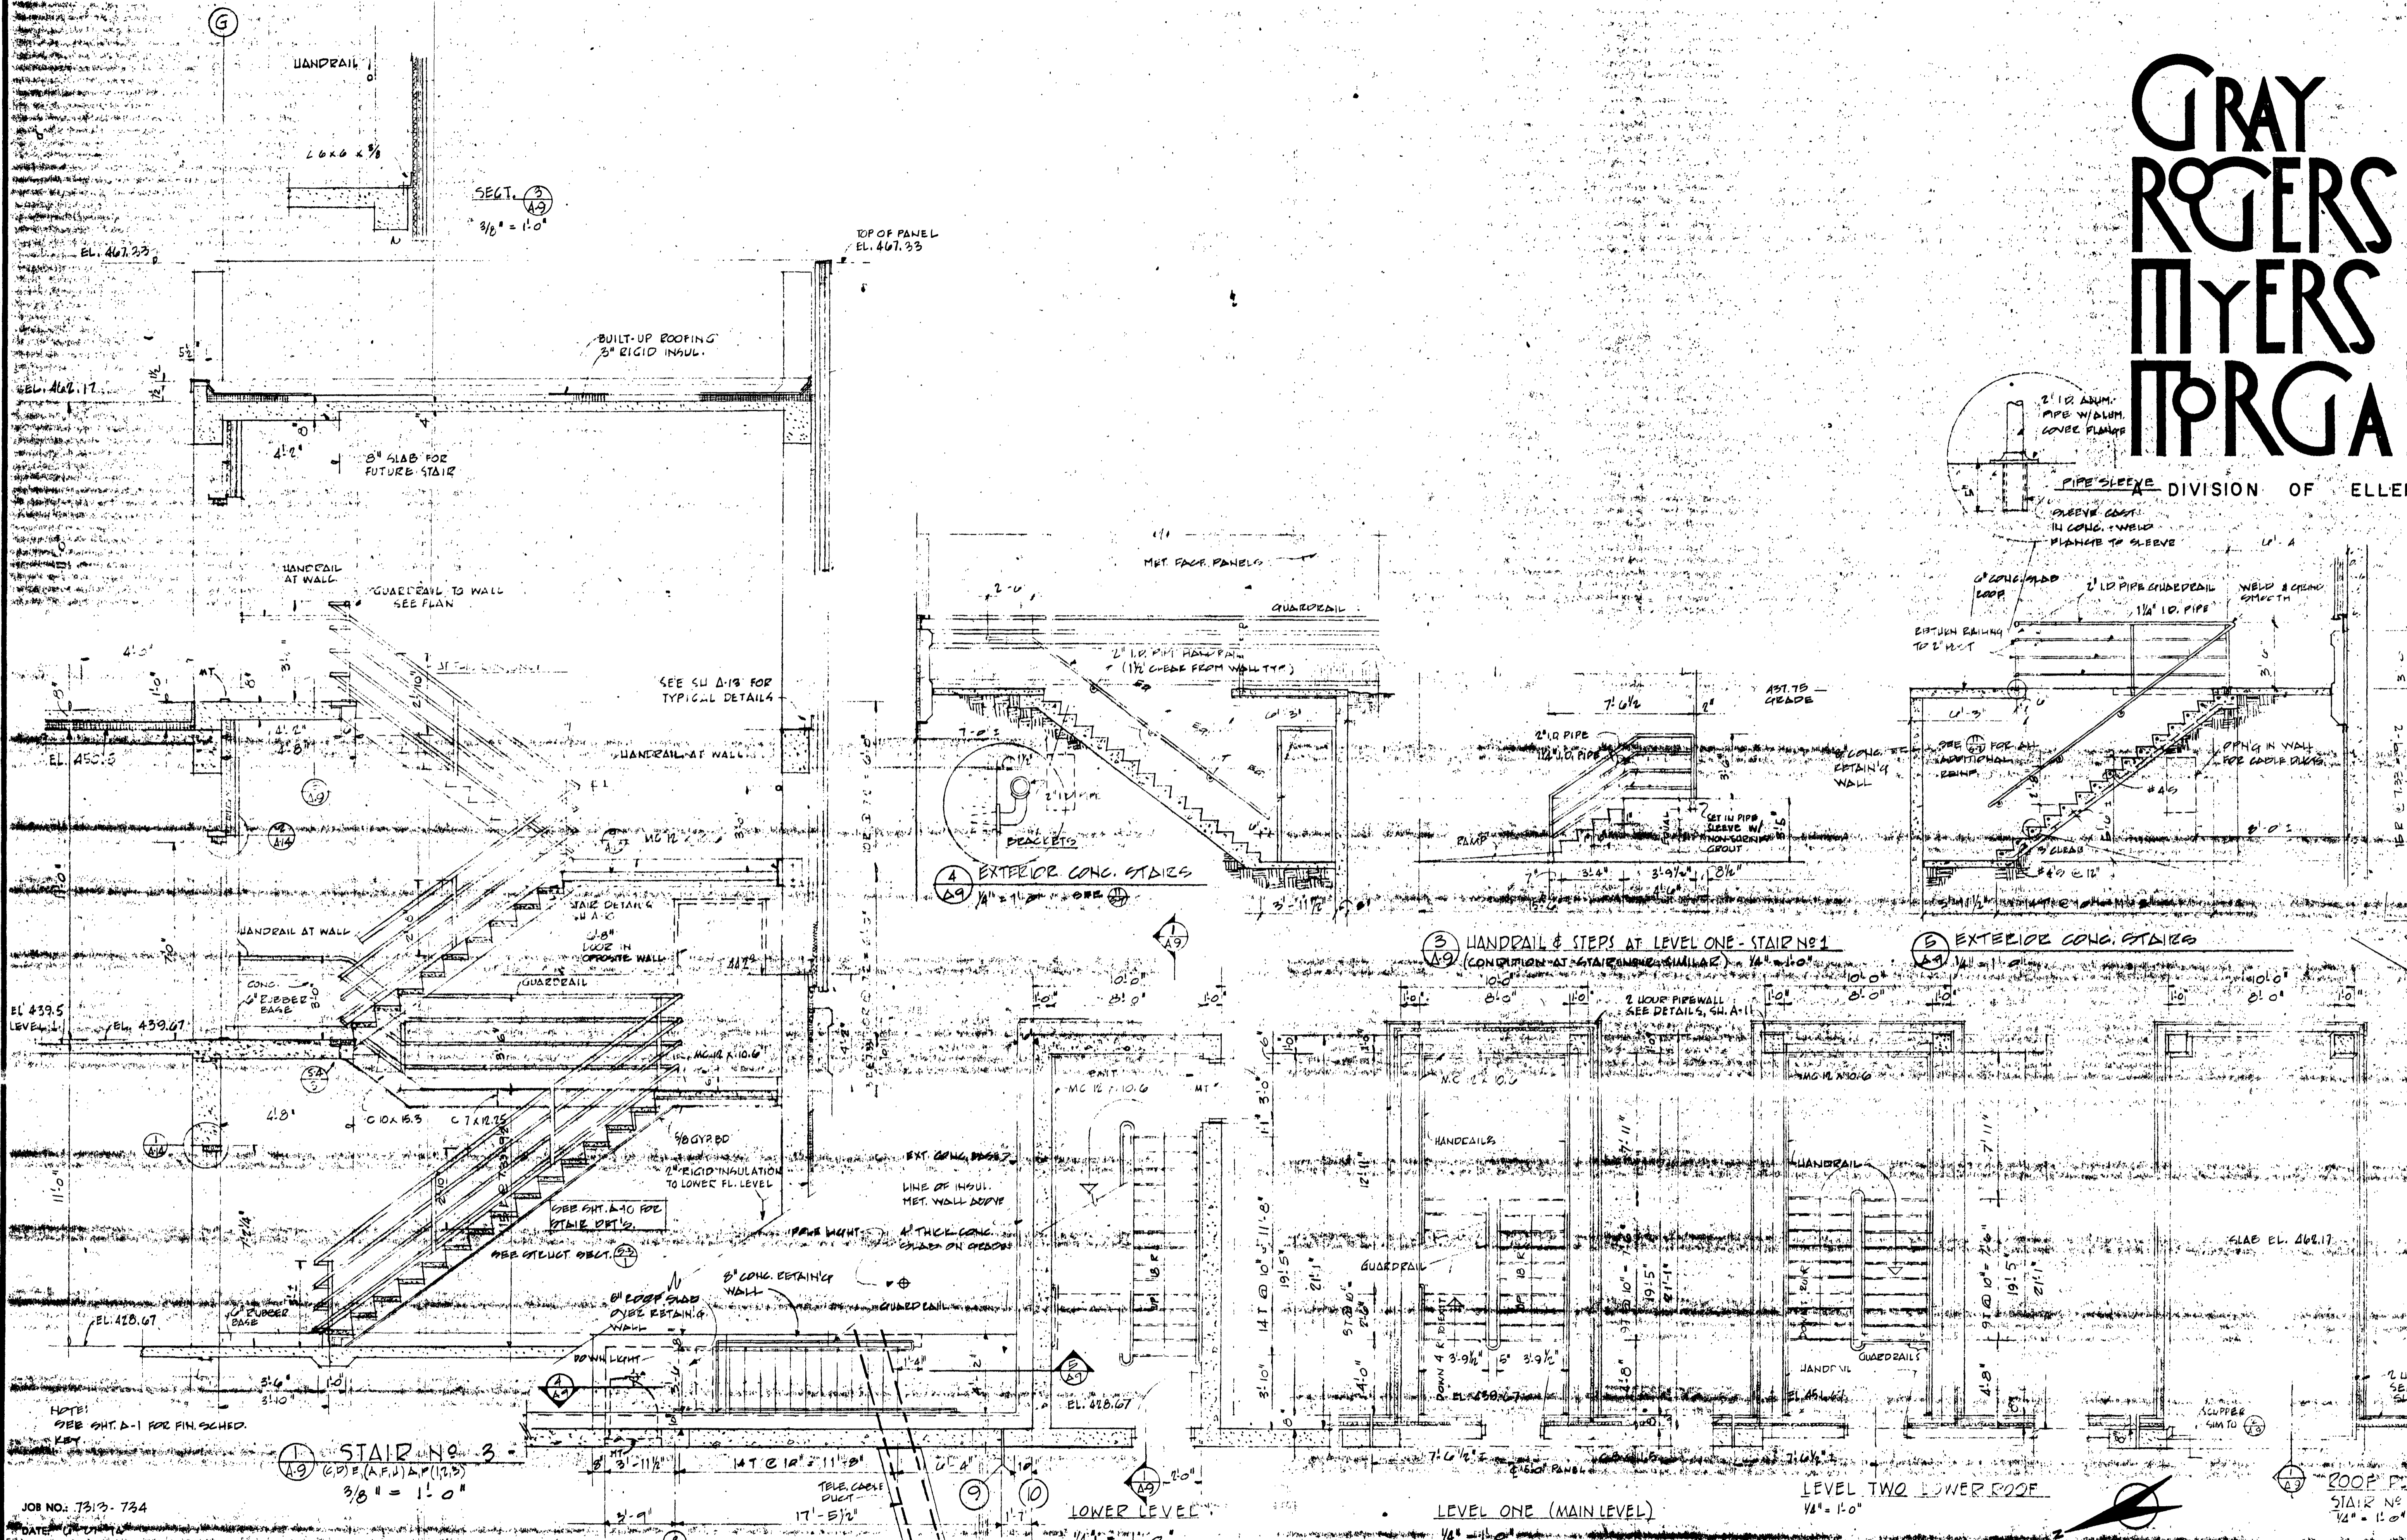


ARCHITECTS • ENGINEERS • SURVEYORS
 801 COLLEGE ROAD, FAIRBANKS, ALASKA 99701, PHONE: 452-1241

STATE OF ALASKA
 DEPT. OF PUBLIC WORKS
 DIVISION OF BUILDINGS
 JUNEAU ALASKA



FAIRBANKS PARKING STRUCTURE
 DBA - 2 - 0130
 FAIRBANKS, AK.

PETER KIEWIT SONS' CO. FAIRBANKS, ALASKA		A-E SHEET 12 OF
W. Hoopes CONTRACTORS & P.	OWNERS REP. AS-BLT	
DATE:		9-30-59

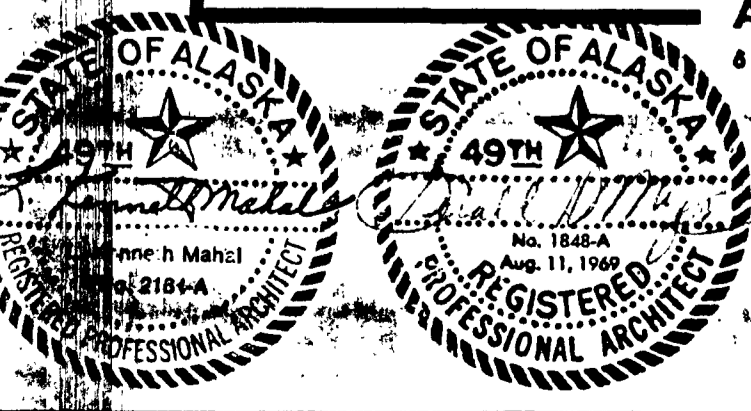

GRAY ROGERS MYERS & TORGAN

A DIVISION OF ELLERBE

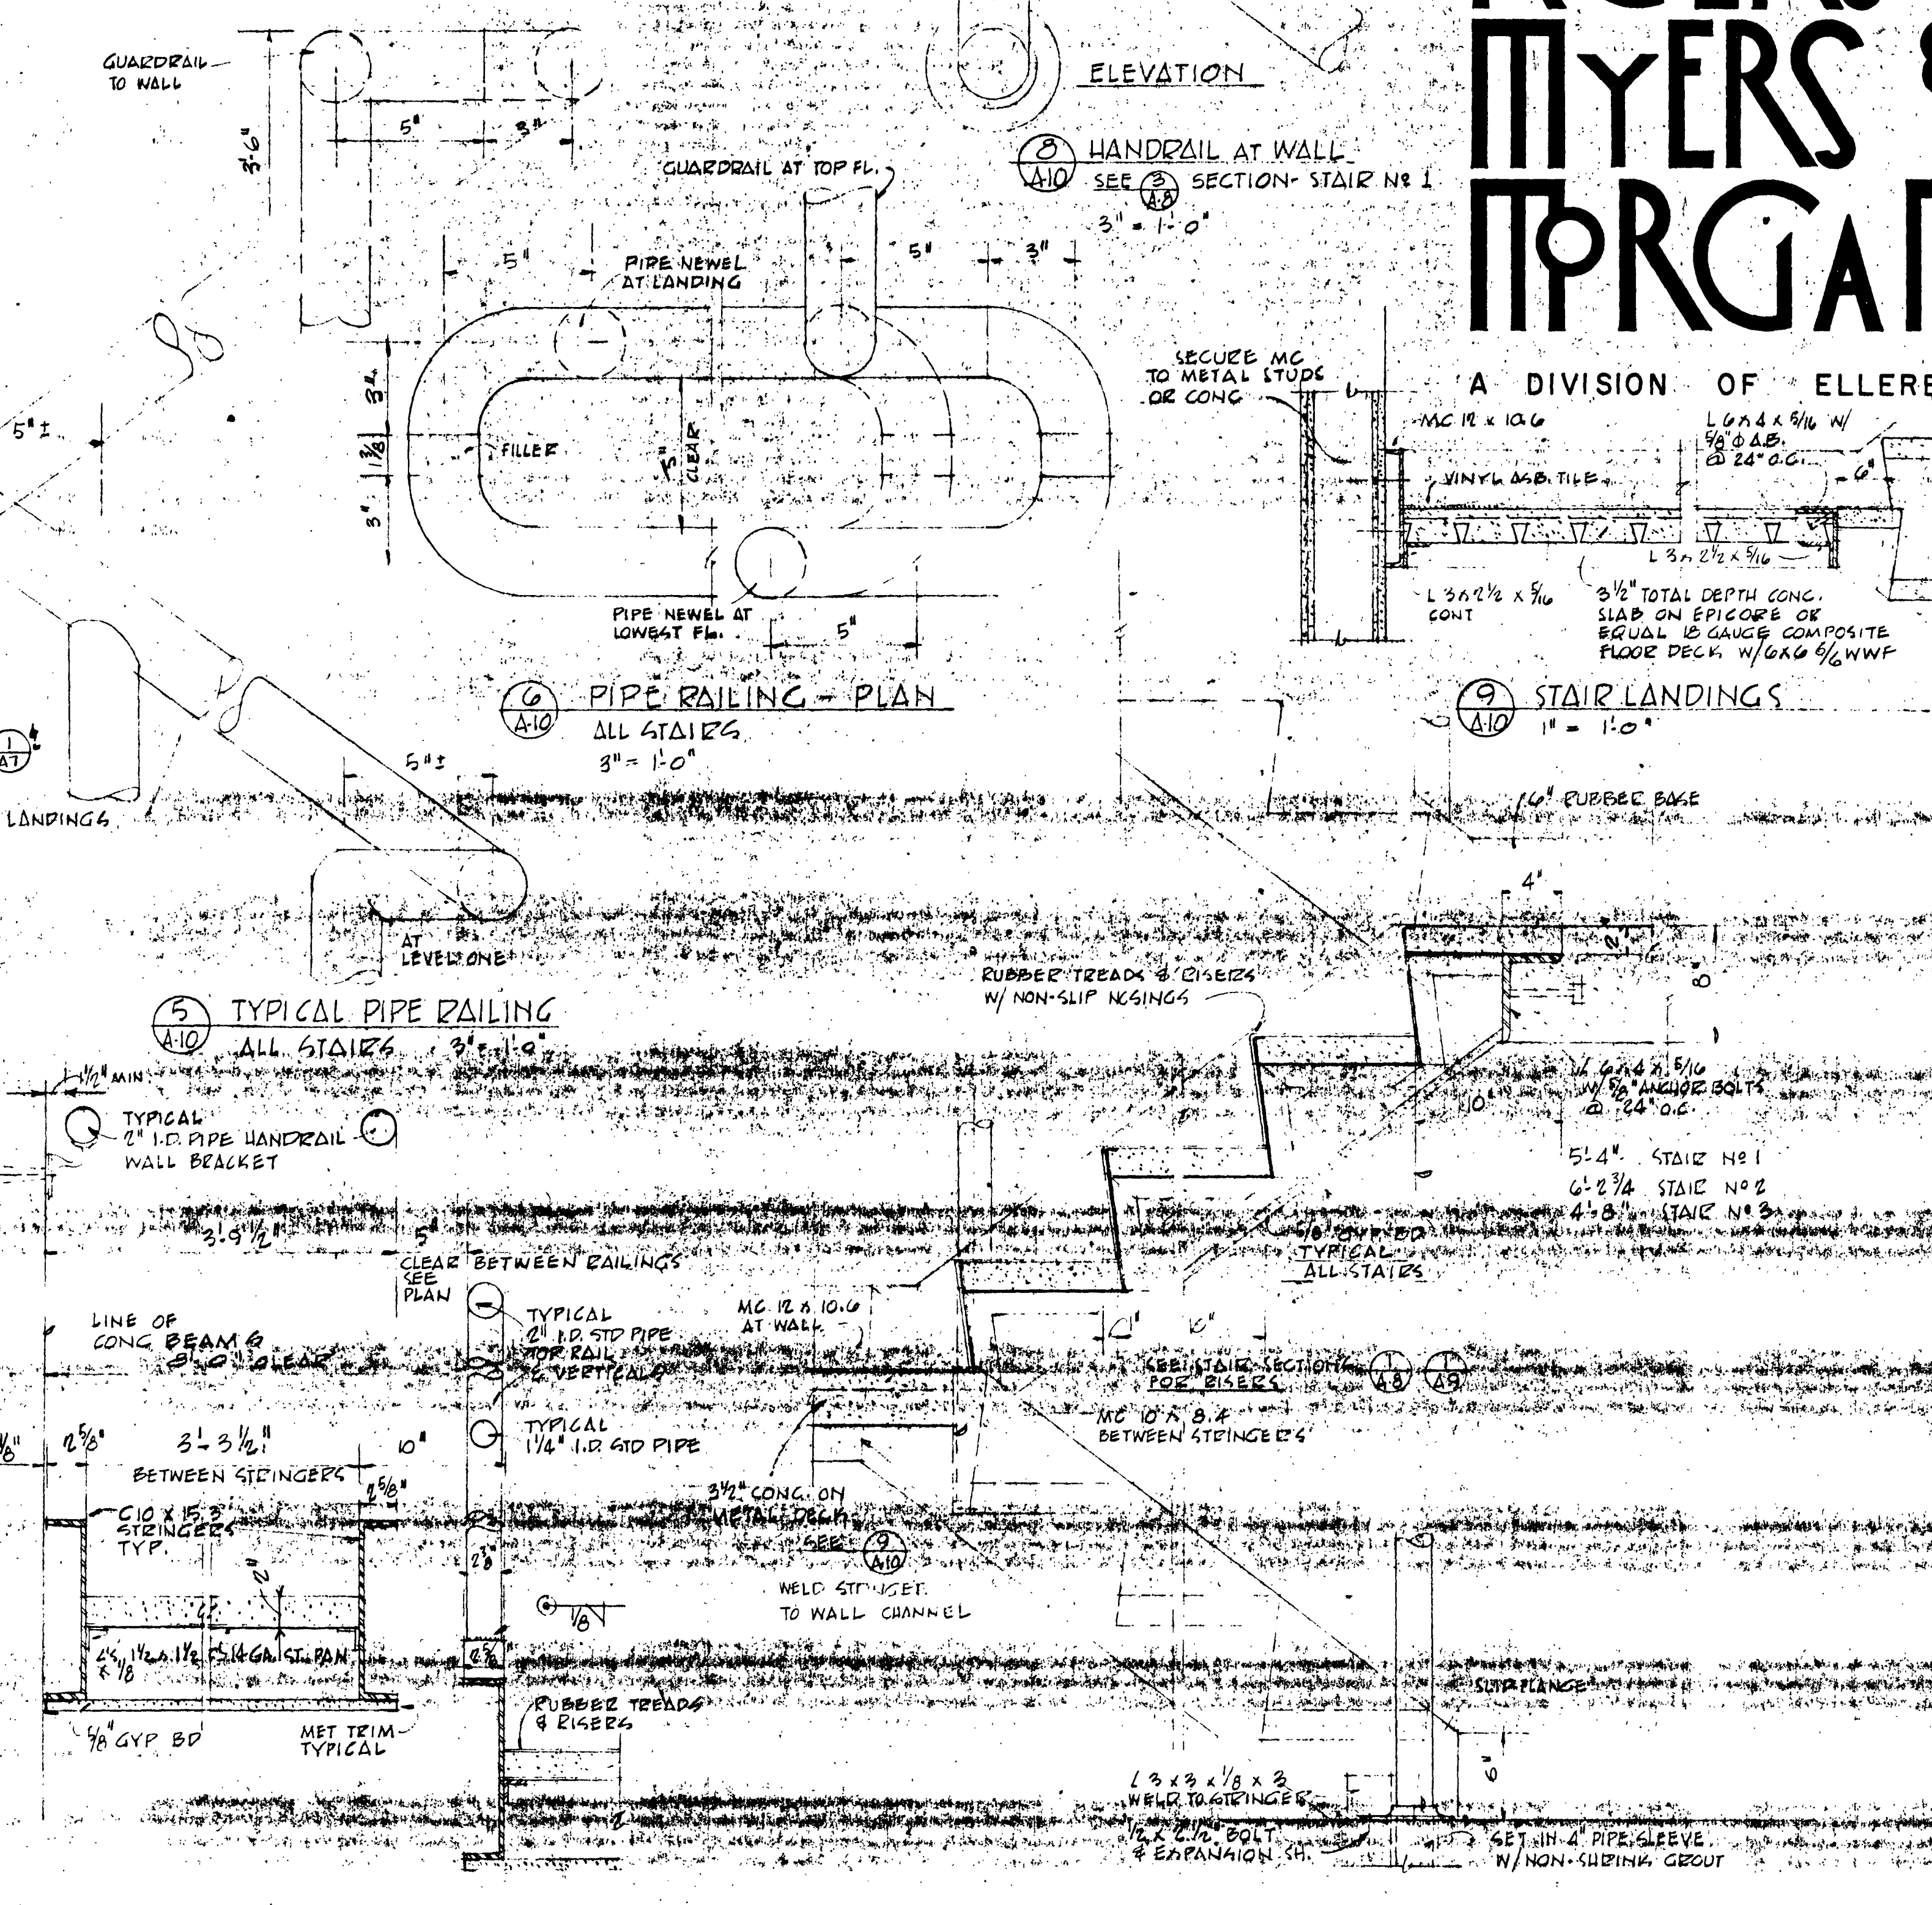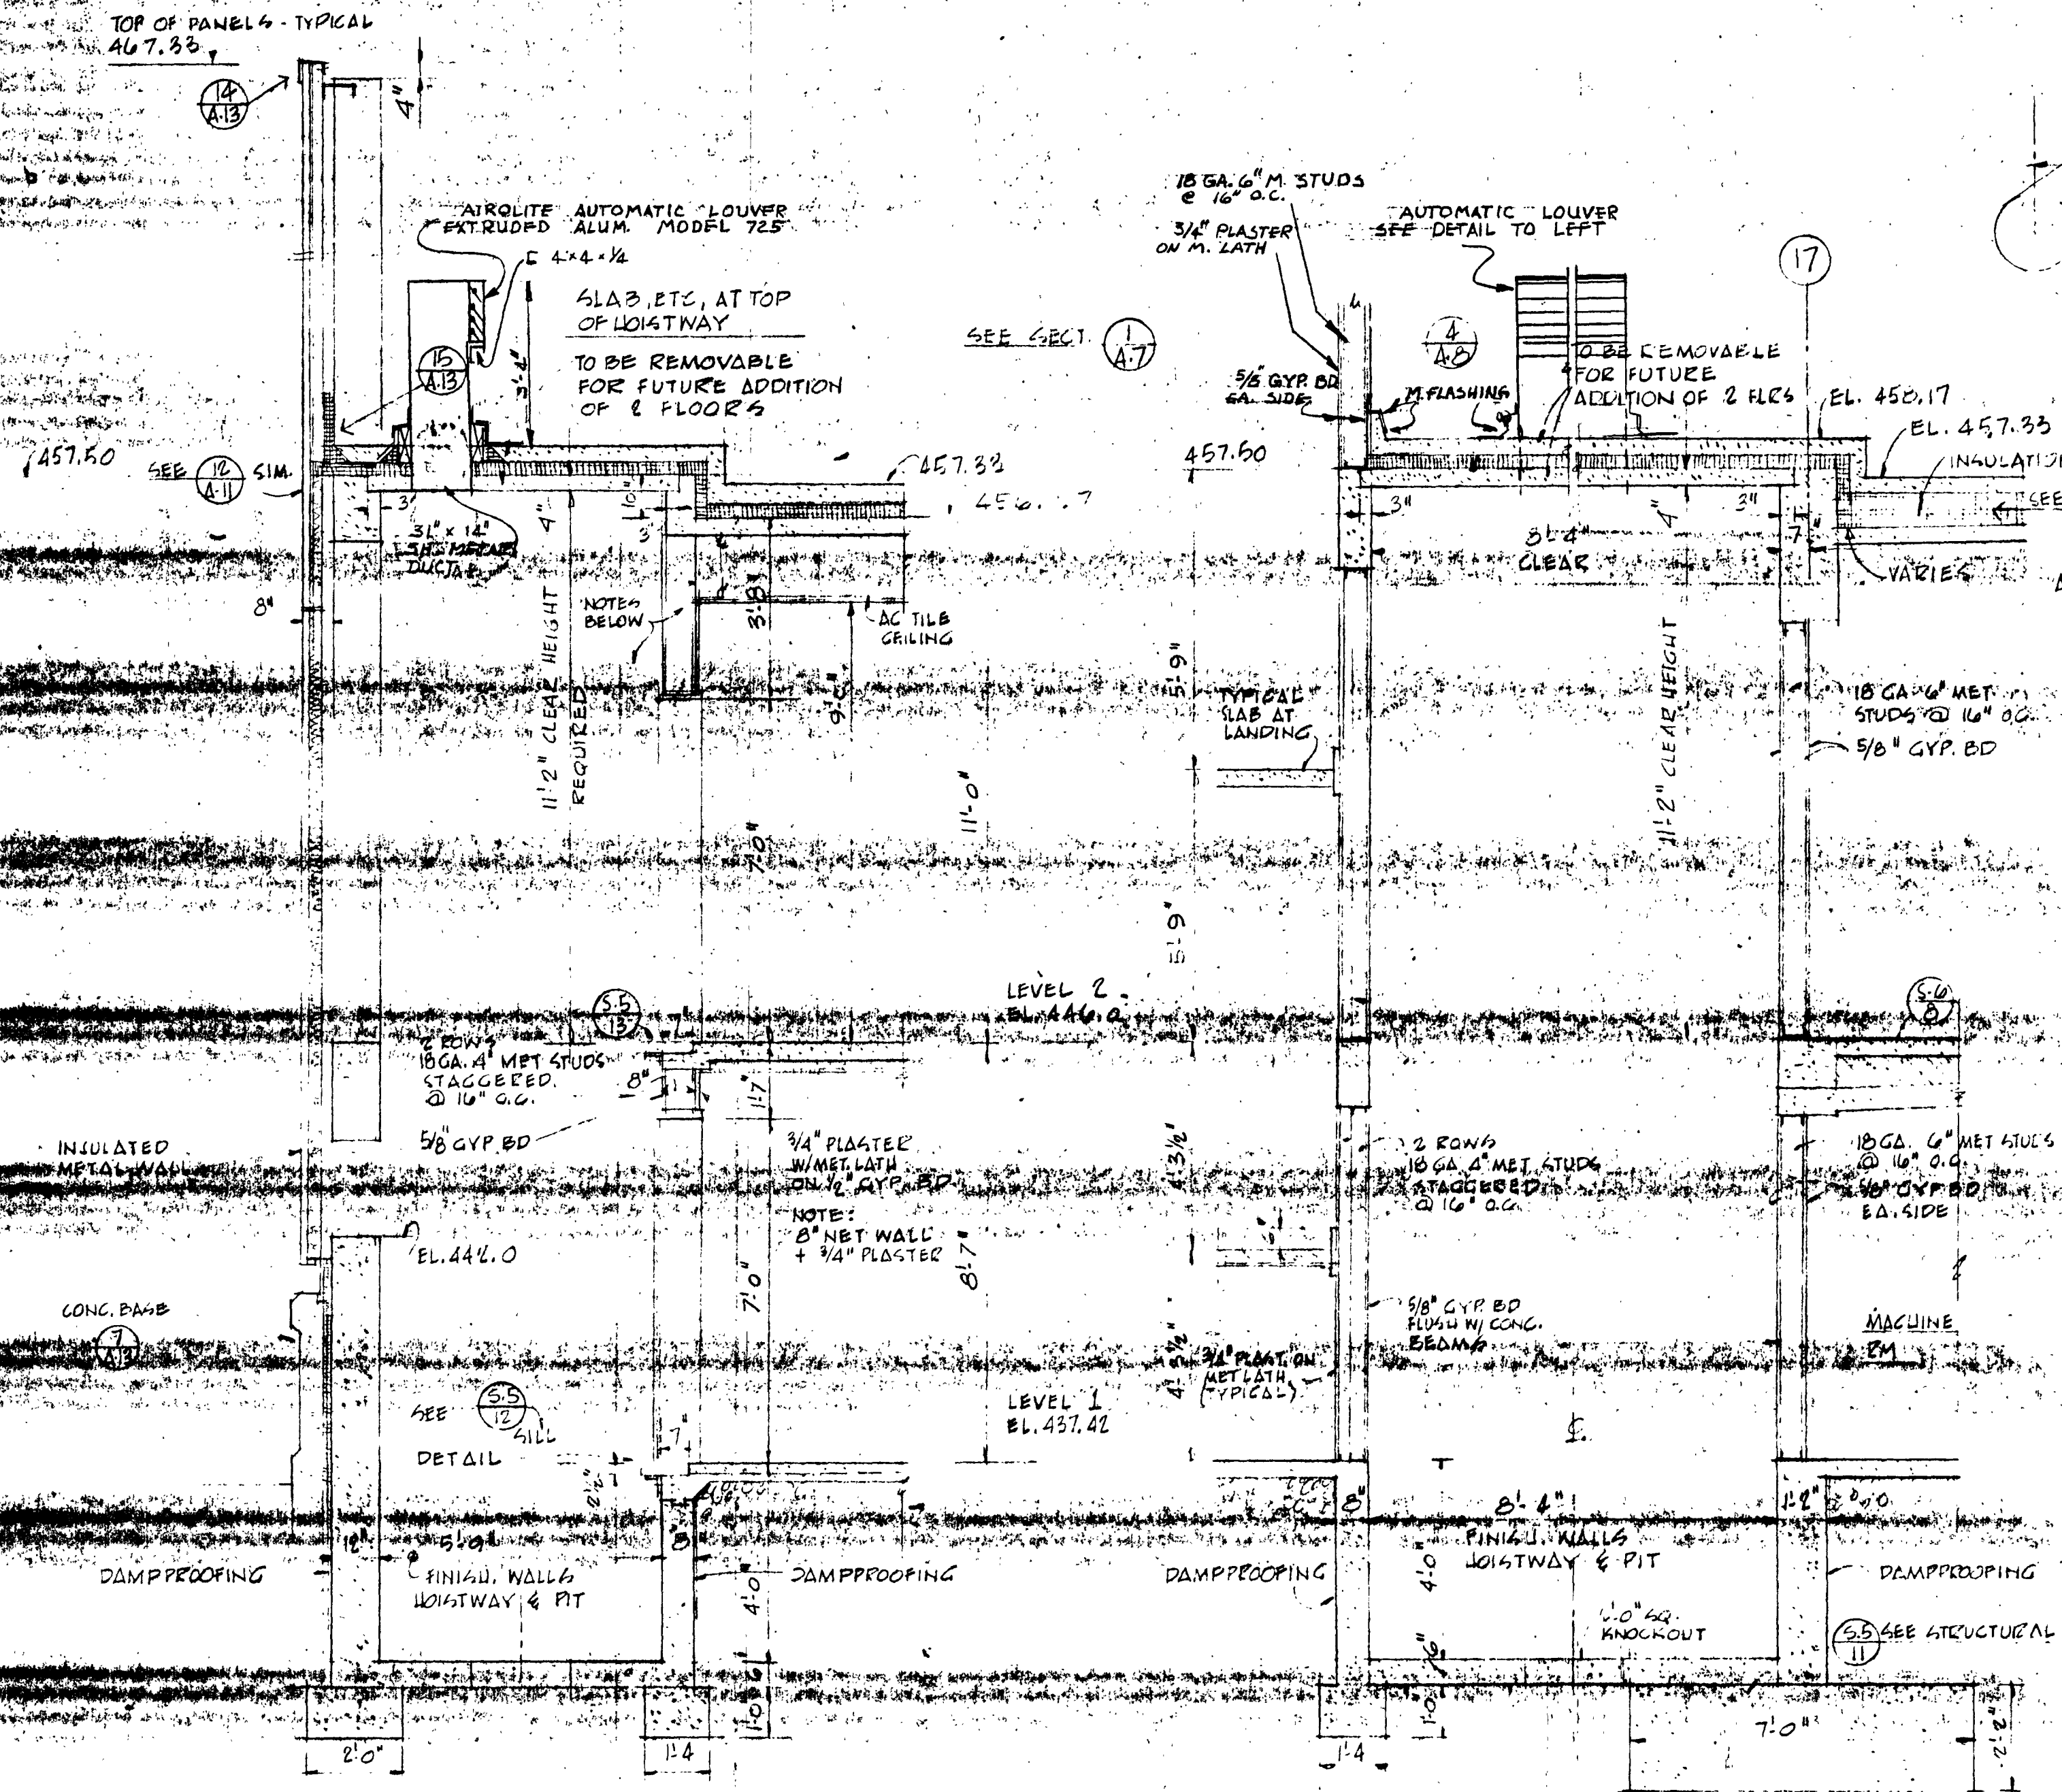

SECTION THROUGH HOISTWAY
3/8" = 1'-0"

SECTION THROUGH HOISTWAY
3/8" = 1'-0"

SECTION THROUGH STRINGERS
1/4" = 1'-0"


SECTION - STAIRS
1/4" = 1'-0"

ARCHITECTS • ENGINEERS • SURVEYORS
100 COLLEGE ROAD, FAIRBANKS, ALASKA 99701, PHONE: 452-1241

STATE OF ALASKA
DEPT. OF PUBLIC WORKS
DIVISION OF BUILDINGS
JUNEAU ALASKA



FAIRBANKS PARKING STRUCTURE
DBA - 2 - 0130
FAIRBANKS, AK

PETER KIEWIT SONS' CO.		A-10
FAIRBANKS, ALASKA	ALASKA	
CONTRACTOR'S REP.	OWNER'S REP.	AS-BLT SHEET 13 OF 40

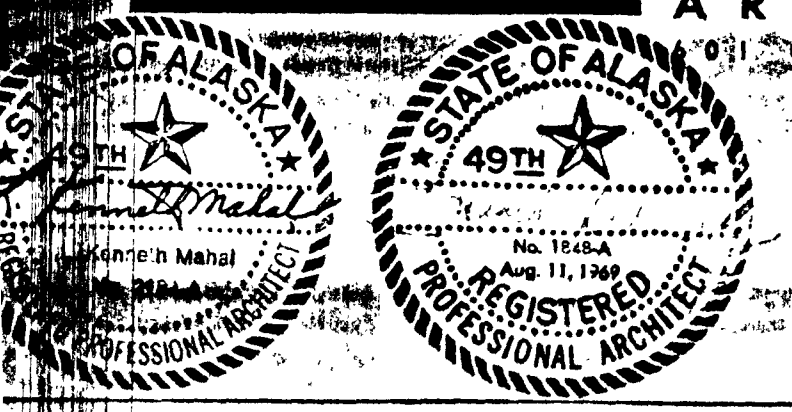

GRAY ROGERS MYERS & MORGAN

A DIVISION OF ELLERBE

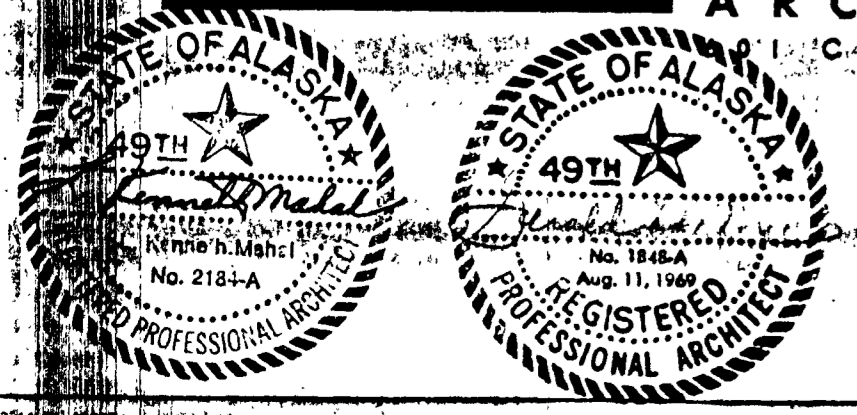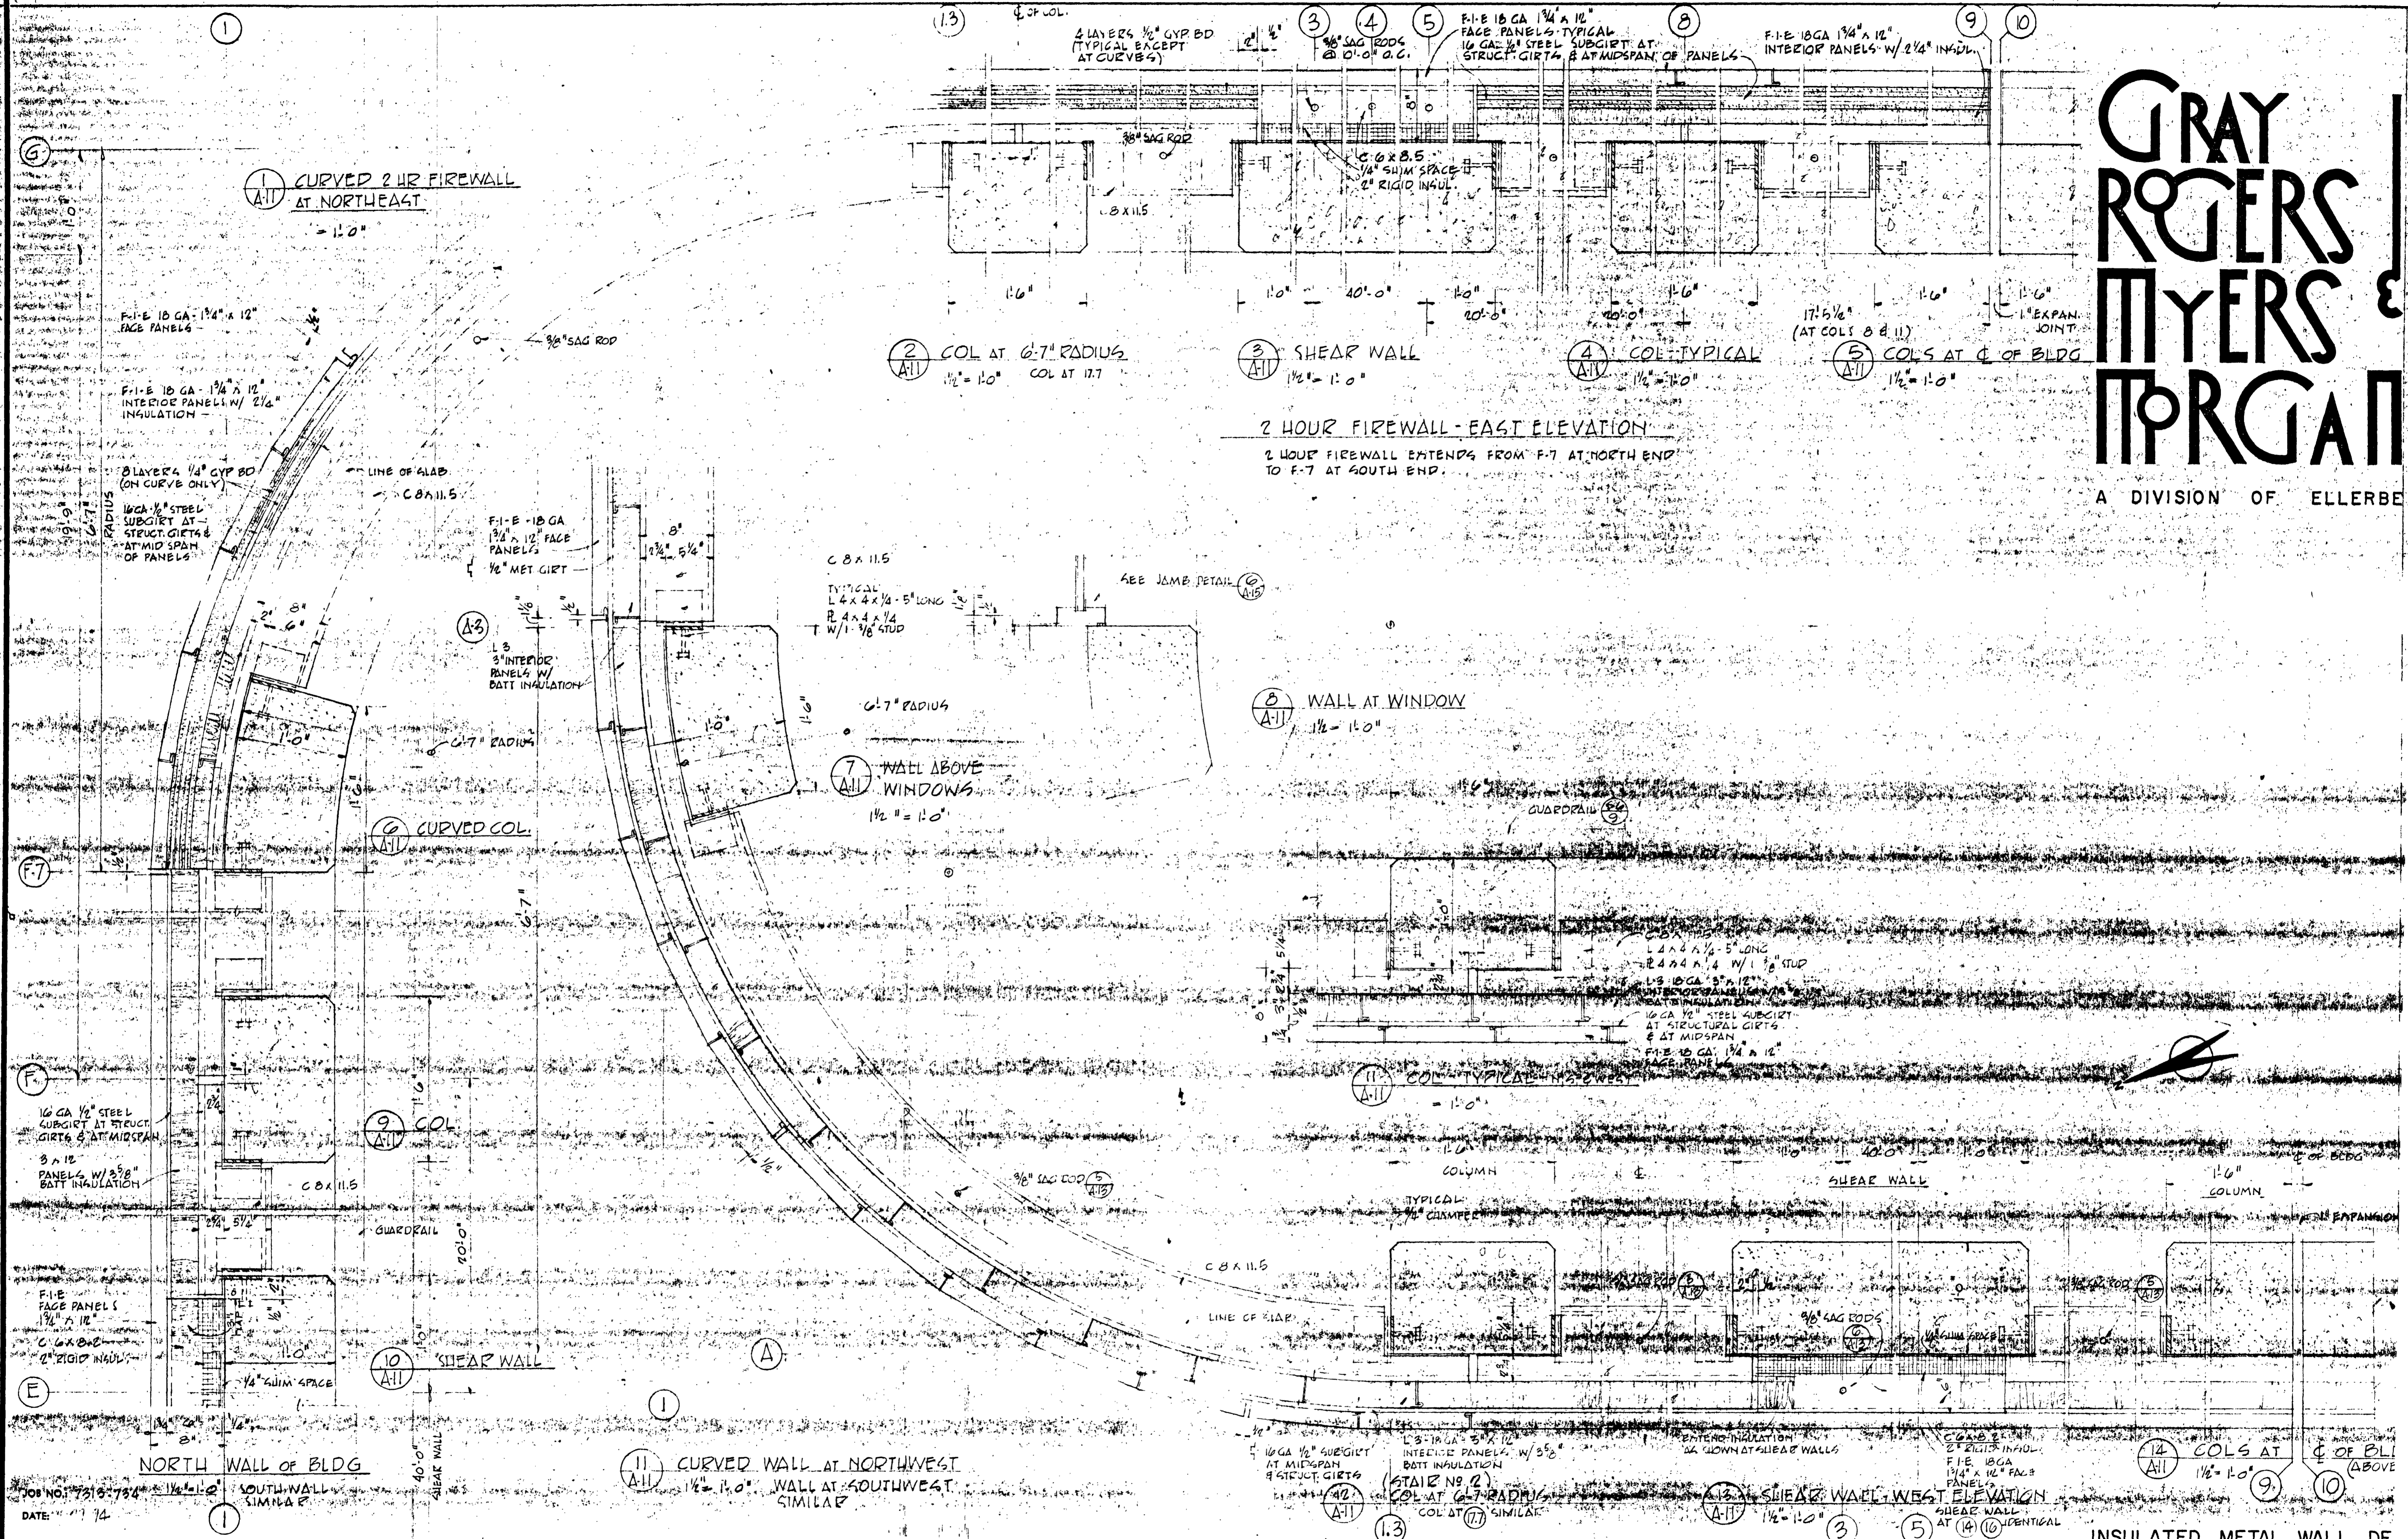

ARCHITECTS • ENGINEERS • SURVEYORS
 100 COLLEGE ROAD, FAIRBANKS, ALASKA 99701, PHONE: 452-1241

STATE OF ALASKA
 DEPT. OF PUBLIC WORKS
 DIVISION OF BUILDINGS
 JUNEAU ALASKA

FAIRBANKS PARKING STRUCTURE

FAIRBANKS, AK.

PETER KIEWIT SONS' CO.













FAIRBANKS ALASKA

RECOMMENDED BY: [Signature]


APPROVED BY: [Signature]

DATE: [Blank]

AS-BLT SHEET 14 OF 20

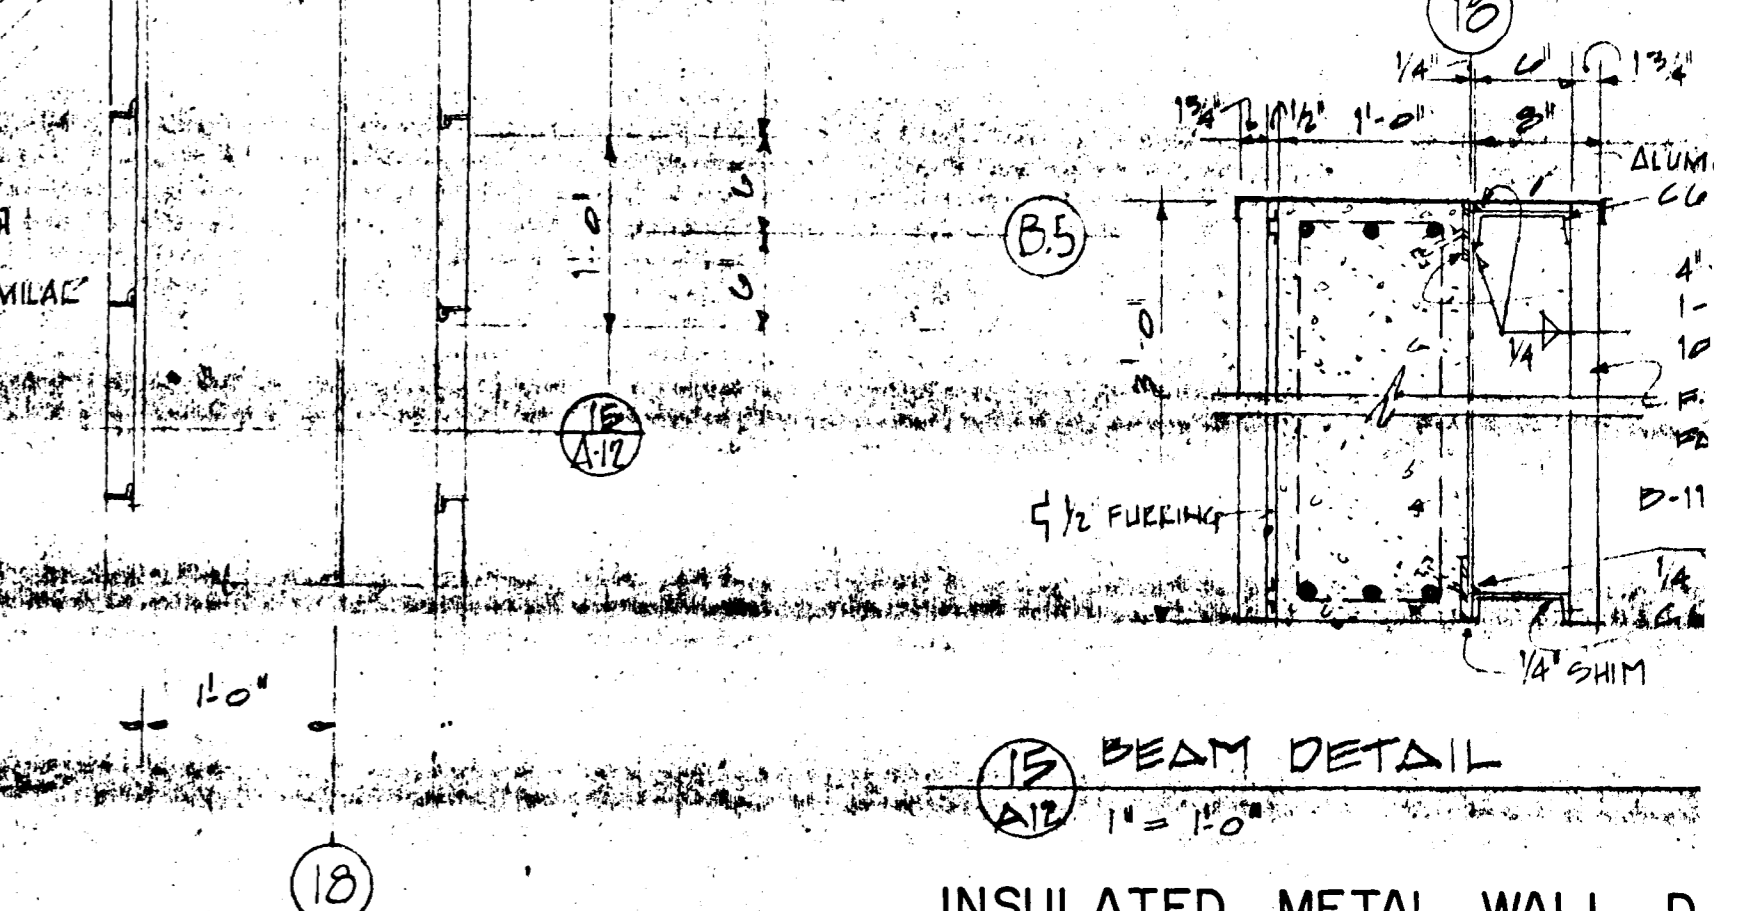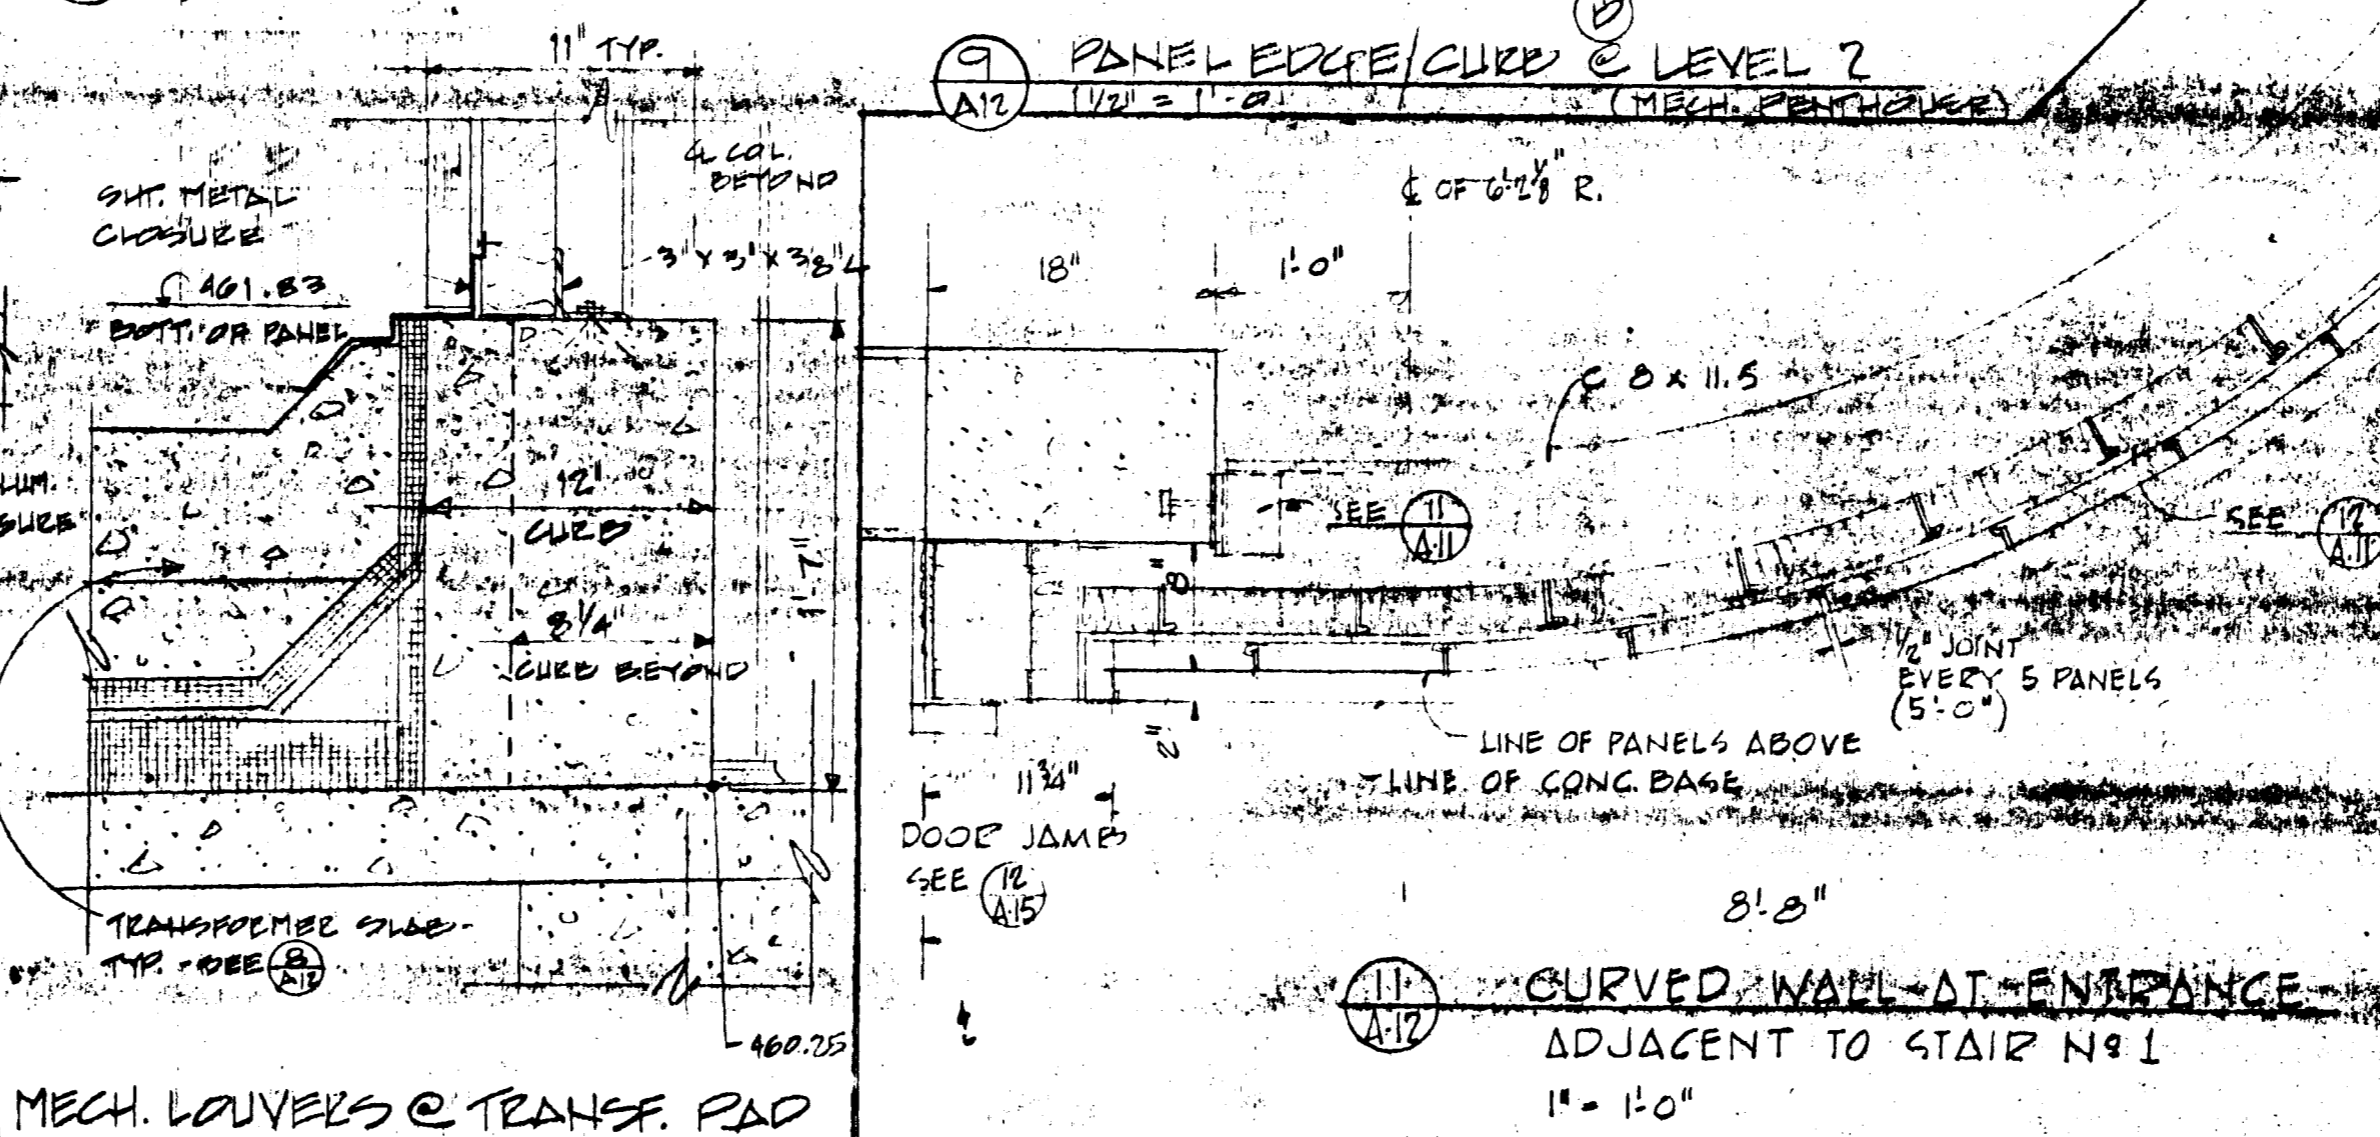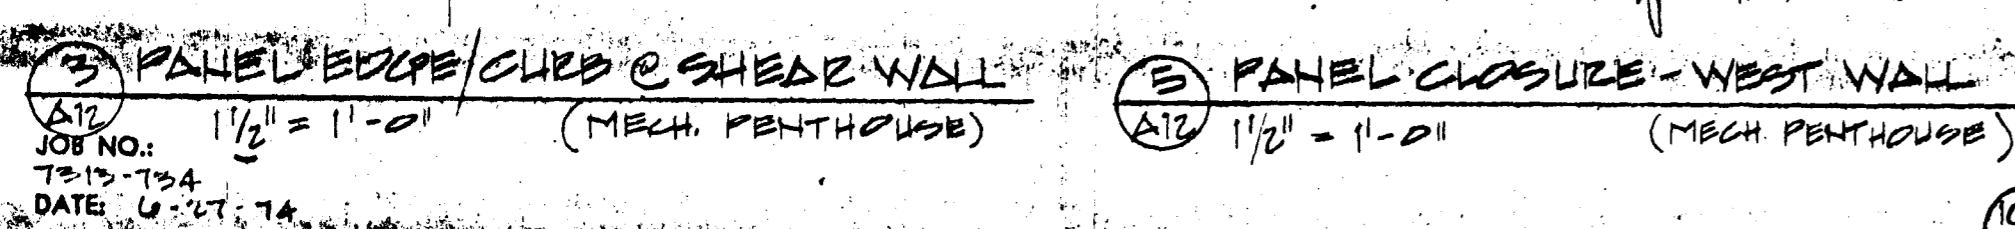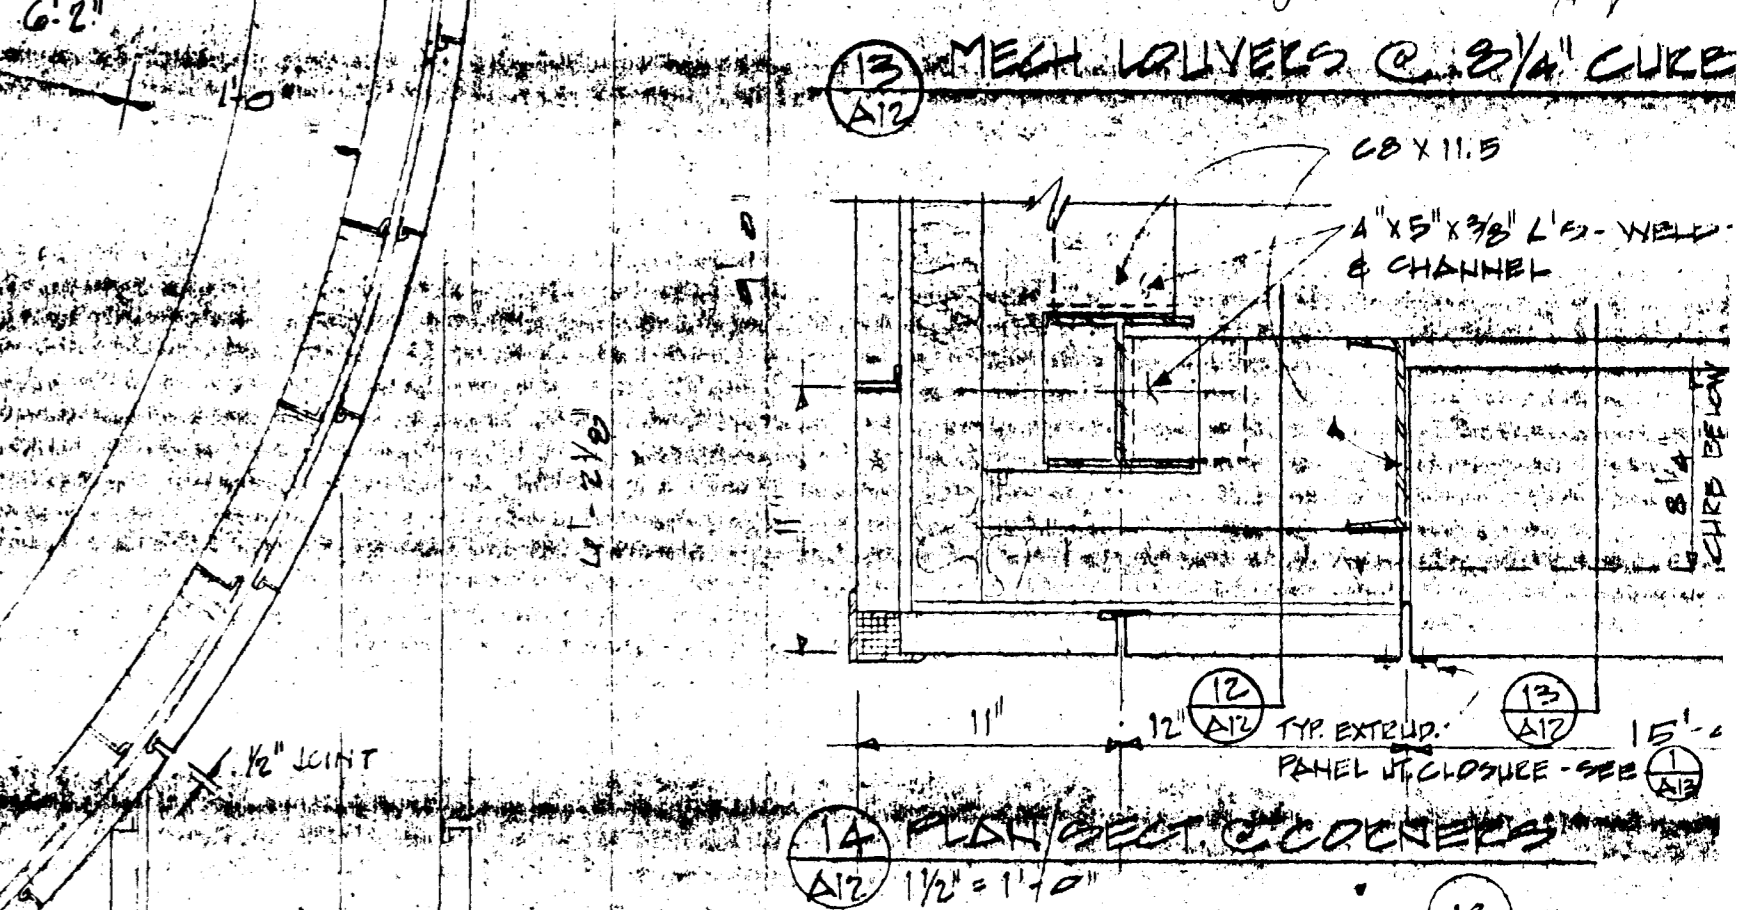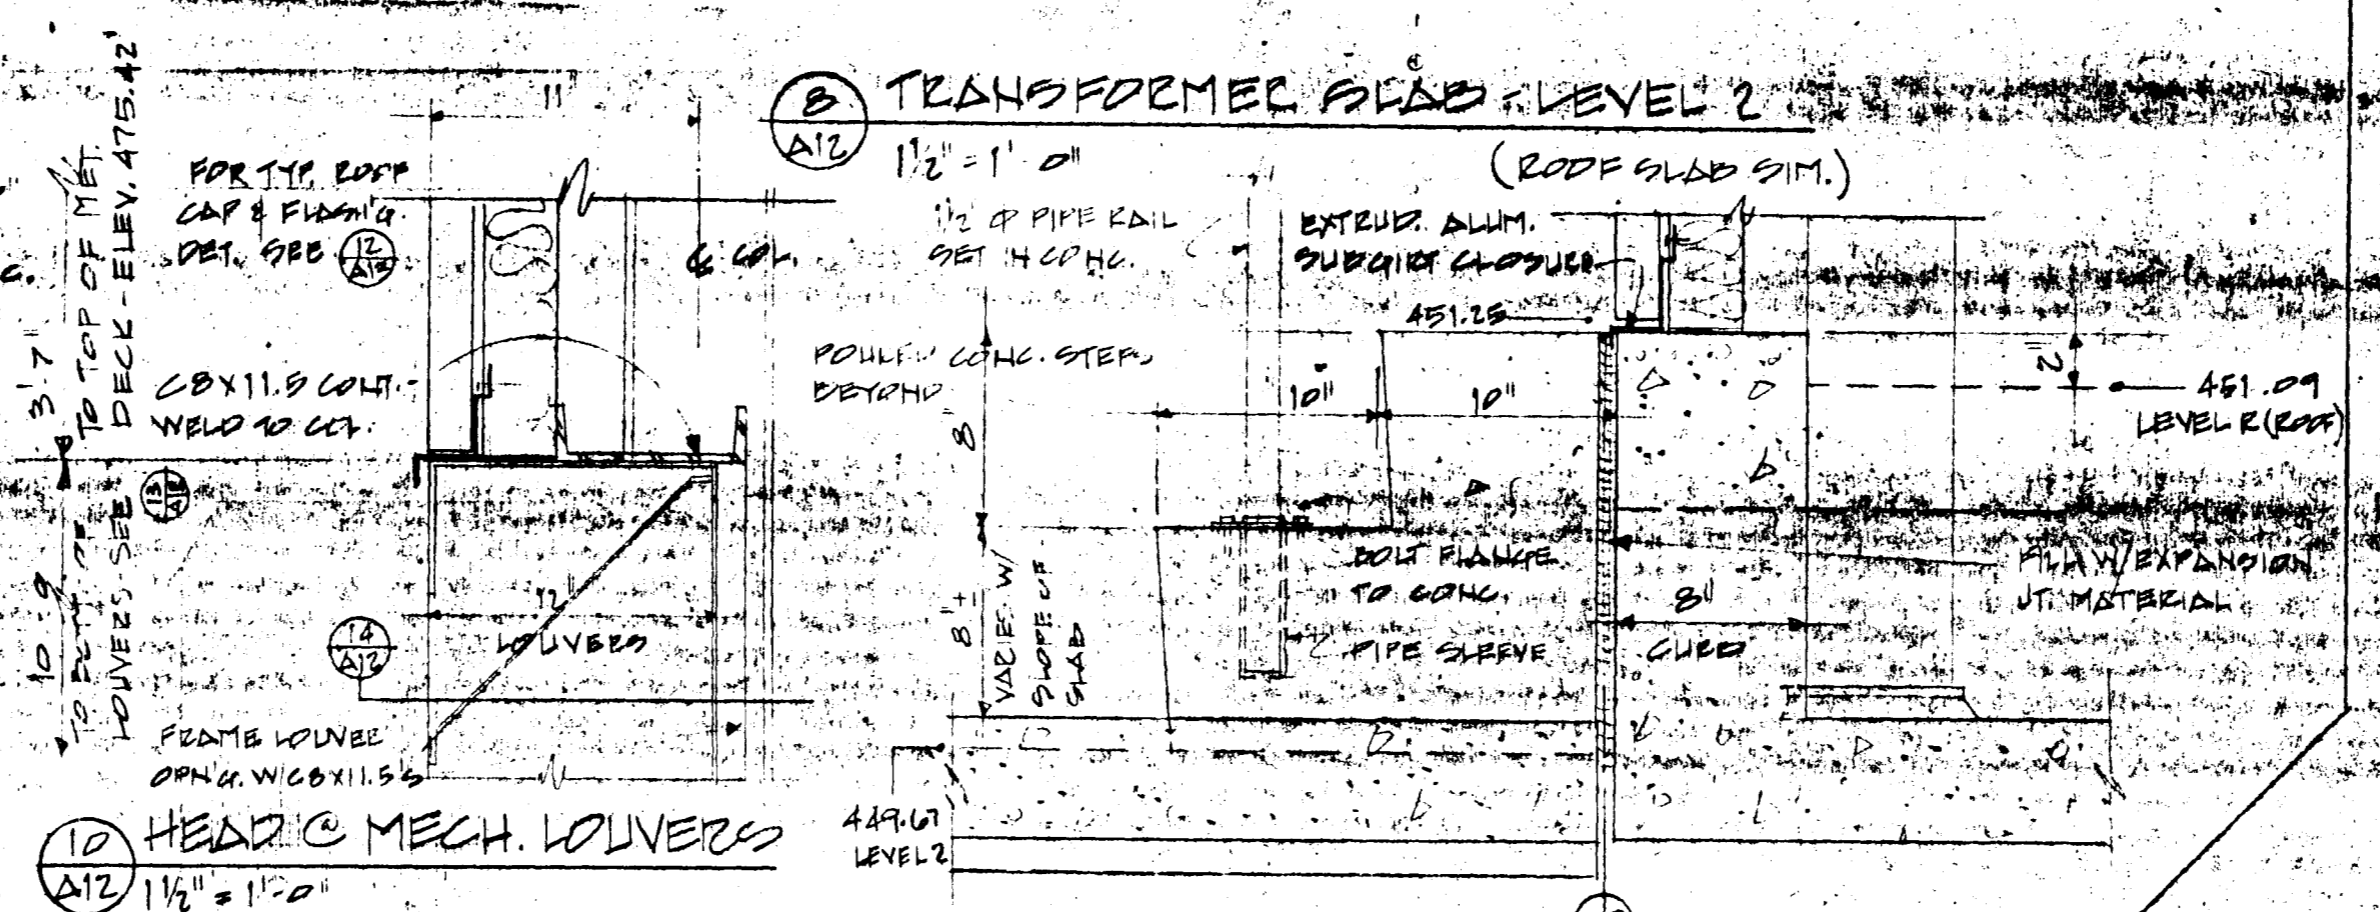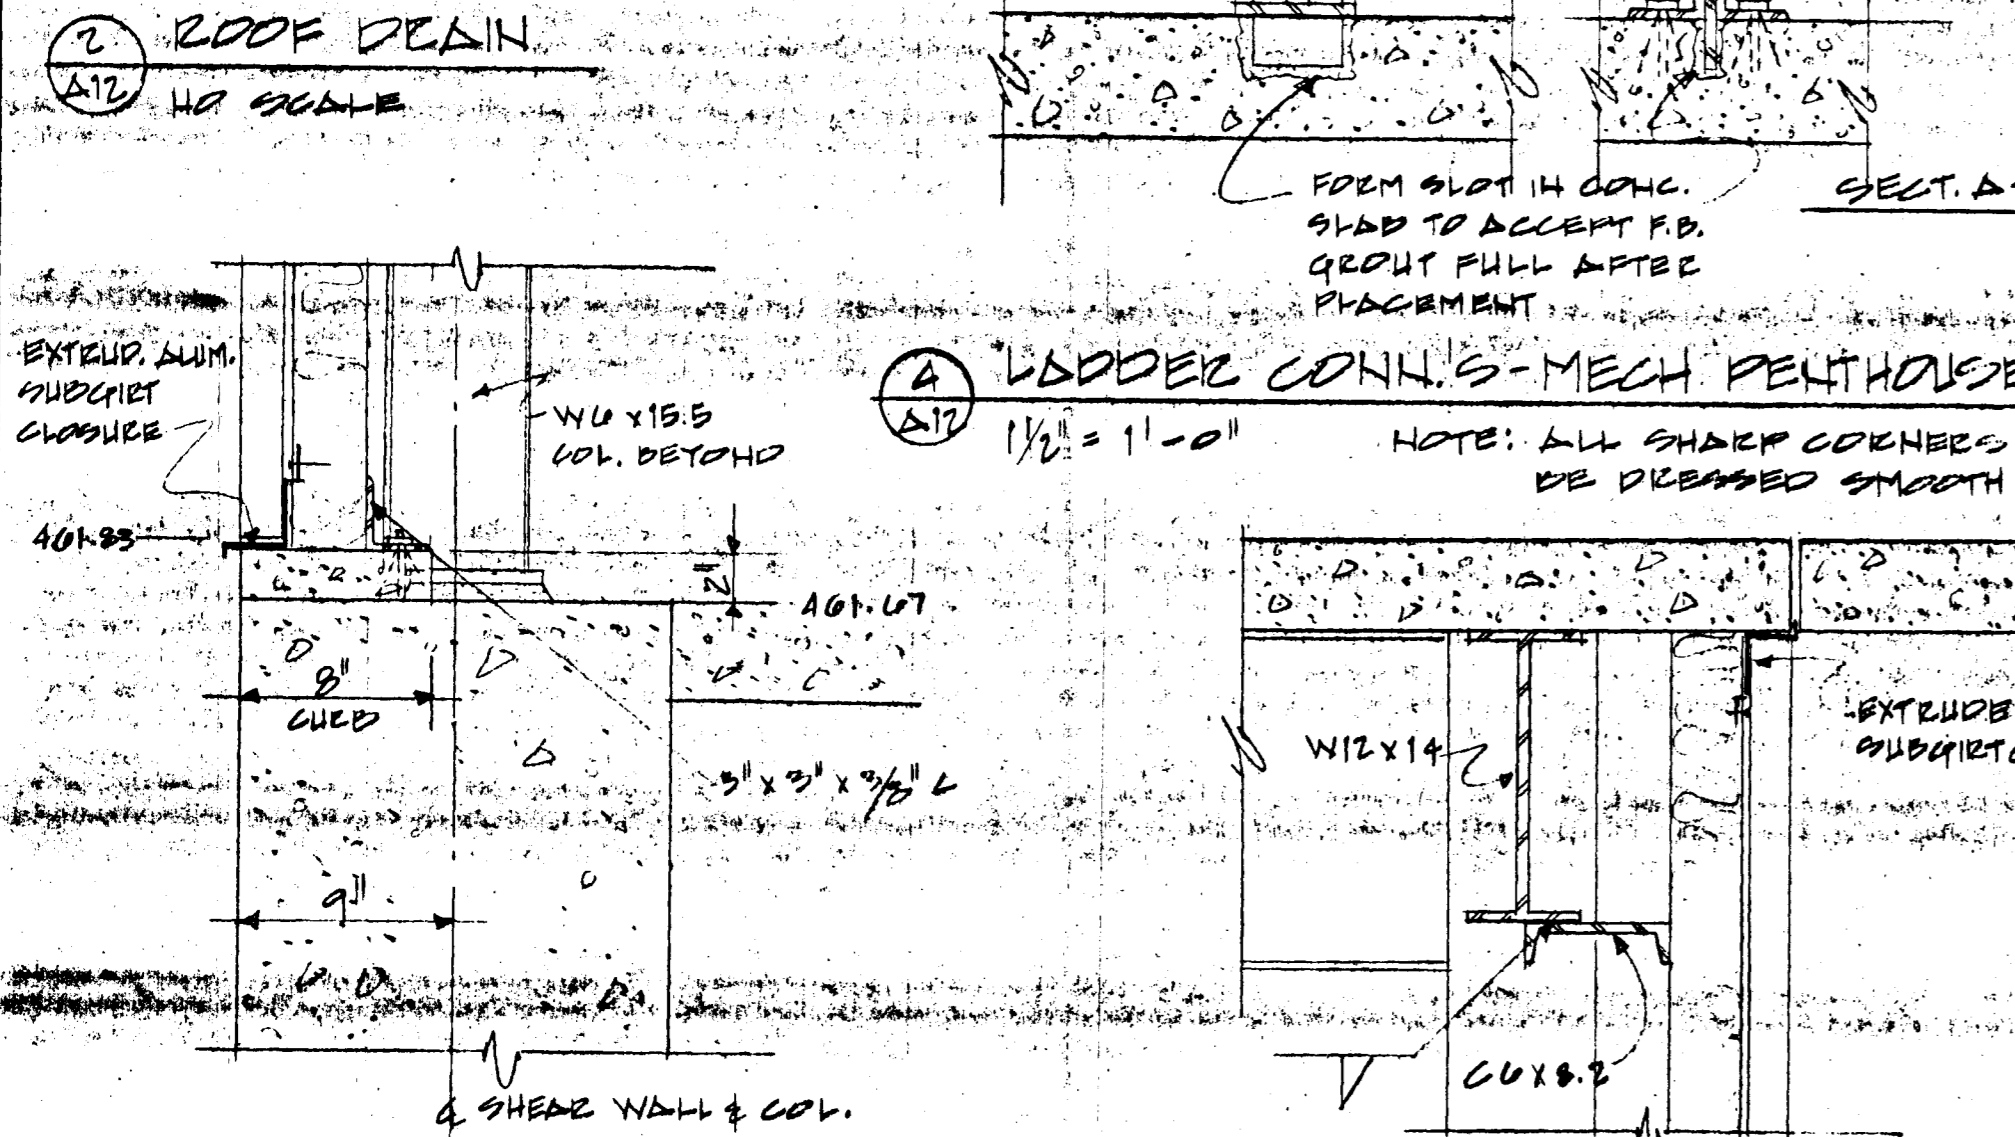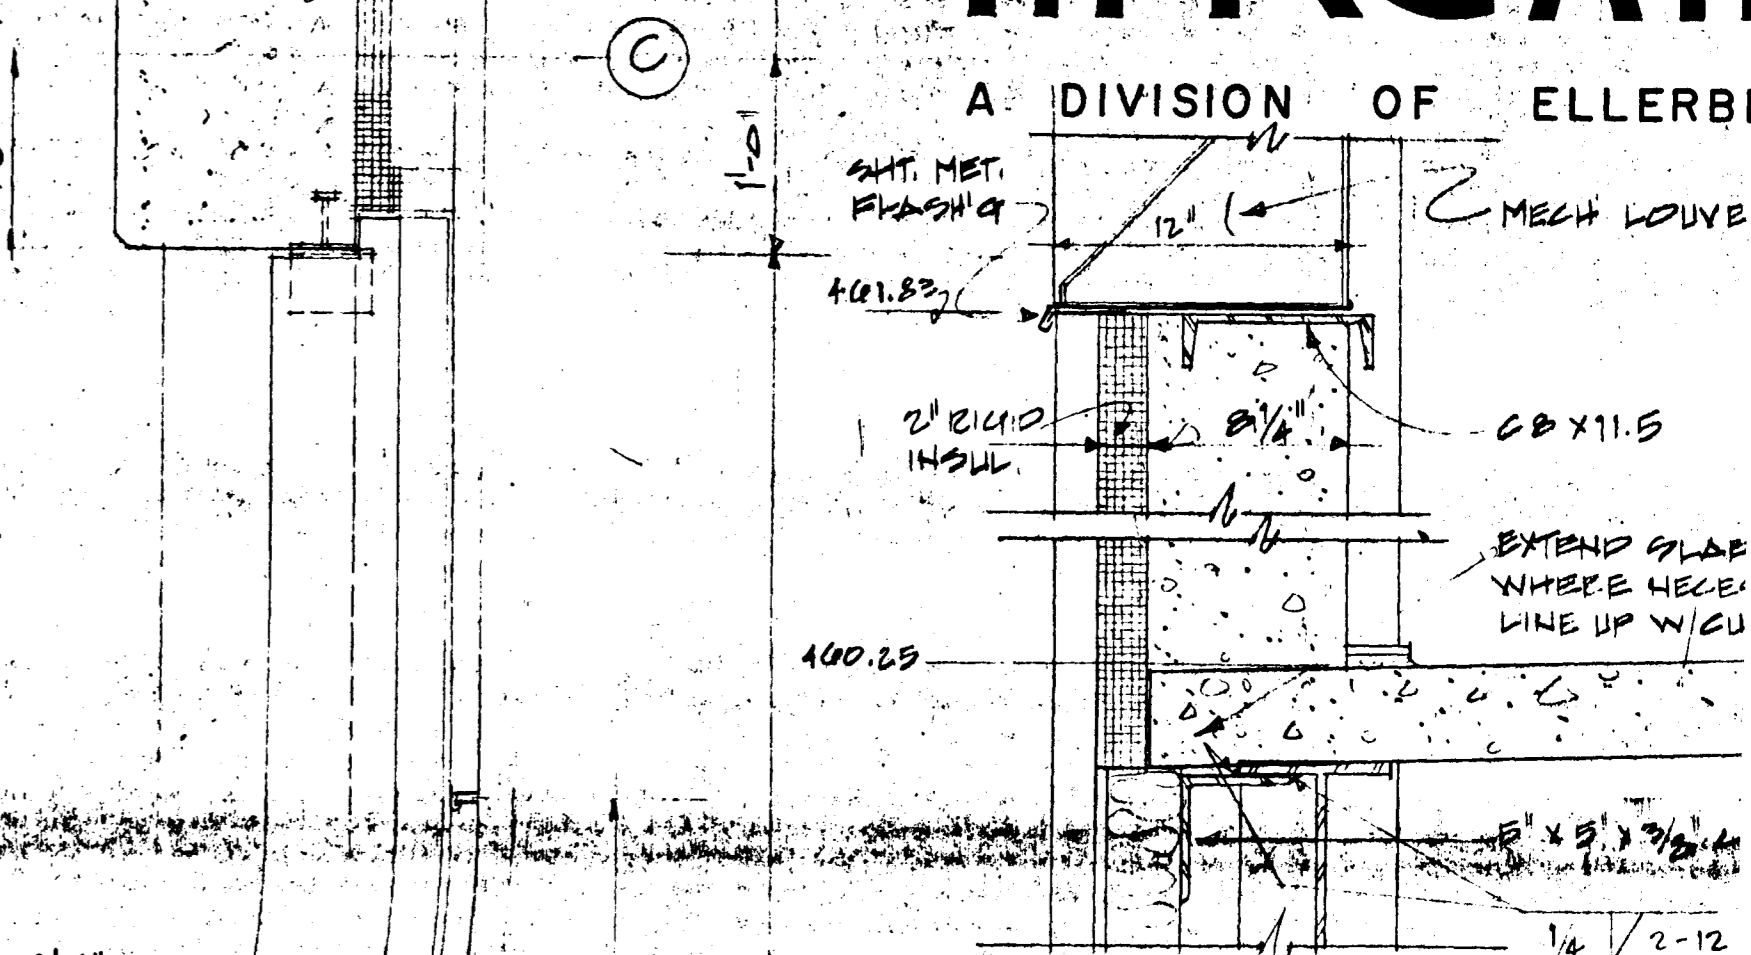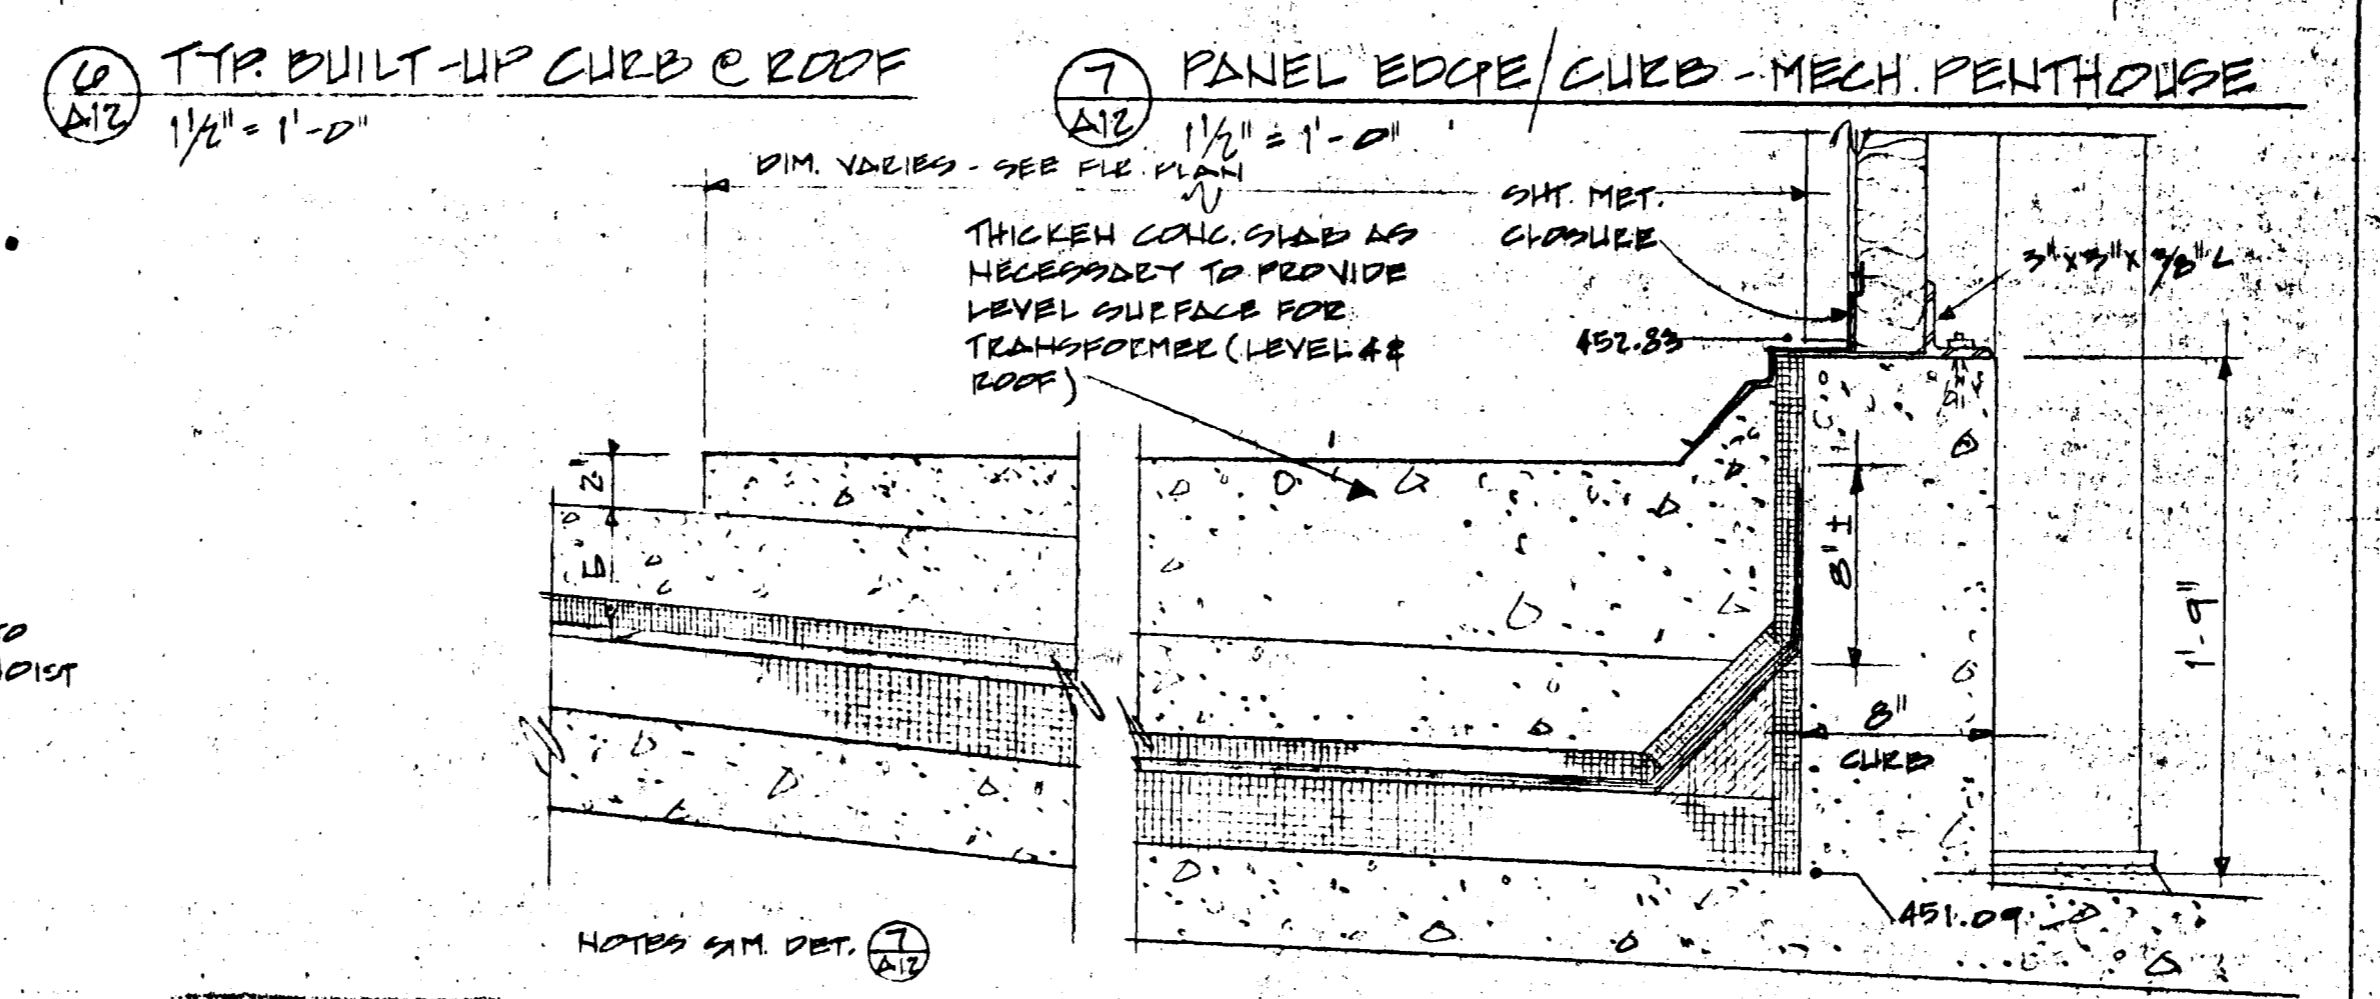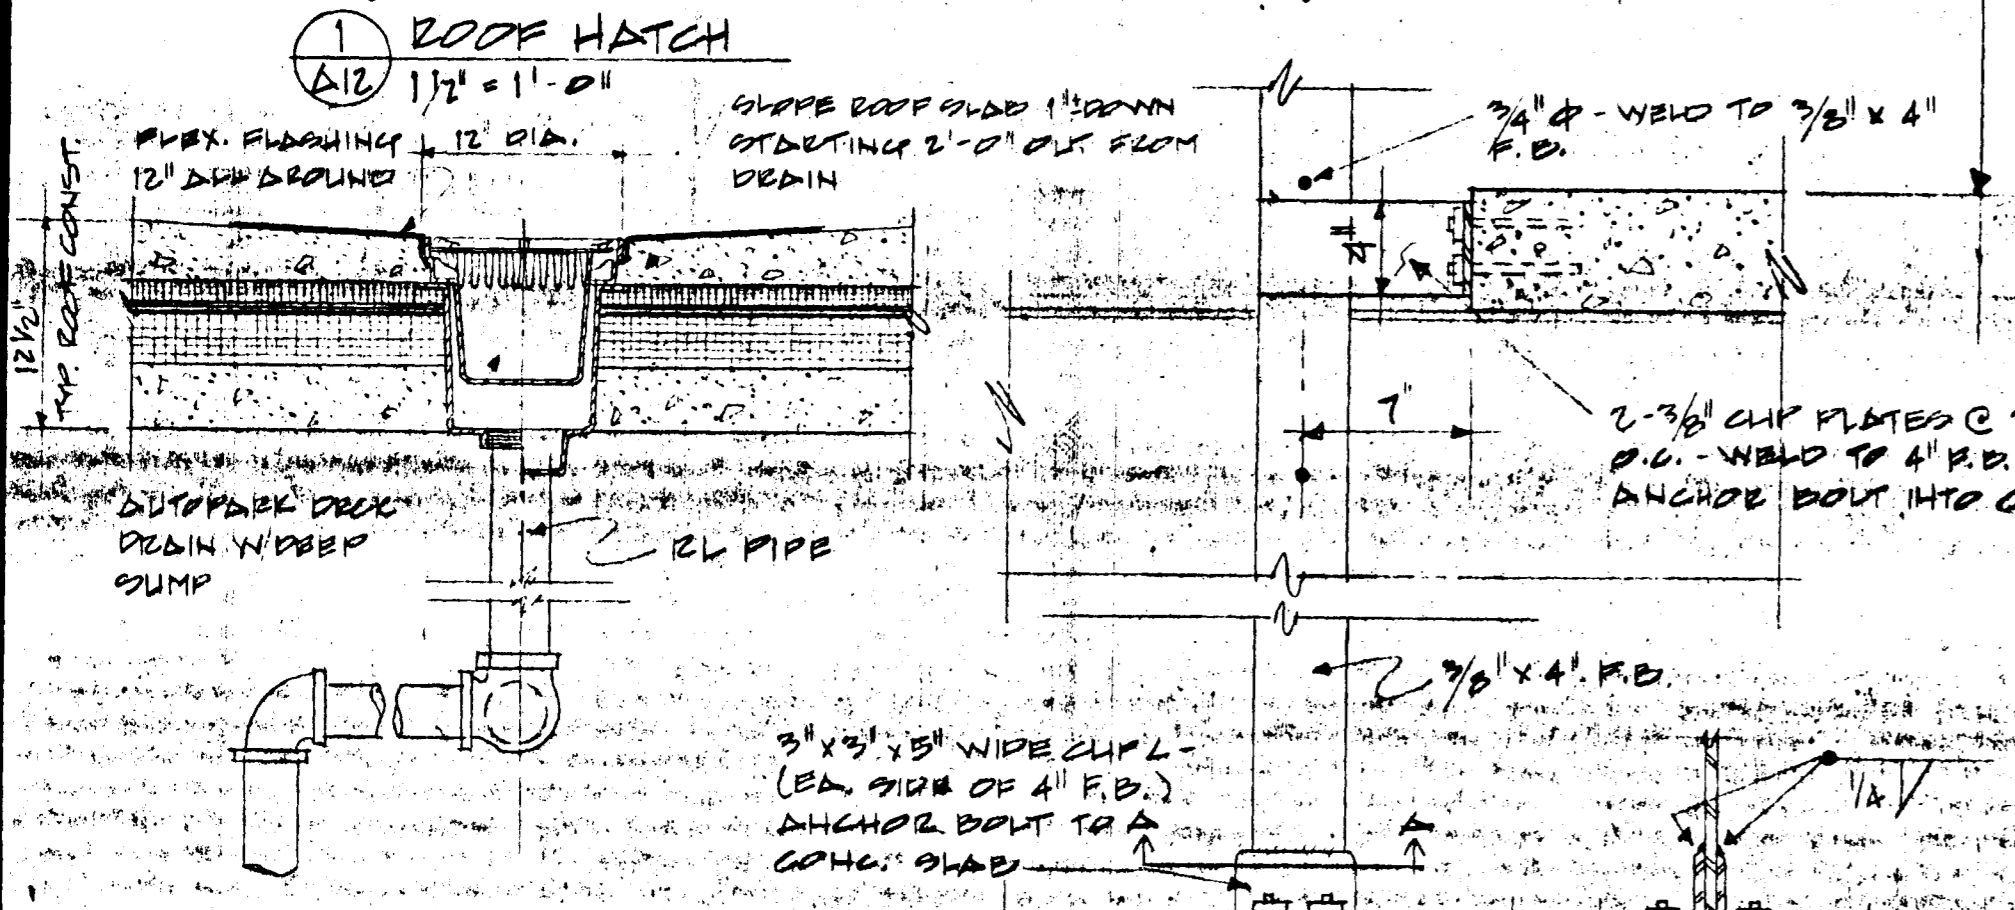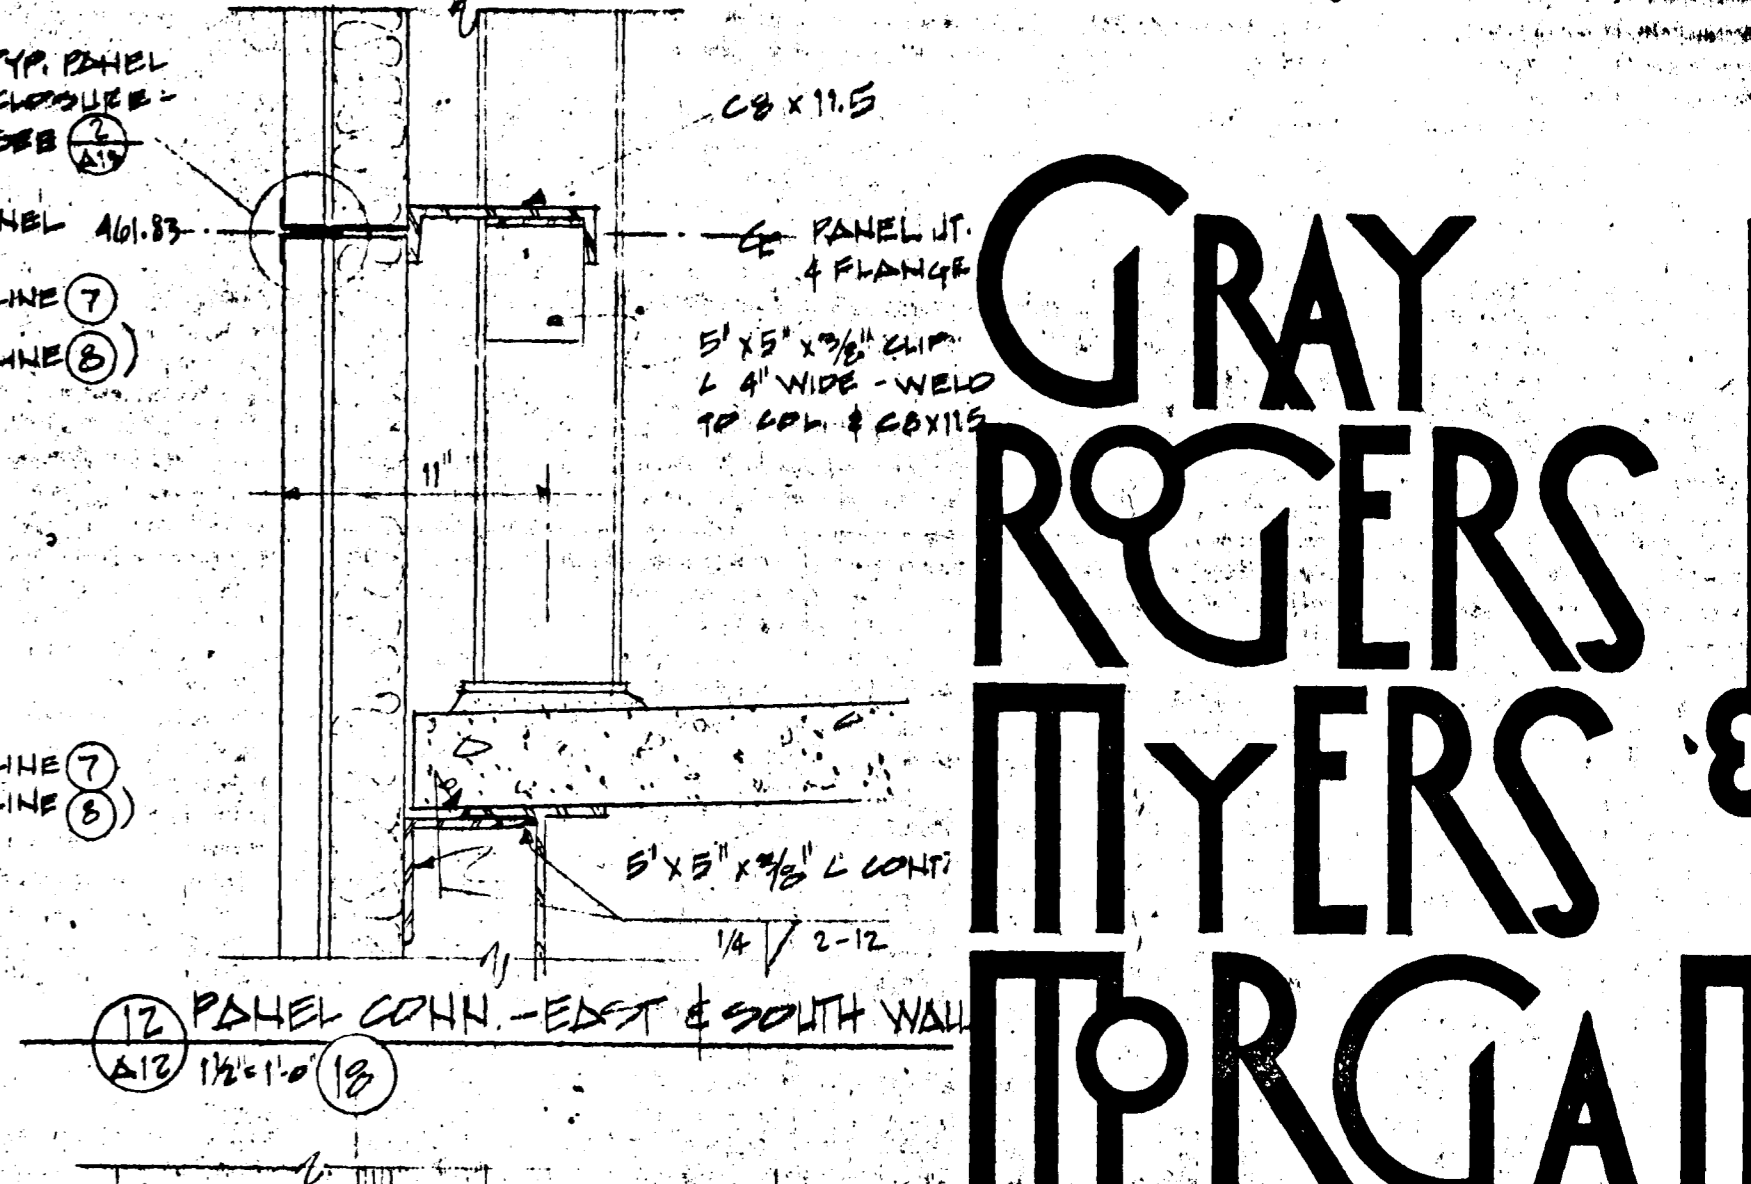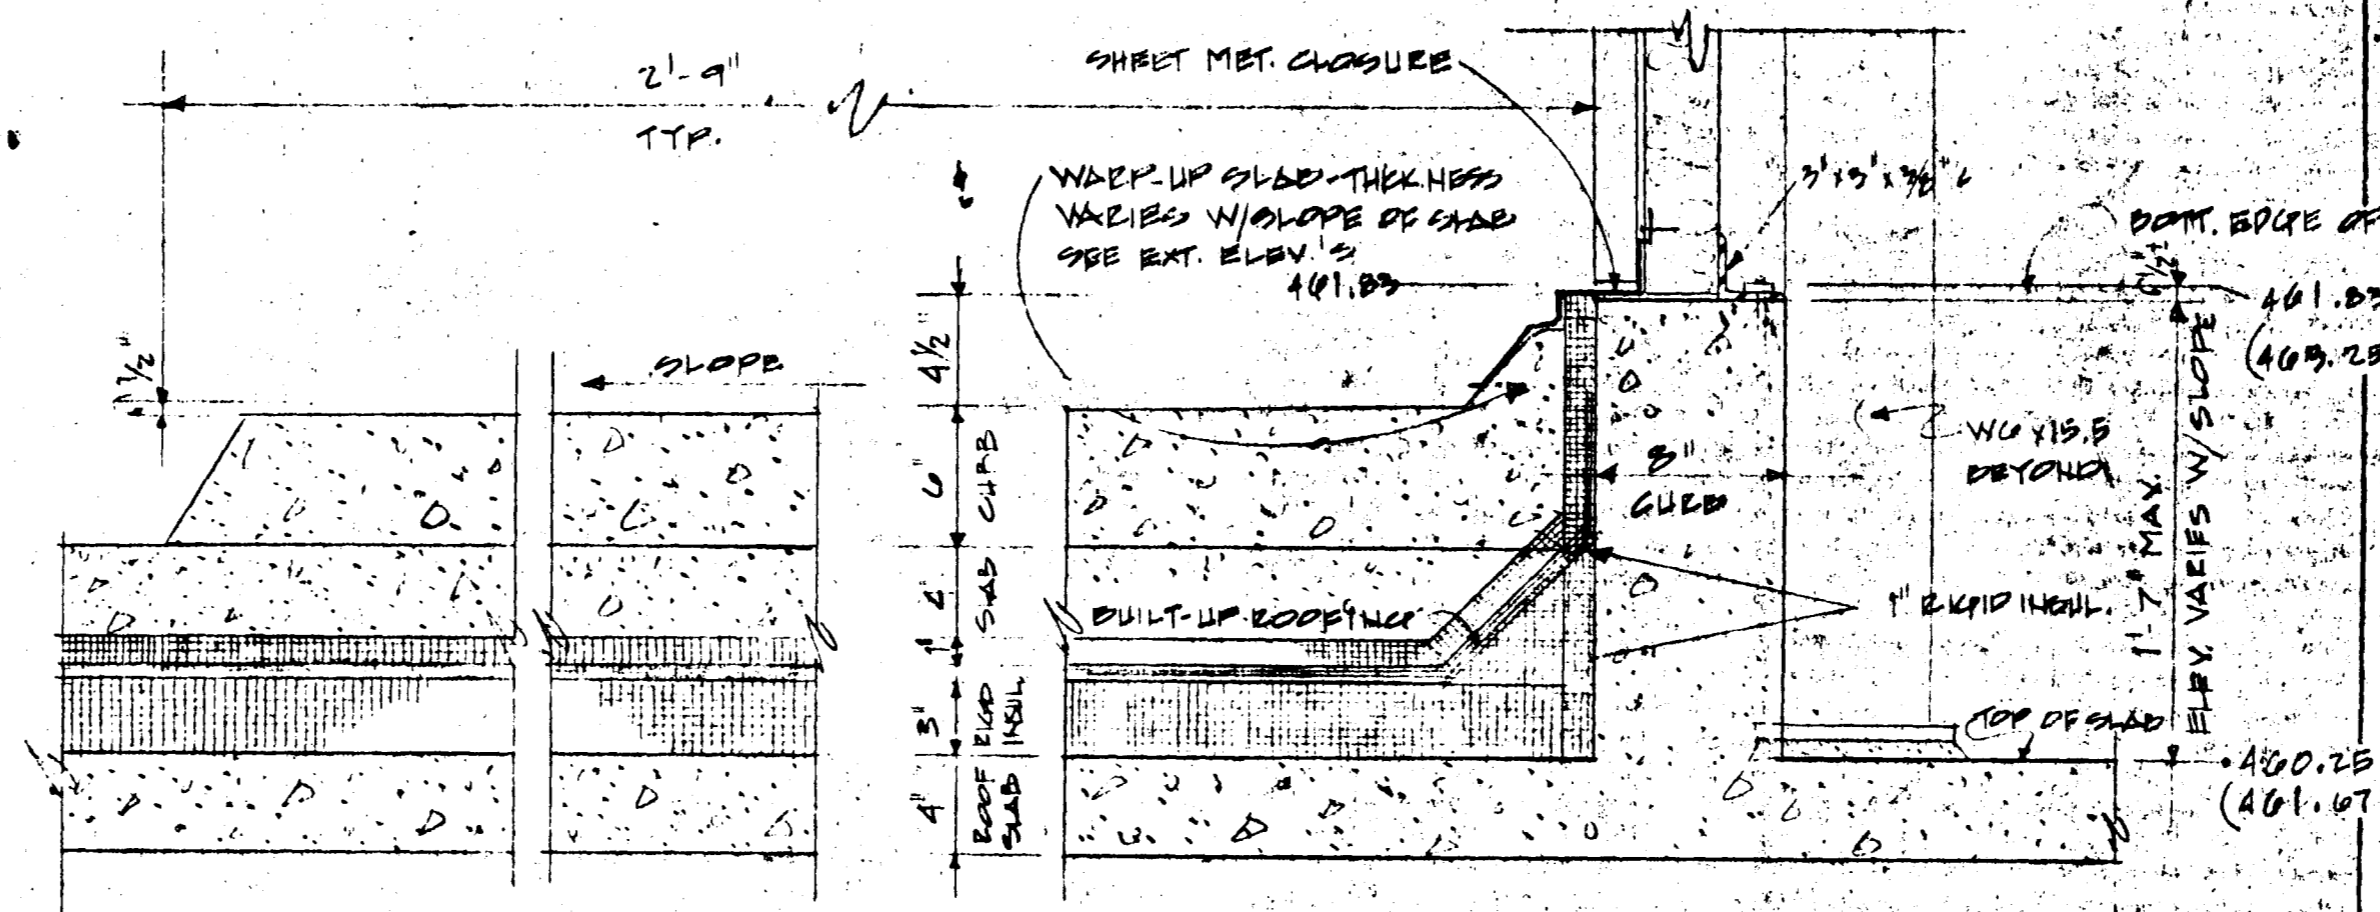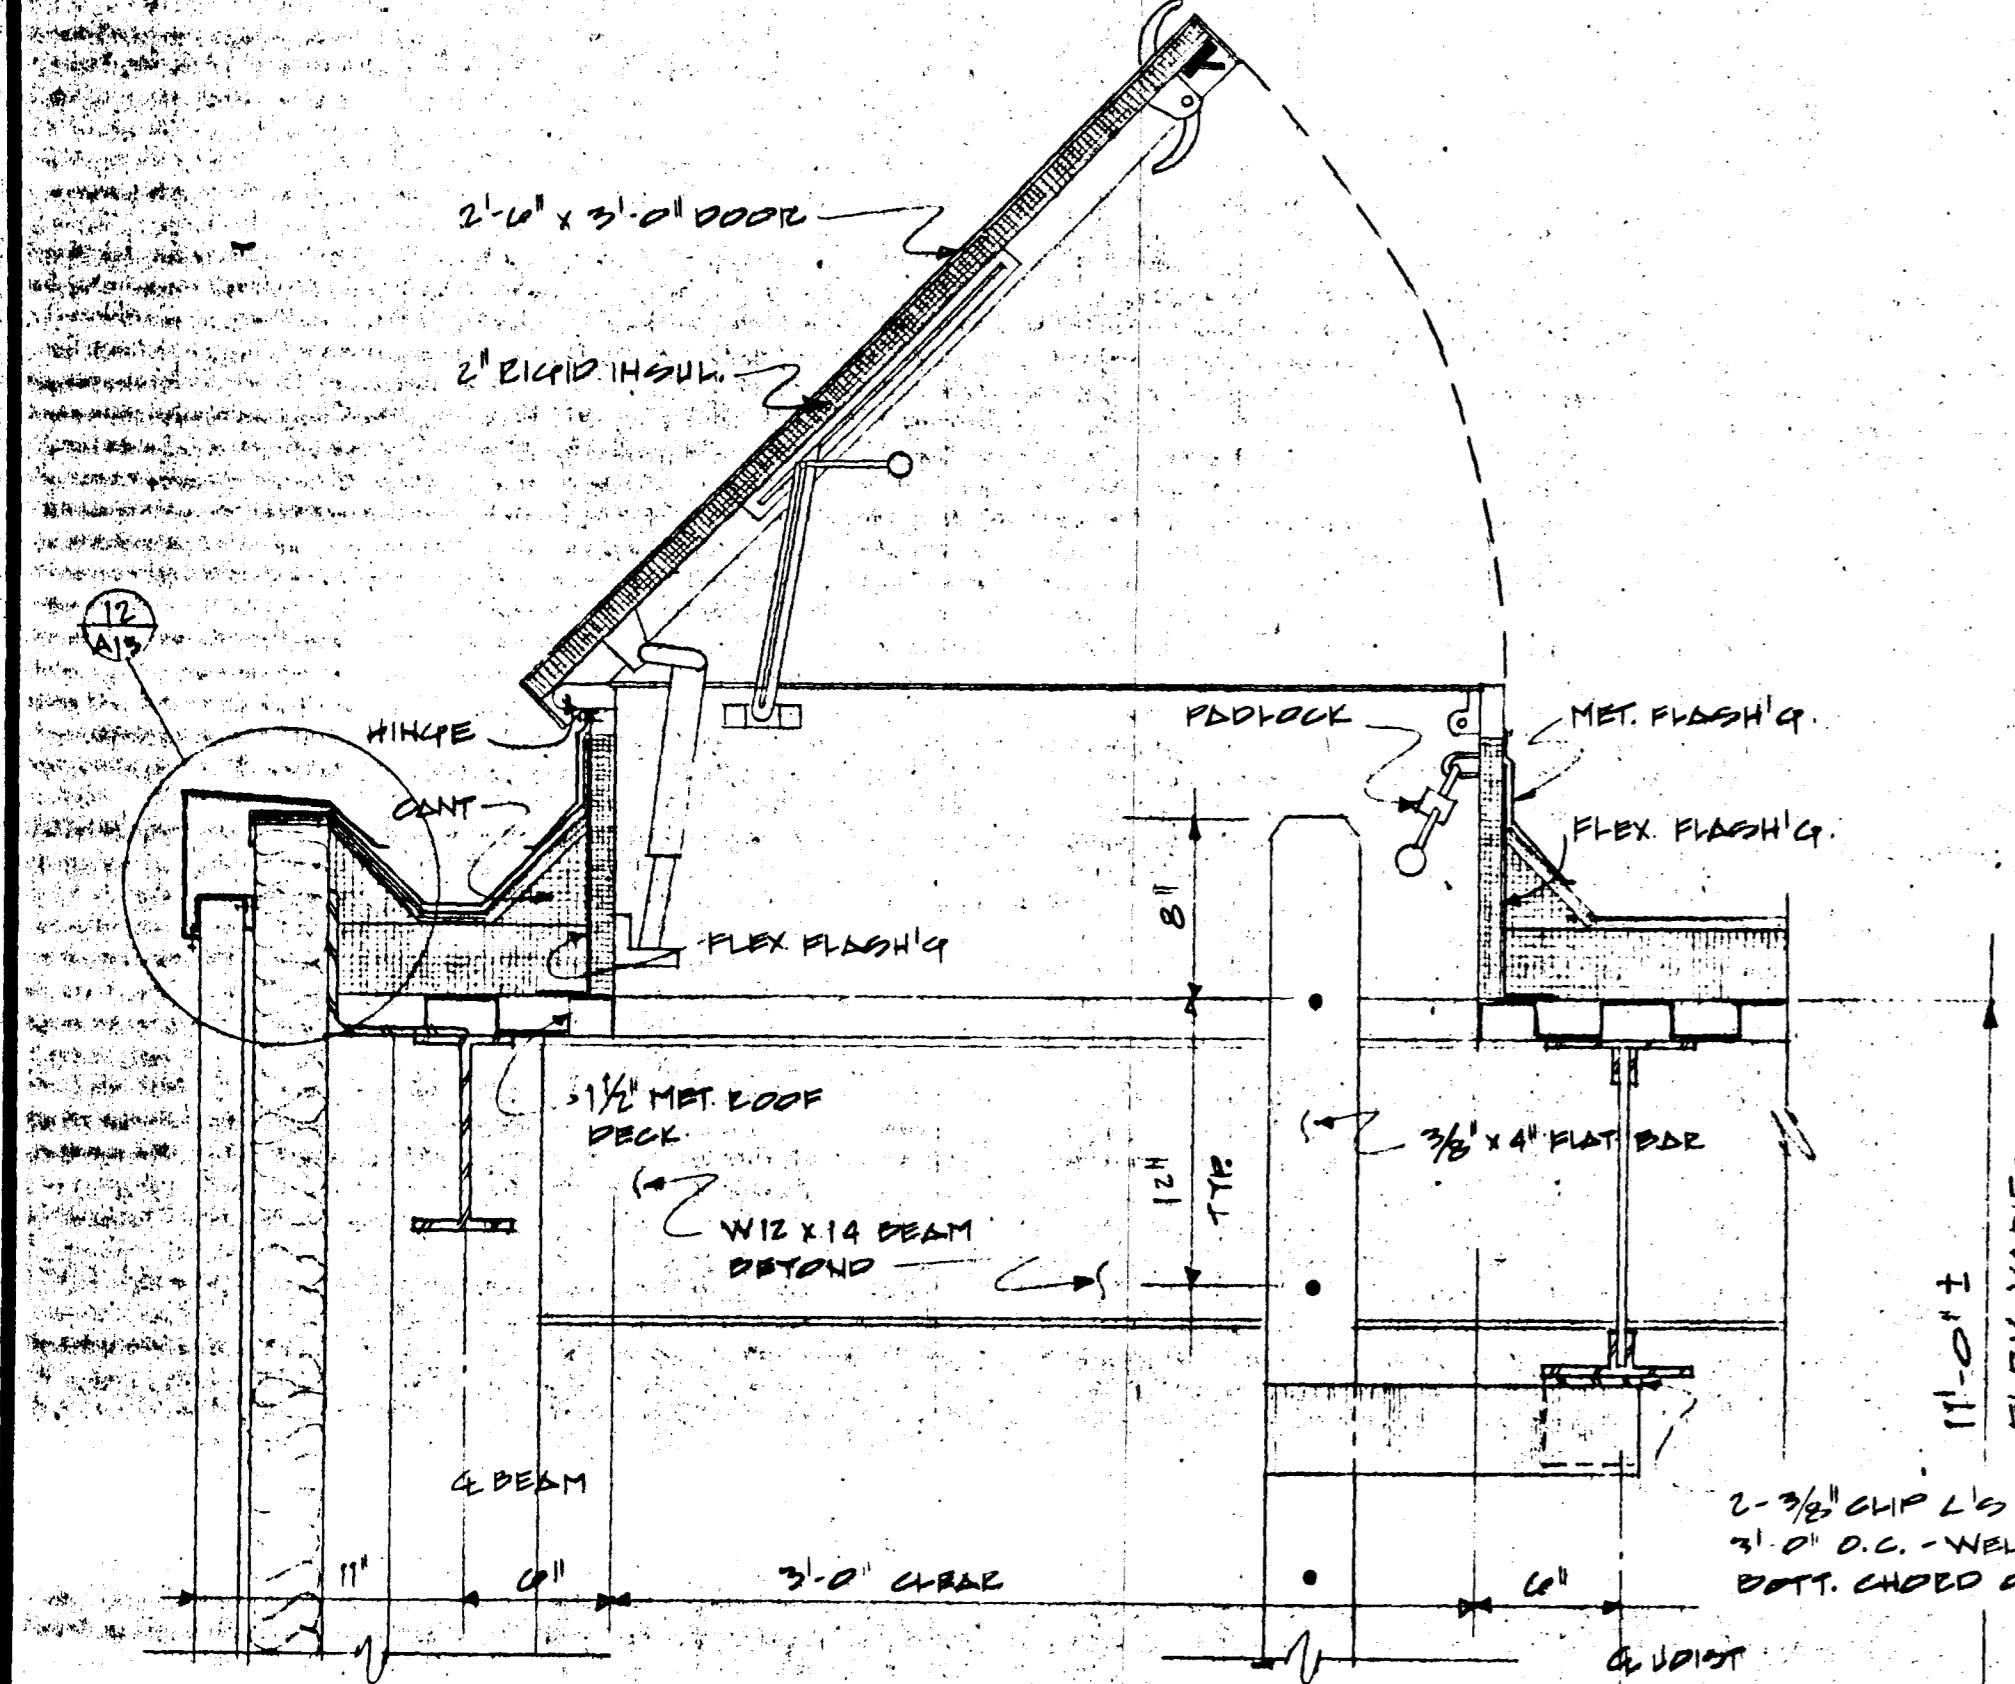

ARCHITECTS - ENGINEERS - SURVEYORS
COLLEGE ROAD, FAIRBANKS, ALASKA 99701. PHONE: 452-1124

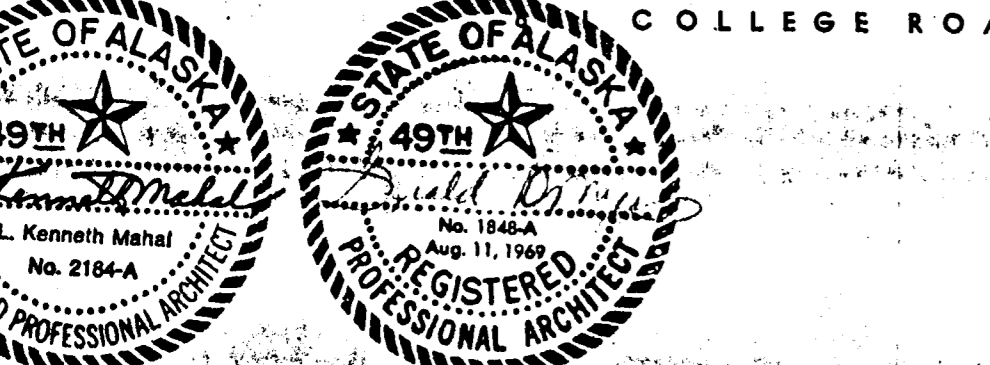

















STATE OF ALASKA
DEPT. OF PUBLIC WORKS
DIVISION OF BUILDINGS
JUNEAU ALASKA

FAIRBANKS PARKING STRUCTURE
DBA - 2 - 0130
FAIRBANKS, AK.

PETER KIEWIT SONS' CO.
CONTRACTOR
DATE: _____
AS-BLT SHEET 15

GRAY ROGERS MYERS & TORRIGIANI

A DIVISION OF ELLERBE

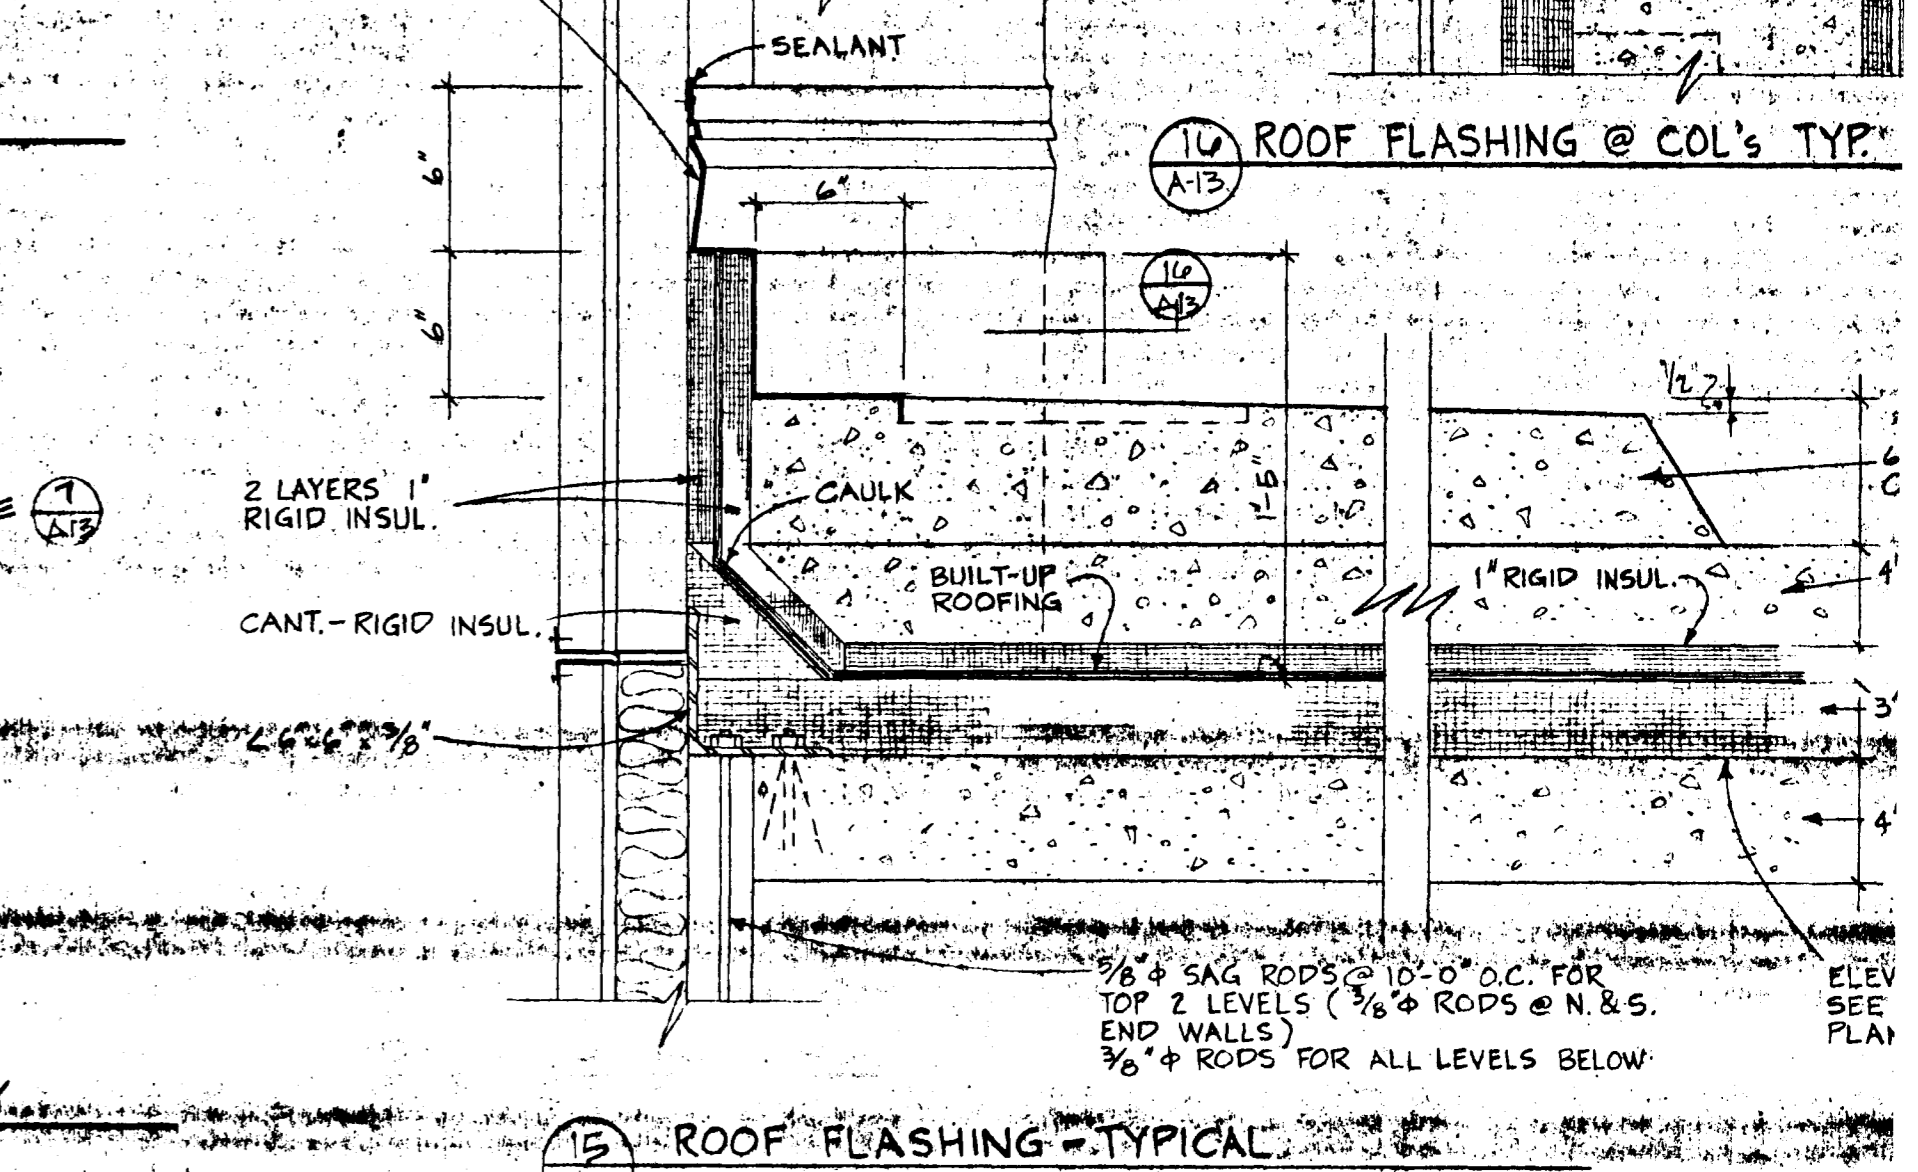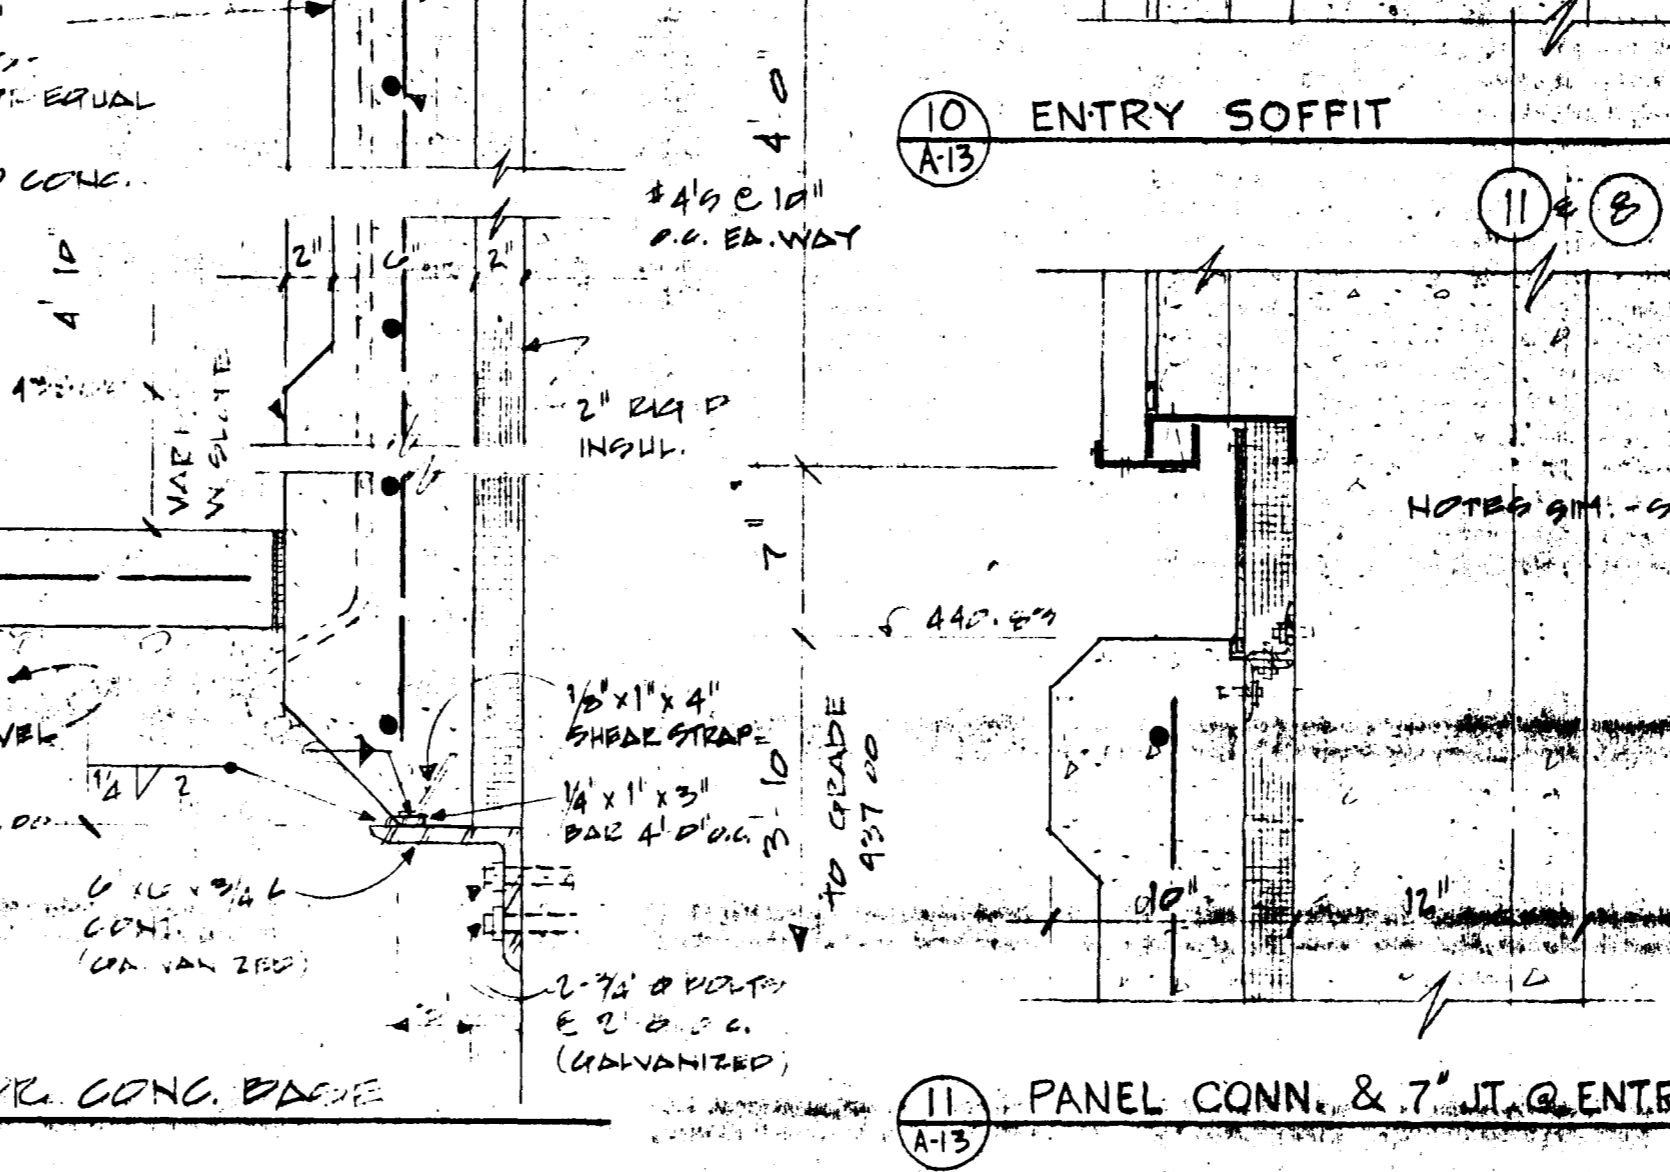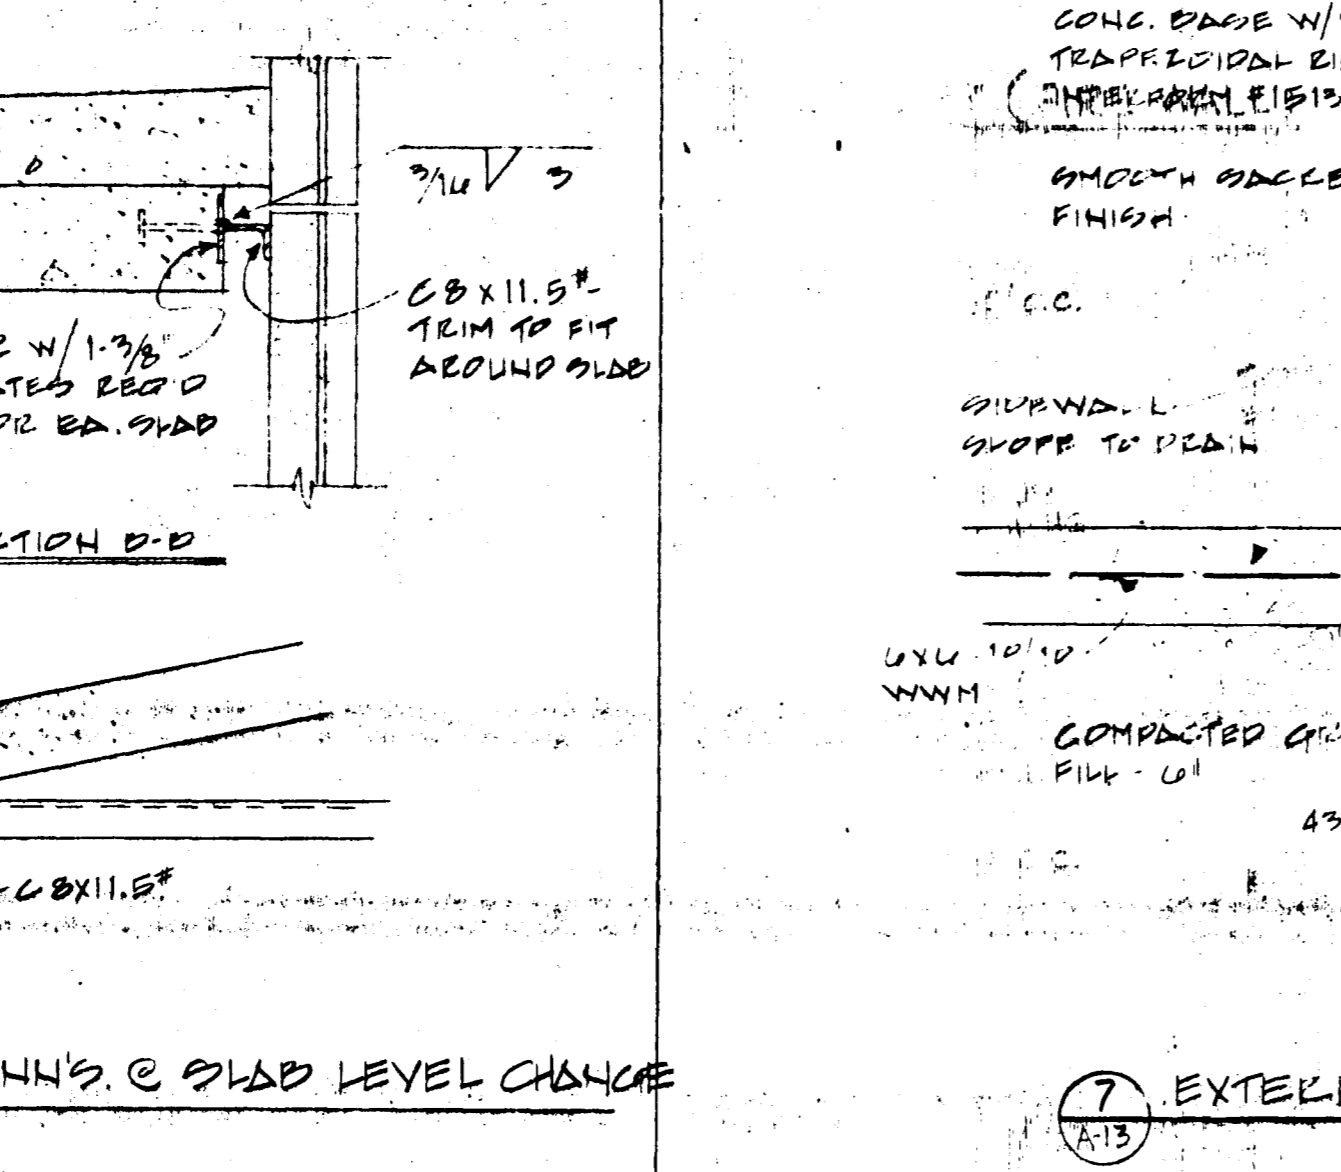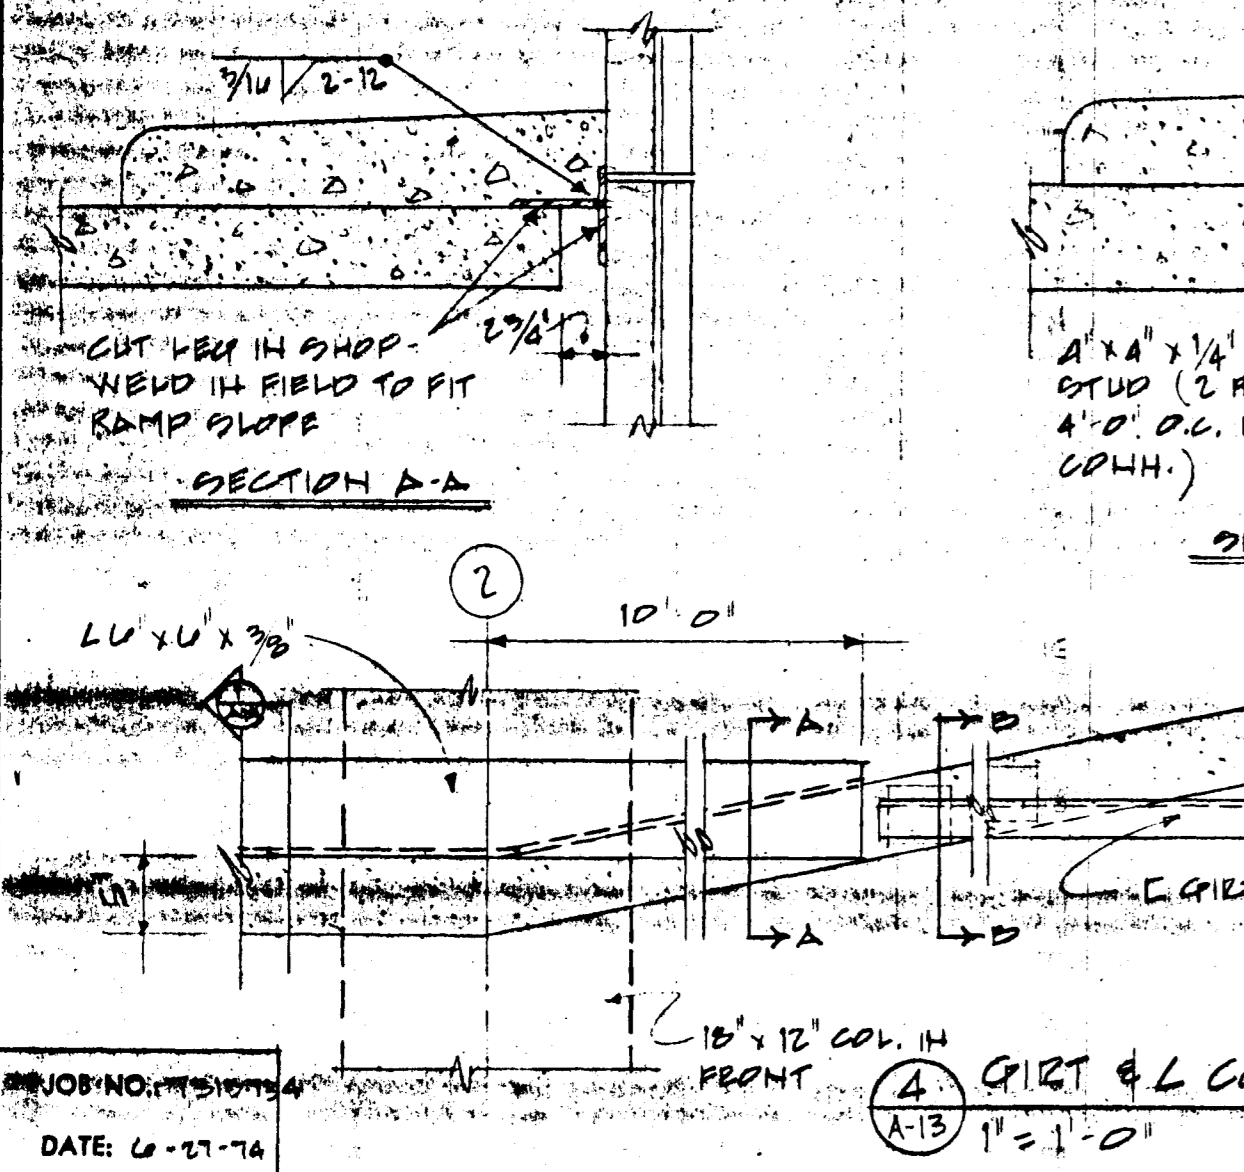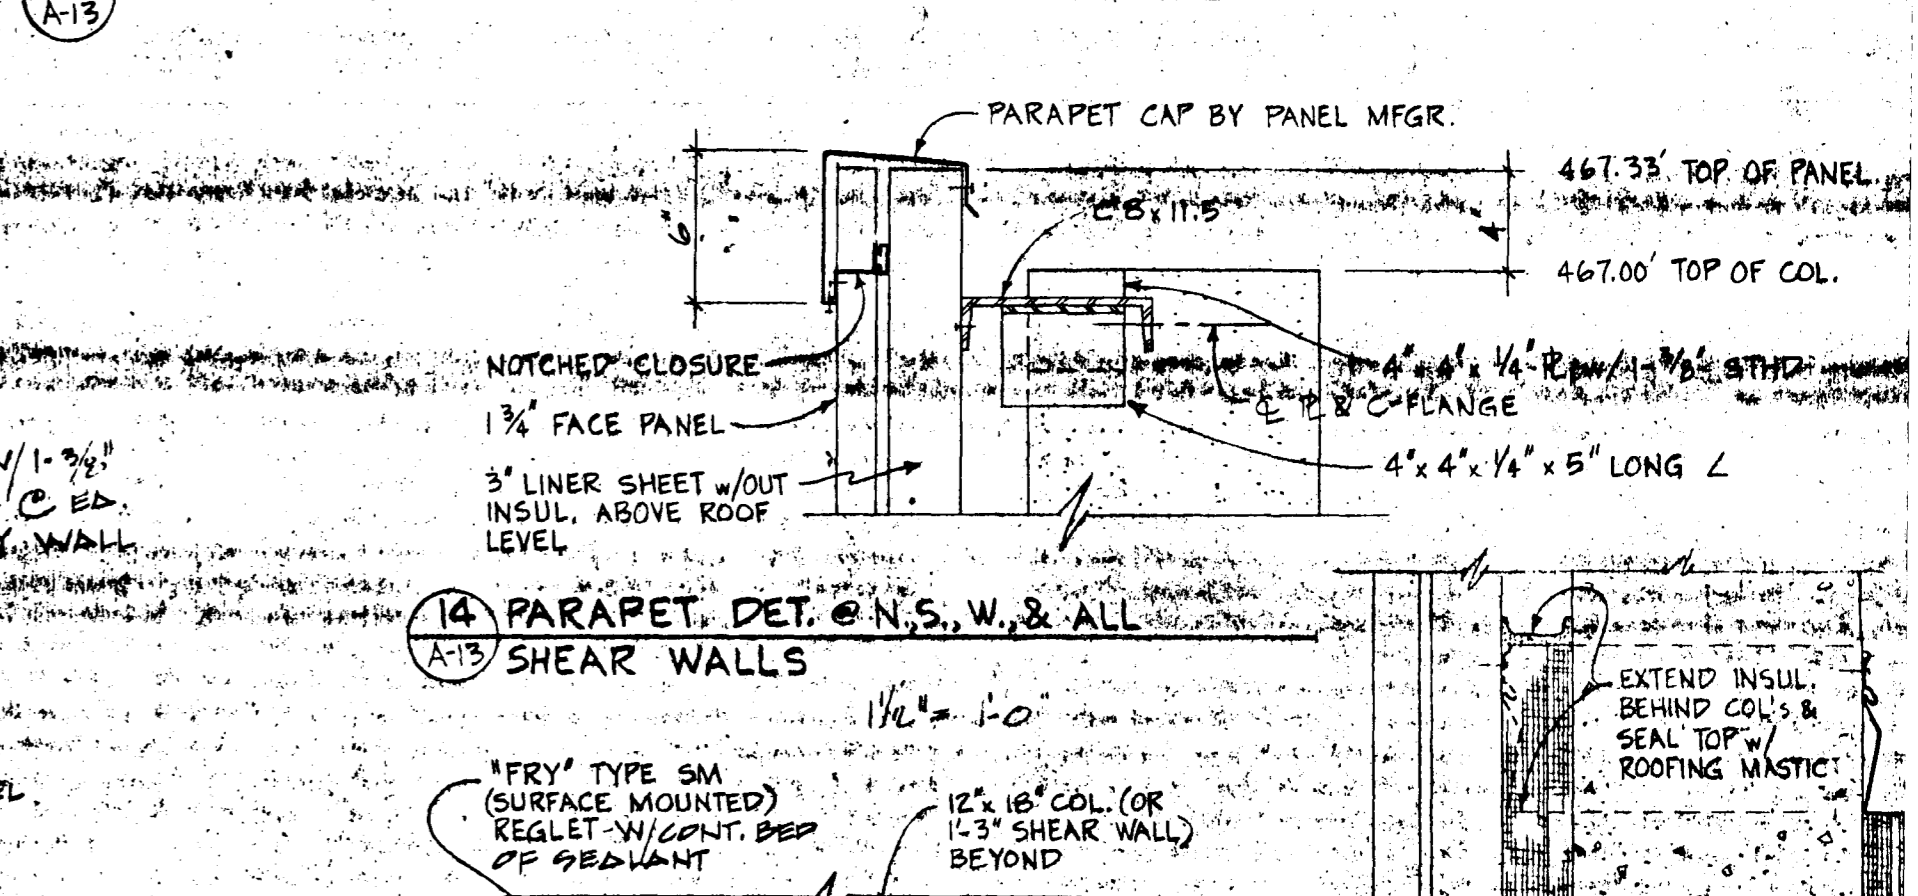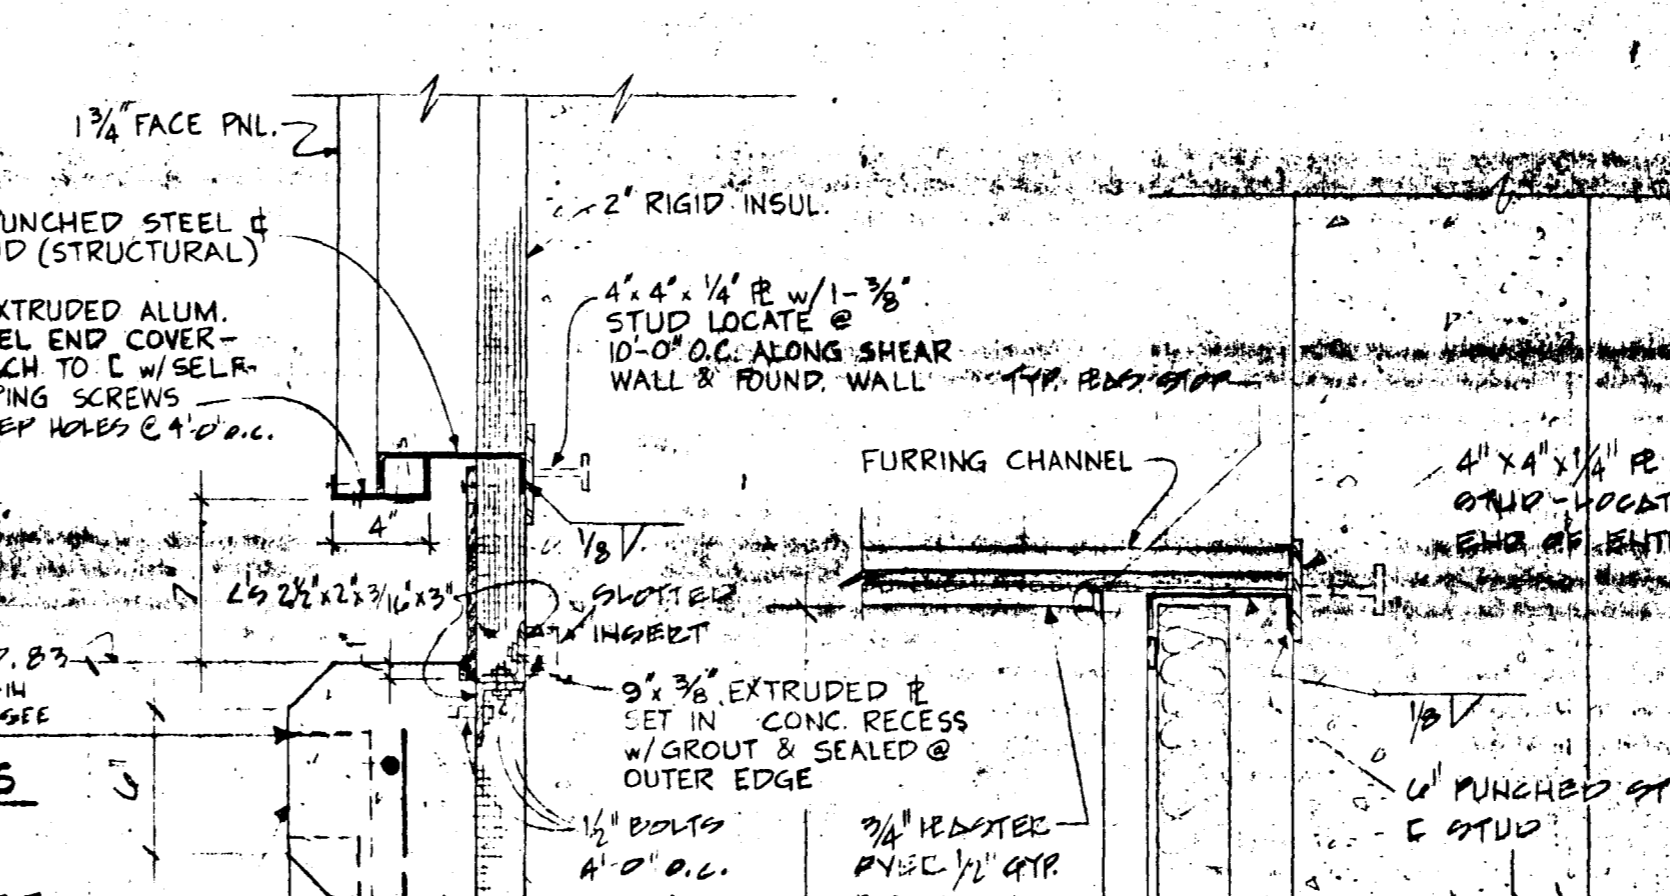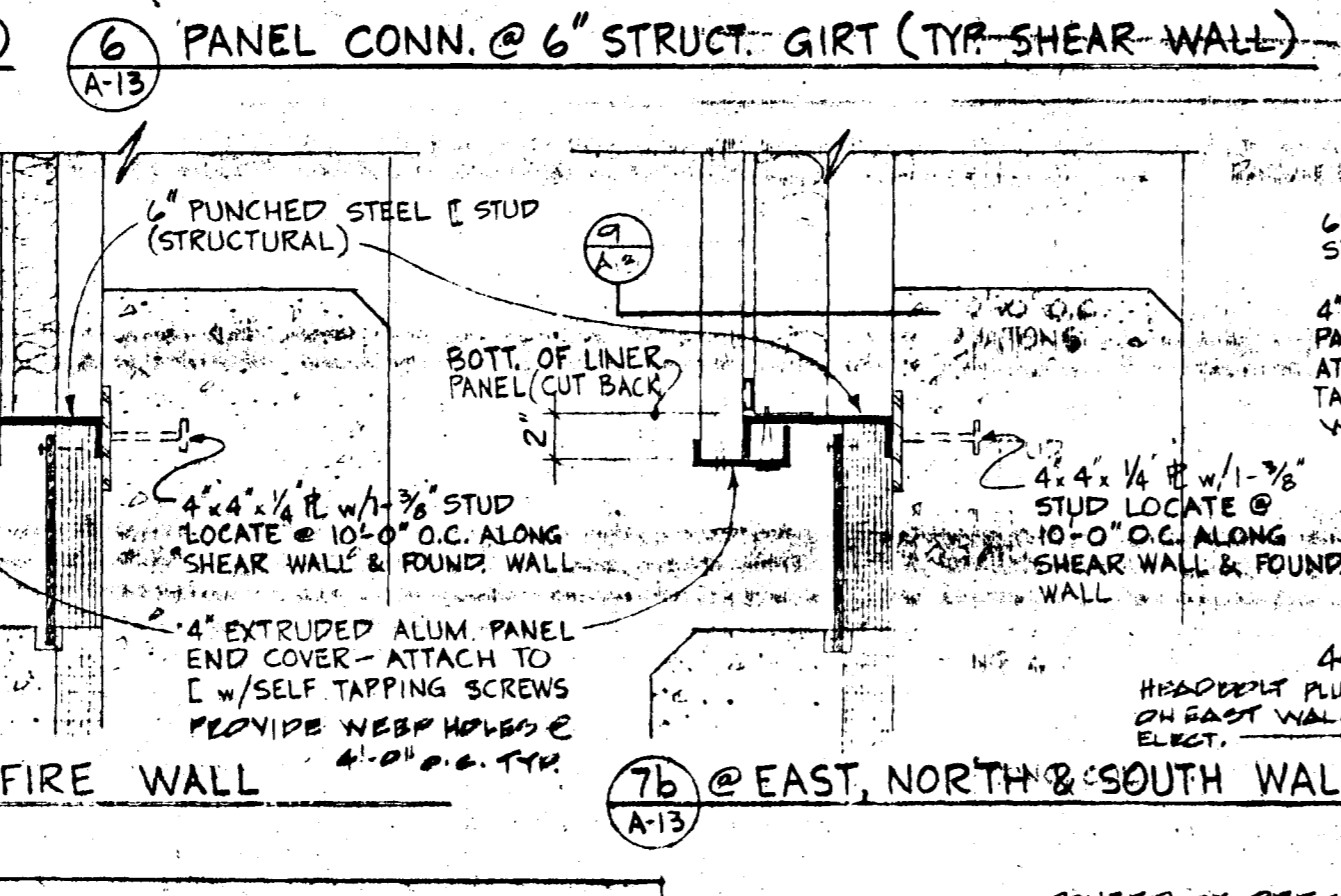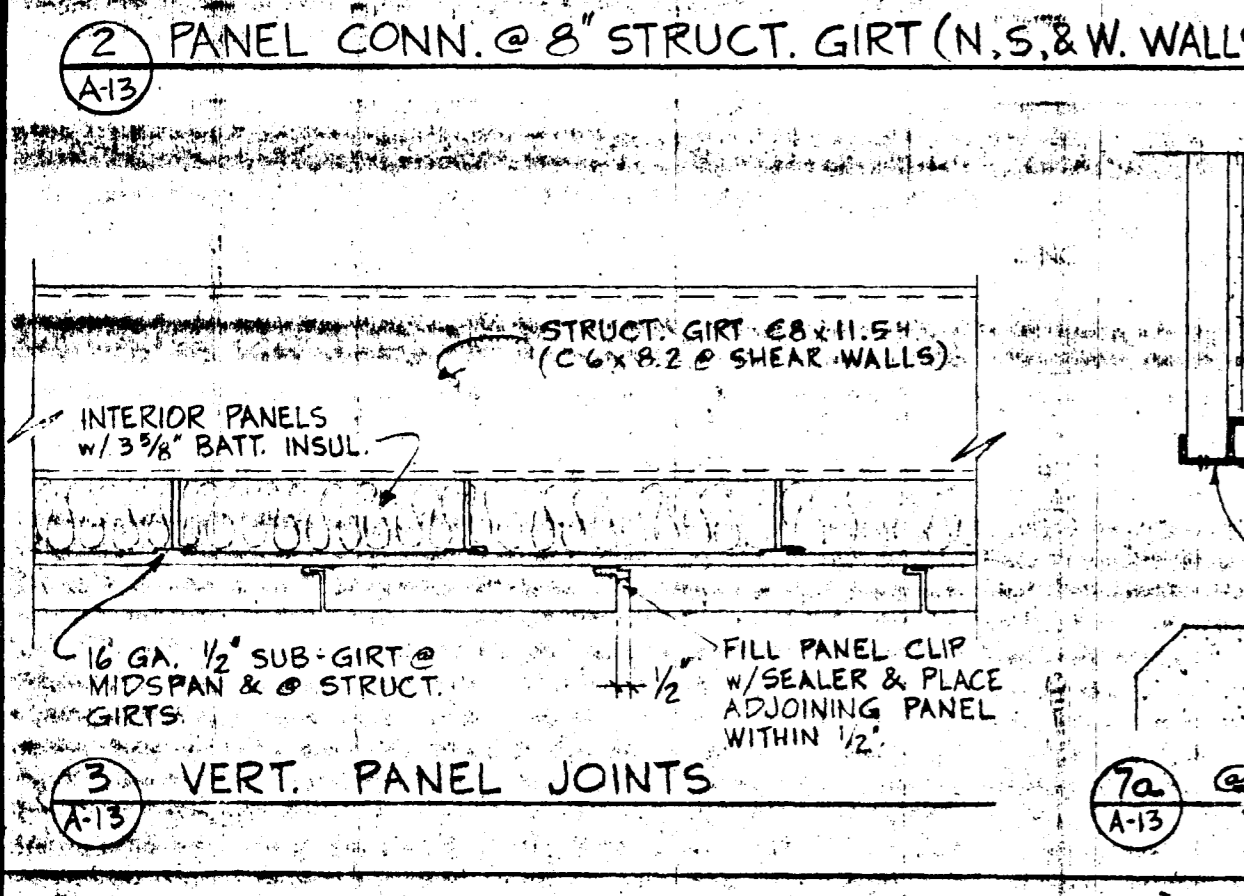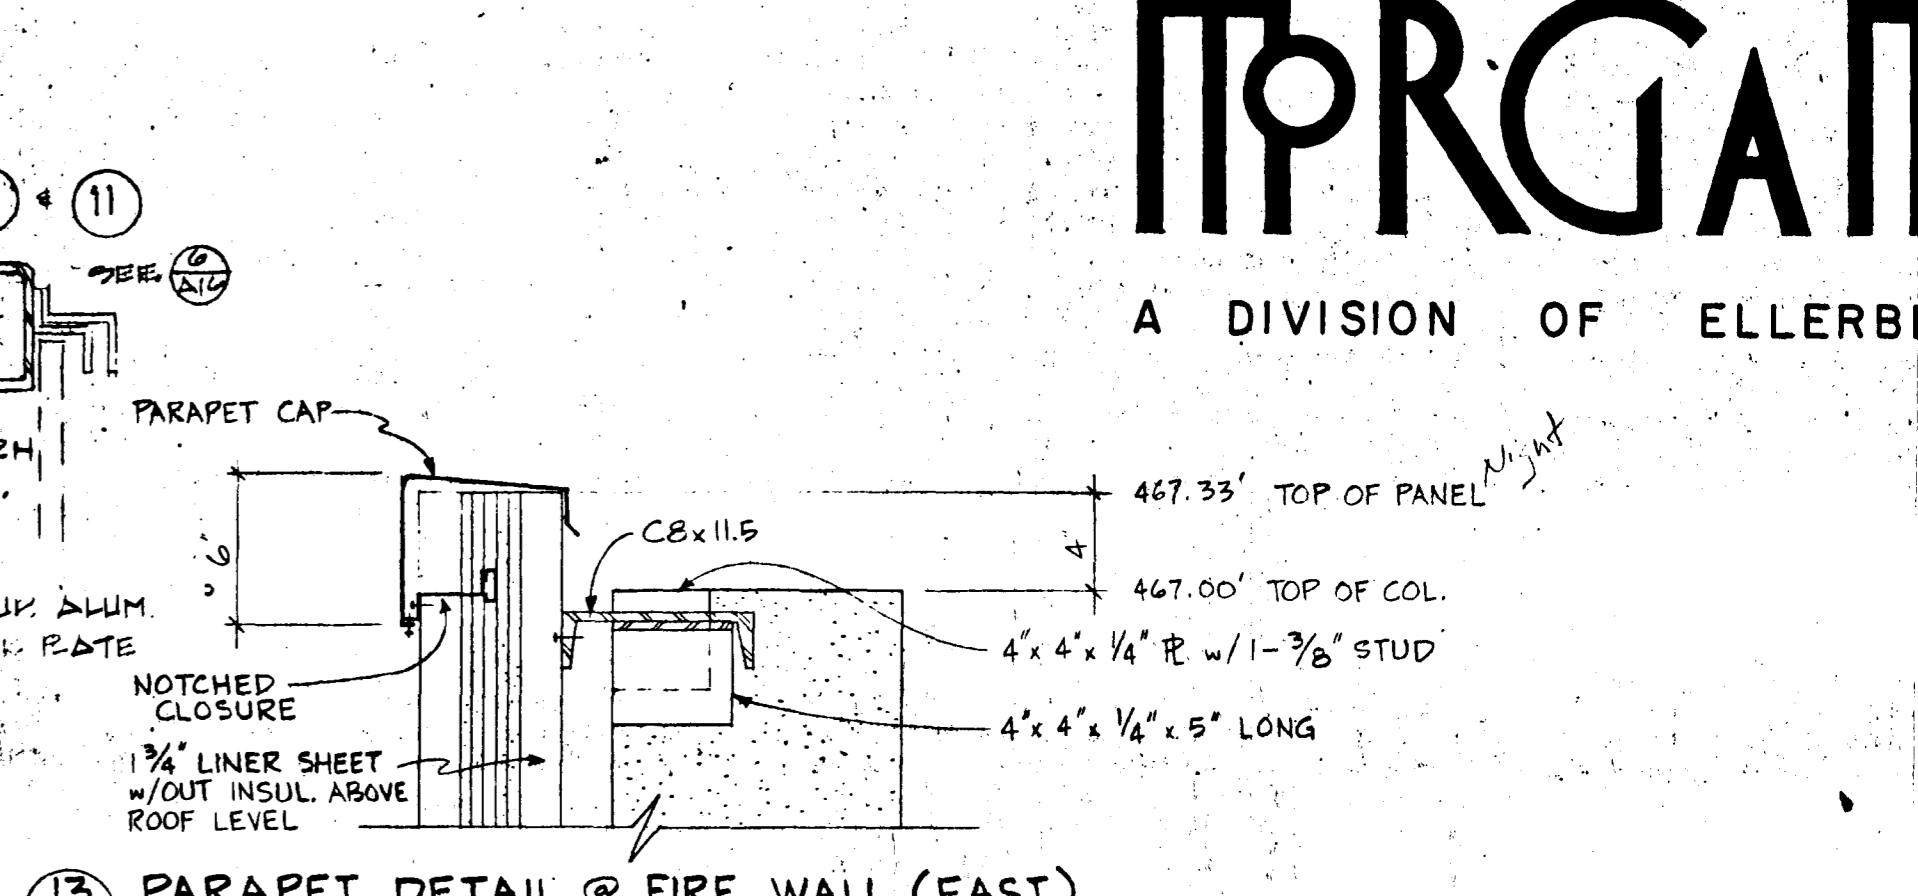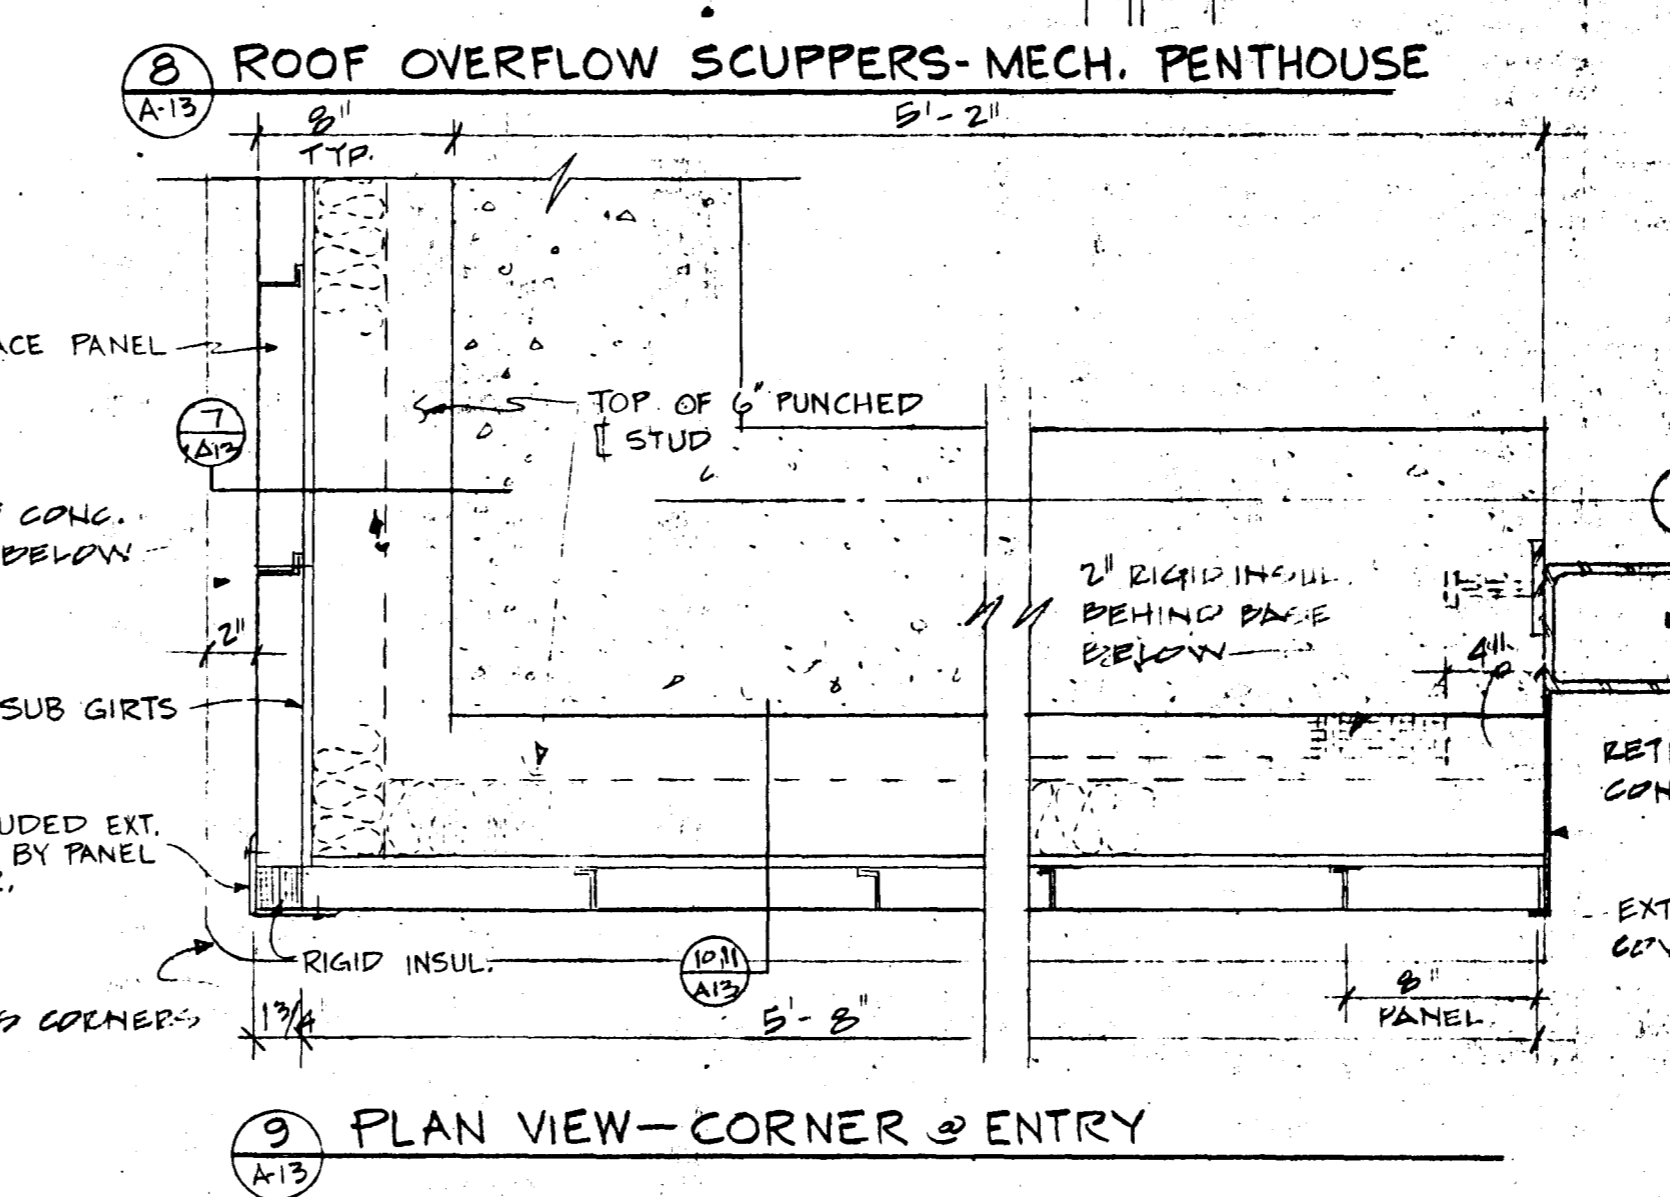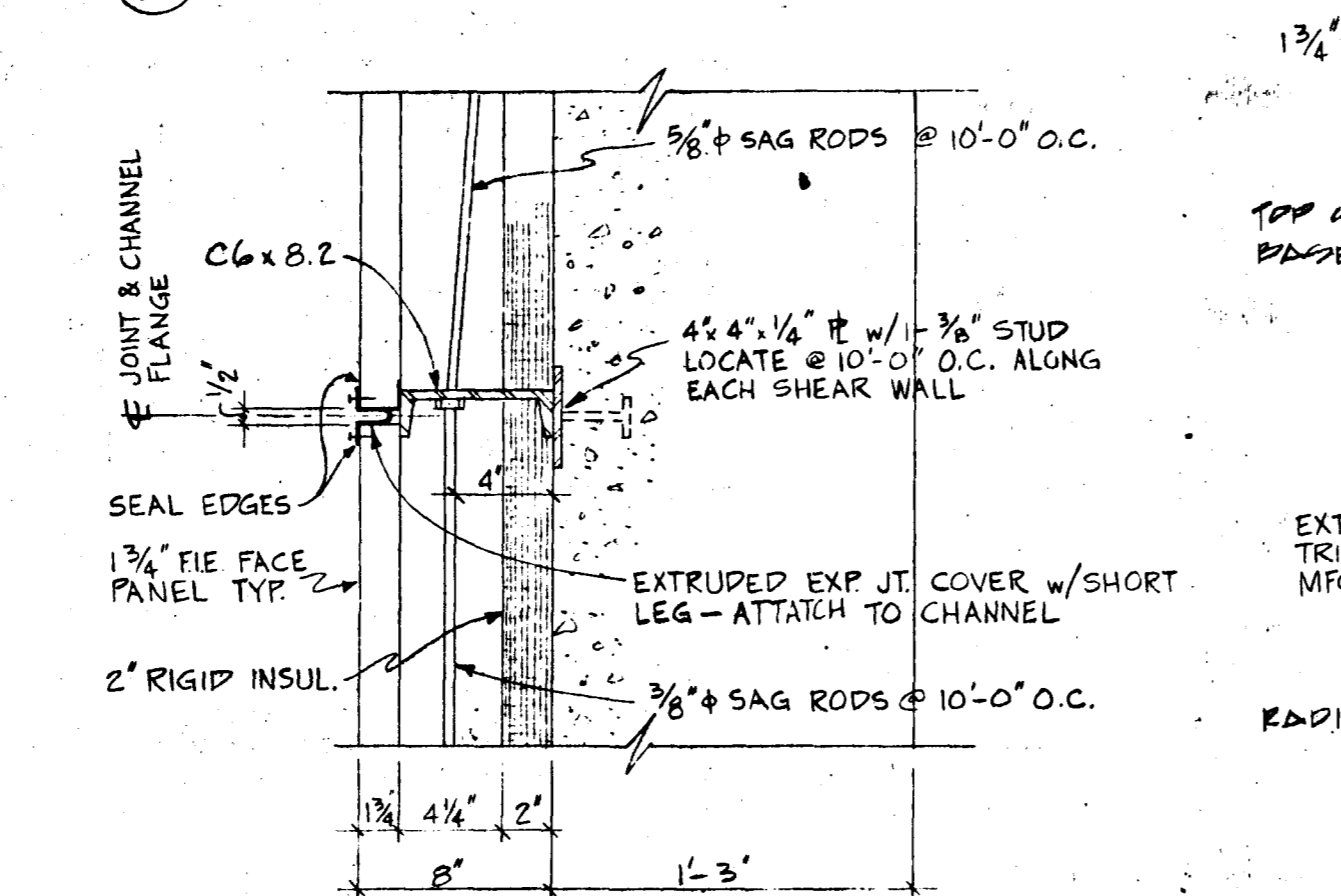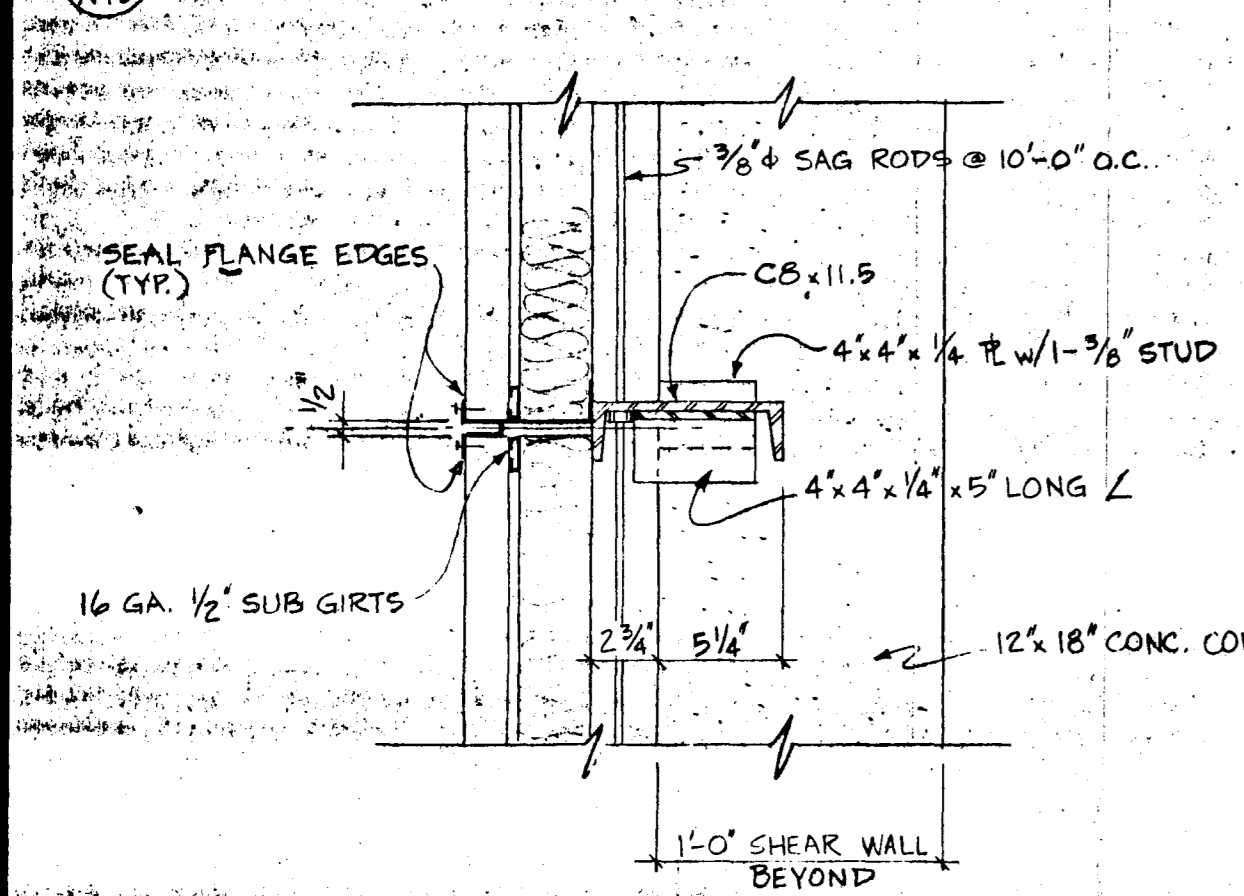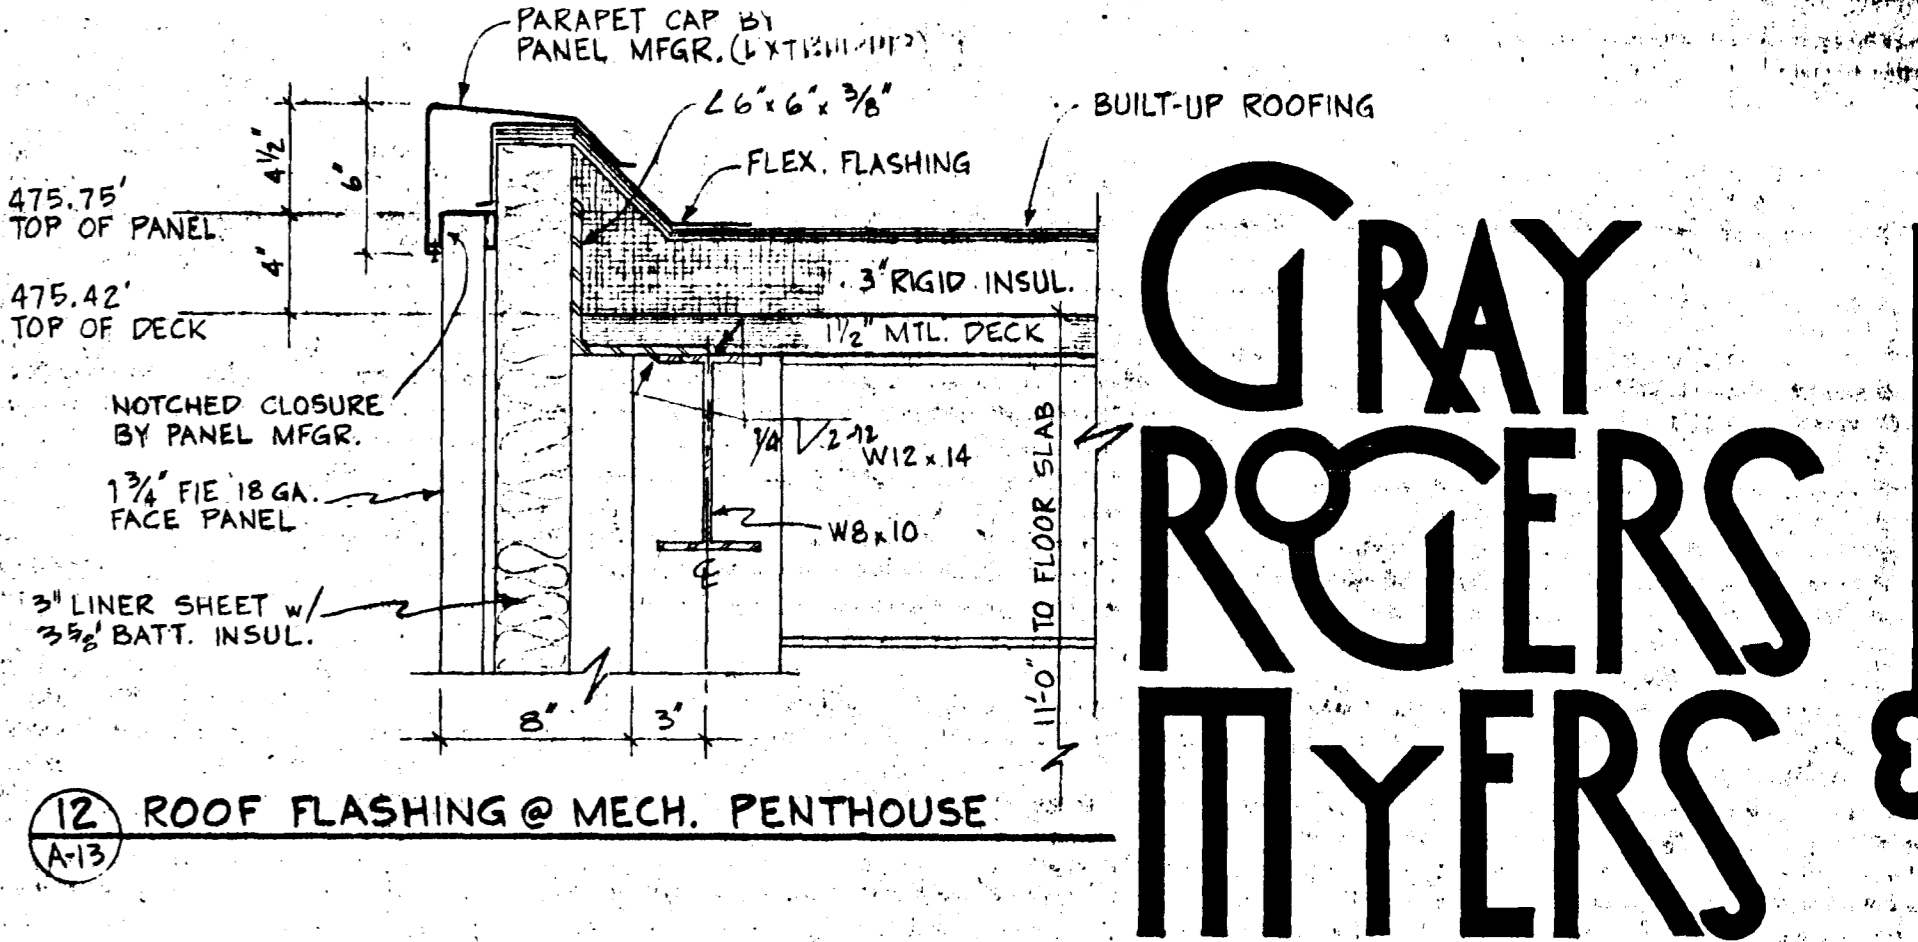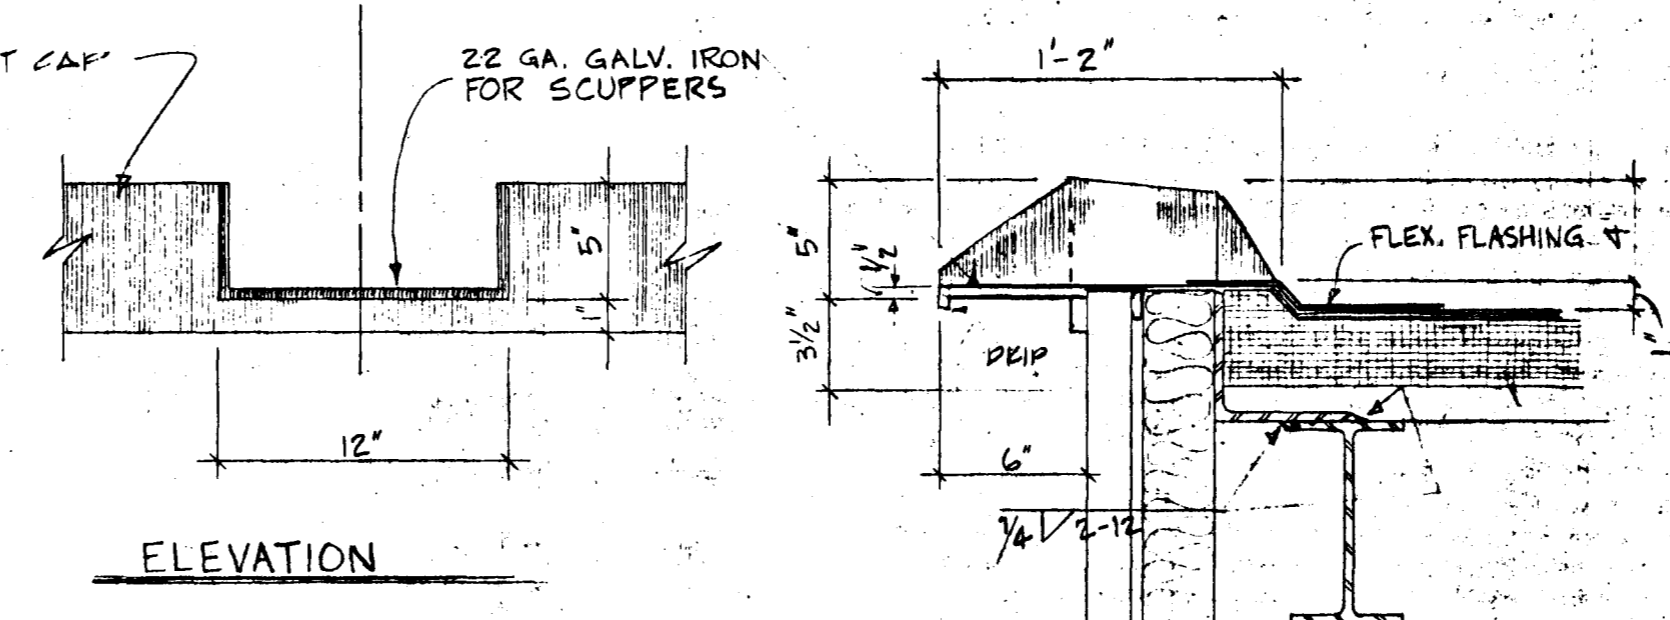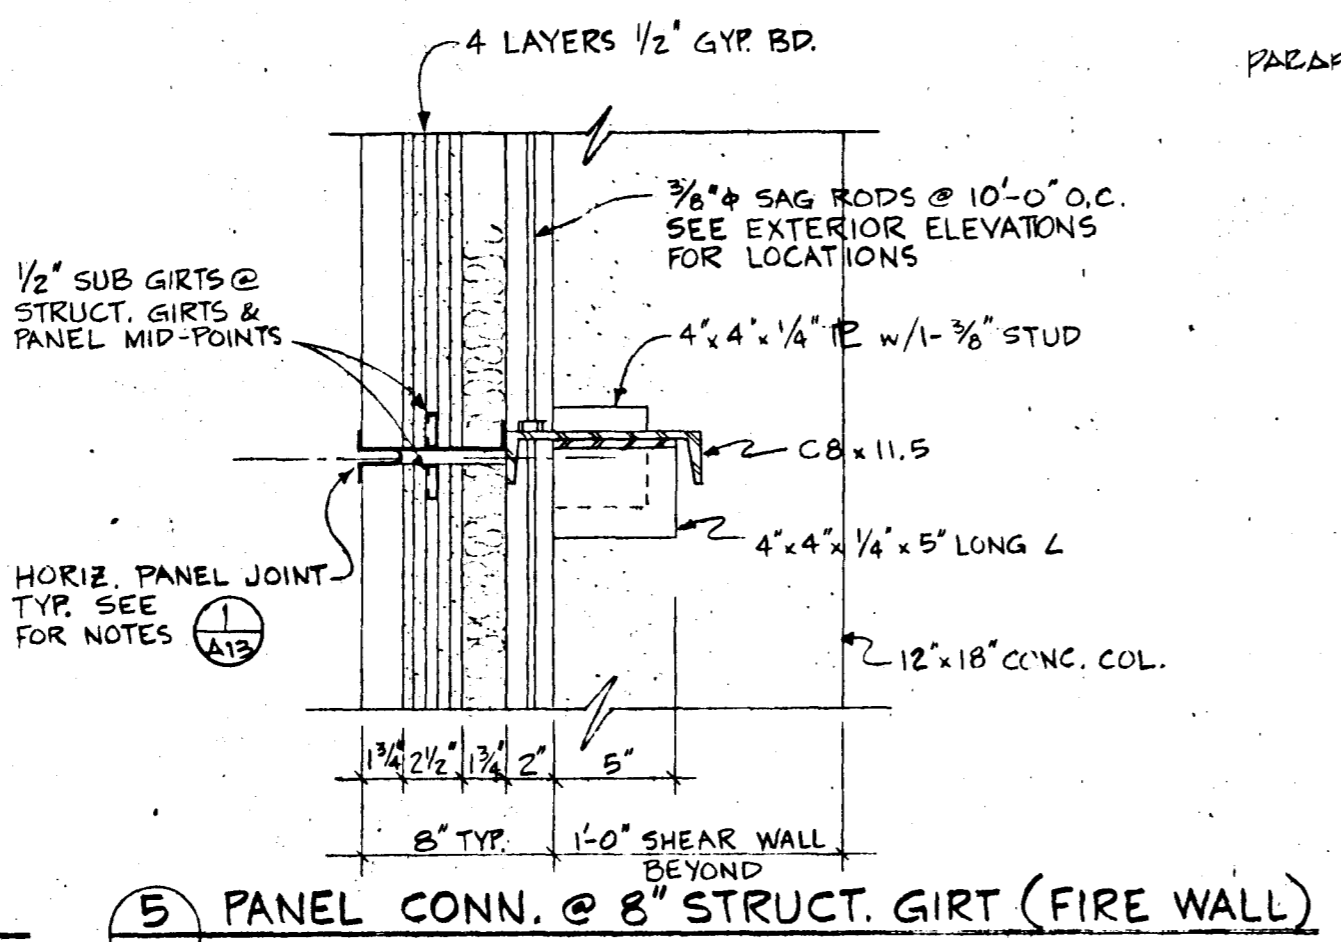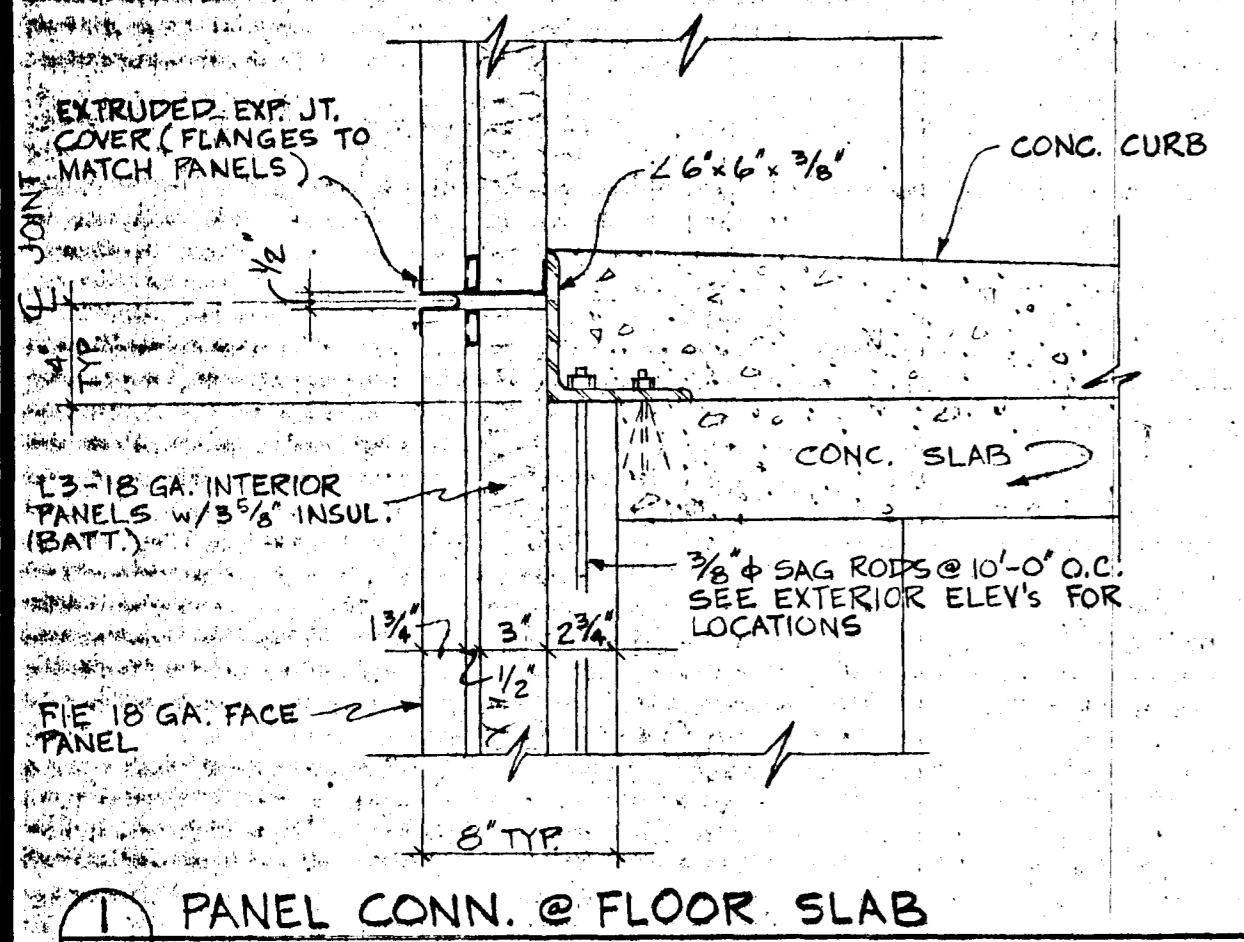



ARCHITECTS • ENGINEERS • SURVEYORS
 COLLEGE ROAD, FAIRBANKS, ALASKA, 99701, PHONE: 452-1241

STATE OF ALASKA
 DEPT. OF PUBLIC WORKS
 DIVISION OF BUILDINGS
 JUNEAU ALASKA


FAIRBANKS PARKING STRUCTURE
 FAIRBANKS, AK.
 DBA - 2 - 0130

PETER KIEWIT SONS CO.
 APPROVED: _____
 CONTRACTOR: _____
 DATE: _____
 AS-BLT SHEET 16 C

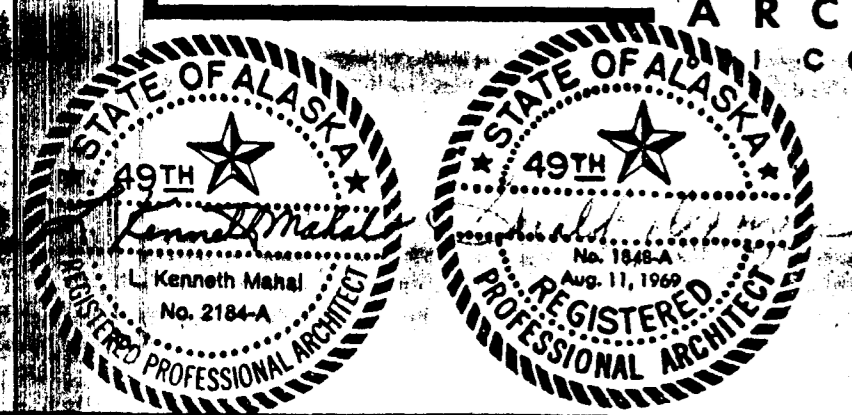

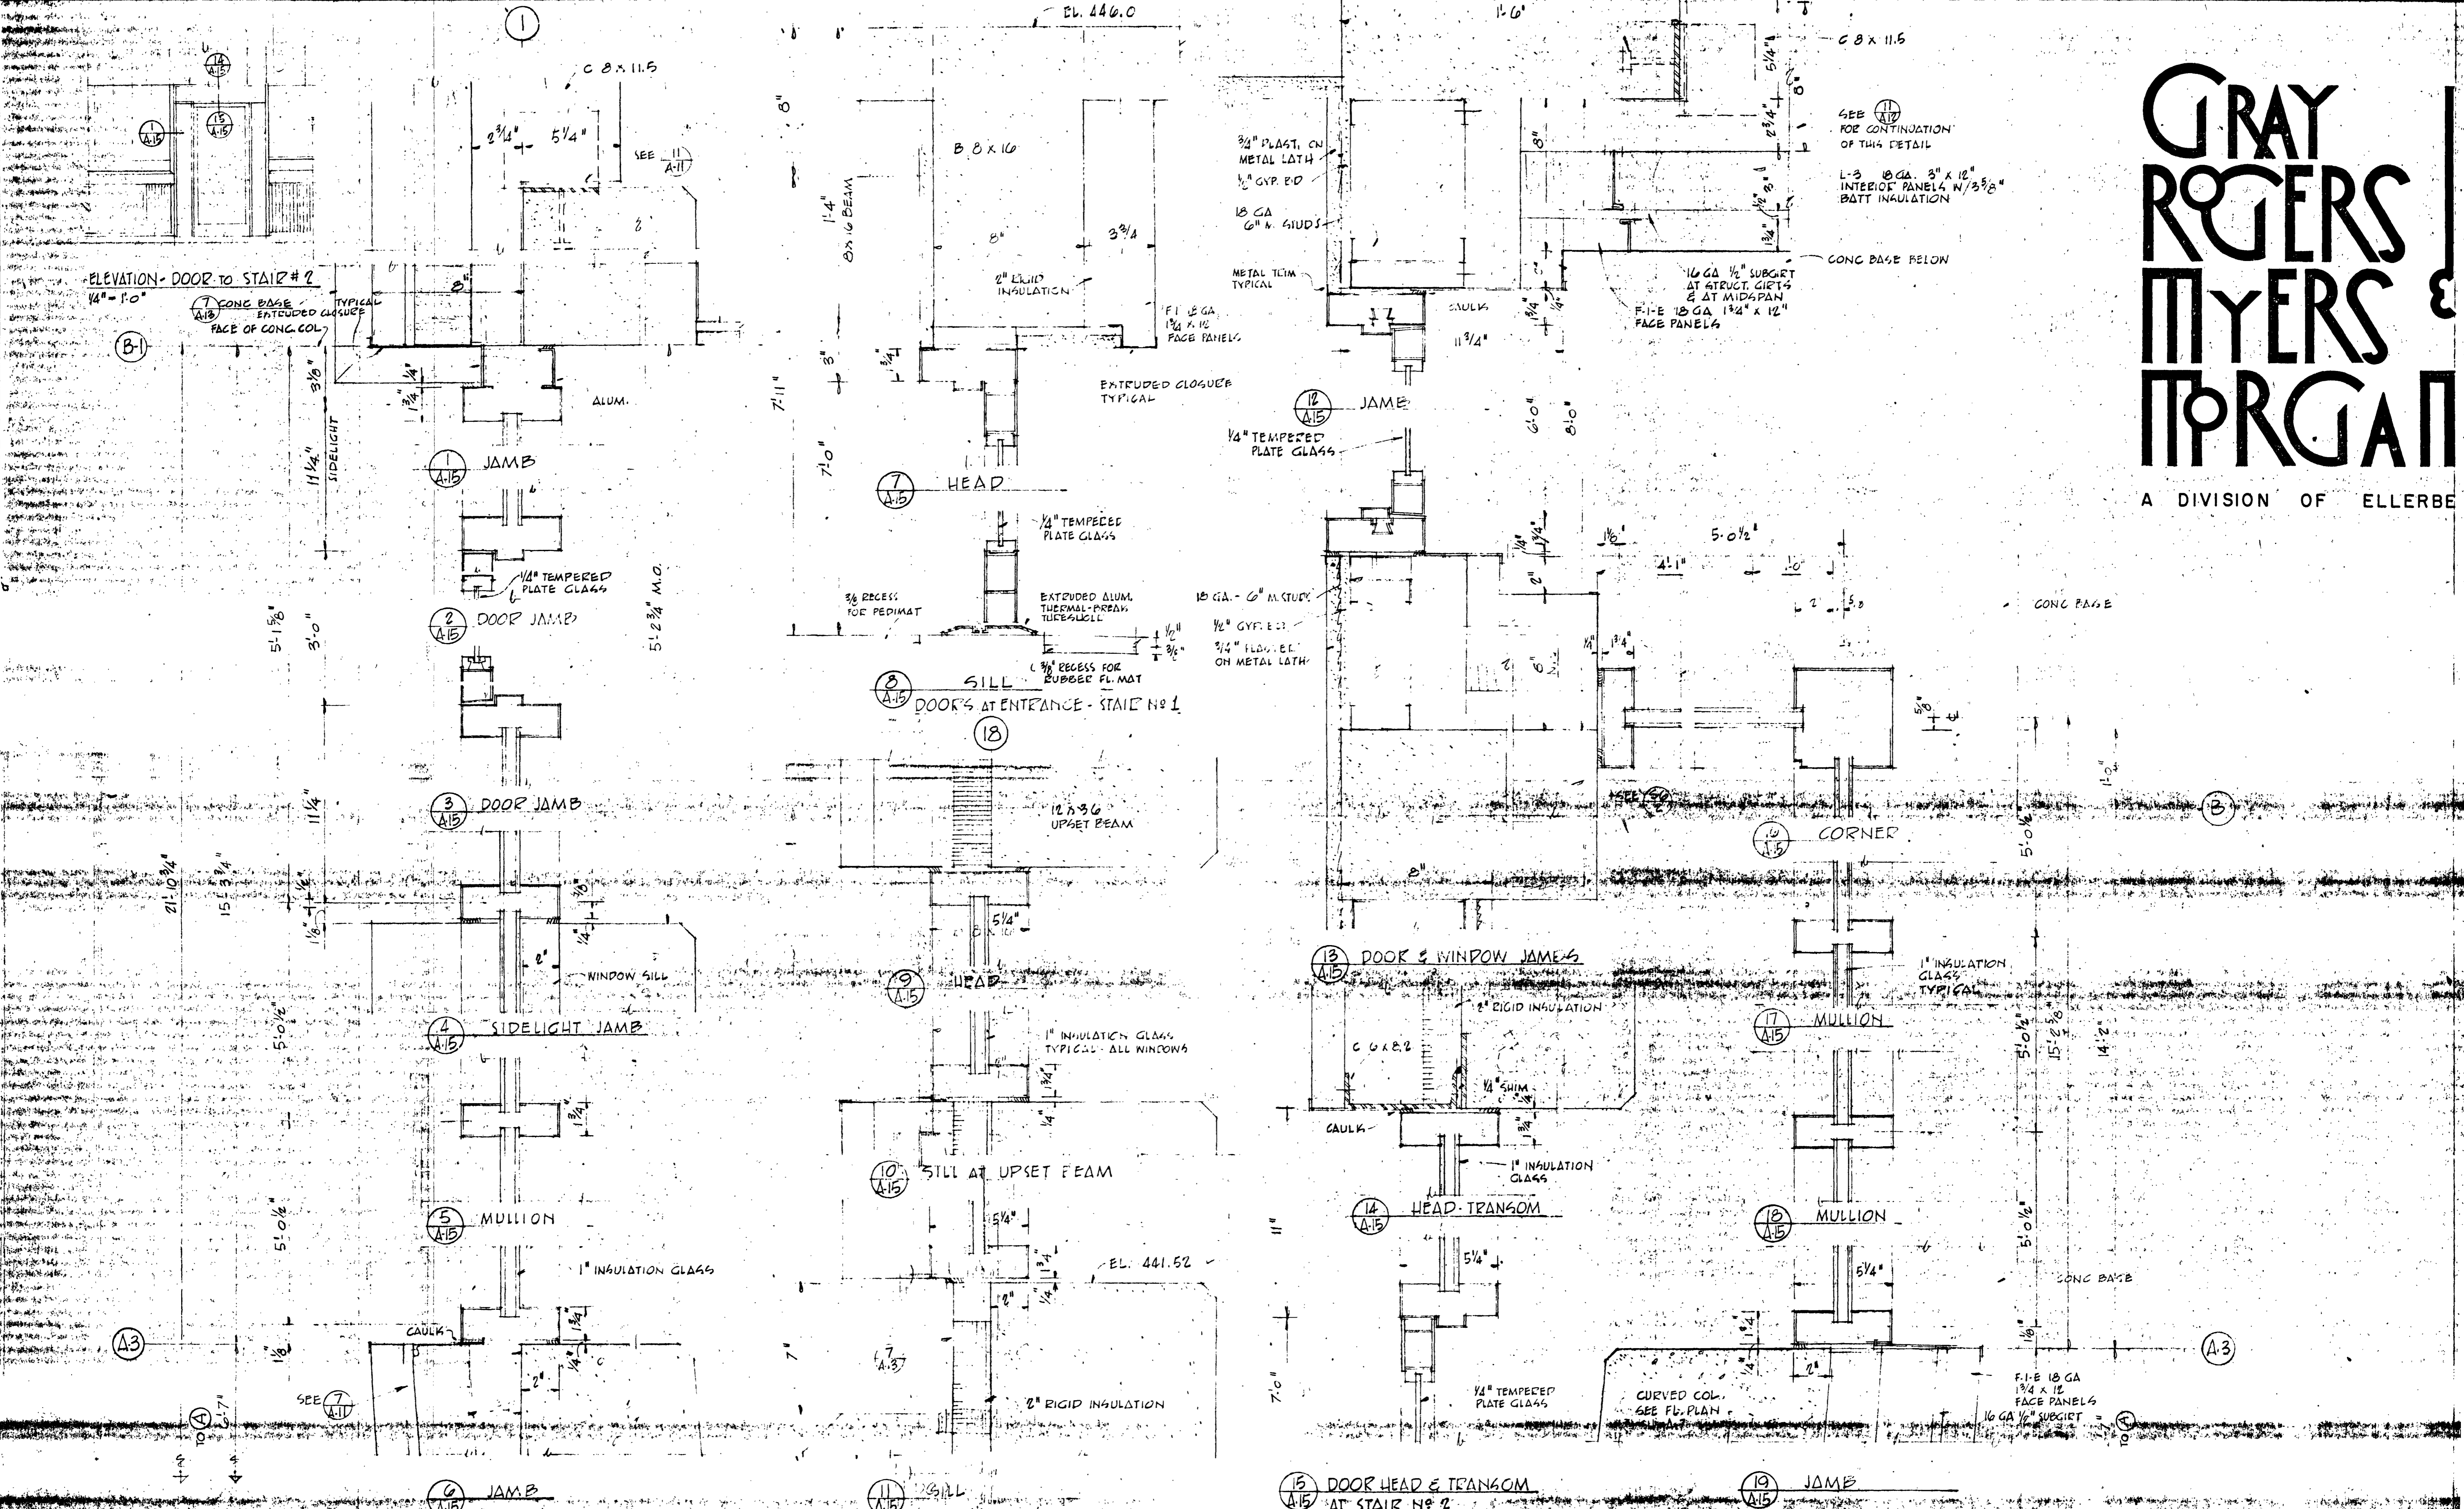

JOB NO.: 7313-734
 DATE: _____
 ARCHITECTS - ENGINEERS - SURVEYORS
 COLLEGE ROAD, FAIRBANKS, ALASKA 99701, PHONE: 452-1241
 STATE OF ALASKA DEPT. OF PUBLIC WORKS DIVISION OF BUILDINGS JUNEAU ALASKA
 FAIRBANKS PARKING STRUCTURE FAIRBANKS, AK.
 PETER KIEWIT SONS' CO.
 FAIRBANKS, ALASKA
 RECOMMENDED BY: _____
 CONTRACTOR: _____
 DATE: _____
 AS-BLT
 SHEET 17 OF _____
 DOOR & WINDOW DETAILS
 WINDOWS & DOOR - STAIR No. 2
 3" - 1'-0"
 DOOR HEAD & TRANSOM AT STAIR No. 2
 3" - 1'-0"
 WINDOWS & DOORS - STAIR No. 1
 3" - 1'-0"

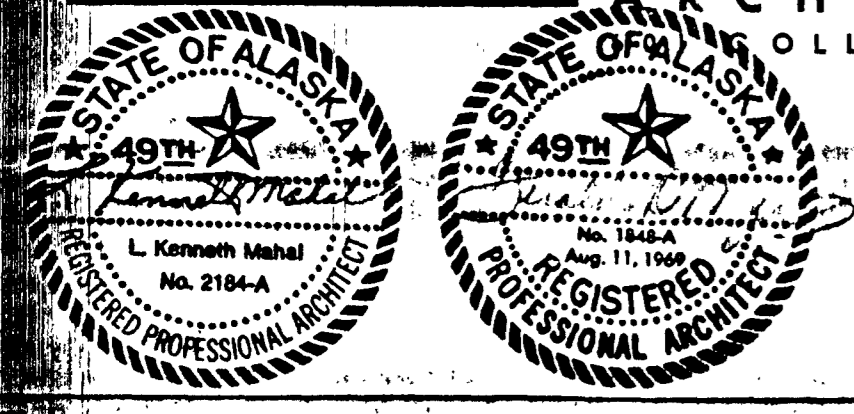


STATE OF ALASKA
 DEPT. OF PUBLIC WORKS
 DIVISION OF BUILDINGS
 JUNEAU ALASKA


FAIRBANKS PARKING STRUCTURE
 FAIRBANKS, AK.

PETER KIEWIT SONS' CO.
 FAIRBANKS, ALASKA
 RECOMMENDED BY: _____
 CONTRACTOR: _____
 DATE: _____
 AS-BLT
A-15
 SHEET 17 OF _____

GRAY ROGERS MYERS & PORGAN

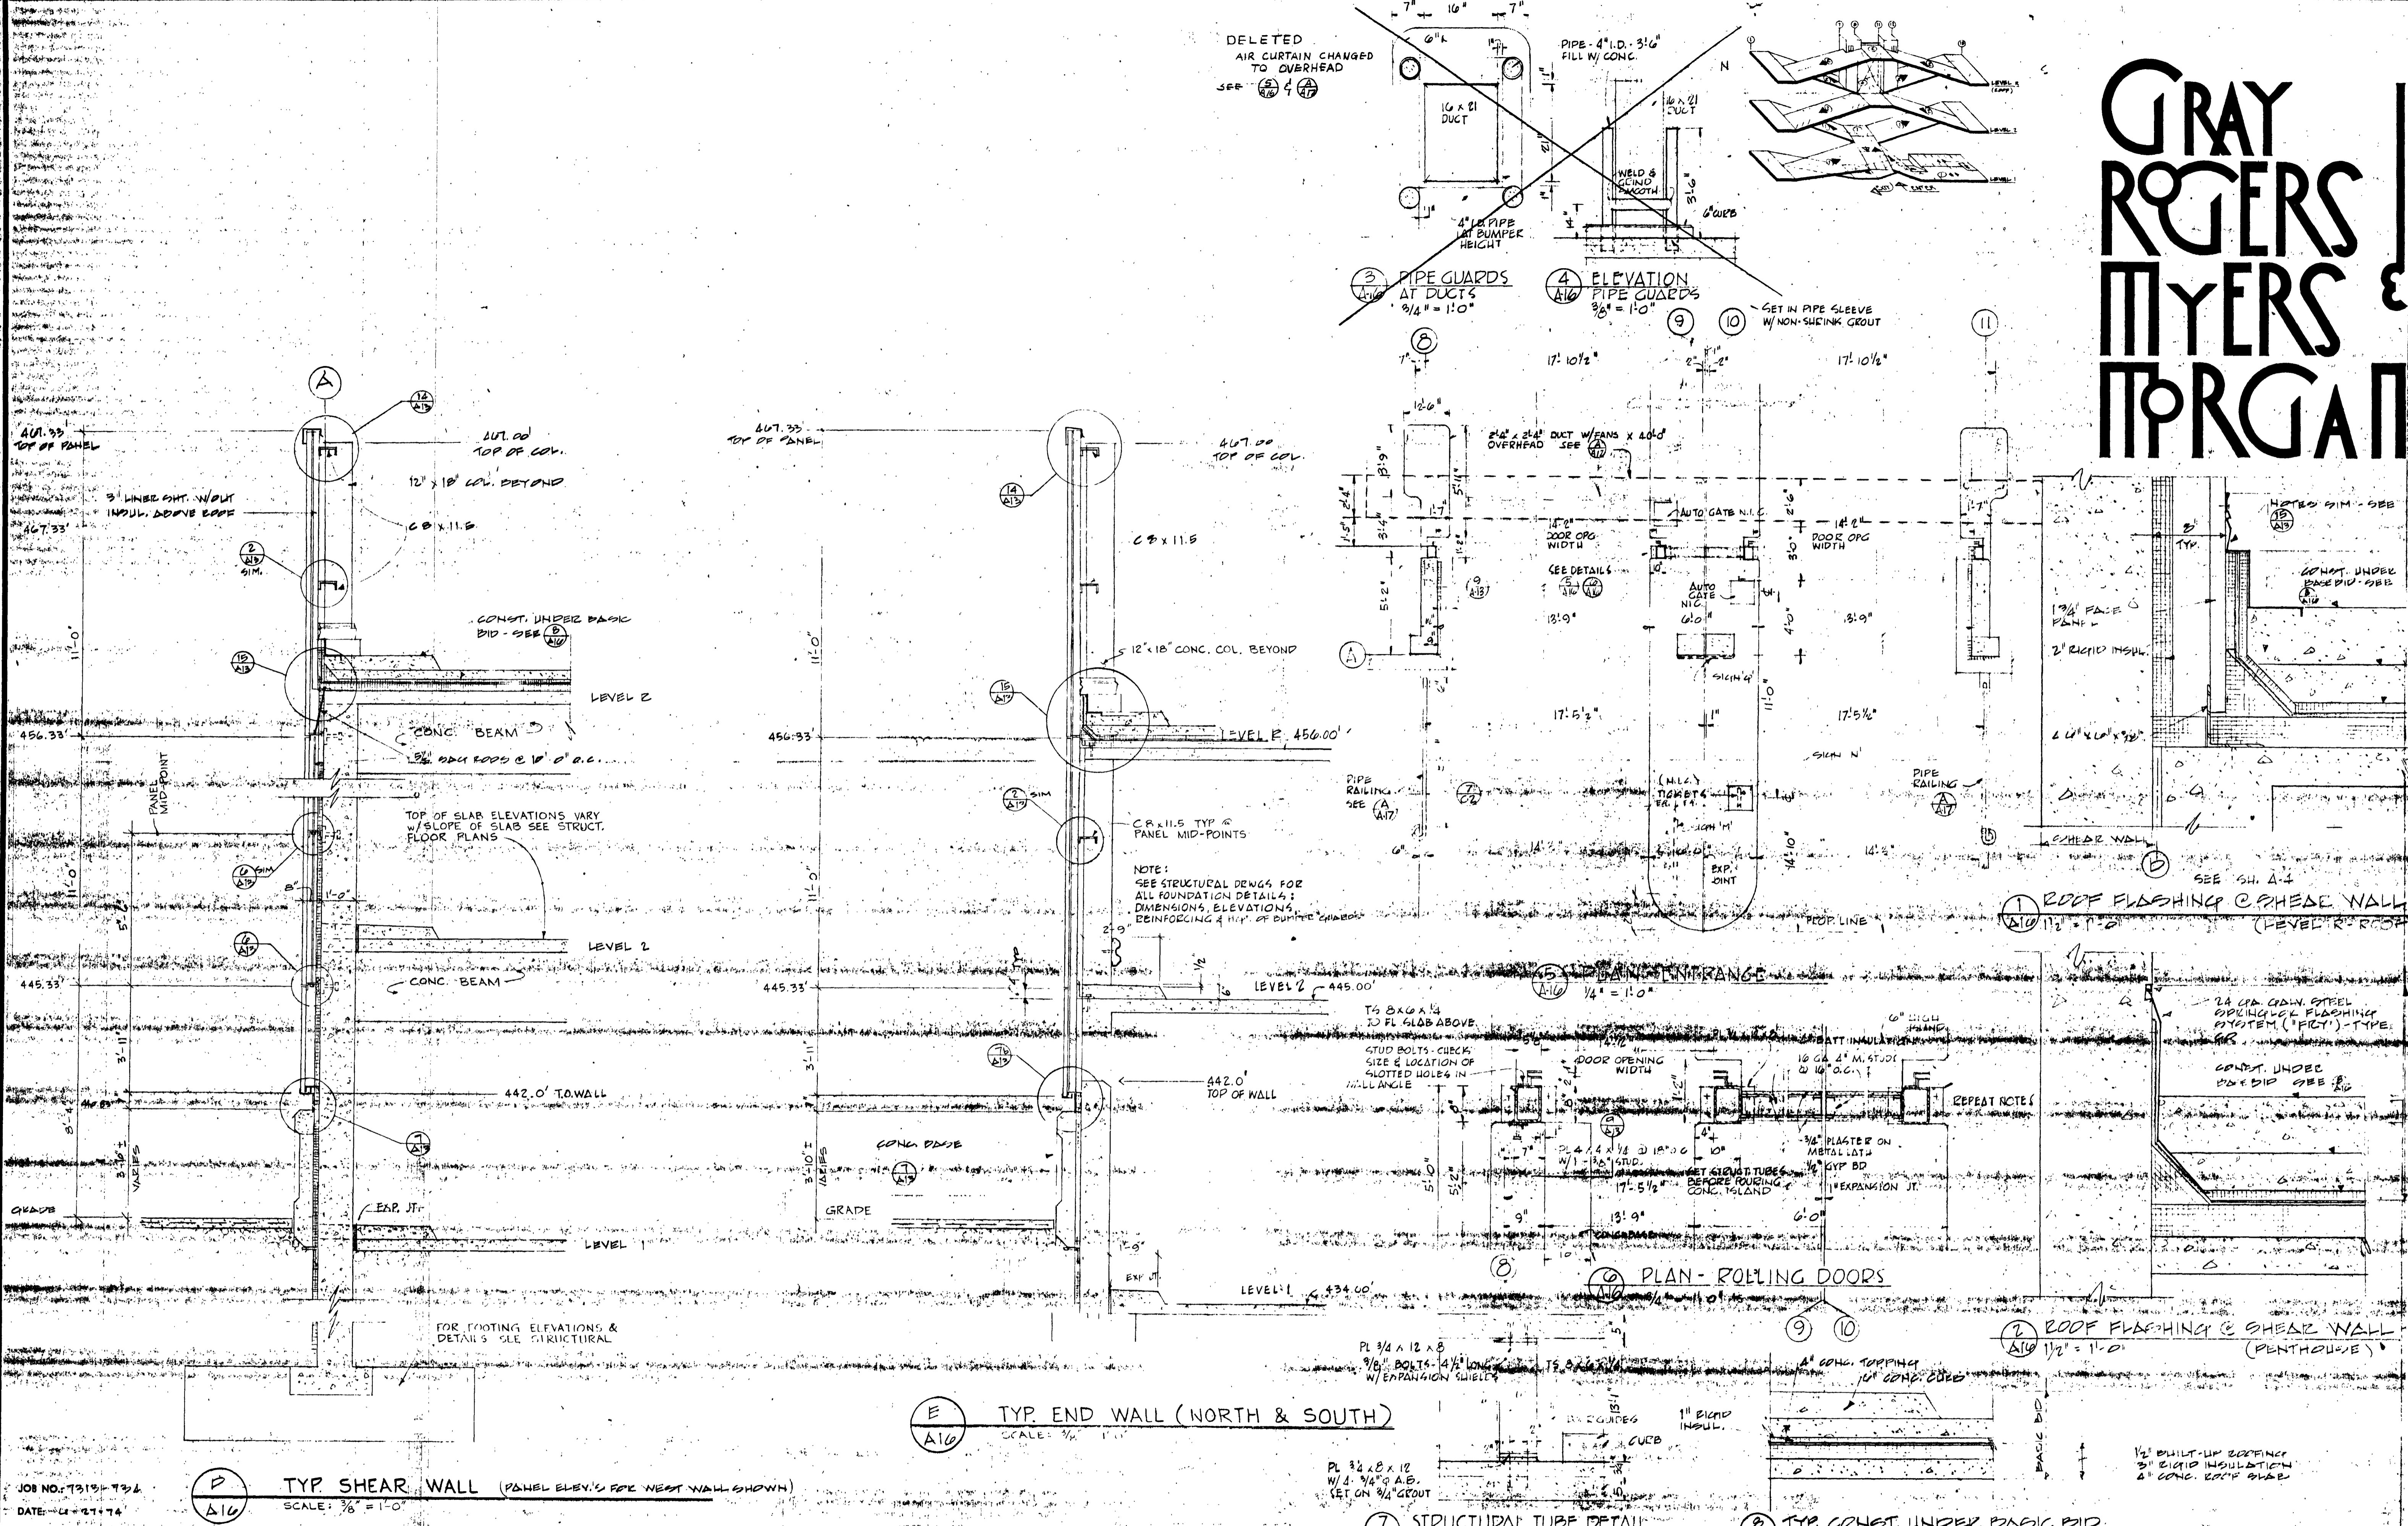

JOB NO. 7313-734
DATE: 12-21-74

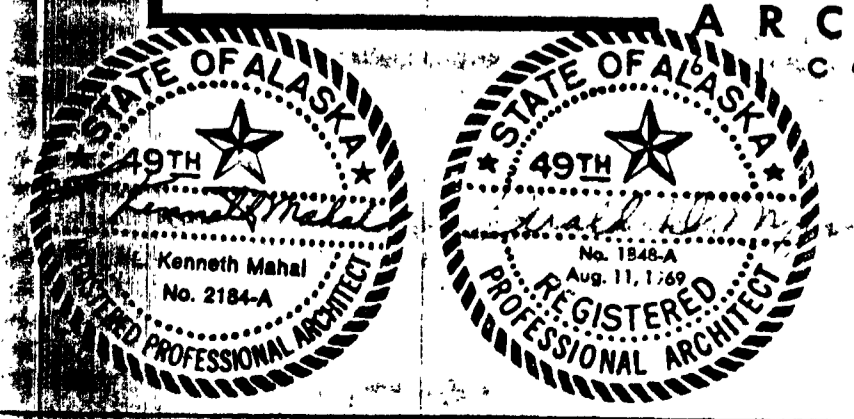

ARCHITECTS • ENGINEERS • SURVEYORS
COLLEGE ROAD, FAIRBANKS, ALASKA 99701, PHONE: 452-1124

STATE OF ALASKA
DEPT. OF PUBLIC WORKS
DIVISION OF BUILDINGS
JUNEAU ALASKA

FAIRBANKS PARKING STRUCTURE

DBA - 2 - 0130
FAIRBANKS, AK.

PETER KIEWIT SONS' CO.
FAIRBANKS, ALASKA
RECOMMENDED BY: W. Hoopes
DATE: _____
AS-BLT SHEET 19 OF 24

ABBREVIATIONS

AB	ANCHOR BOLT
ADD	ADDENDUM
ALT	ALTERNATE
ARCH	ARCHITECT, ARCHITECTURAL
BFE	BOTTOM FOOTING ELEVATION
BJ	BRIDGING JOIST
BLDG	BUILDING
BM	BEAM
BOT	BOTTOM
BRIDGE	BRIDGING
BSMT	BASEMENT
CANT	CANTILEVER
CL	CONTROL JOINT
CL	CENTER LINE
COL	COLUMN
CON	CONCRETE
CONN	CONNECTION
CONST	CONSTRUCTION
CONT	CONTINUOUS
CONTR	CONTRACTOR
COORD	COORDINATE
CT-JT	CONSTRUCTION JOINT
CTR	CENTER
DEPR	DEPRESSION
DET	DETAIL
DIA	DIAMETER
DM	DIMENSION
DJM	DOUBLE JOIST
DO	DITTO
DWG	DRAWING
DWLS	DOWELS
EACH	EACH FACE
EACH	EACH WAY
EE	EACH END
EJT	EXPANSION JOINT
EL	ELEVATION
ELEV	ELEVATION
ERECT	ERECTION
EWEF	EACH WAY EACH FACE
EXIST	EXISTING
EXP	EXPANSION
EXT	EXTERIOR
FDN	FOUNDATION
FIN	FINISH
FL	FLOOR
FP	FIREPROOFING
FRMG	FRAMING
FTG	FOOTING
FUT	FUTURE
GA	GAUGE, GAGE
GALV	GALVANIZED
GC	GENERAL CONTRACTOR
GND	GROUND
GR. BM	GRADE BEAM
HDR	HEADER
HS	HIGH STRENGTH
HT	HEIGHT
HORIZ	HORIZONTAL
IF	INSIDE FACE
IN	INCH
INT	INTERIOR

JST	JOIST
JT	JOINT
KWY	KEYWAY
MAX	MAXIMUM
MB	MACHINE BOLT
MECH	MECHANICAL
MEMB	MEMBRANE
MEZZ	MEZZANINE
MFR	MANUFACTURER
MIN	MINIMUM
MONO	MONOLITHIC
NO	NUMBER
OC	ON CENTER
OF	OUTSIDE FACE
OPNG	OPENING
PED	PEDESTAL
PLT	PLATE
PSF	POUNDS PER SQUARE FOOT
PSI	POUNDS PER SQUARE INCH

R	RISER
RC	RADIUS
RD	ROOF DRAIN
REF	REFERENCE
REINF	REINFORCE
REV	REVISE, REVISION
RS	ROUGH SLAB
RT	RIGHT
SCHED	SCHEDULE
SECT	SECTION
SF	SQUARE FOOT
SHT	SHEET
SIM	SIMILAR
SJ	STEEL JOIST
SPEC	SPECIFICATIONS
SPA	SPACES
SQ	SQUARE
ST	STEEL
STIR	STIRRUPS
STRUCT	STRUCTURAL
STR	STRAIGHT
SYMM	SYMMETRICAL
T&B	TOP & BOTTOM
TEMP ST	TEMPERATURE STEEL
TJ	TRIPLE JOIST
TR	TREAD
TRYP	TYPICAL
UNO	UNLESS NOTED OTHERWISE
VERT	VERTICAL
W/	WITH
WP	WEATHERPROOF, WEATHERPROOF
WT	WEIGHT
WVF	WELDED WIRE FABRIC

GENERAL STRUCTURAL NOTES

- BUILDING CODES USED:**
 - Uniform Building Code, 1970.
 - ACI Standard 318-71.
 - AISC Specification, 1969.
- FOUNDATION:**
 - Foundation design based on an allowable uniform pressure of 4,000 psf with spread footings bearing on compacted fill.
 - All slabs on grade are to be placed on 4 mil polyethylene vapor barrier.
- DESIGN LIVE LOADS:**
 - All Parking Decks 50 psf
 - Stairs, Corridors 100 psf
 - Seismic Zone 3
- DESIGN:**
 - Reinforced concrete beams, slabs and columns designed in accordance with the ultimate strength theory and ACI 318-71.
 - Post-tensioned girders and slabs designed in accordance with ACI 318-71 and "Tentative Recommendations for Concrete Members Prestressed with Unbonded Tendons" by ACI Committee 423.

CONCRETE:






Class	Strength at 28 Days (psi)	Location
A	5,000	Post-tensioned slabs, beams, & girders. (Precast girders & columns and conventional reinforced 6-1/2" slabs for contractor option.)
B	4,000	Footings, fdn. walls, slabs on grade, and all other concrete.

- REINFORCING STEEL:**
 - ACI "Manual of Standard Practice for Detailing Reinforced Concrete Structures" (latest edition) and CRSI "Manual of Standard Practice" (latest edition) to govern fabrication of all reinforcing steel unless shown otherwise on plans.
 - Reinforcing vendor to furnish all accessories, chairs, spacer bars and supports necessary to secure steel in accordance with the ACI "Manual of Standard Practice for Detailing Reinforced Concrete Structures" (latest edition) and CRSI "Manual of Standard Practice" (latest edition).
 - All reinforcing steel to be ASTM A-615 Grade 60 except stirrups and ties to be ASTM A-615 Grade 40.
 - Concrete reinforcement shall be placed according to the CRSI "Recommended Practice for Placing Reinforcing Bars" (latest edition).

- 10. METAL SLAB FORM:**
 - Metal Slab Form - See General Specifications.
 - 11. BACKFILLING:**
 - No backfilling and compacting of earth shall be permitted against foundation walls until supporting slabs have been poured and have reached 75% of their design strength or unless adequate bracing submitted for review is provided.
 - Both sides of foundation walls shall be backfilled simultaneously so as to prevent overturning or lateral movement of walls.
 - All grade beams shall be adequately braced to prevent lateral movement during backfilling and compaction.
 - 12. CONSTRUCTION JOINTS:**
 - General contractor shall submit a drawing showing the proposed construction joints for all areas. This includes walls, structural floor systems, slabs on grade, etc. This drawing must be reviewed by the project engineer and returned to the contractor prior to pouring of any concrete. These construction joint drawings shall be furnished to the fabricators before their shop drawings are submitted. If for some reason the contractor desires to adjust or remove certain proposed construction joints, he must submit new construction joint drawings and a written request outlining his reasons for the proposed change to the architect for his review prior to pouring.
 - Construction joints are to be made as detailed on structural drawings. Location of construction joints shall be coordinated with post-tensioning installer.
 - 13.** General Contractor to verify location of all mechanical and electrical openings with mechanical and electrical contractors respectively.
 - 14.** The exact location and elevations of all existing utilities shall be verified by the General Contractor and reported to the architect for conformance with assumptions made in preparation of construction documents.
 - 15.** All reinforcing bars that terminate at a slab or wall edge are to be hooked.
 - 16.** Unless noted otherwise, provide two #5 bars each side of all openings in slabs and walls.
 - 17.** All exposed corners of columns, beams and walls to have 1/4" x 3/4" chamfer.
- 7. STRUCTURAL STEEL:**
 - Fabrication and erection of structural steel shall be governed by AISC "Code of Standard Practice", latest edition.
 - Shop connections may be welded or bolted. Field connections may be bolted or welded.
 - All bolts used for field connections shall be 3/4" diameter high strength bolts per ASTM A-325, unless noted or shown otherwise on plans.
 - Standard connections (AISC) used for beam to columns or beam to beam connection, unless shown otherwise on plans.
 - Minimum beam connections shall be as shown in table on Sheet No. S-9 for 3/4" diameter A-325 high strength bolts, unless shown or noted otherwise on plans.
 - 8. STEEL JOISTS:**
 - All steel joists shall conform to requirements of the Steel Joist Institute Standard Specifications, latest edition. Manufacturers not members of SJI or AISC shall submit for architect's approval a complete structural analysis of their joists proposed for use. All stresses shall be within limits established by SJI.
 - Bridging for H series steel joists shall be continuous horizontal 5/8" rods or equal at top and bottom of joists in lengths to permit lapping at joist panel points for welding. Weld bridging to web members near top and bottom chords.
 - Refer to plans for bottom chord extensions required.
 - Header angles for steel joists shall be furnished by joist manufacturer.
 - Steel joists are to be attached to supporting members as per recommendations of Steel Joist Institute Specifications.
 - 9. STEEL ROOF DECK:**
 - Steel roof deck shall be 1-1/2" in depth by 20-gage. See general specifications for type and method of fastening deck to supporting members.

GRAY ROGERS MYERS & TORGAN

A DIVISION OF ELLERBE

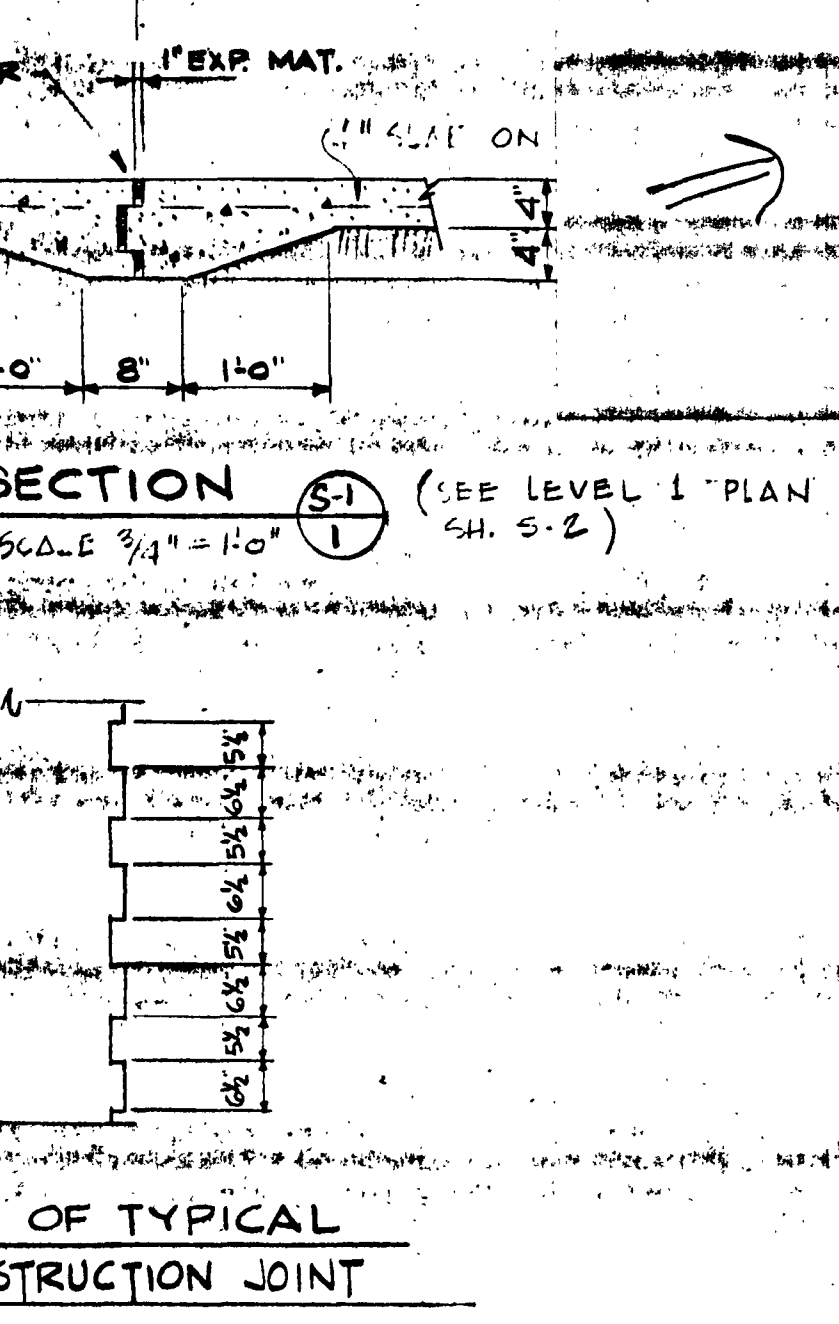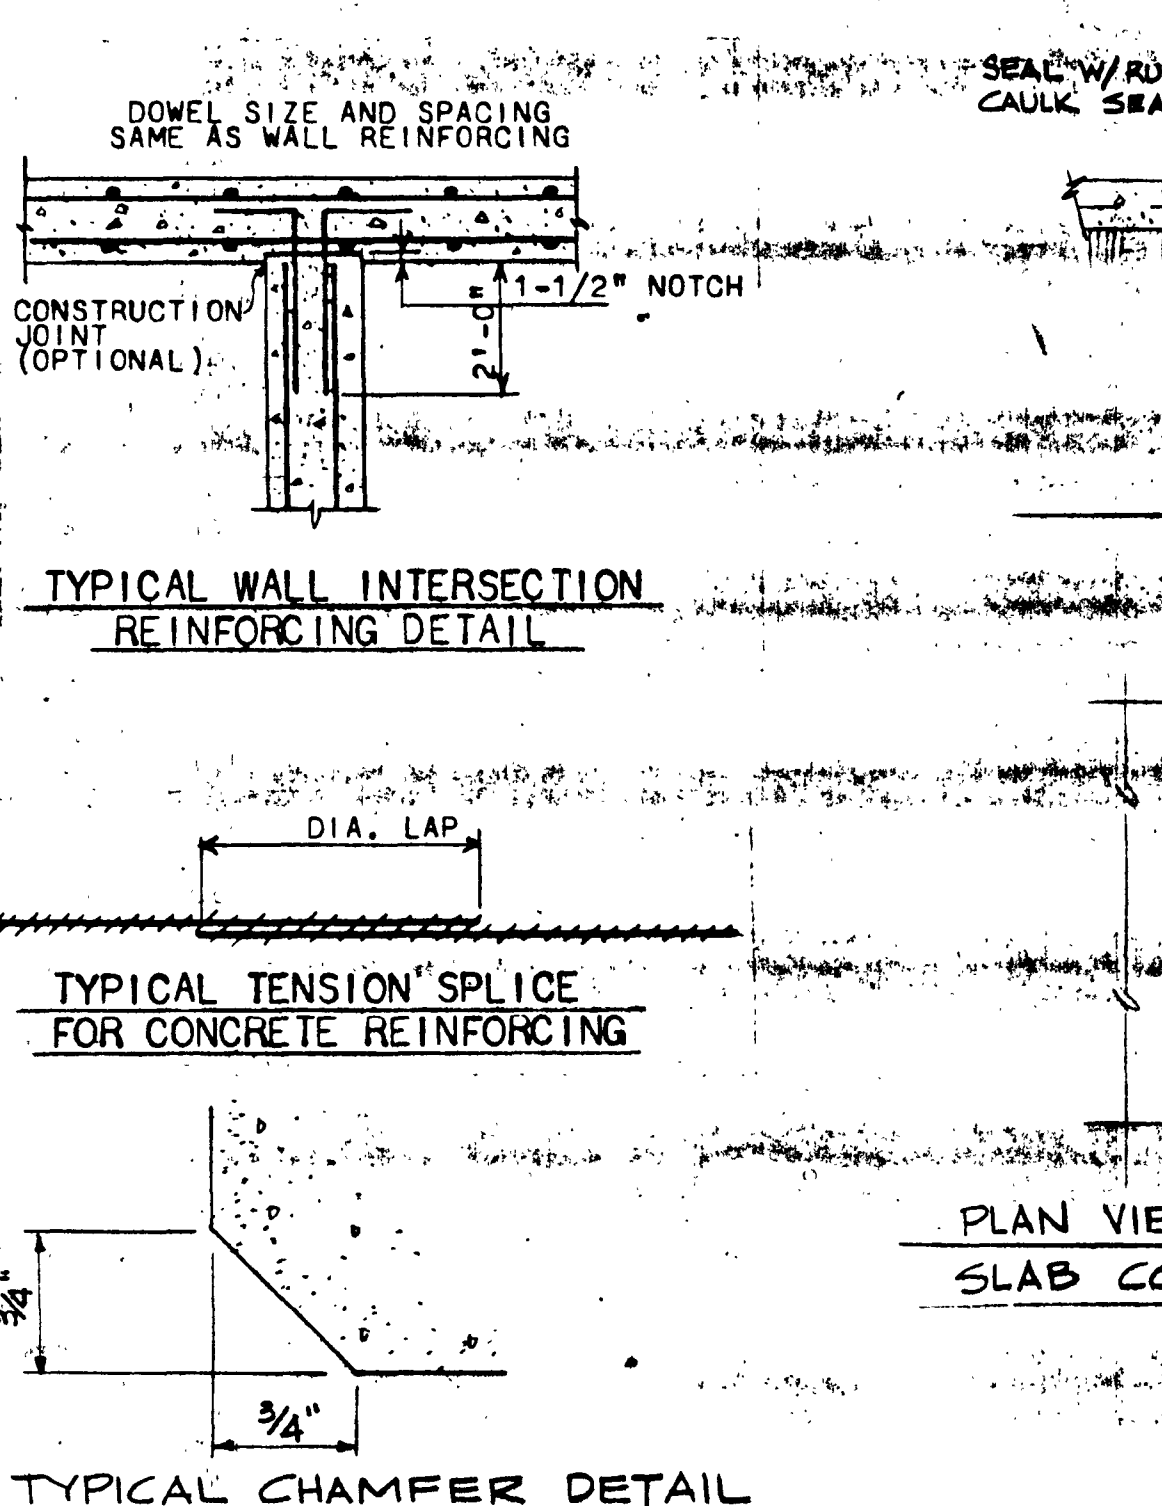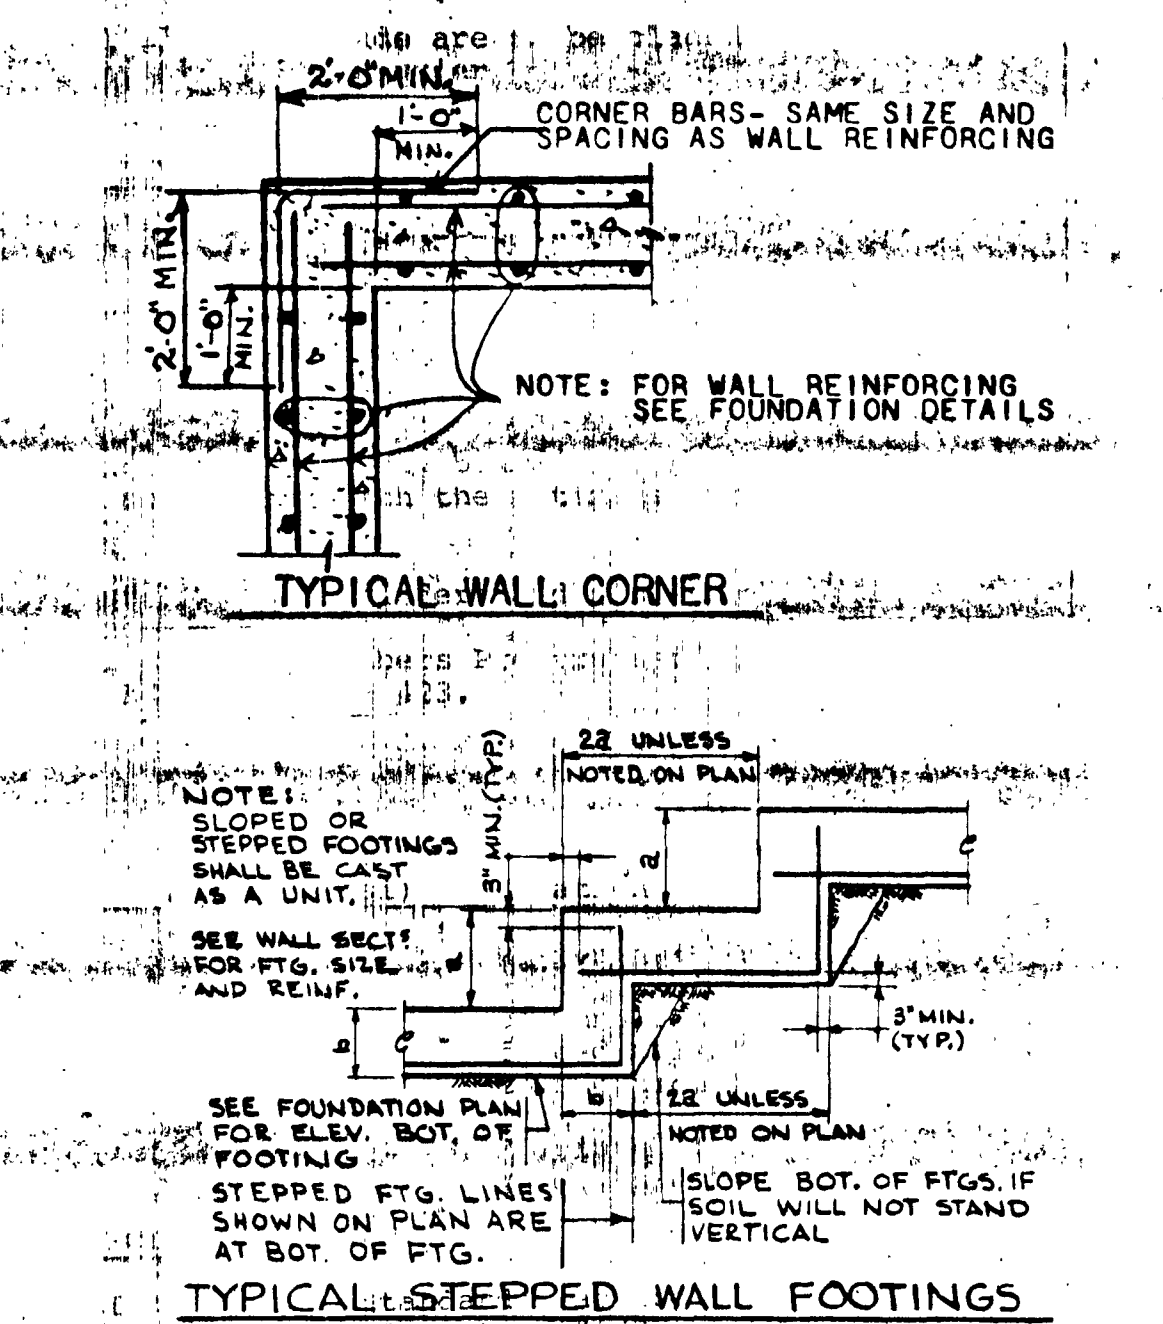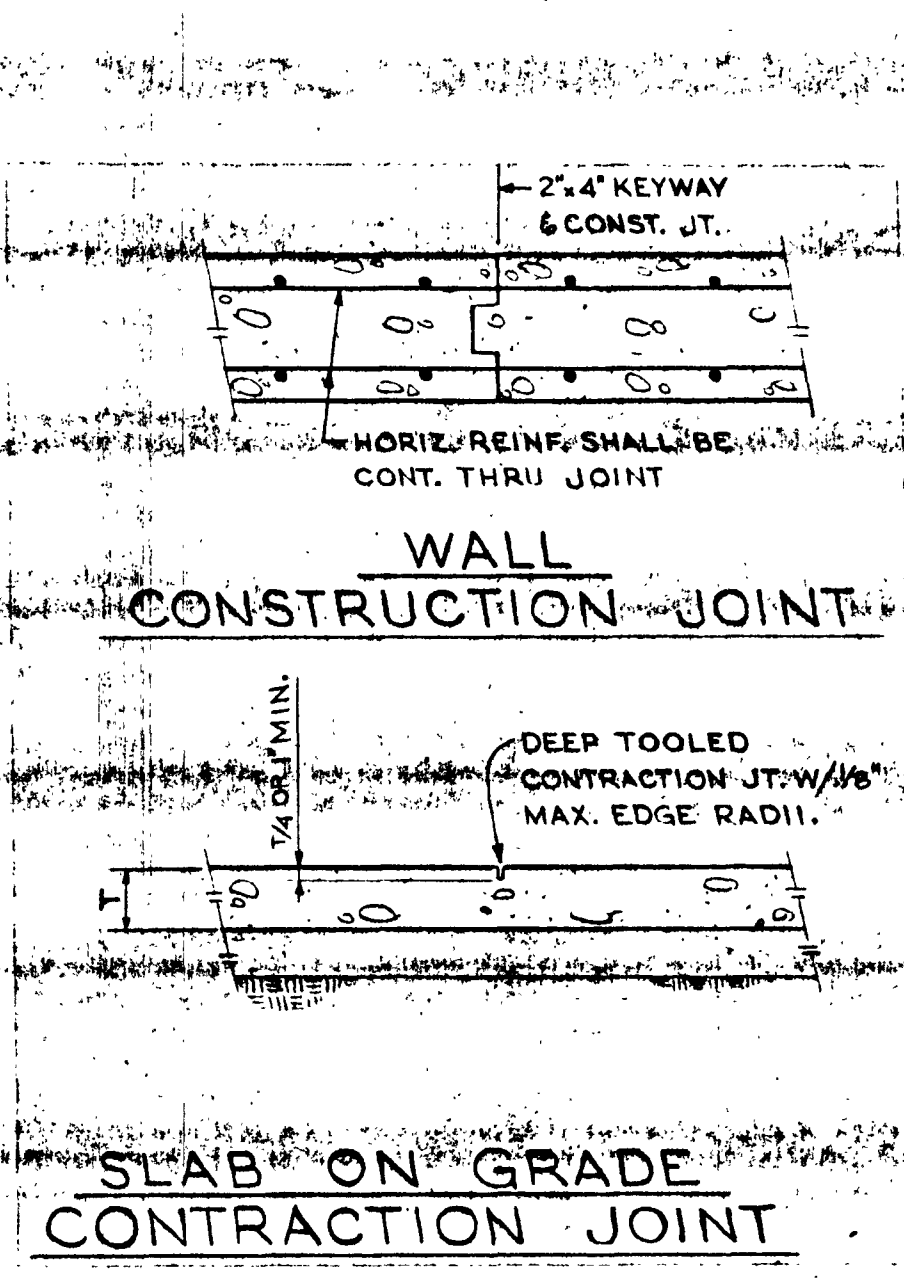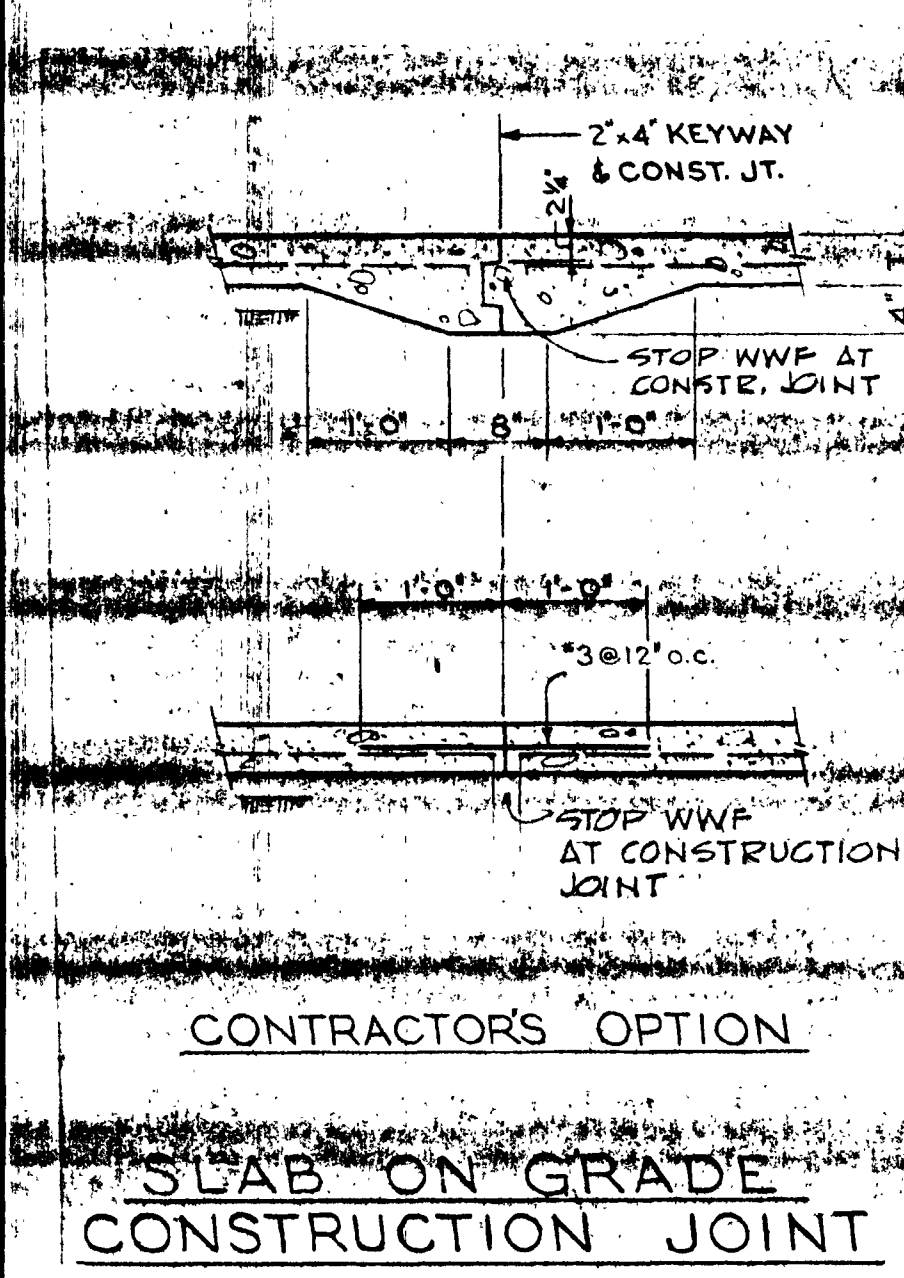

Precast Option

The structural system indicated on the following sheets (S-1 thru S-14) is post-tensioned girder and slab. The contractor has the option to provide a precast column and girder system with a conventionally reinforced 6-1/2" concrete slab in lieu of the P-T system indicated on Sheet S-1 thru S-14. Typical member sizes, reinforcing and details for the precast option are shown on Sheet S-15 and are to be used for bidding purposes. If the contractor provides the precast option, structural calculations for all precast members and connections shall be submitted to the Architect for approval.

The contractor will be responsible to coordinate the precast details with plans and details on Sheets S-1 thru S-14 to ensure conformance with design intent. It is not mandatory for the contractor to submit a price for the precast option.

General Note to Contractor

The Contractor shall avoid damage as a result of his operation to existing sidewalks, streets, curbs, pavements, utilities, (except those to be replaced or removed) adjoining the property, etc., and he shall, at his own expense completely repair any damage thereto caused by his operation.

The Contractor shall shore up, brace, underpin, secure, and protect as may be necessary, all foundations and other parts of existing structures adjacent thereto adjoining, and in the vicinity of the site, which may be affected by the excavations or other operations connected with construction of the parking structure embraced in this contract. The Contractor shall be responsible for the giving of any and all required notices to any adjoining or adjacent property owners or other parties before the commencement of any work. The Contractor shall indemnify and save harmless the State of Alaska and the Architect/Engineer from any damages on account of settlement or the loss of lateral support of adjoining property and from all loss and expense and all damages for which the State of Alaska and the Architect/Engineer may become liable and consequence of such injury or damage to adjoining and adjacent structures and their premises.

TYPICAL DETAILS AND GENERAL STRUCTURAL NOTES

JOB NO. 7313-734
DATE: 6-27-74

ARCHITECTS • ENGINEERS • SURVEYORS

601 COLLEGE ROAD, FAIRBANKS, ALASKA 99701. PHONE: 452-1124

STATE OF ALASKA
DEPT. OF PUBLIC WORKS
DIVISION OF BUILDINGS
JUNEAU ALASKA





FAIRBANKS PARKING STRUCTURE
DBA - 2 - 0130
FAIRBANKS, AK.

S-1

SHEET 21 OF 24

GRAY ROGERS MYERS & TORGAN

A DIVISION OF ELLERBE

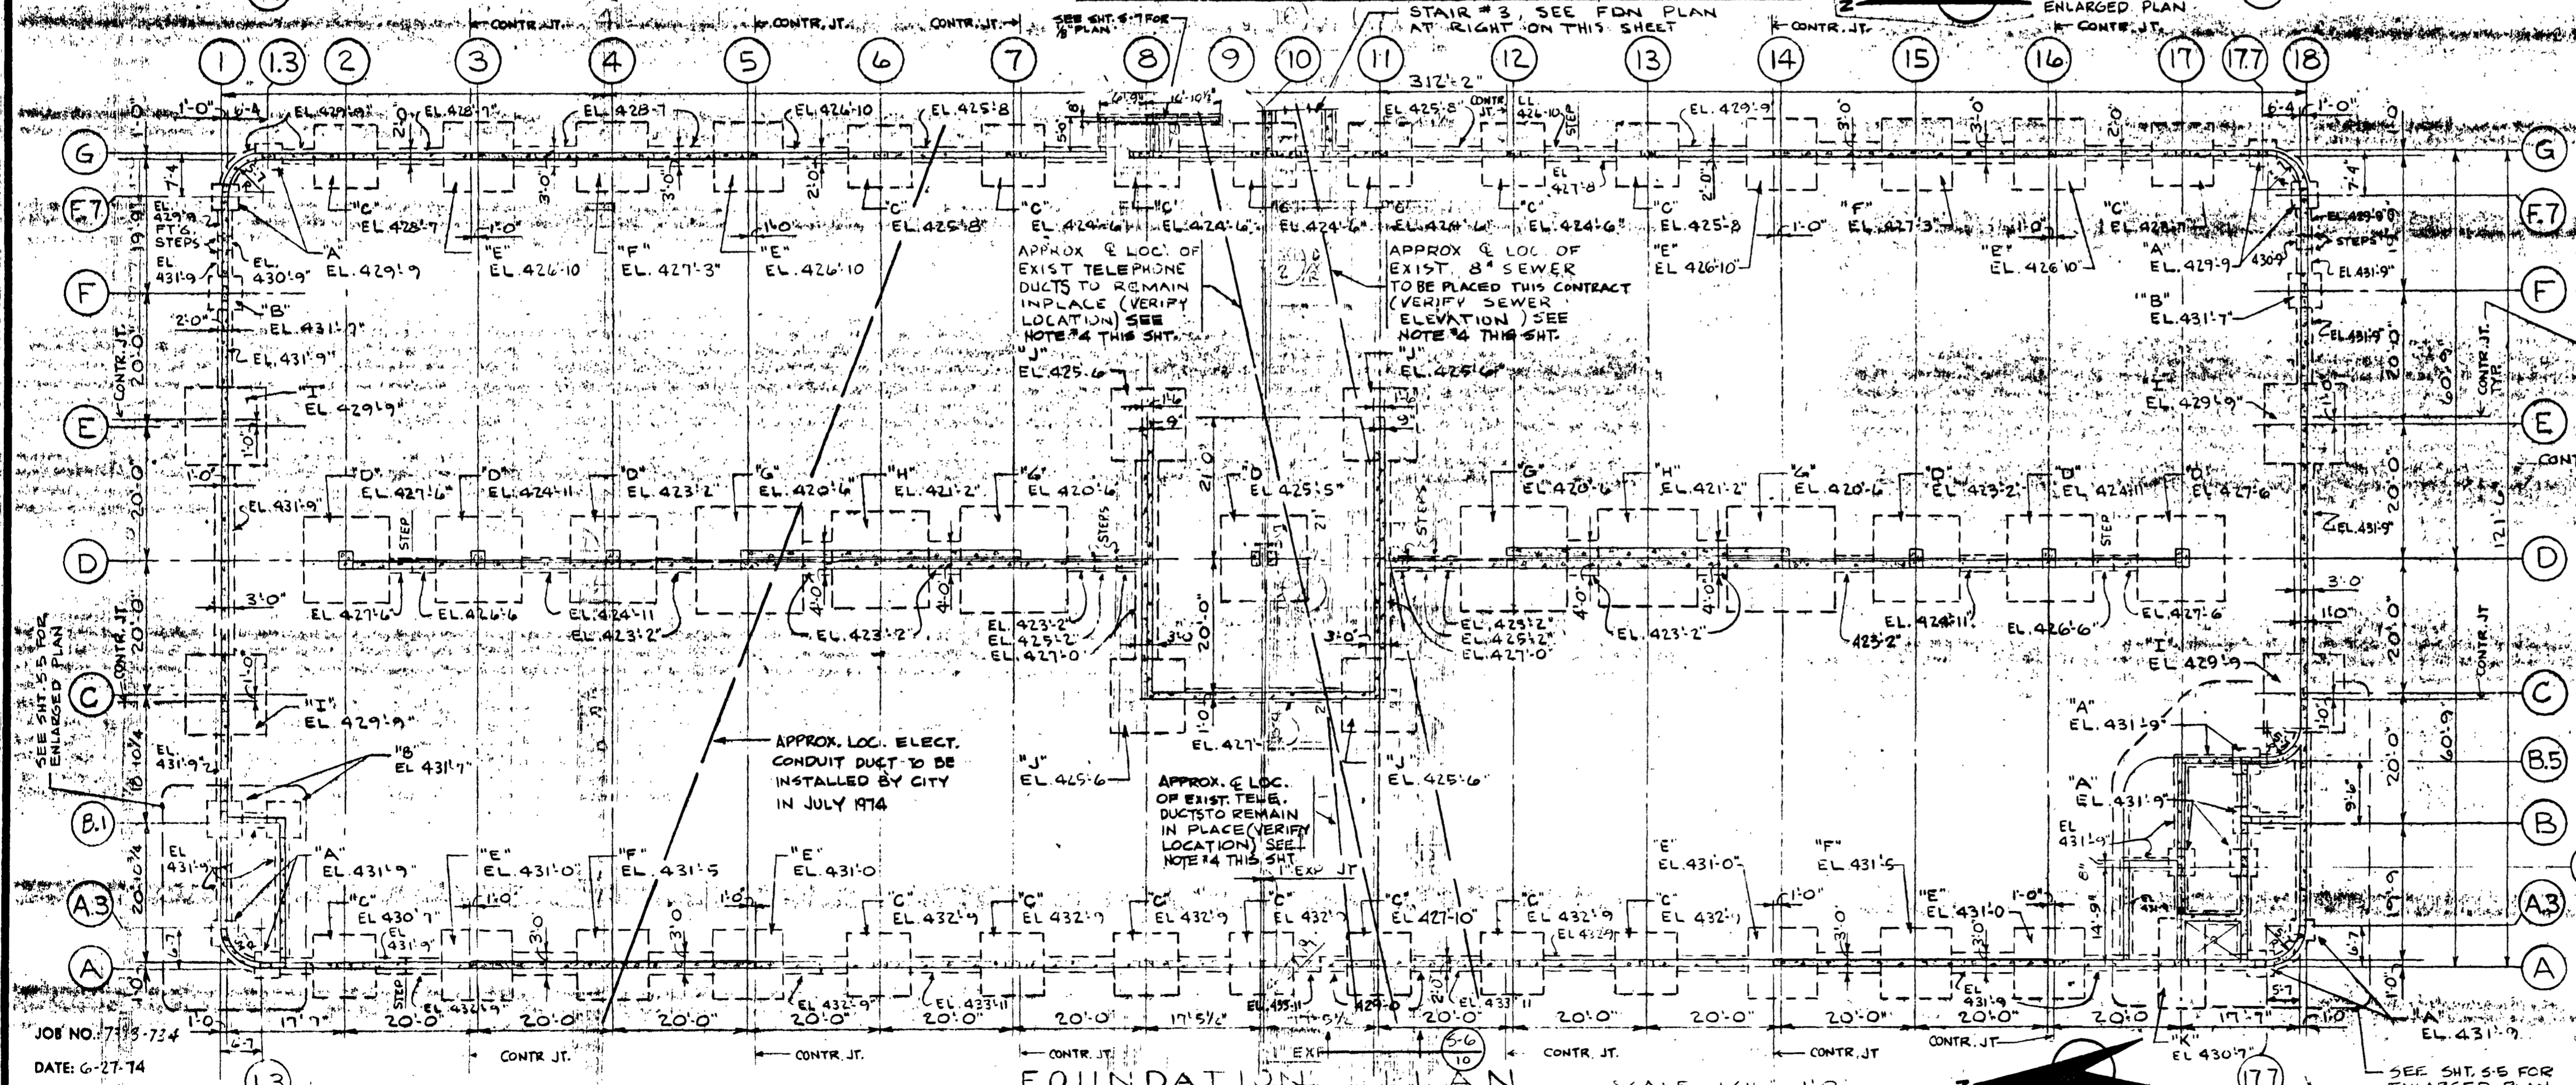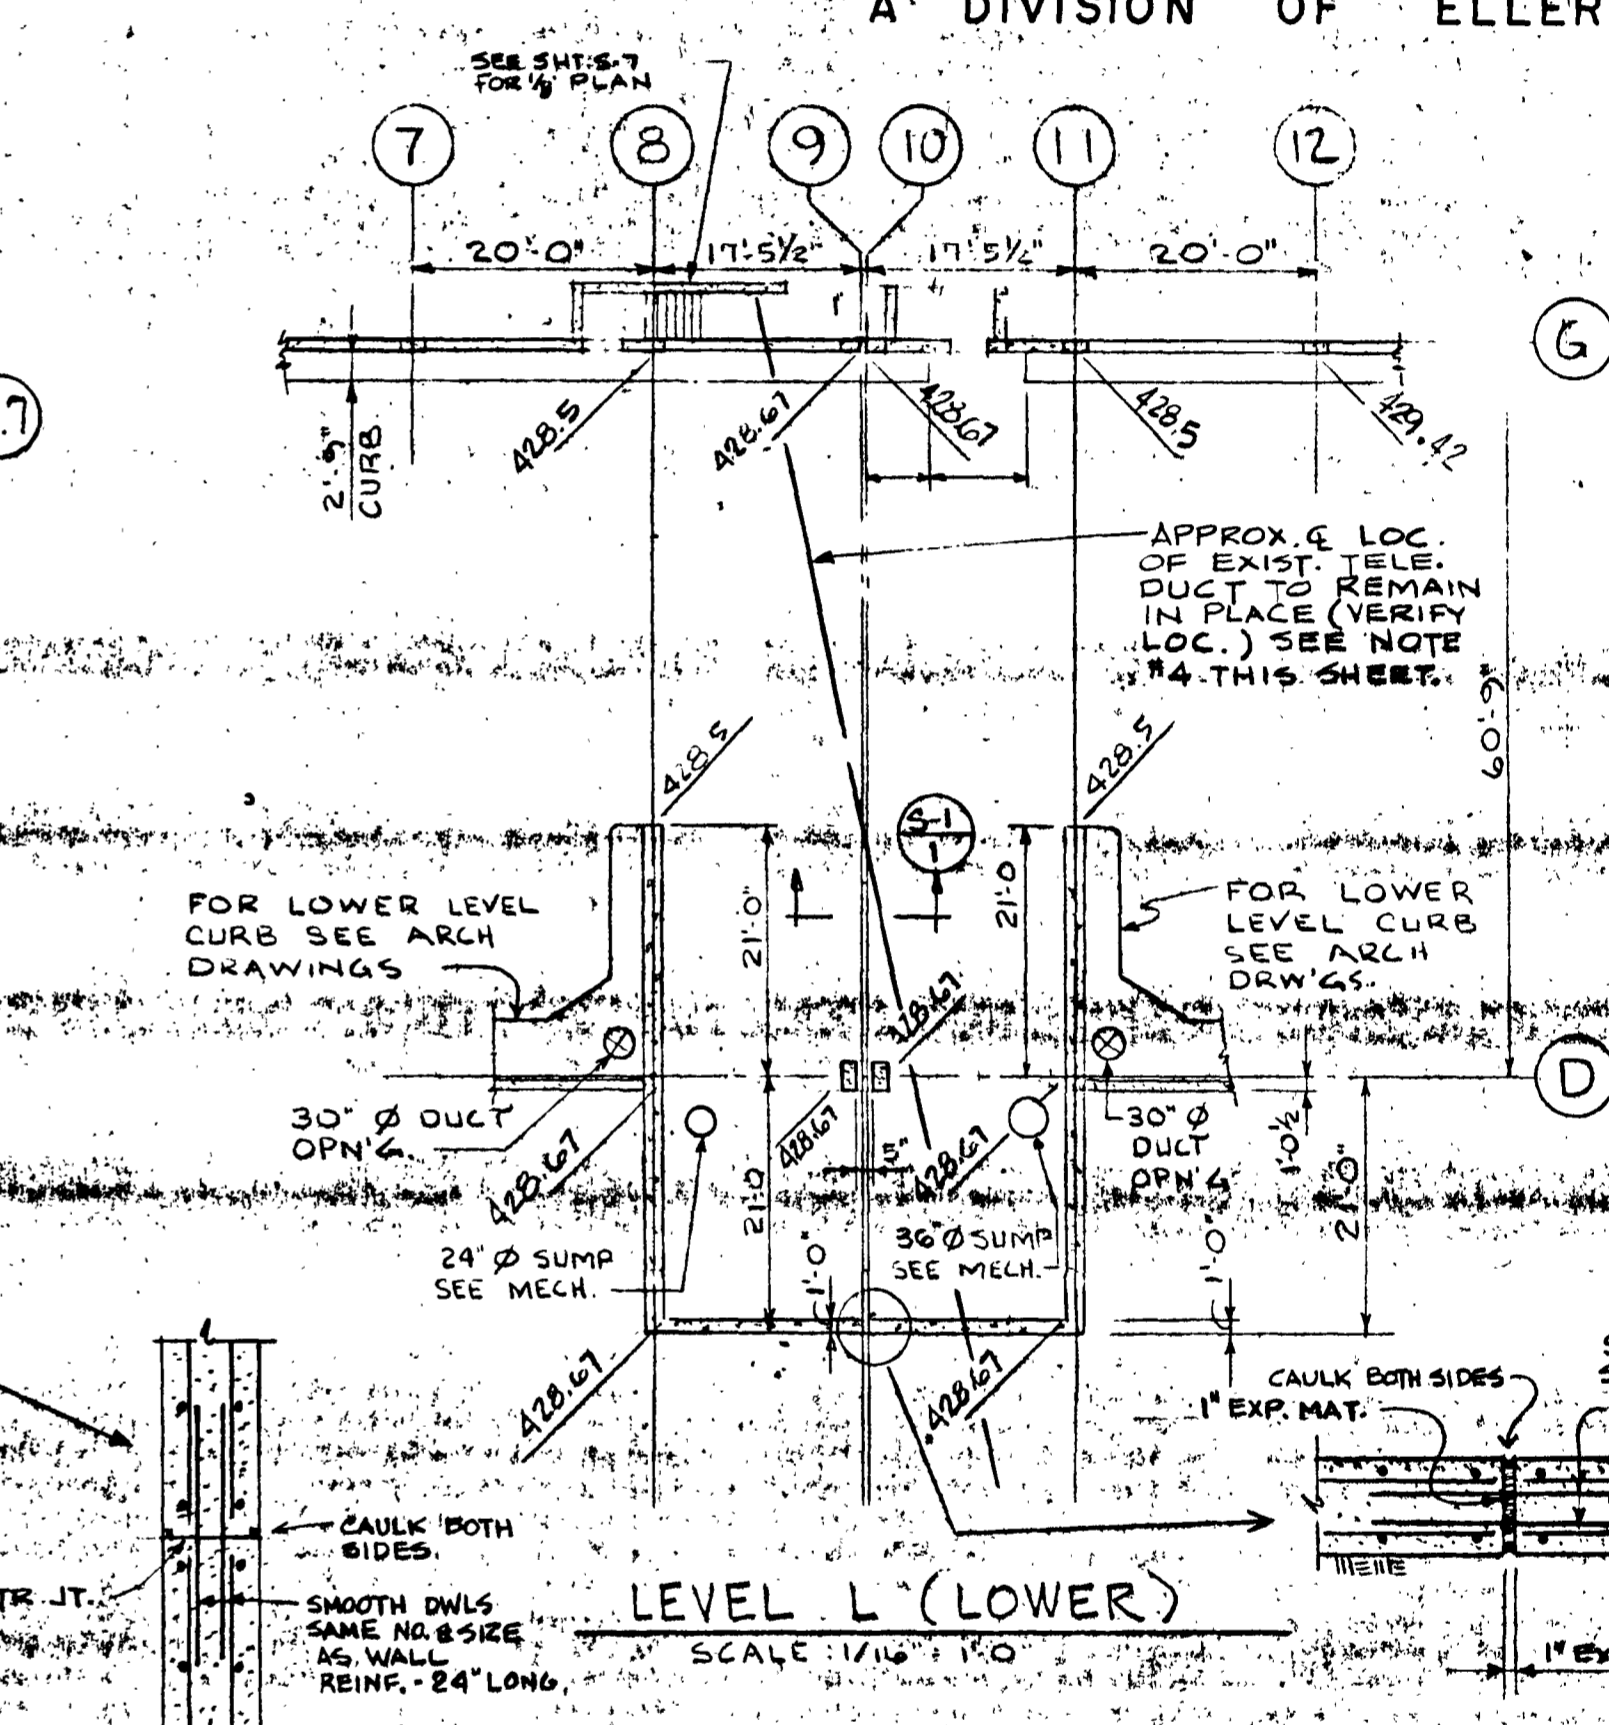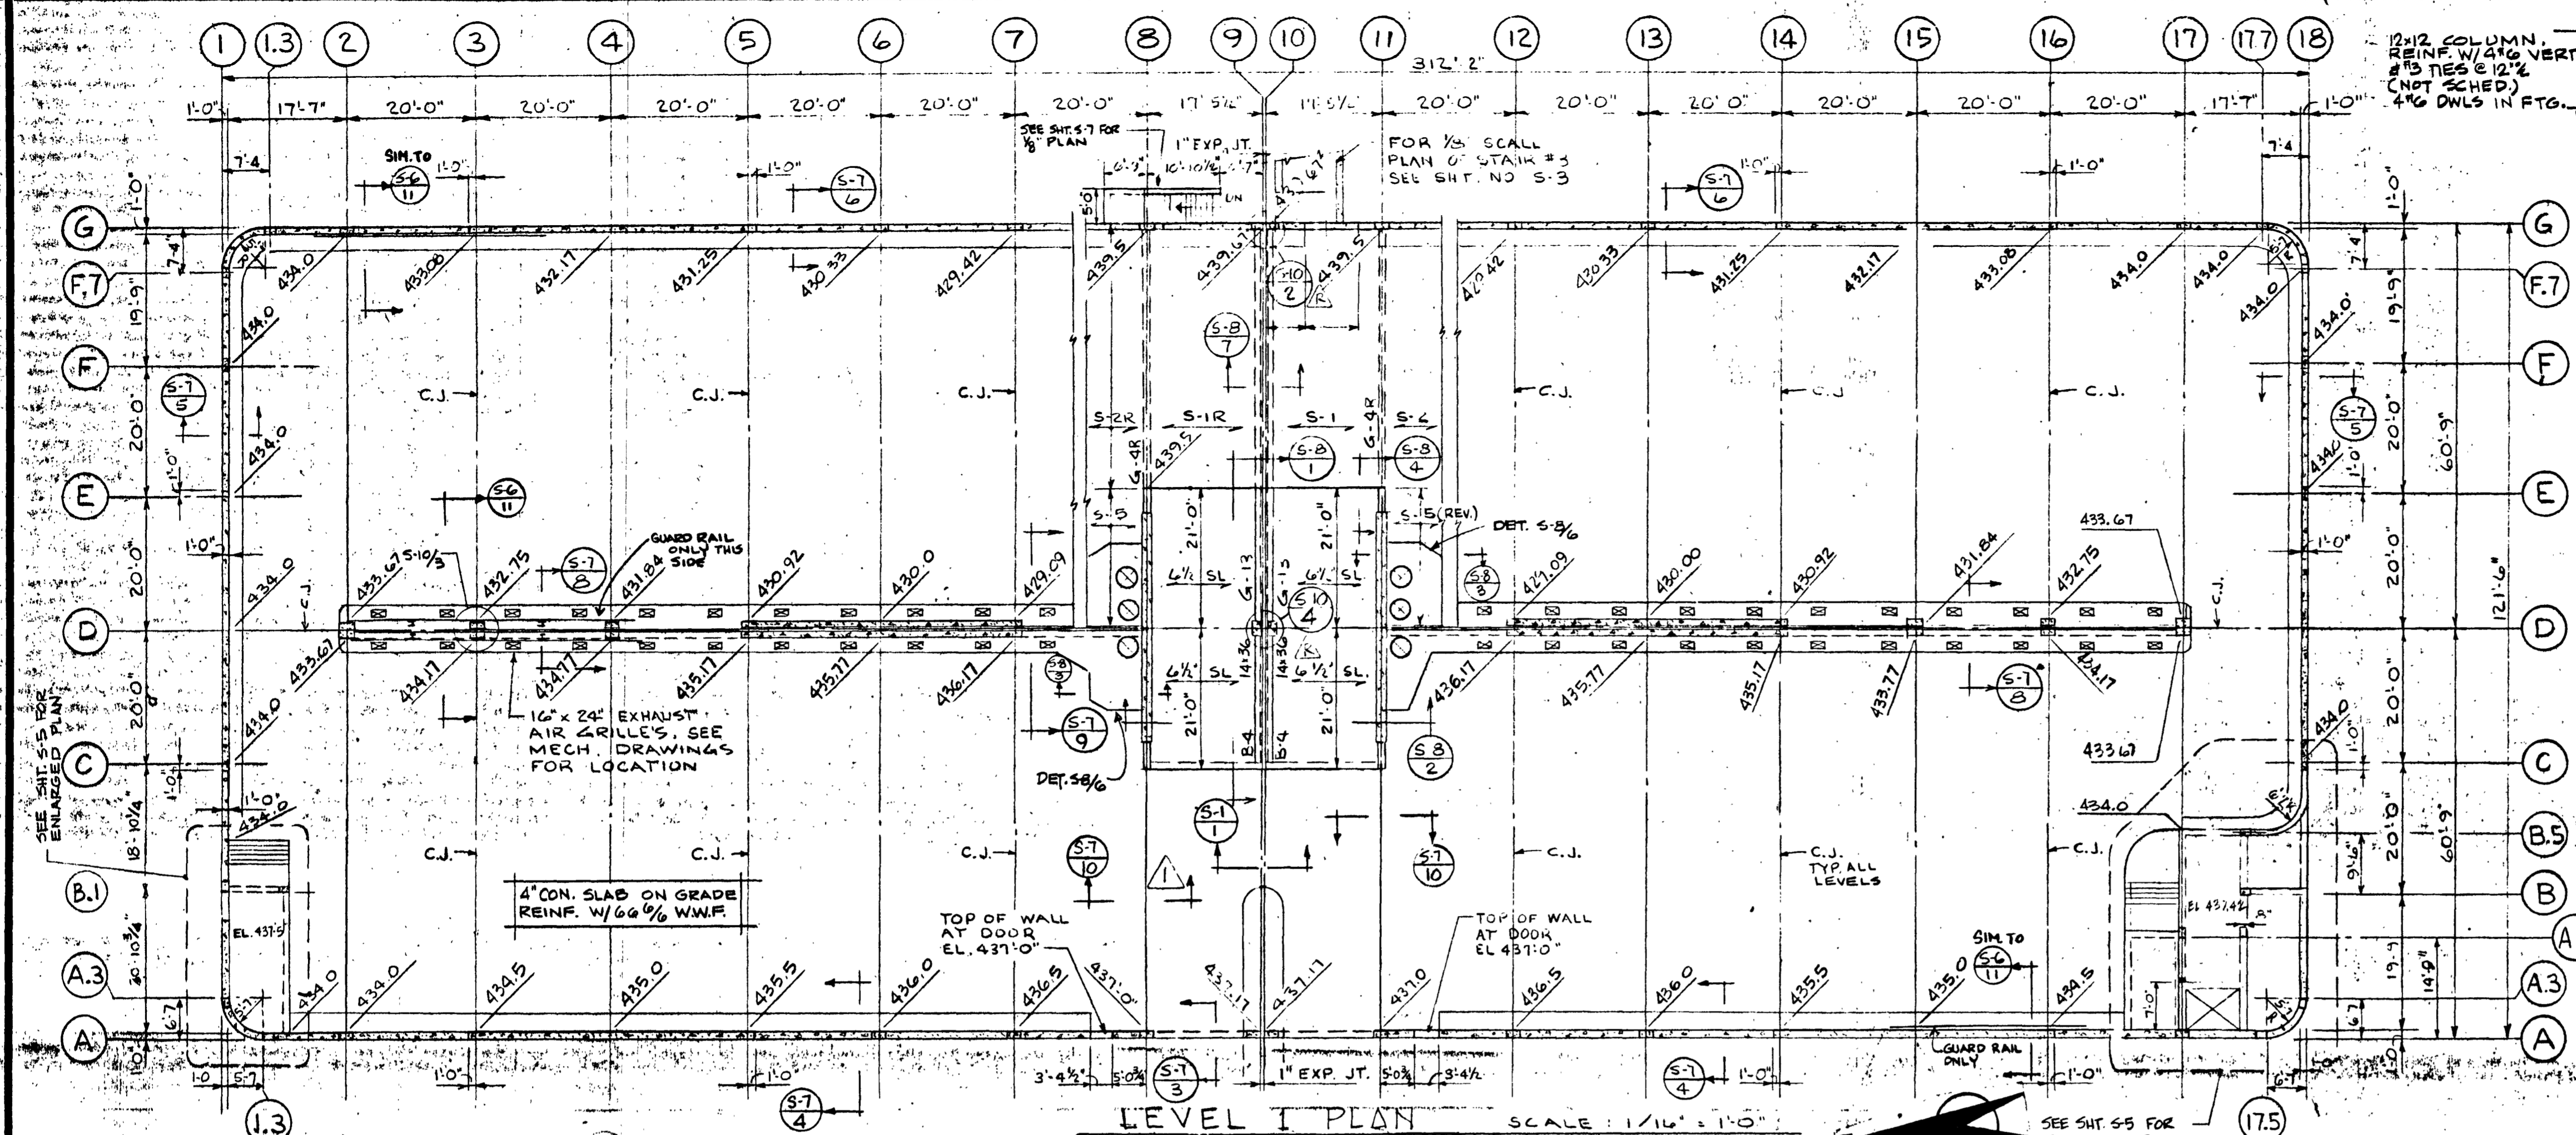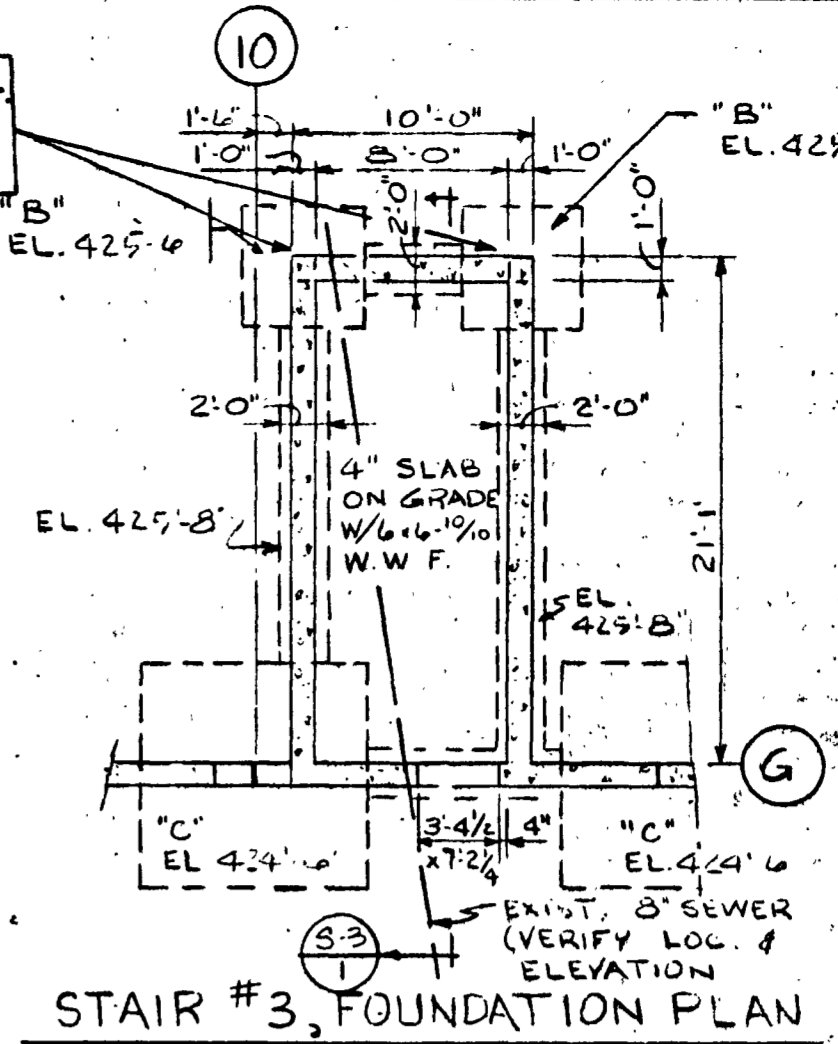

FOOTING SCHEDULE			
FOOTING	SIZE	DEPTH	REINFORCING
"A"	4'-0" x 4'-0"	12"	4-#5 E.W.
"B"	5'-0" x 5'-0"	14"	5-#5 E.W.
"C"	9'-6" x 9'-6"	26"	7-#8 E.W.
"D"	13'-0" x 13'-0"	33"	11-#9 E.W.
"E"	12'-6" x 10'-6"	33"	9-#9 E.W.
"F"	10'-6" x 10'-6"	28"	9-#8 E.W.
"G"	16'-0" x 16'-0"	44"	14-#10 E.W.
"H"	14'-6" x 14'-6"	36"	12-#9 E.W.
"I"	12'-0" x 12'-0"	30"	10-#9 E.W.
"J"	11'-0" x 11'-0"	32"	11-#8 E.W.
"K"	7'-0" x 13'-0"	26"	9-#8 LONG 12-#8 SHORT

NOTES:
 1. ALL FOOTINGS ARE CENTERED UNDER COLUMNS OR WALLS.
 2. SEE PLAN FOR FOOTING ELEVATIONS, ELEVATIONS ARE BOTTOM OF FOOTINGS.
 3. VERIFY SIZE & LOCATION OF ALL MECHANICAL OPENINGS, ETC. WITH MECHANICAL CONTRACTOR.
 4. THE CONTRACTOR IS RESPONSIBLE FOR PROVIDING THE SHORING & PROTECTION FOR EXISTING TELE. DUCT & SEWER LINE DURING CONSTRUCTION.


ARCHITECTS • ENGINEERS • SURVEYORS
 601 COLLEGE ROAD, FAIRBANKS, ALASKA 99701, PHONE: 452-1241



STATE OF ALASKA
 DEPT. OF PUBLIC WORKS
 DIVISION OF BUILDINGS
 JUNEAU ALASKA

FAIRBANKS PARKING STRUCTURE
 FAIRBANKS, AK.
 DBA - 2 - 0130


S-2

SHEET 22 OF 24

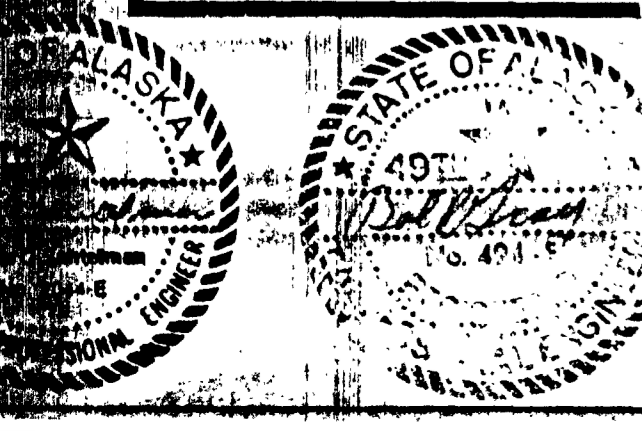


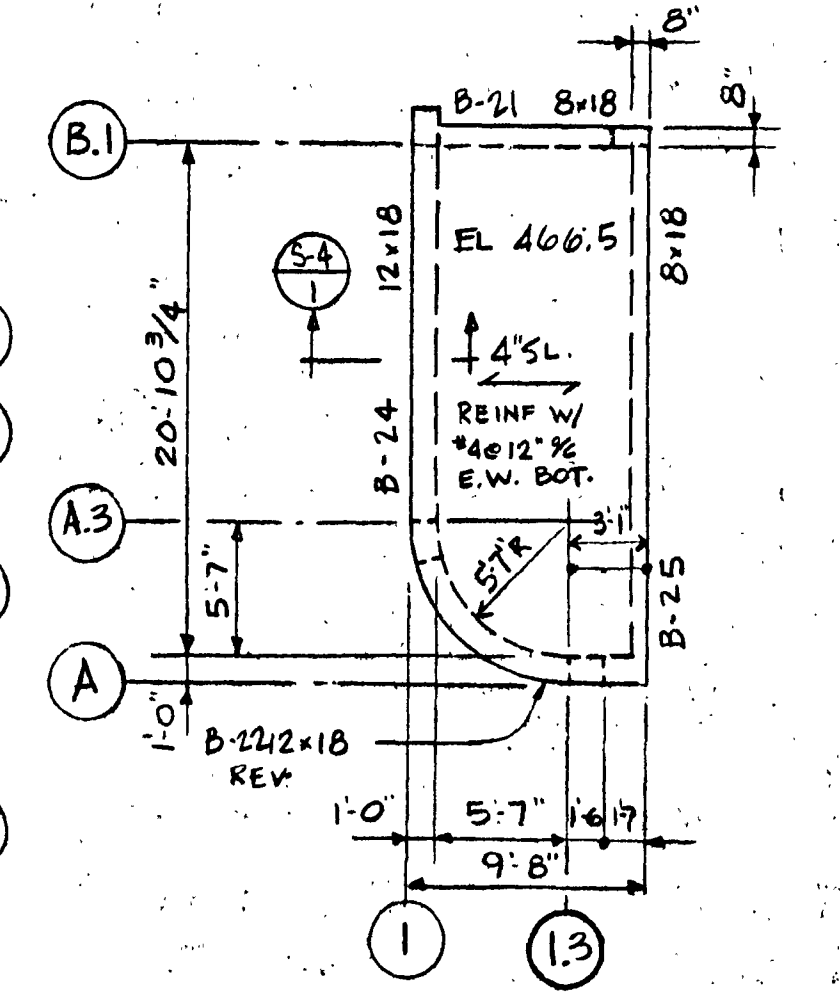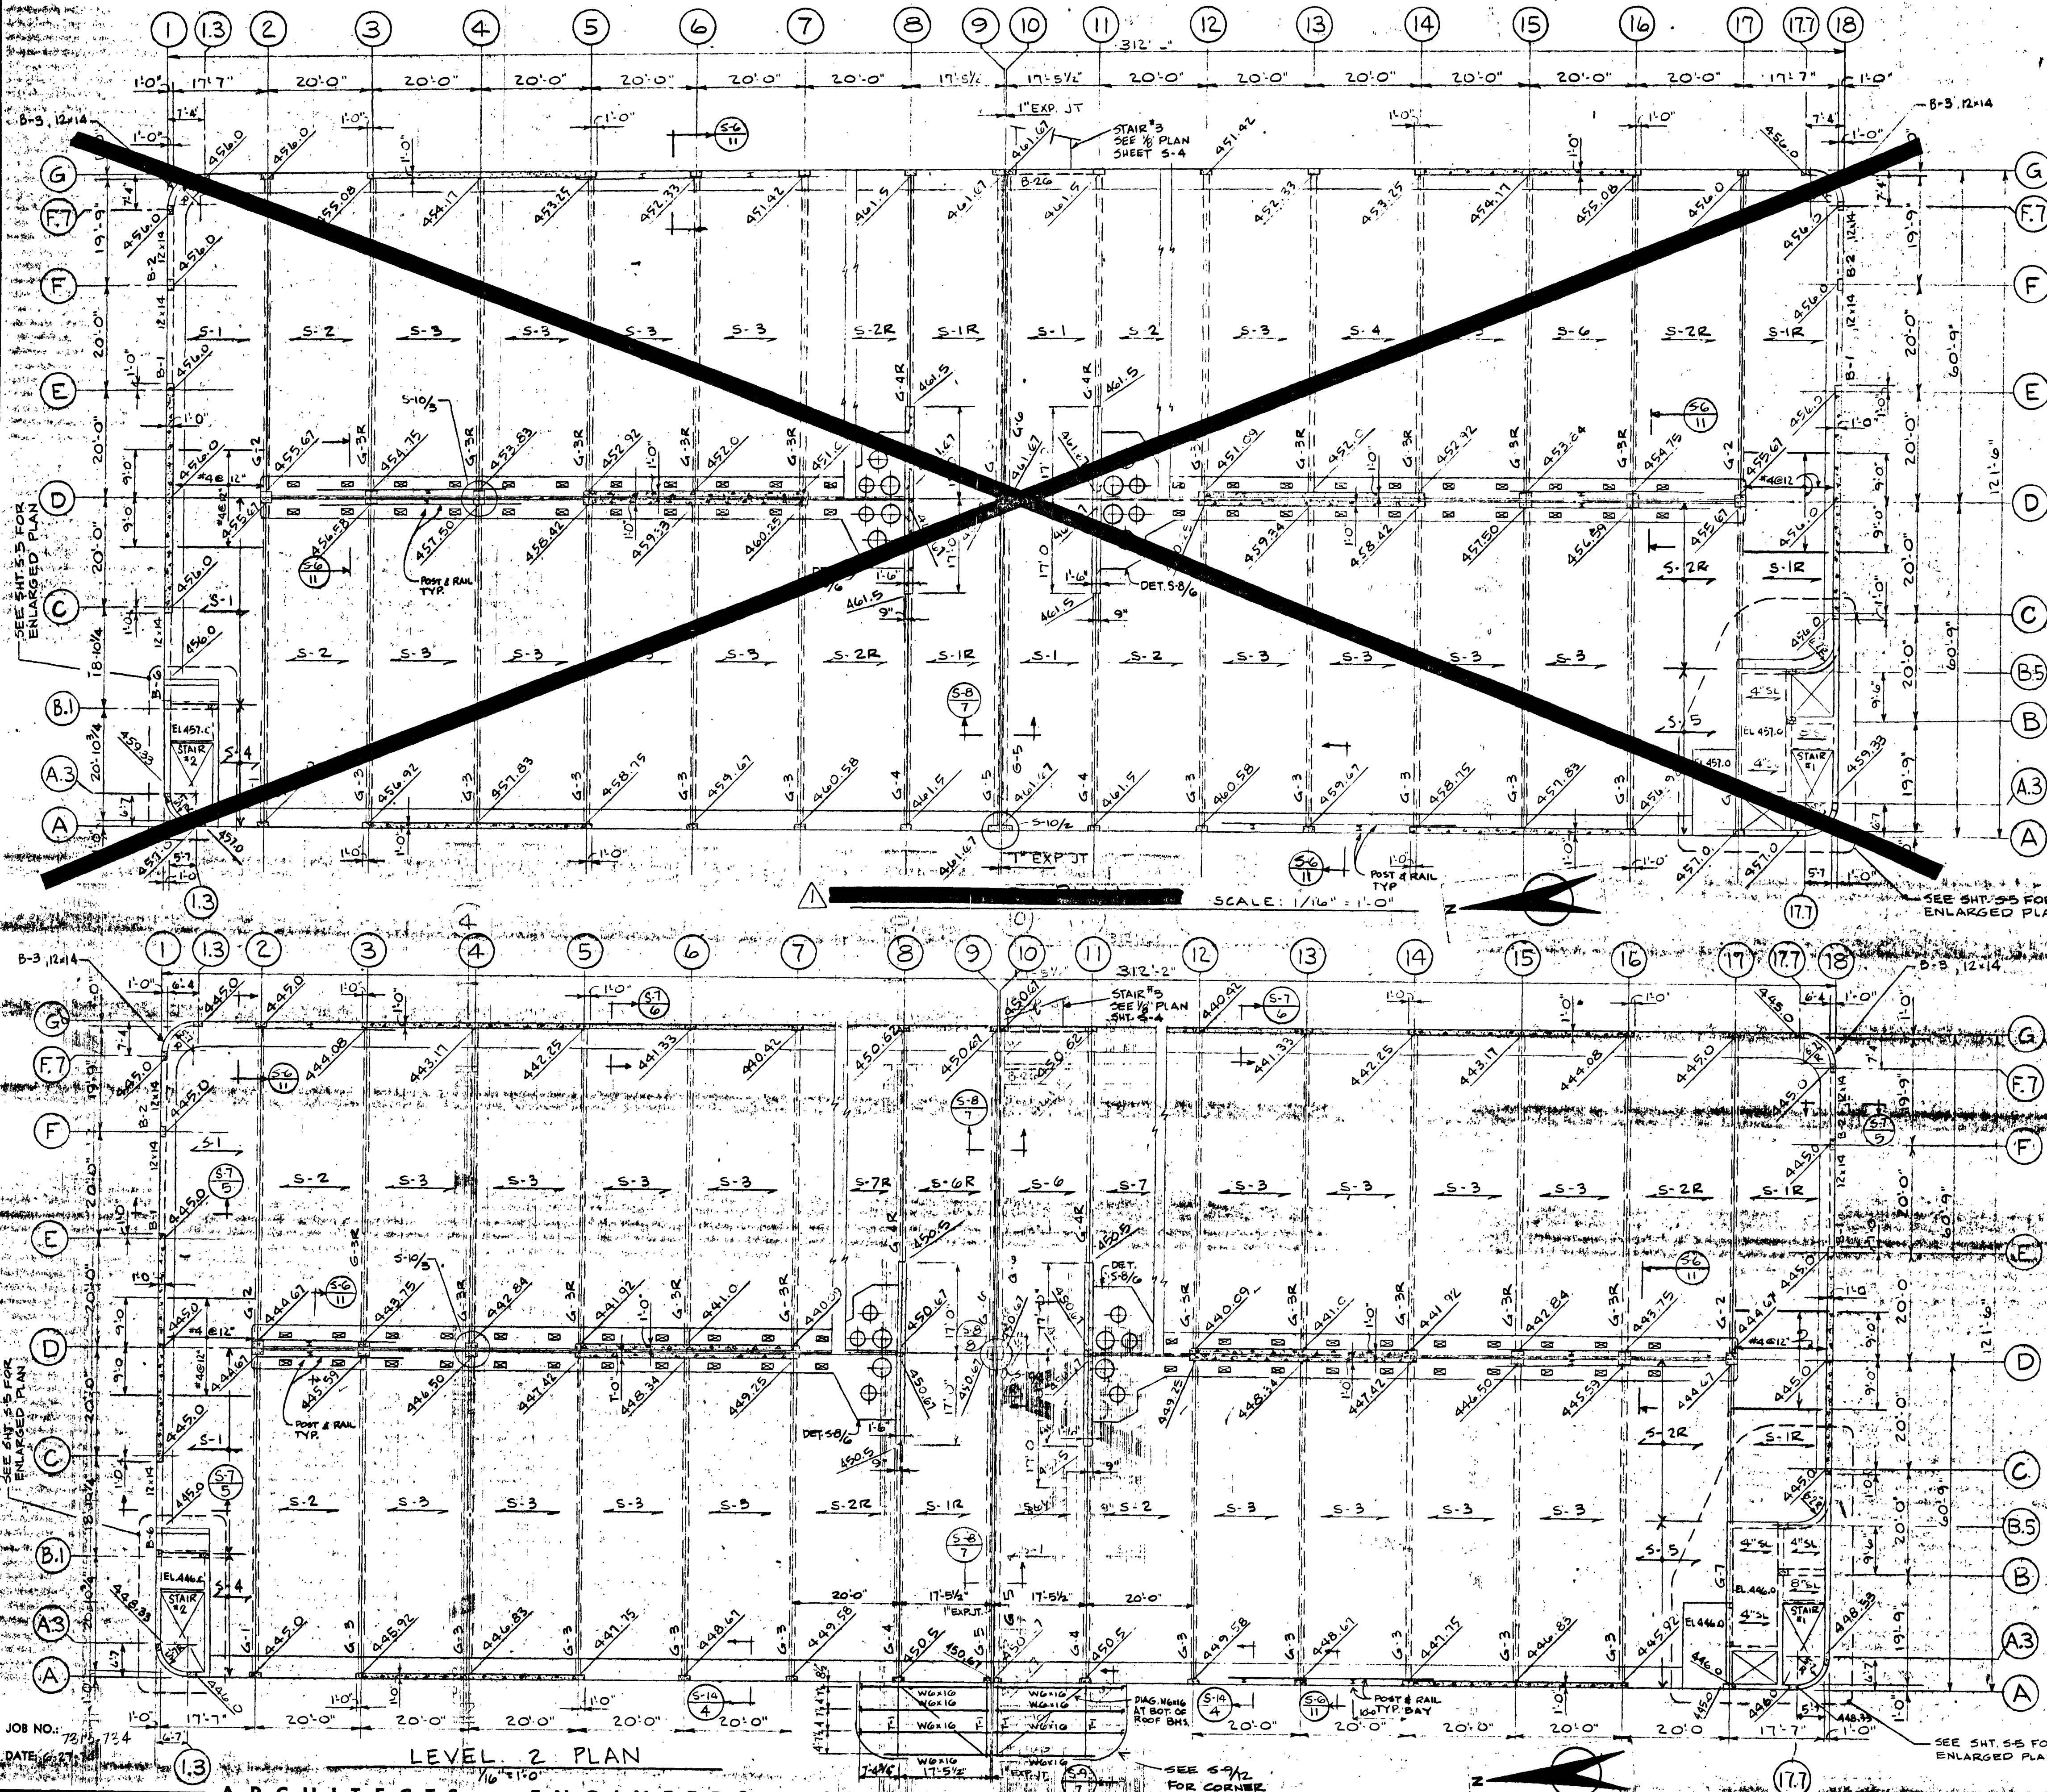

STAIR #2 UPPER ROOF PLAN
1/8" = 1'-0"

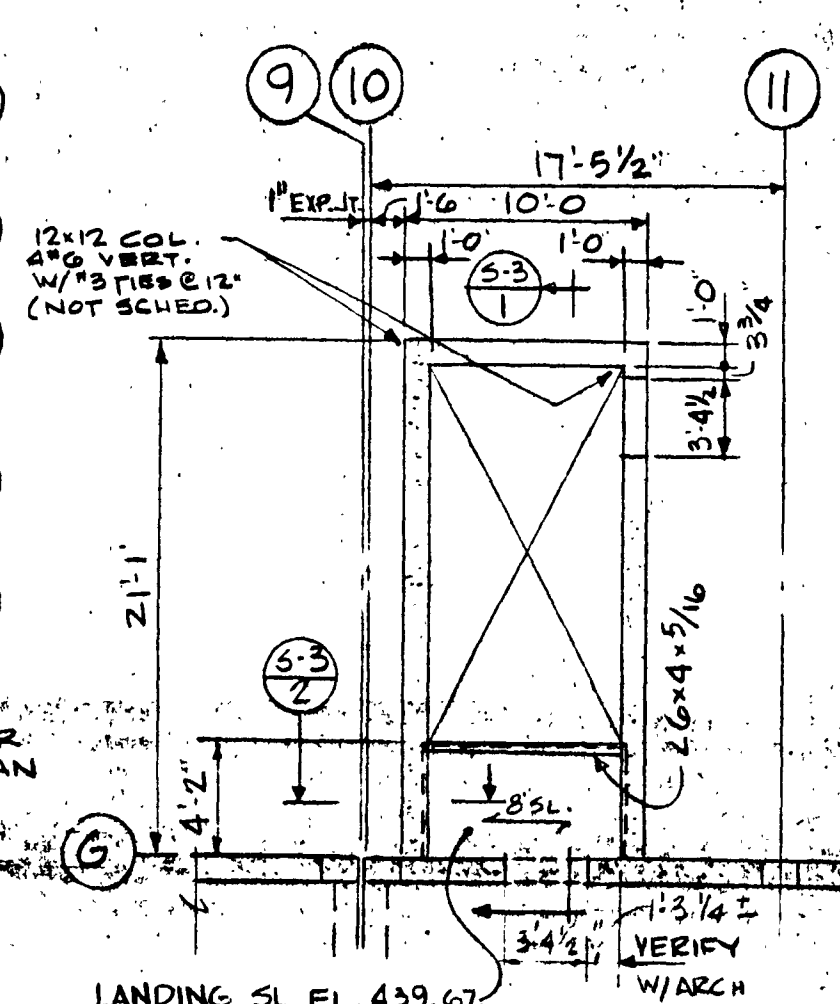

STAIR #3 LEVEL 1 PLAN
1/8" = 1'-0"

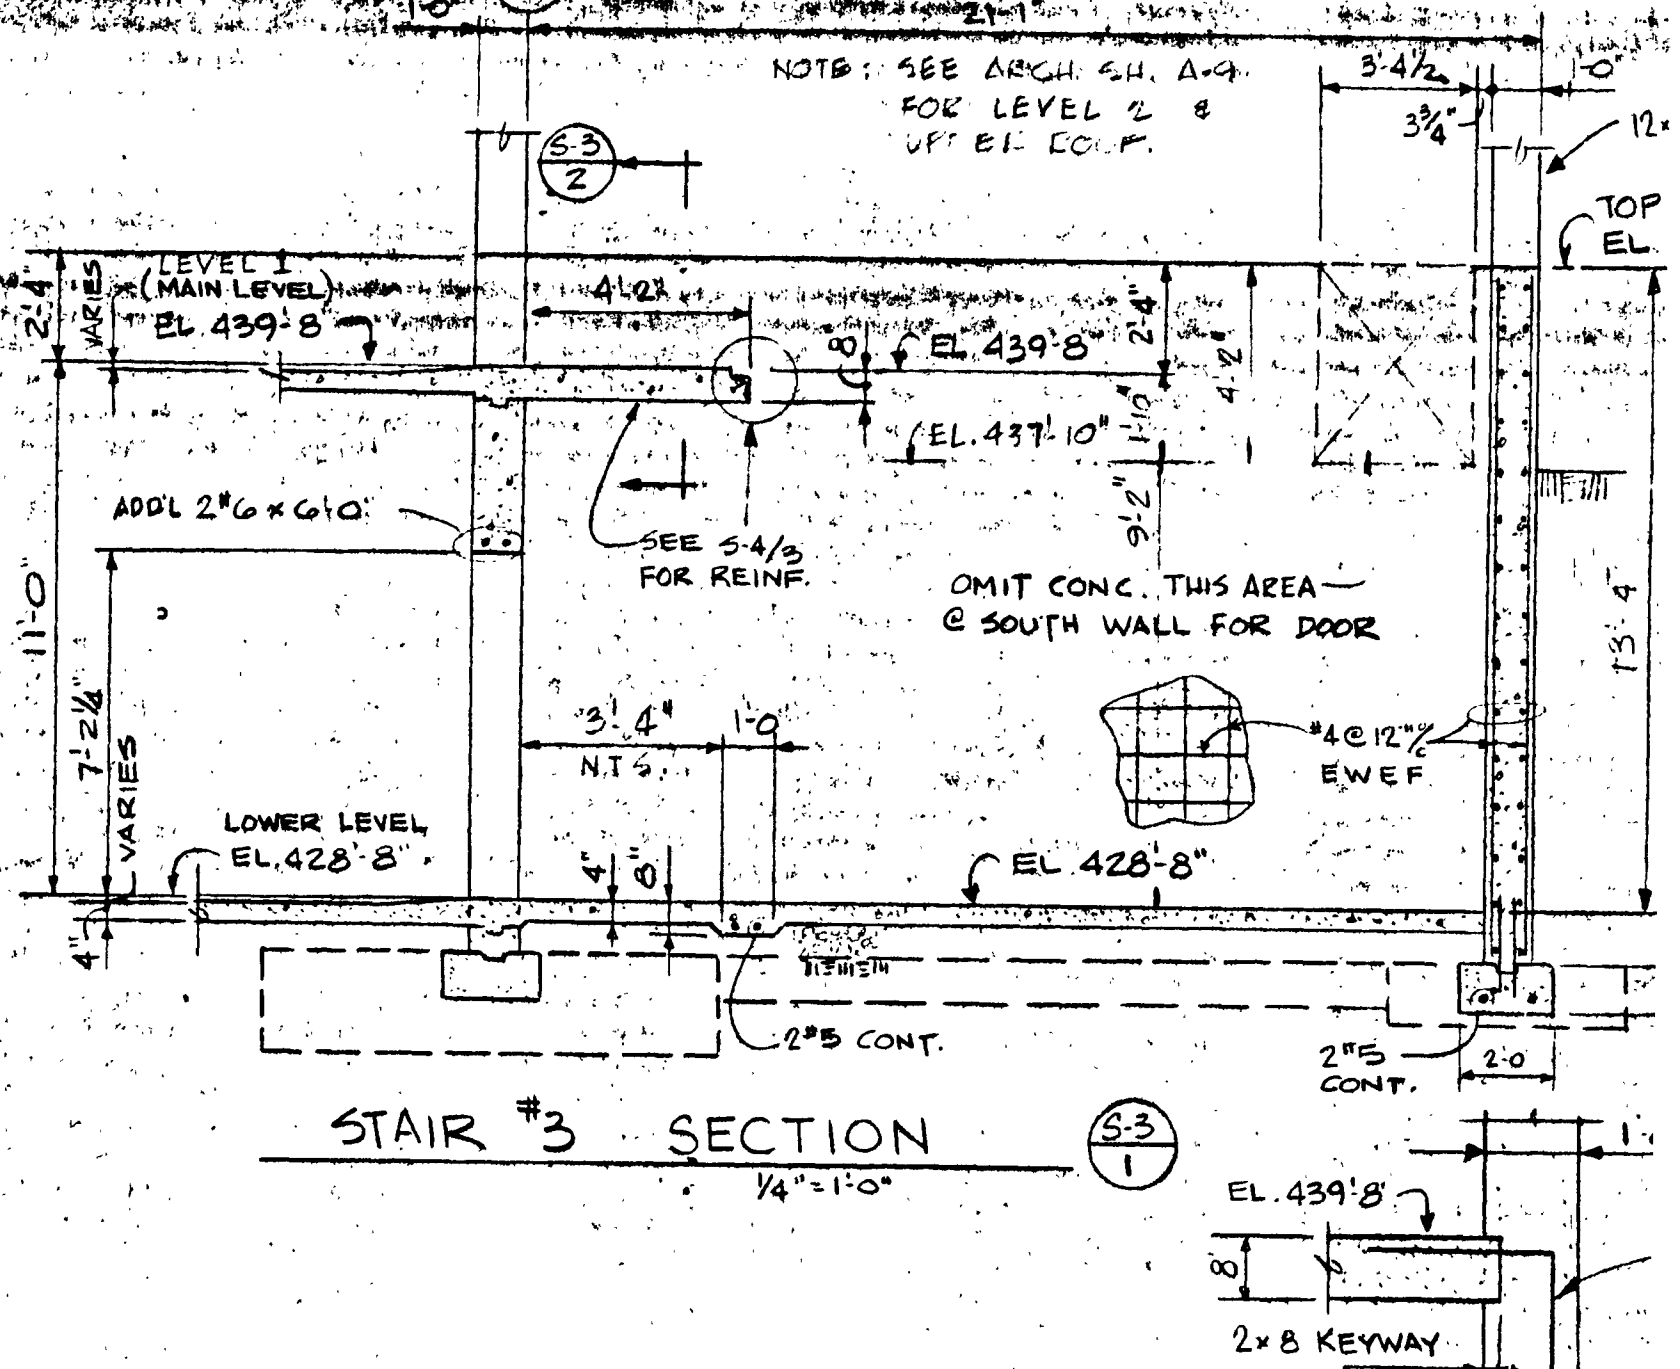

STAIR #3 SECTION
1/4" = 1'-0"

GRAY ROGERS MYERS & TORGAN

A DIVISION OF ELLERBE

- NOTES:
1. FLOOR EL. VARIES - SEE PLAN.
 2. VERIFY MECH. & ELECT. OPNG. SIZE W/ MECH. & ELECT. CONTRACTORS.
 3. SEE SHT. S-7 1/2 FOR RAMP CROSS SECTION.
 4. SEE SHT. S-11, 12, 13 FOR SHEAR WALL DET.
 5. SEE SHT. S-14 FOR RT GIRDER # SLAB DET.
 6. SEE SHT. S-15 FOR PRECAST (CONTR. OPT).
 7. SEE SHT. S-10 FOR R/C BM. & COL REIN.
 8. SEE SHT. S-4 FOR ADD'L SLAB REIN. (CL. II).
 9. FLOOR EL. SHOWN ON PLAN ARE TO TOP OF STRUCTURAL SLAB.
 10. SEE S-1 FOR TYP. SLAB CONSTR. JOINT.


ARCHITECTS • ENGINEERS • SURVEYORS
601 COLLEGE ROAD, FAIRBANKS, ALASKA 99701, PHONE: 452-1241

STATE OF ALASKA
DEPT. OF PUBLIC WORKS
DIVISION OF BUILDINGS
JUNEAU ALASKA

FAIRBANKS PARKING STRUCTURE






DBA - 2 - 0130
FAIRBANKS, AK.

PETER KIEWIT SONS CO.
FAIRBANKS ALASKA
RECOMMENDED BY
DATE: AS-BLT
SHEET 23 OF 30

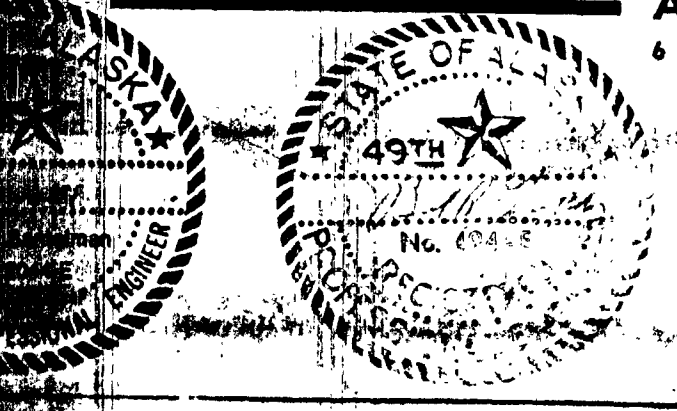

GRAY ROGERS MYERS & MORGAN

A DIVISION OF ELLERBE

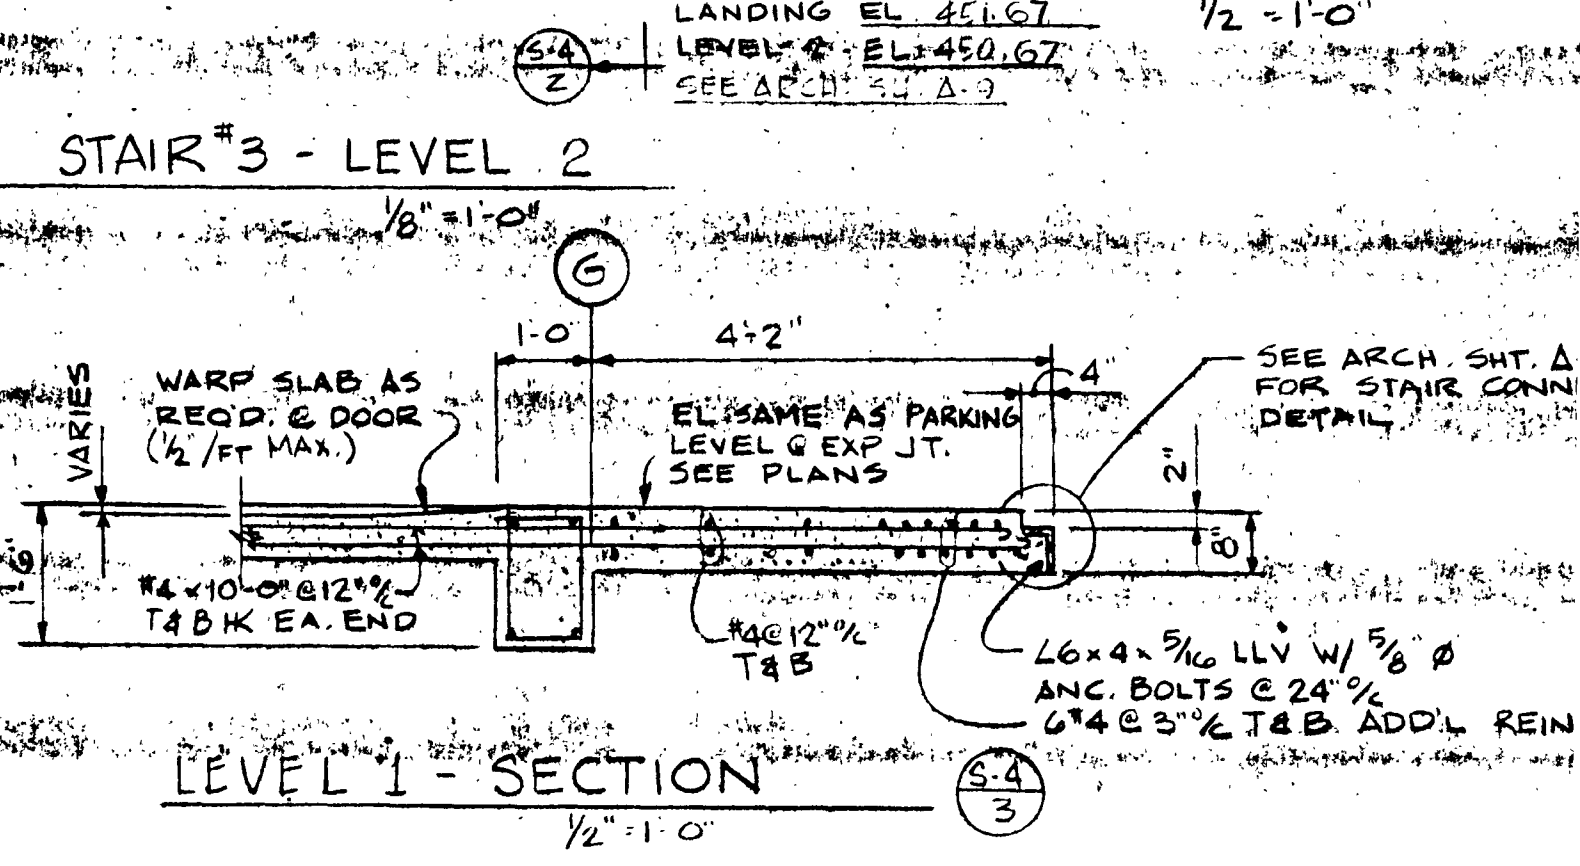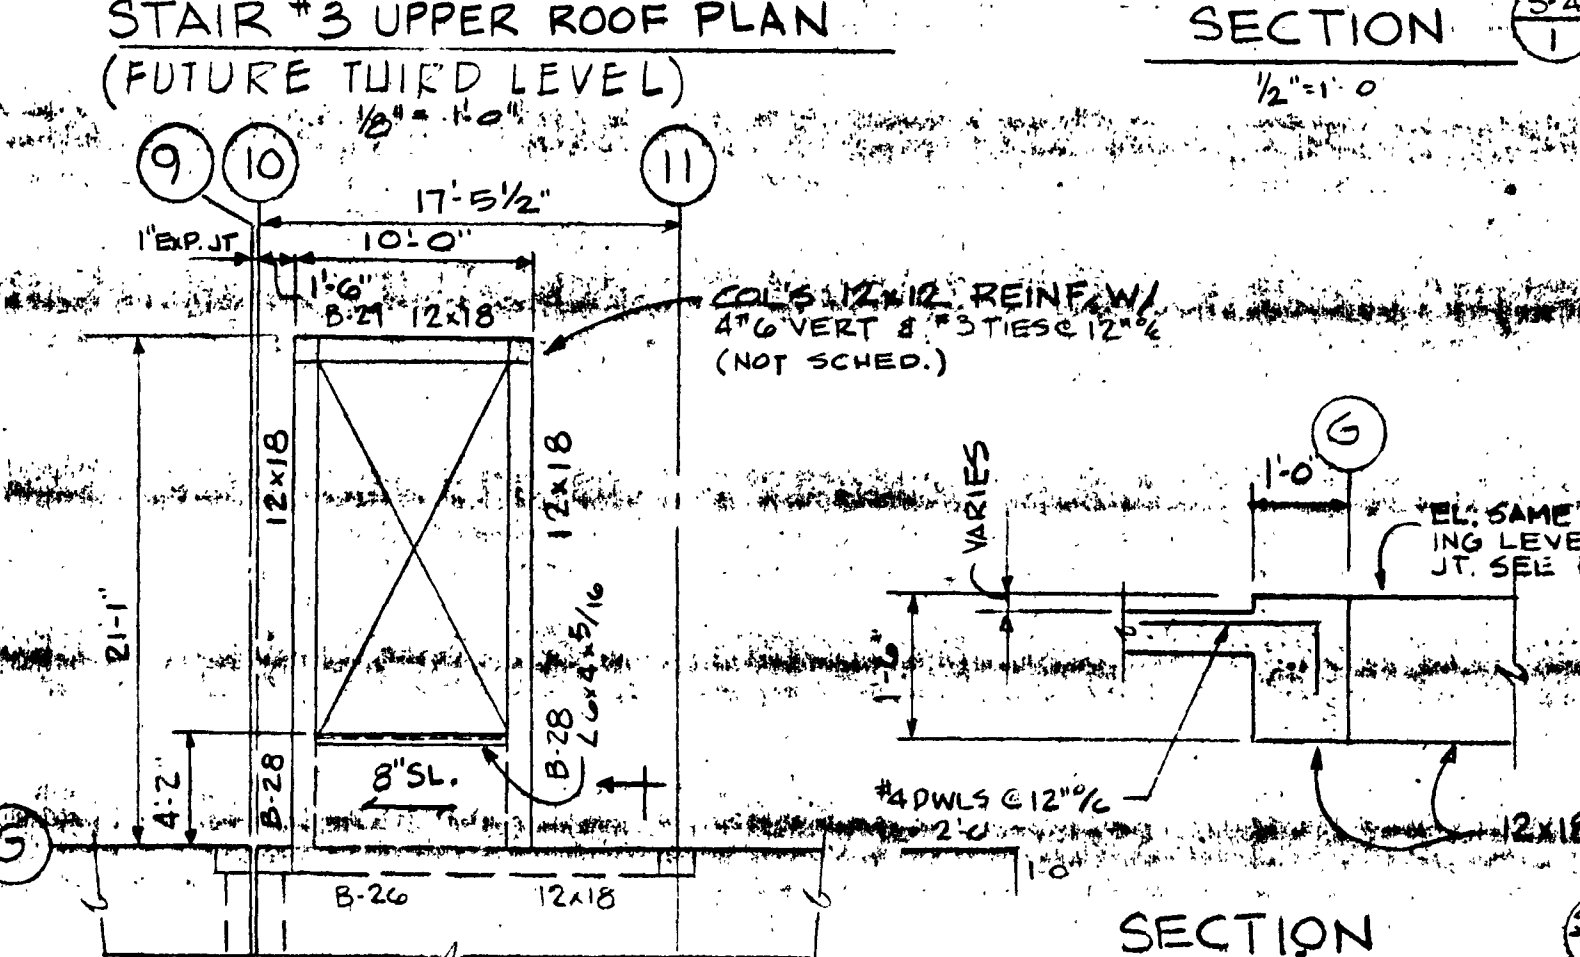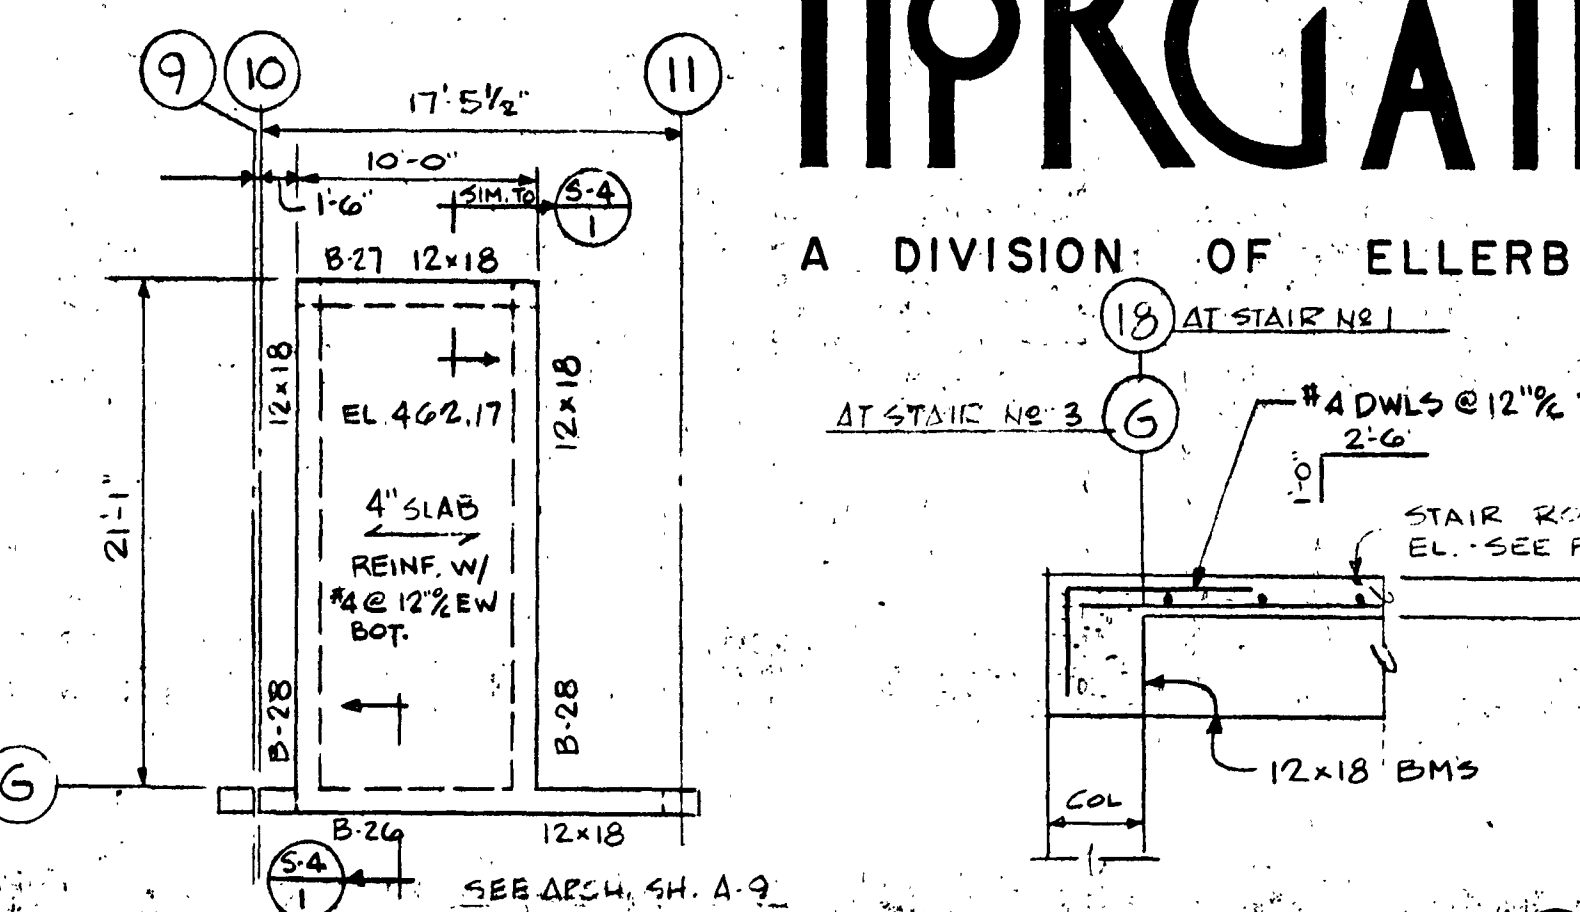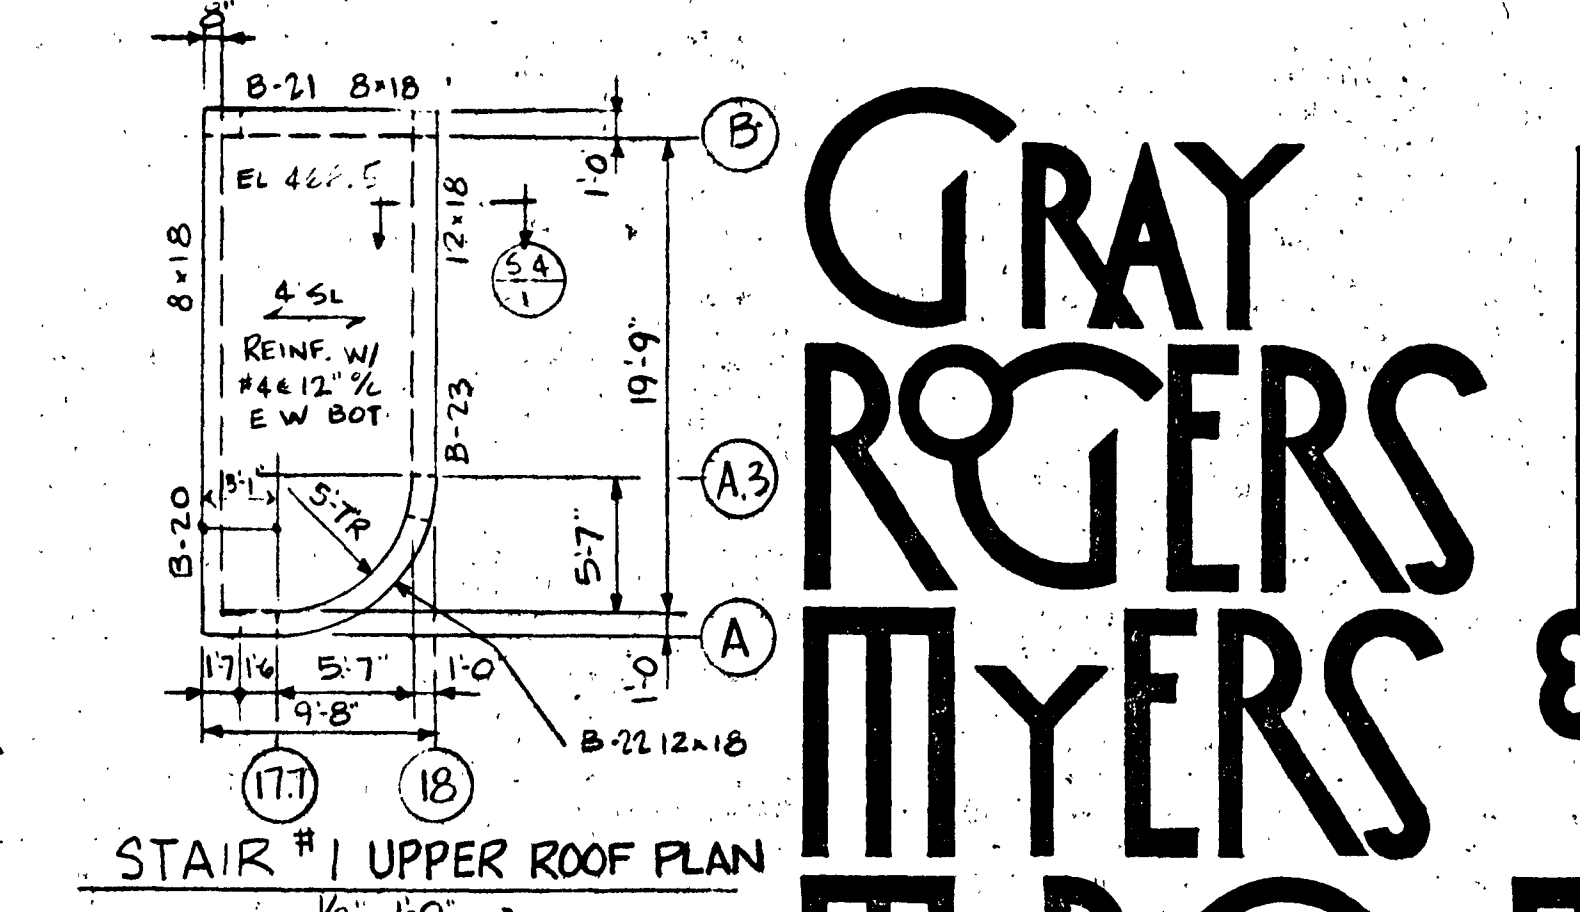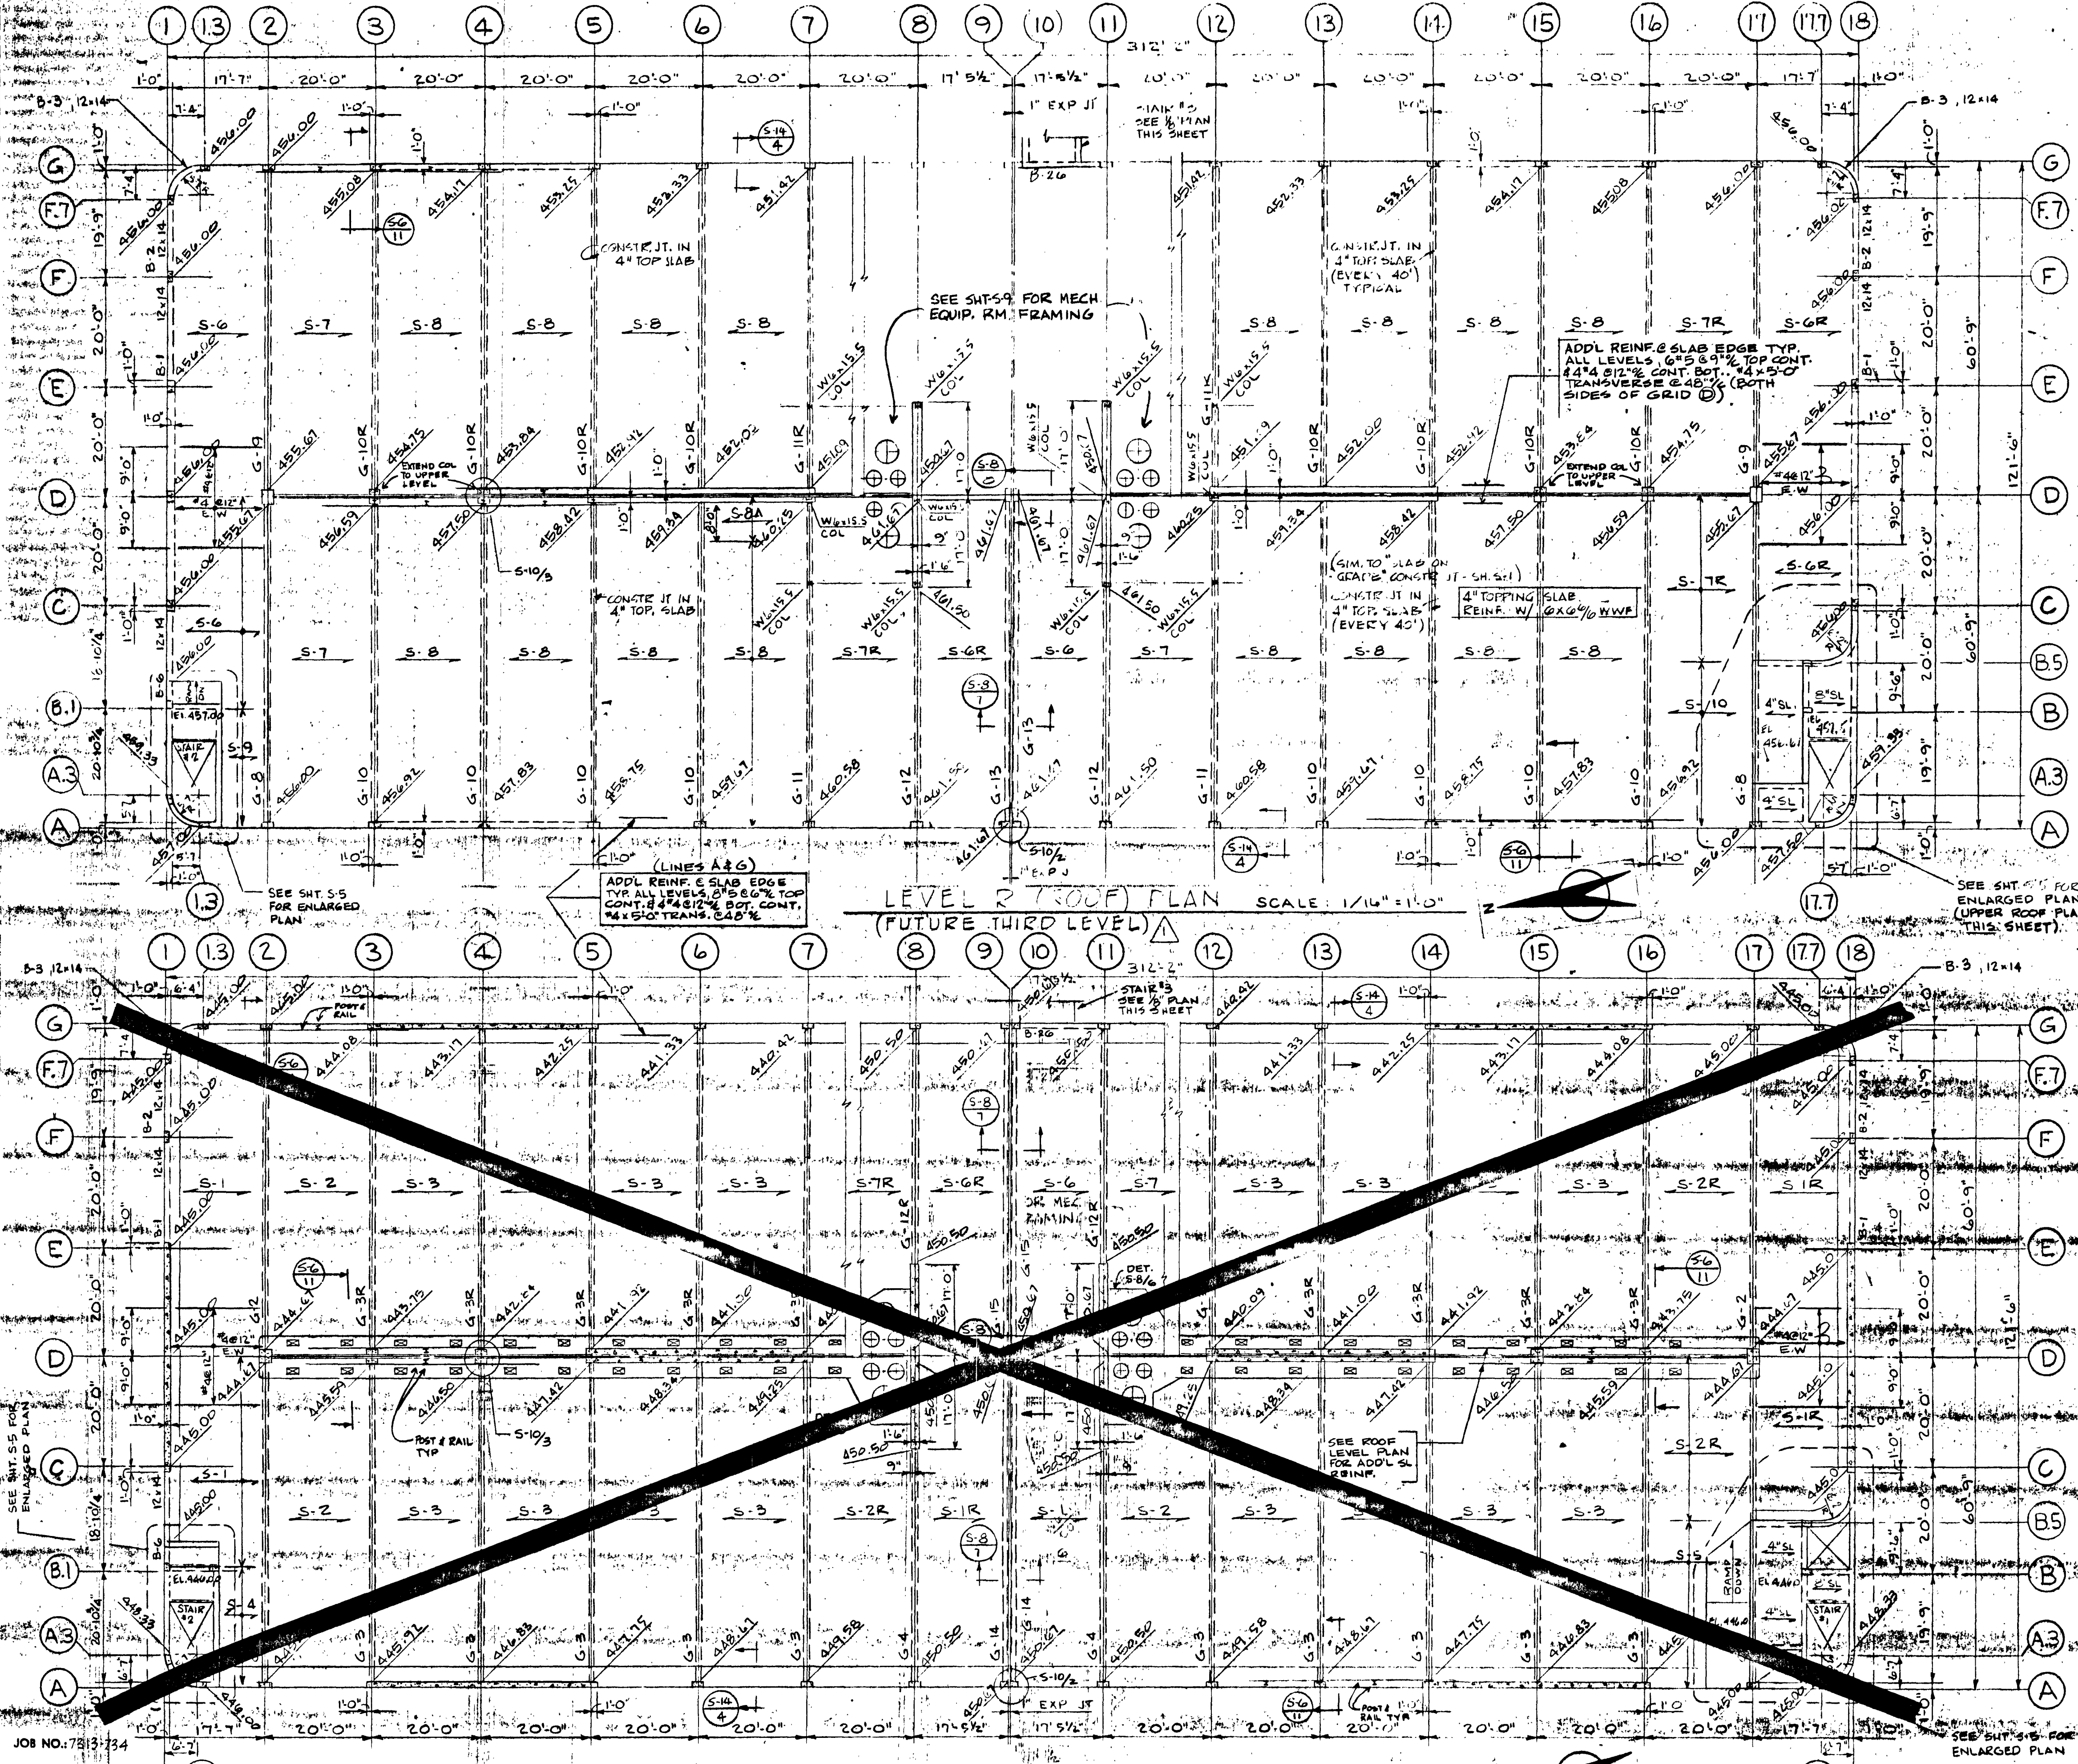





NOTES:
 1. FLOOR EL. VARIES - SEE PLAN
 2. VERIFY MECH. & ELECT. PPGNG. SIZE
 3. SEE NOTES ON SHT. S-3

ARCHITECTS • ENGINEERS • SURVEYORS
 601 COLLEGE ROAD, FAIRBANKS, ALASKA 99701, PHONE: 452-1241


STATE OF ALASKA
 DEPT. OF PUBLIC WORKS
 DIVISION OF BUILDINGS
 JUNEAU ALASKA

FAIRBANKS PARKING STRUCTURE
 DBA - 2 - 0130
 FAIRBANKS, AK.


REIN. MFG. CO. CO.		S-4
FAIRBANKS	ALASKA	
REVISIONS	DATE	AS-BLT
DATE		SHEET 24 OF 20

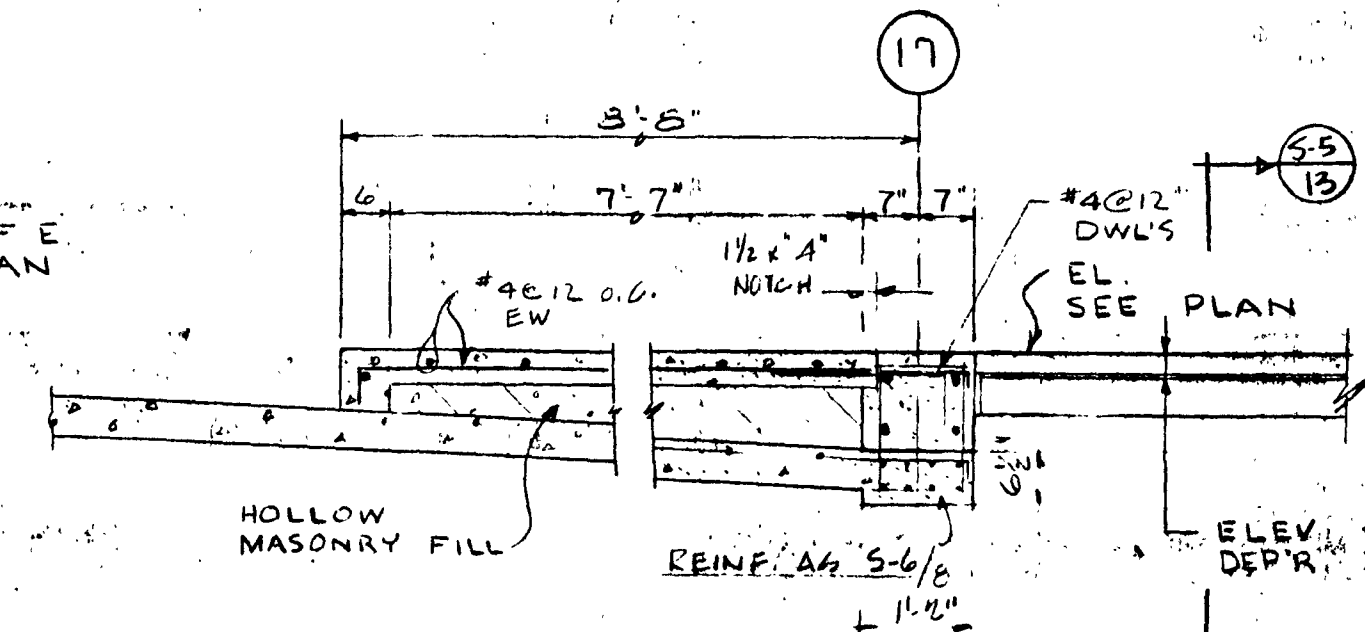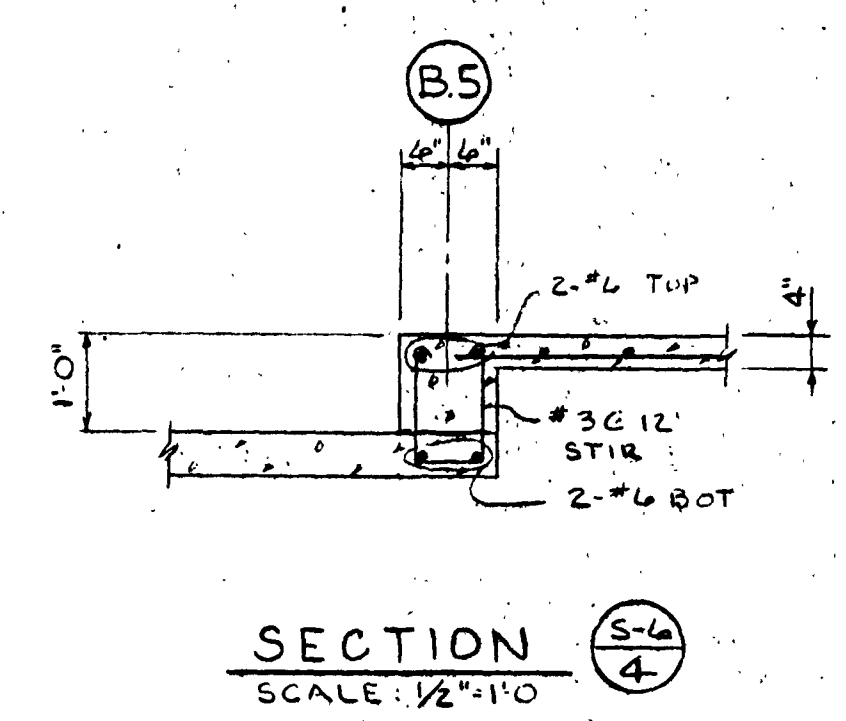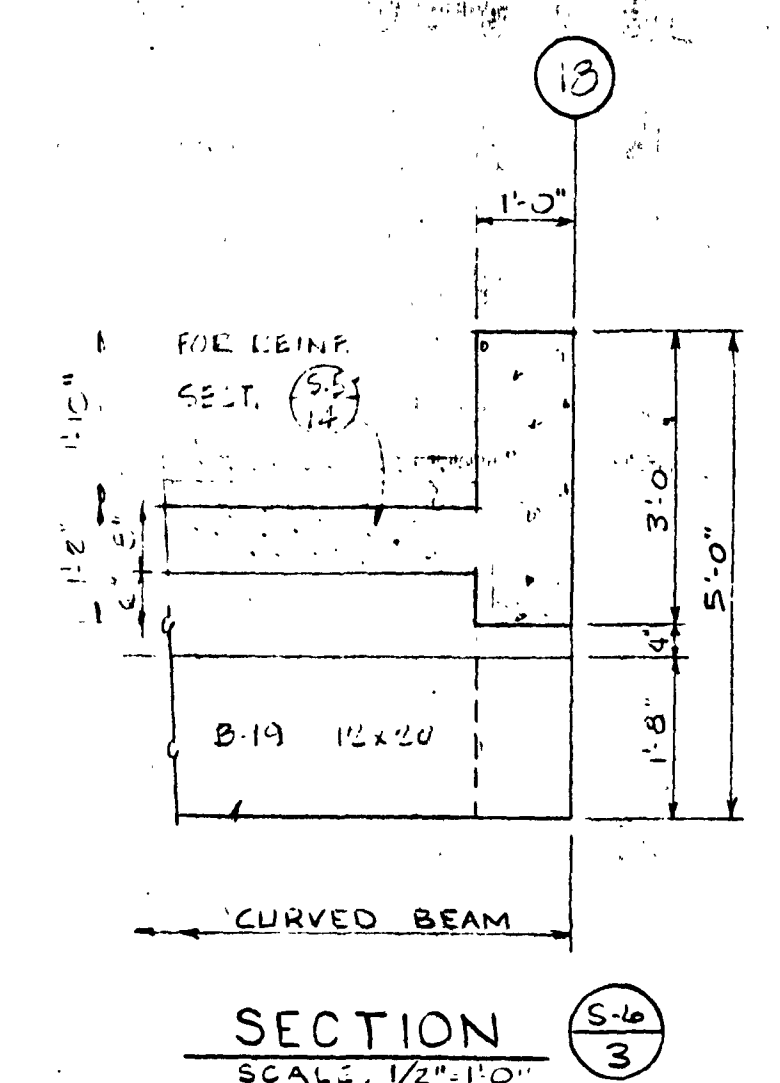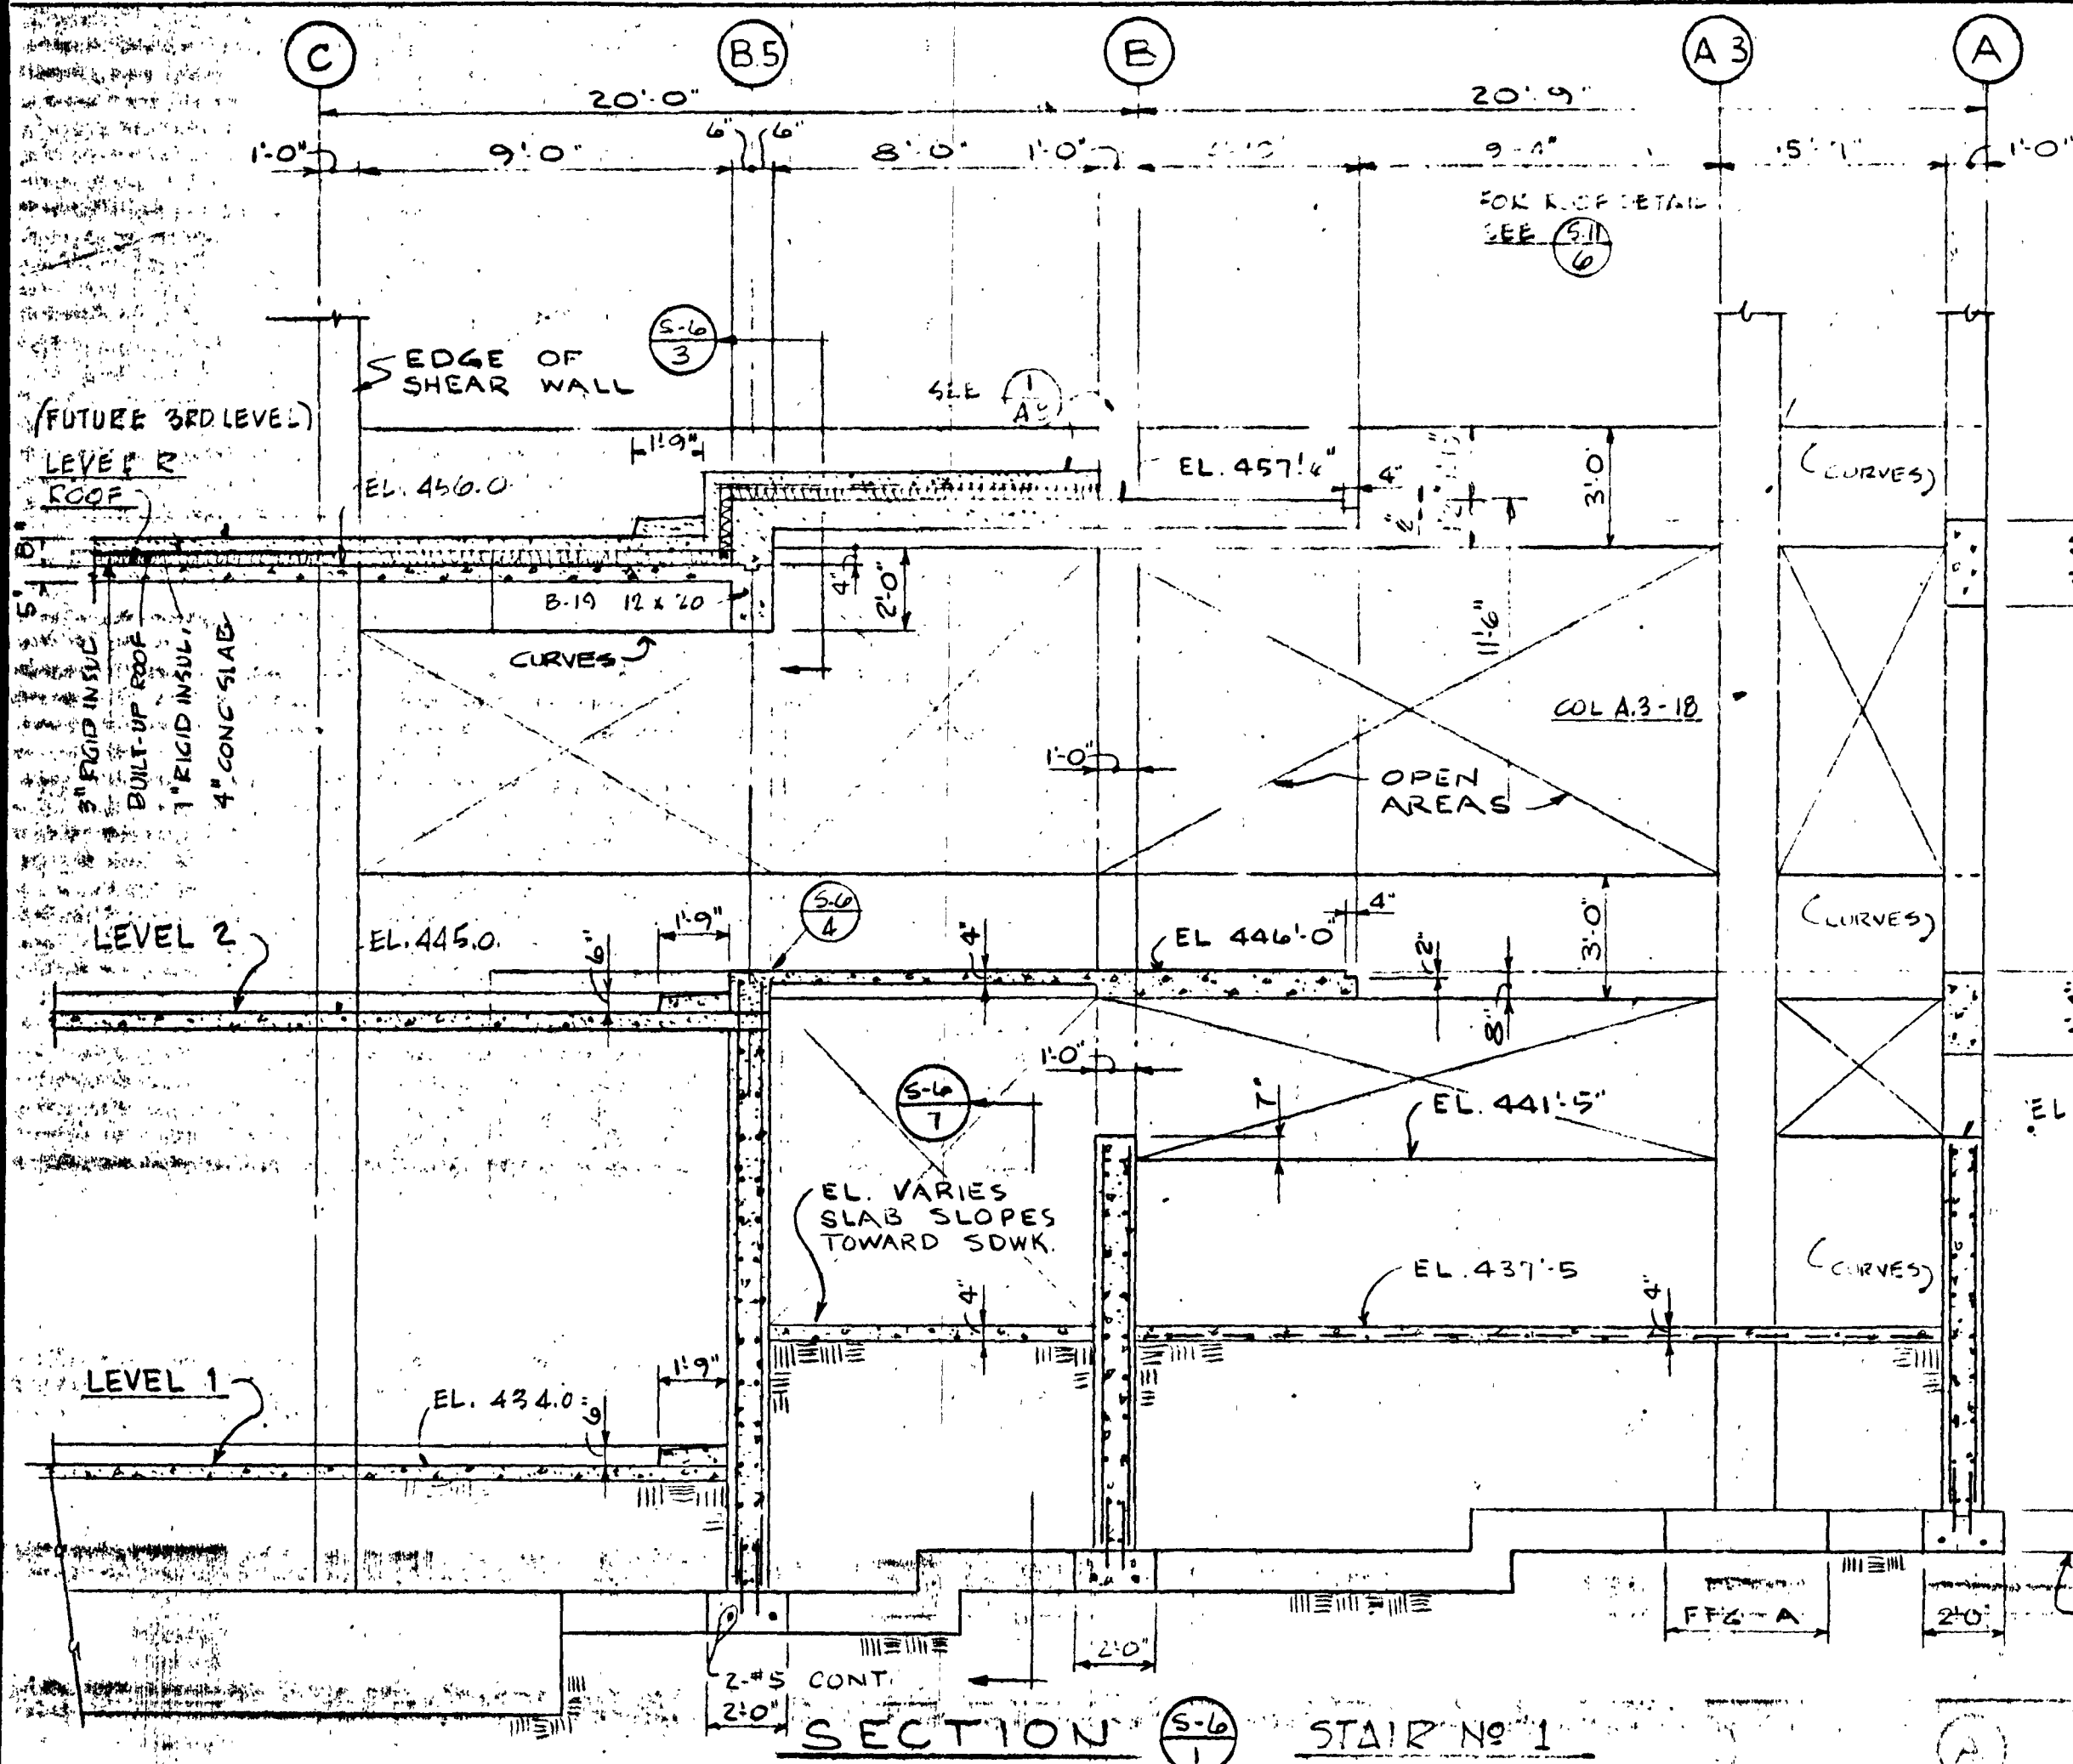


SECTION S-6/5 DELETED
SCALE: 1/2"=1'-0"

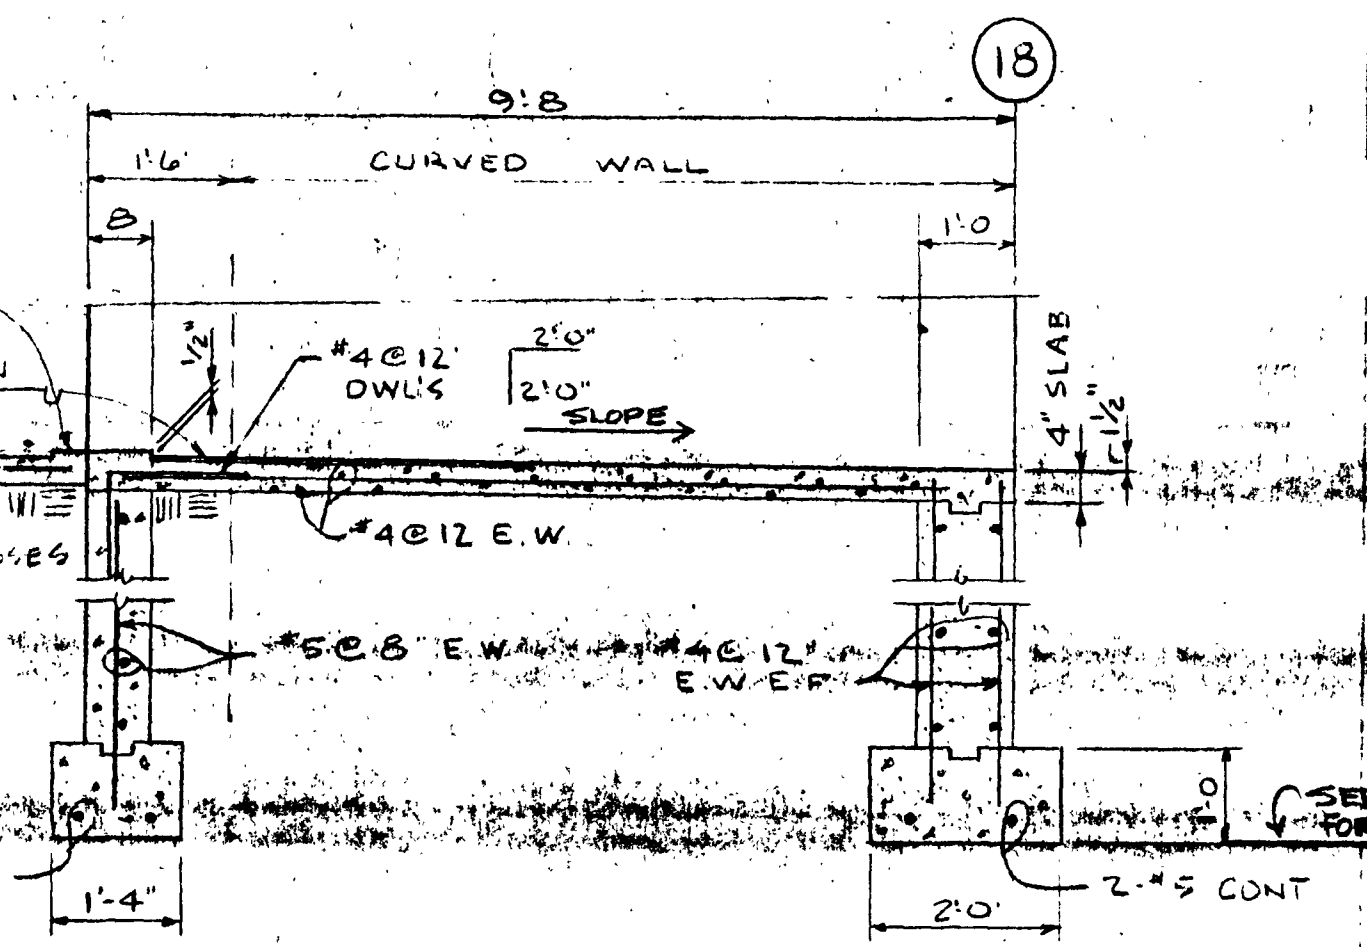


SECTION S-6/6
SCALE: 1/2"=1'-0"
LEVEL 2

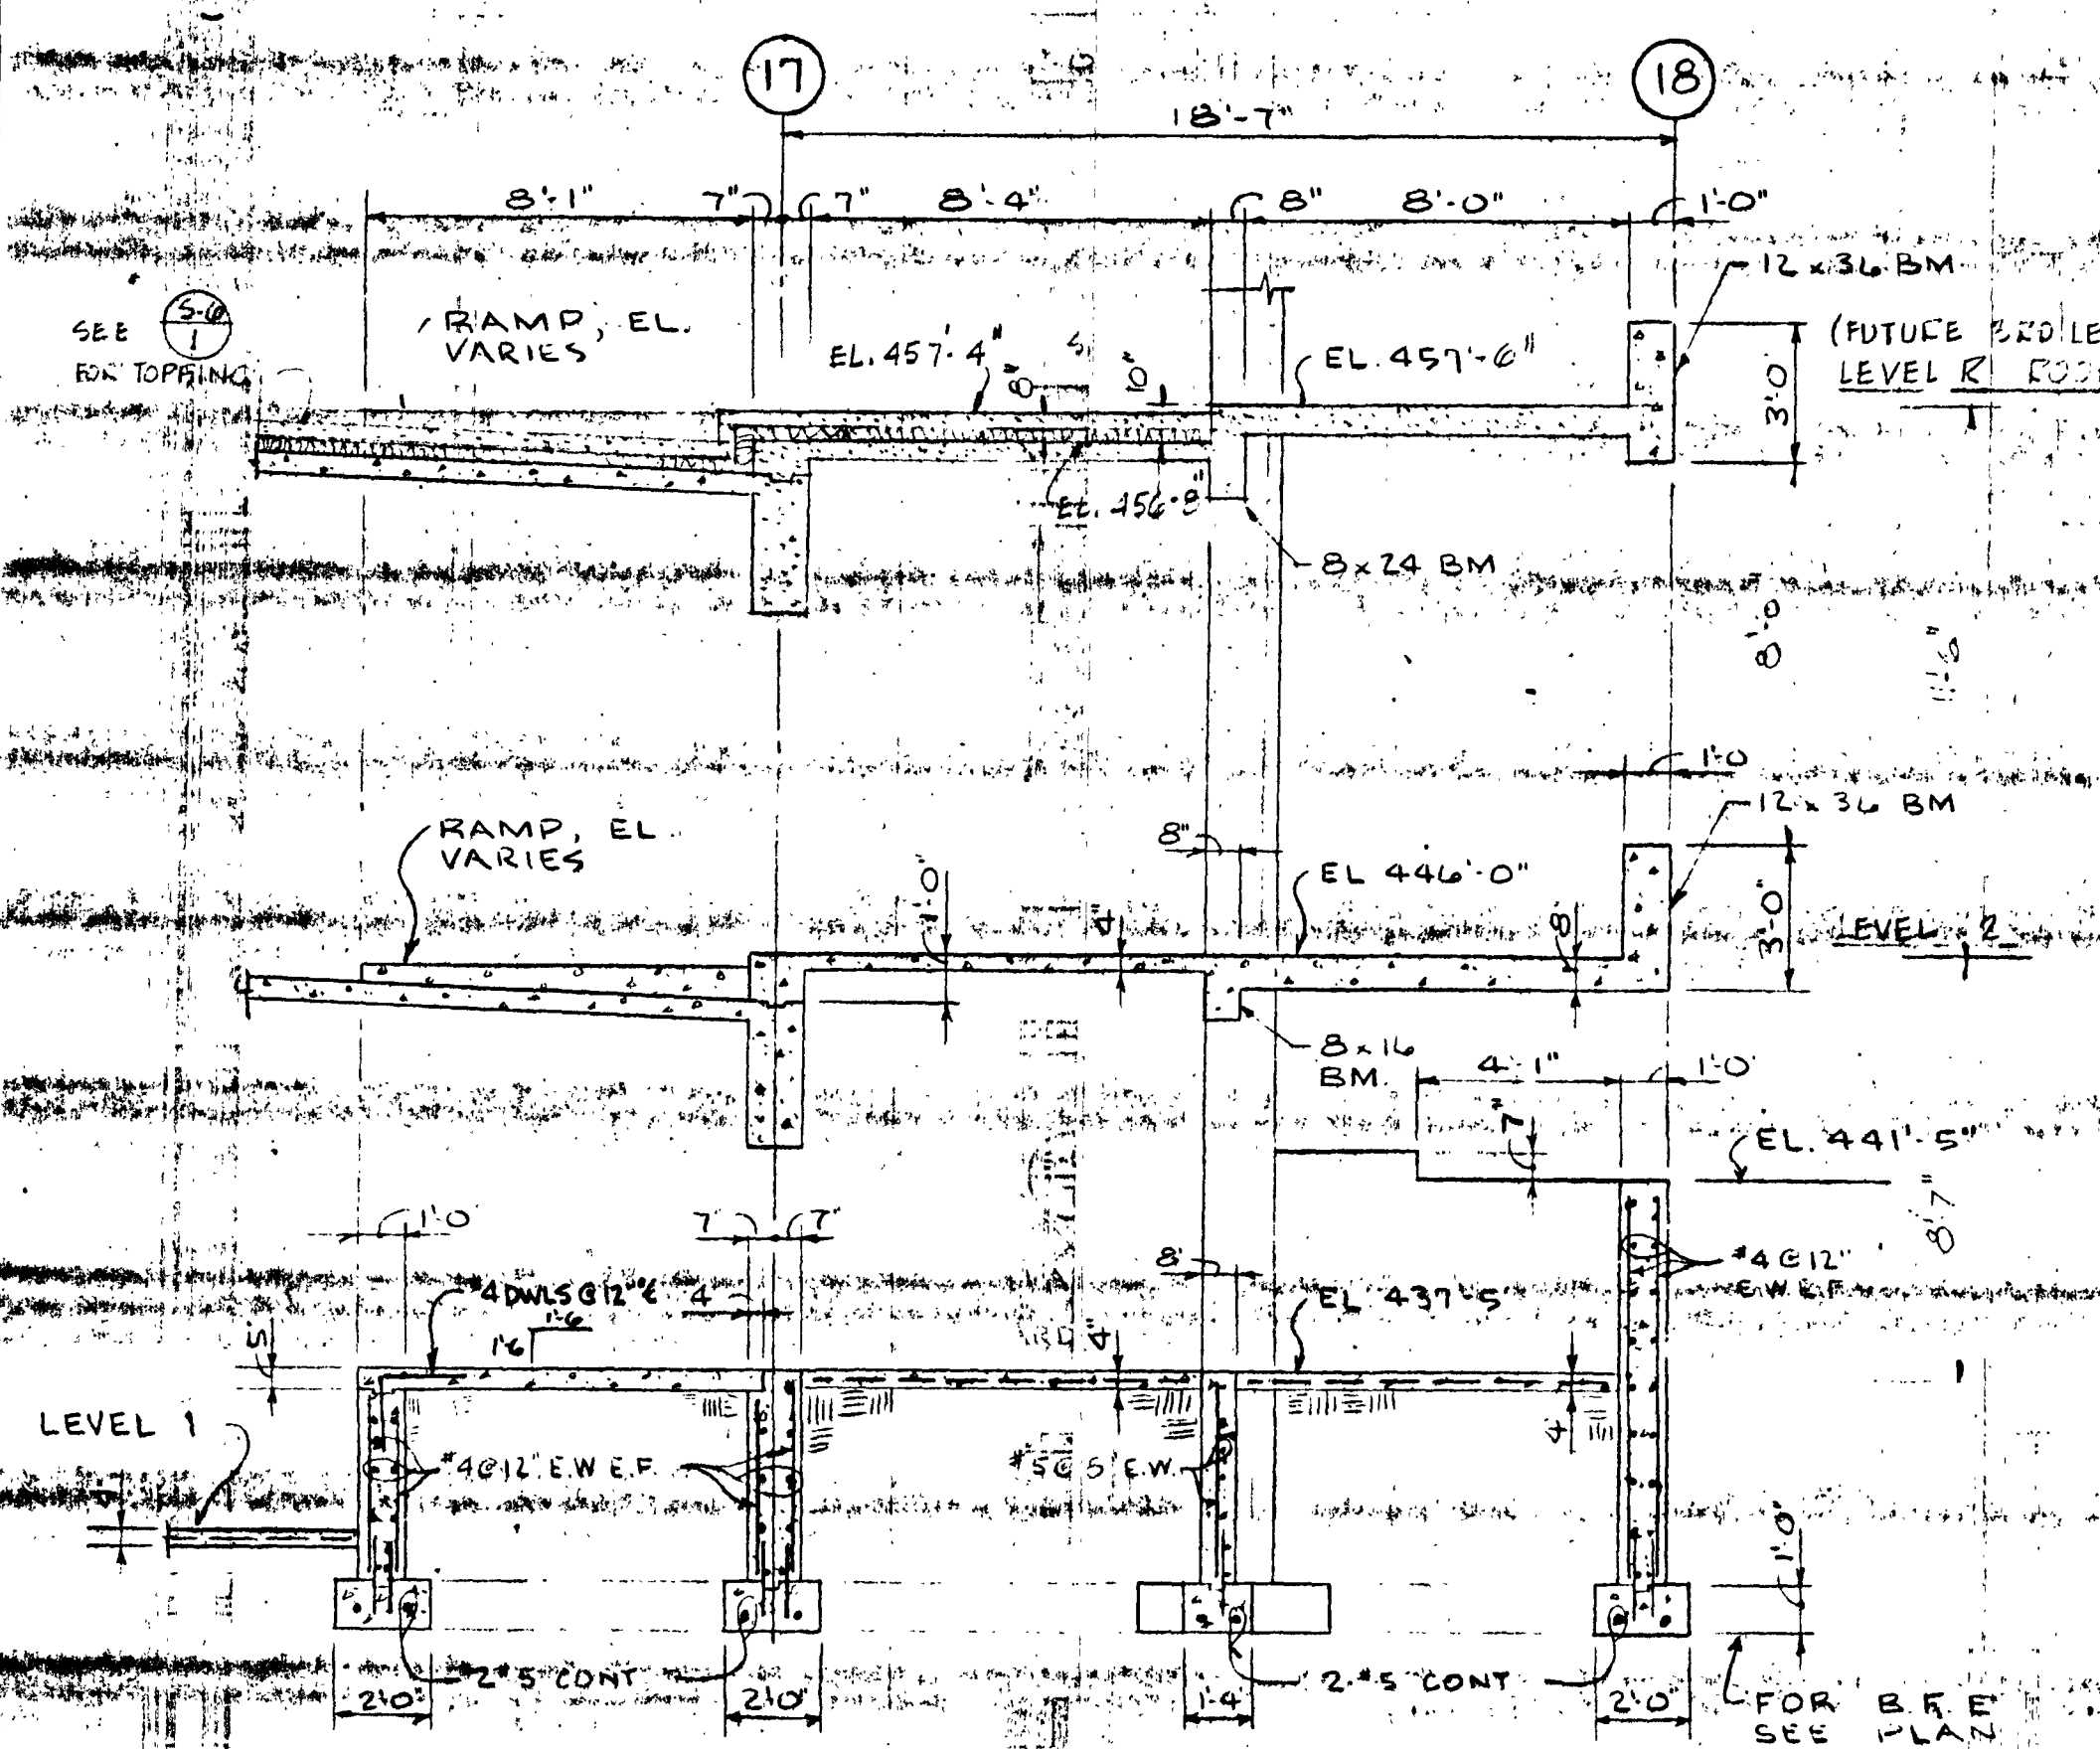


SECTION S-6/7
SCALE: 1/4"=1'-0"
STAIR No. 1

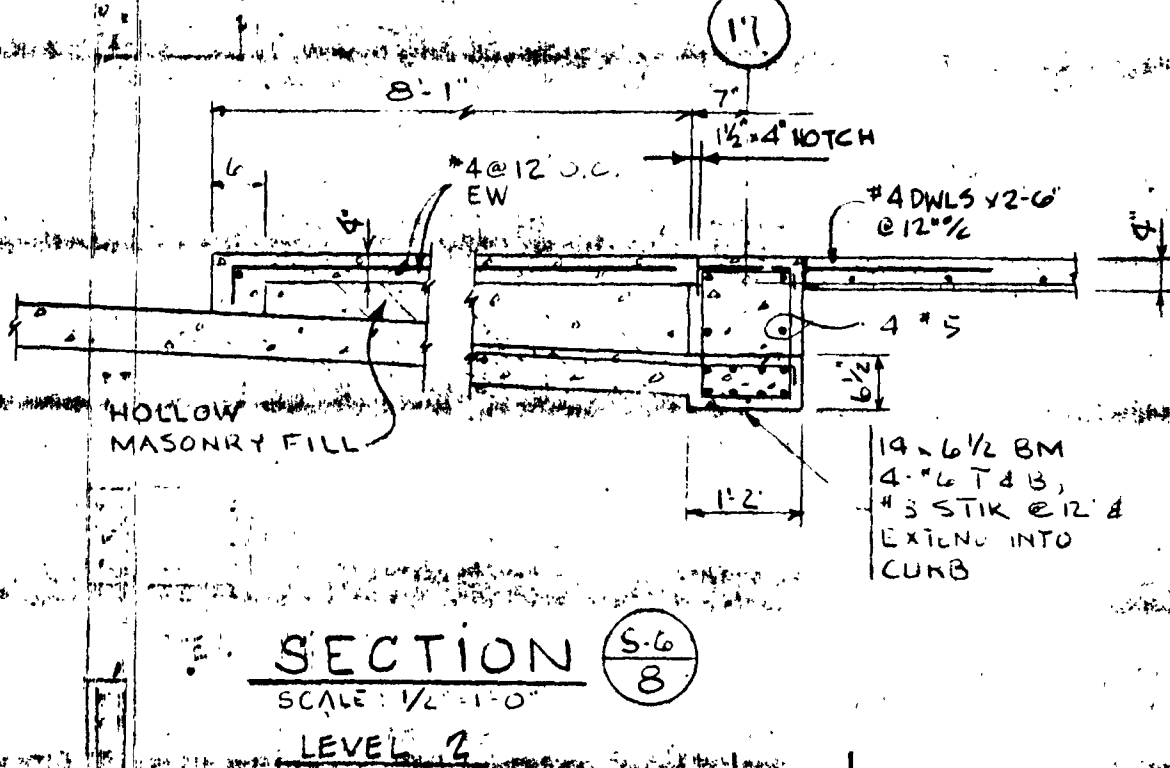

SECTION S-6/8
SCALE: 1/2"=1'-0"
LEVEL 2

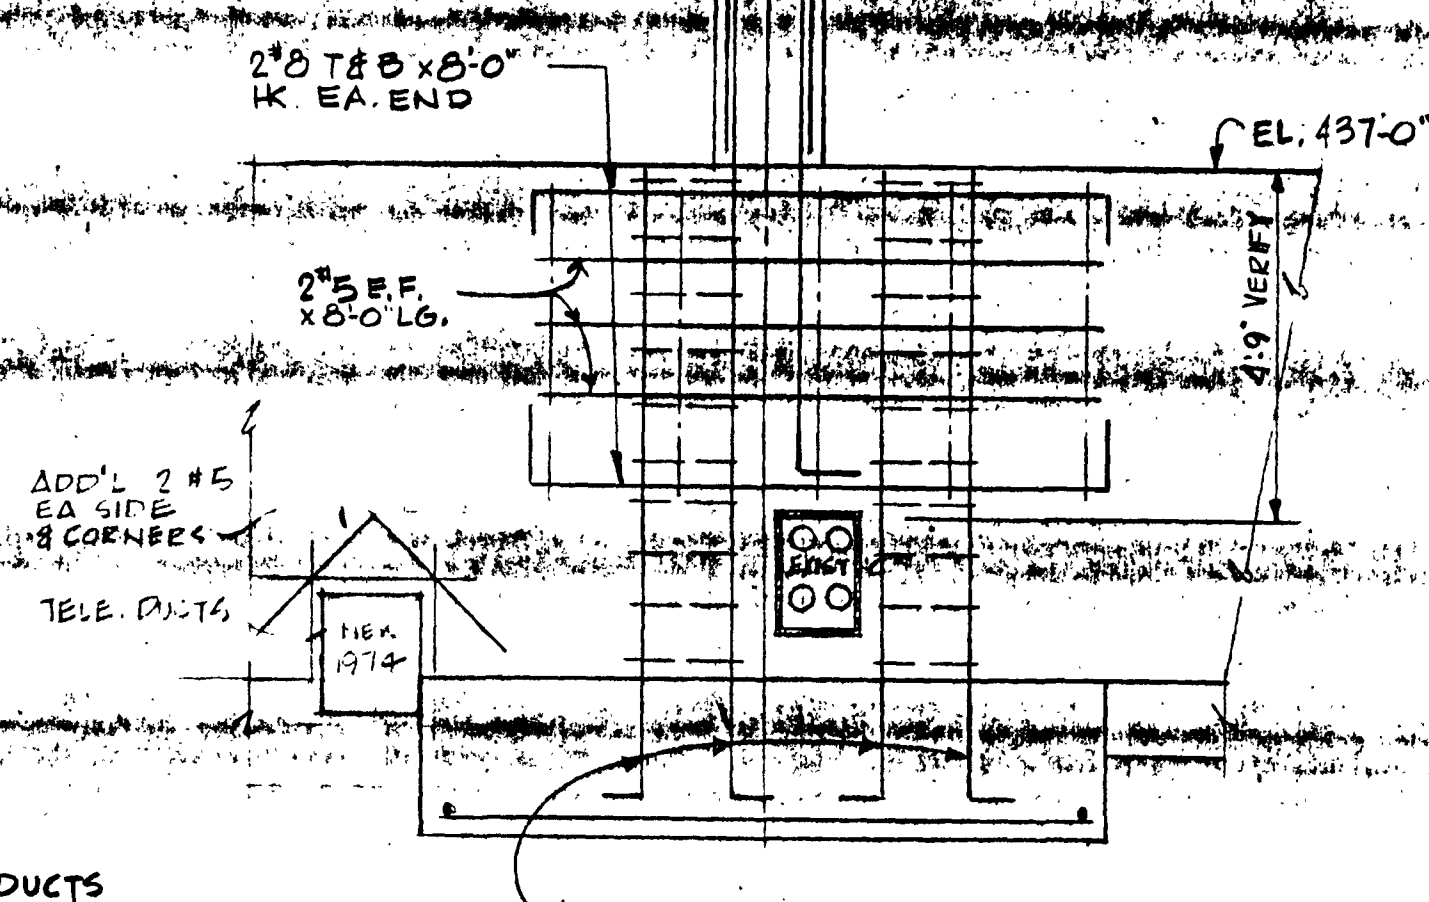

SECTION S-6/9
SCALE: 3/8"=1'-0"

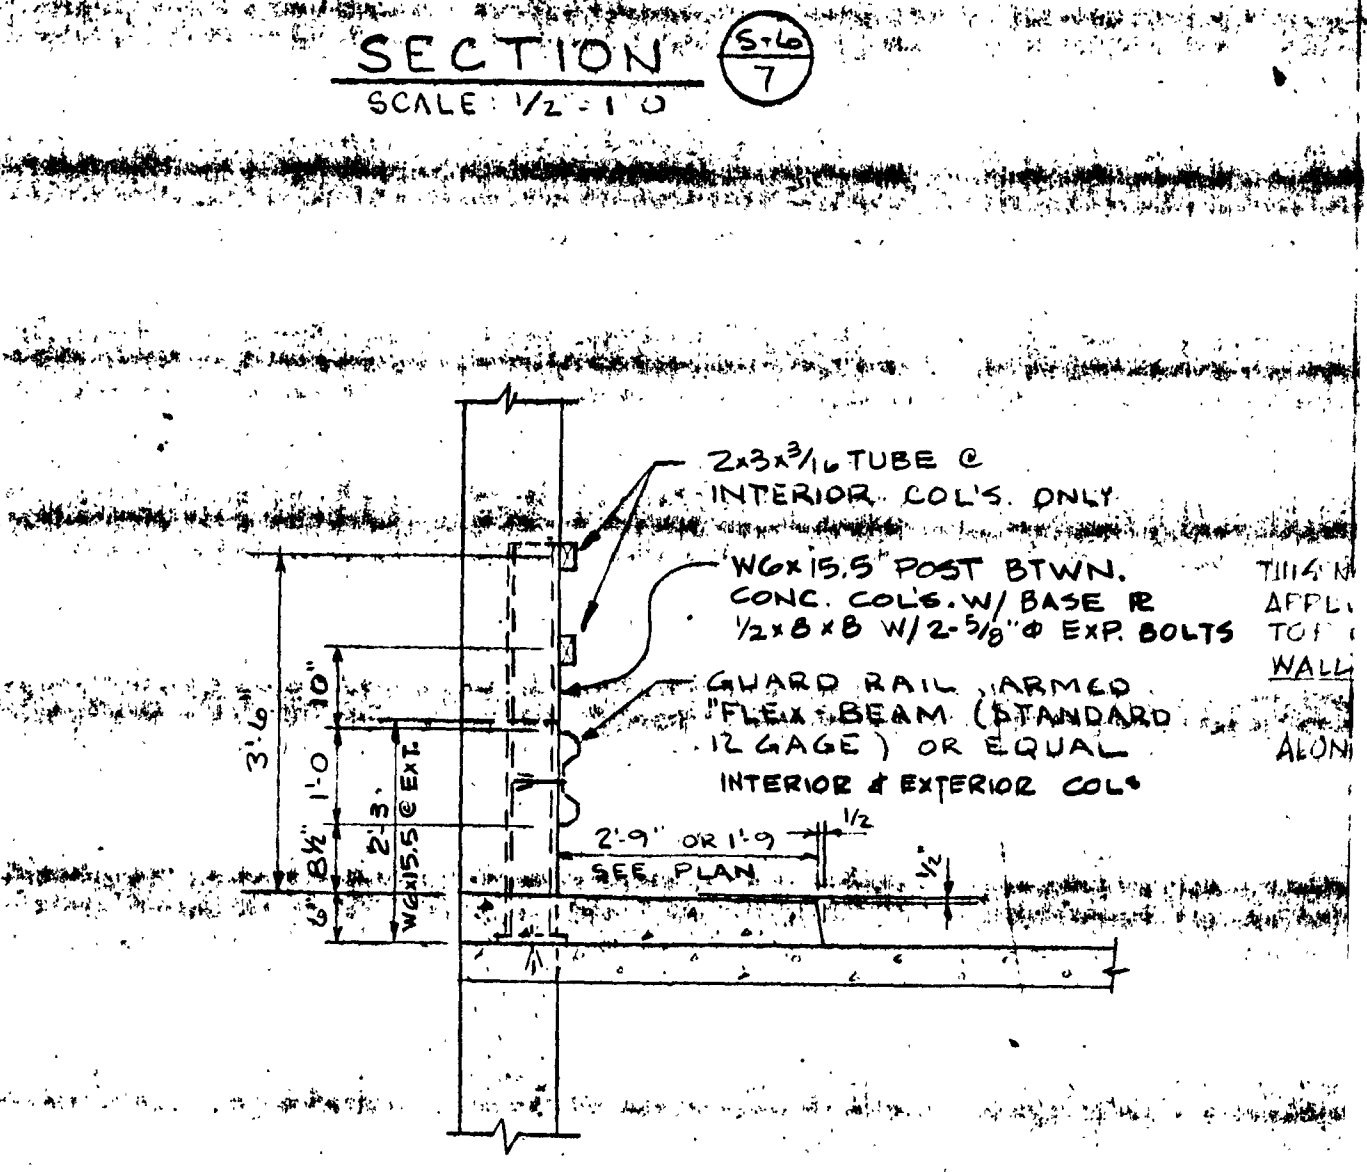

SECTION S-6/10
SCALE: 1/2"=1'-0"

JOB NO: 7313-734
DATE: 6-21-74

ARCHITECTS • ENGINEERS • SURVEYORS
601 COLLEGE ROAD, FAIRBANKS, ALASKA 99701, PHONE: 452-1241

STATE OF ALASKA
DEPT. OF PUBLIC WORKS
DIVISION OF BUILDINGS
JUNEAU ALASKA











FAIRBANKS PARKING STRUCTURE
FAIRBANKS, AK.

STAIR No. 1 SECTIONS AND DET.

S-E

SHEET 26 0

A DIVISION OF ELLERBE

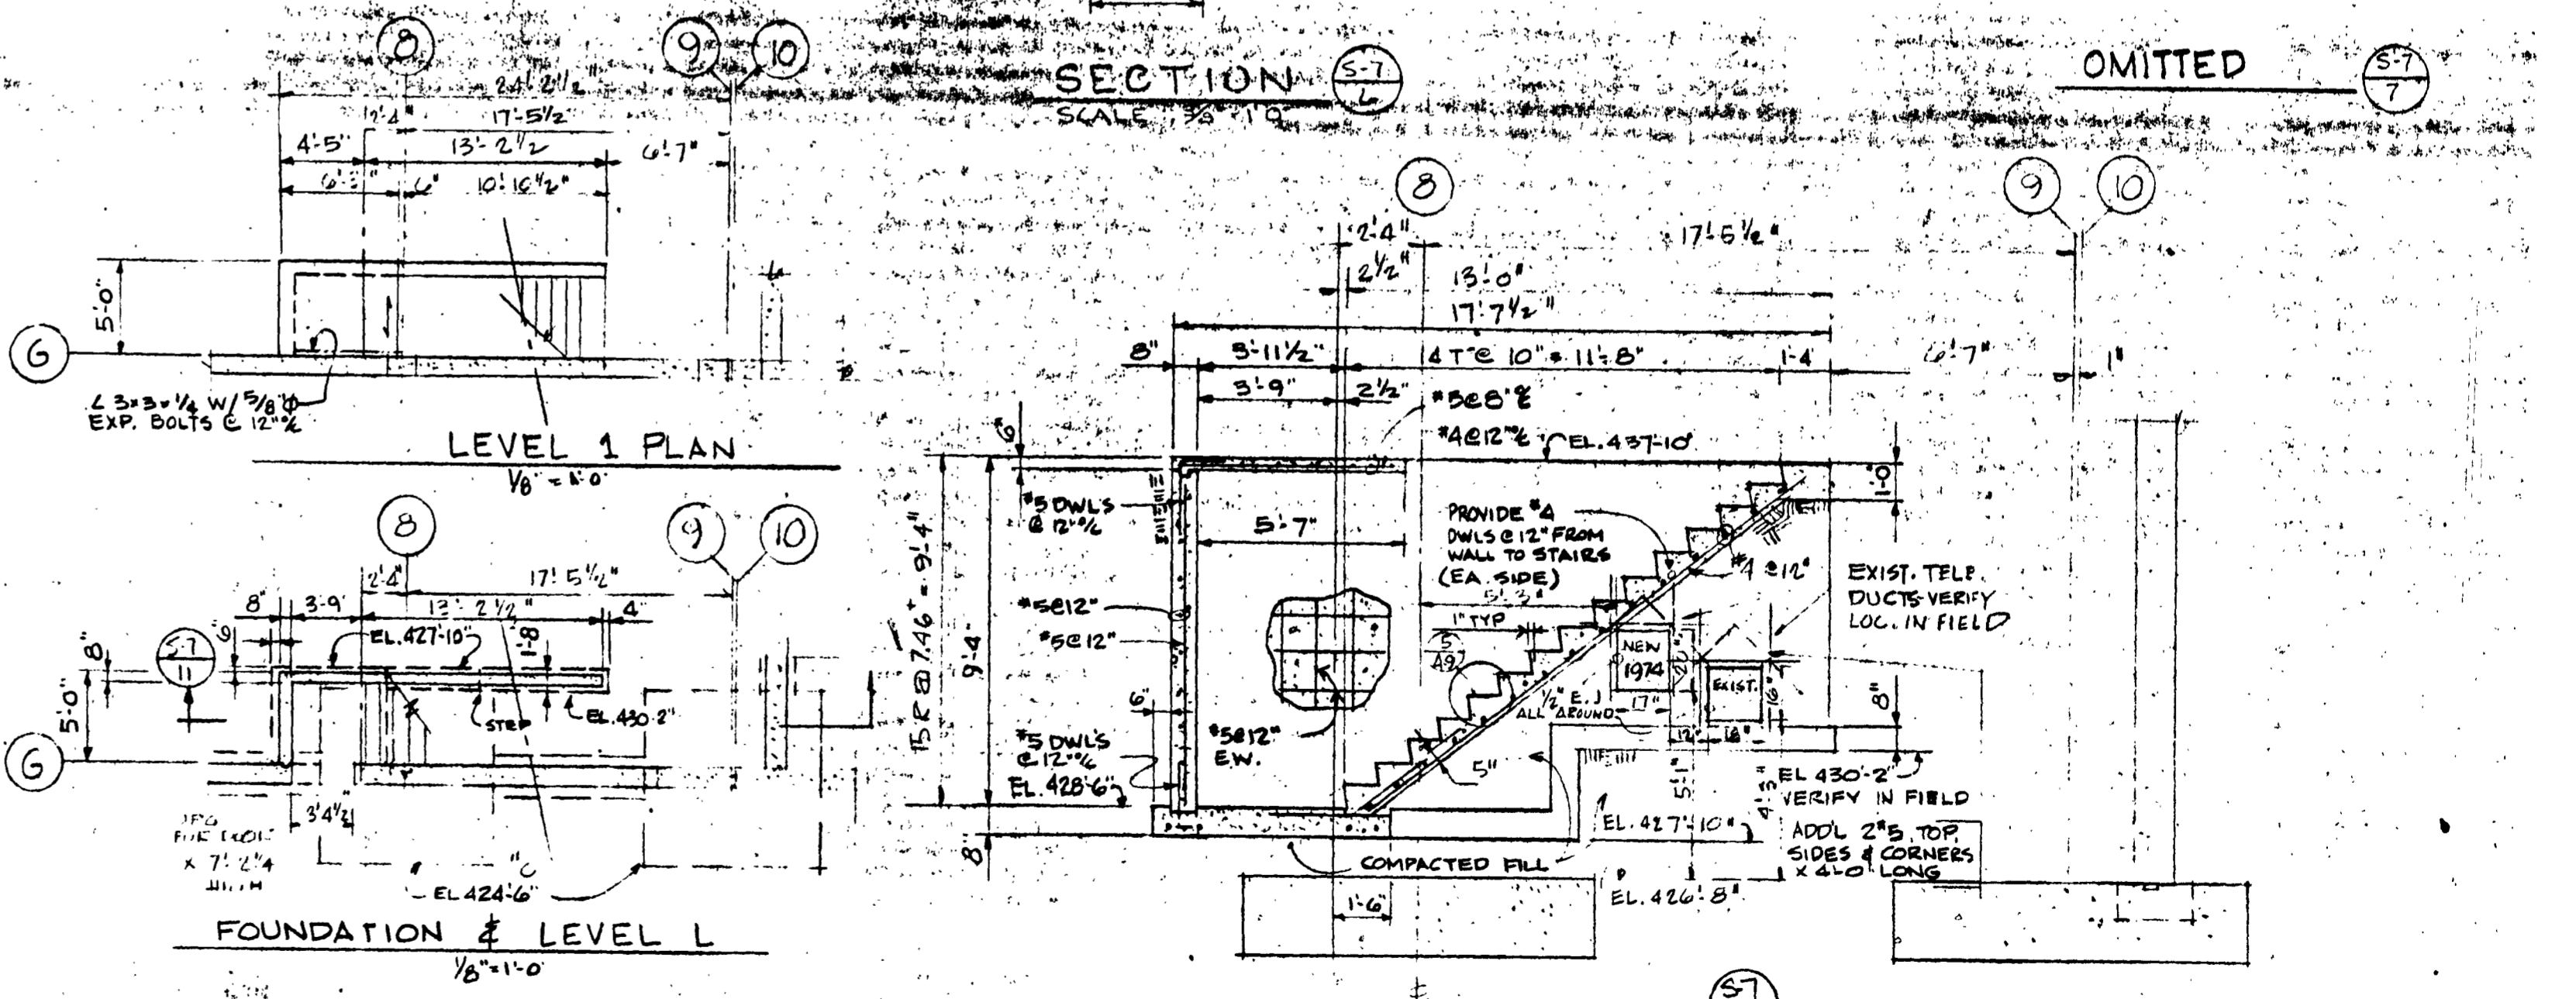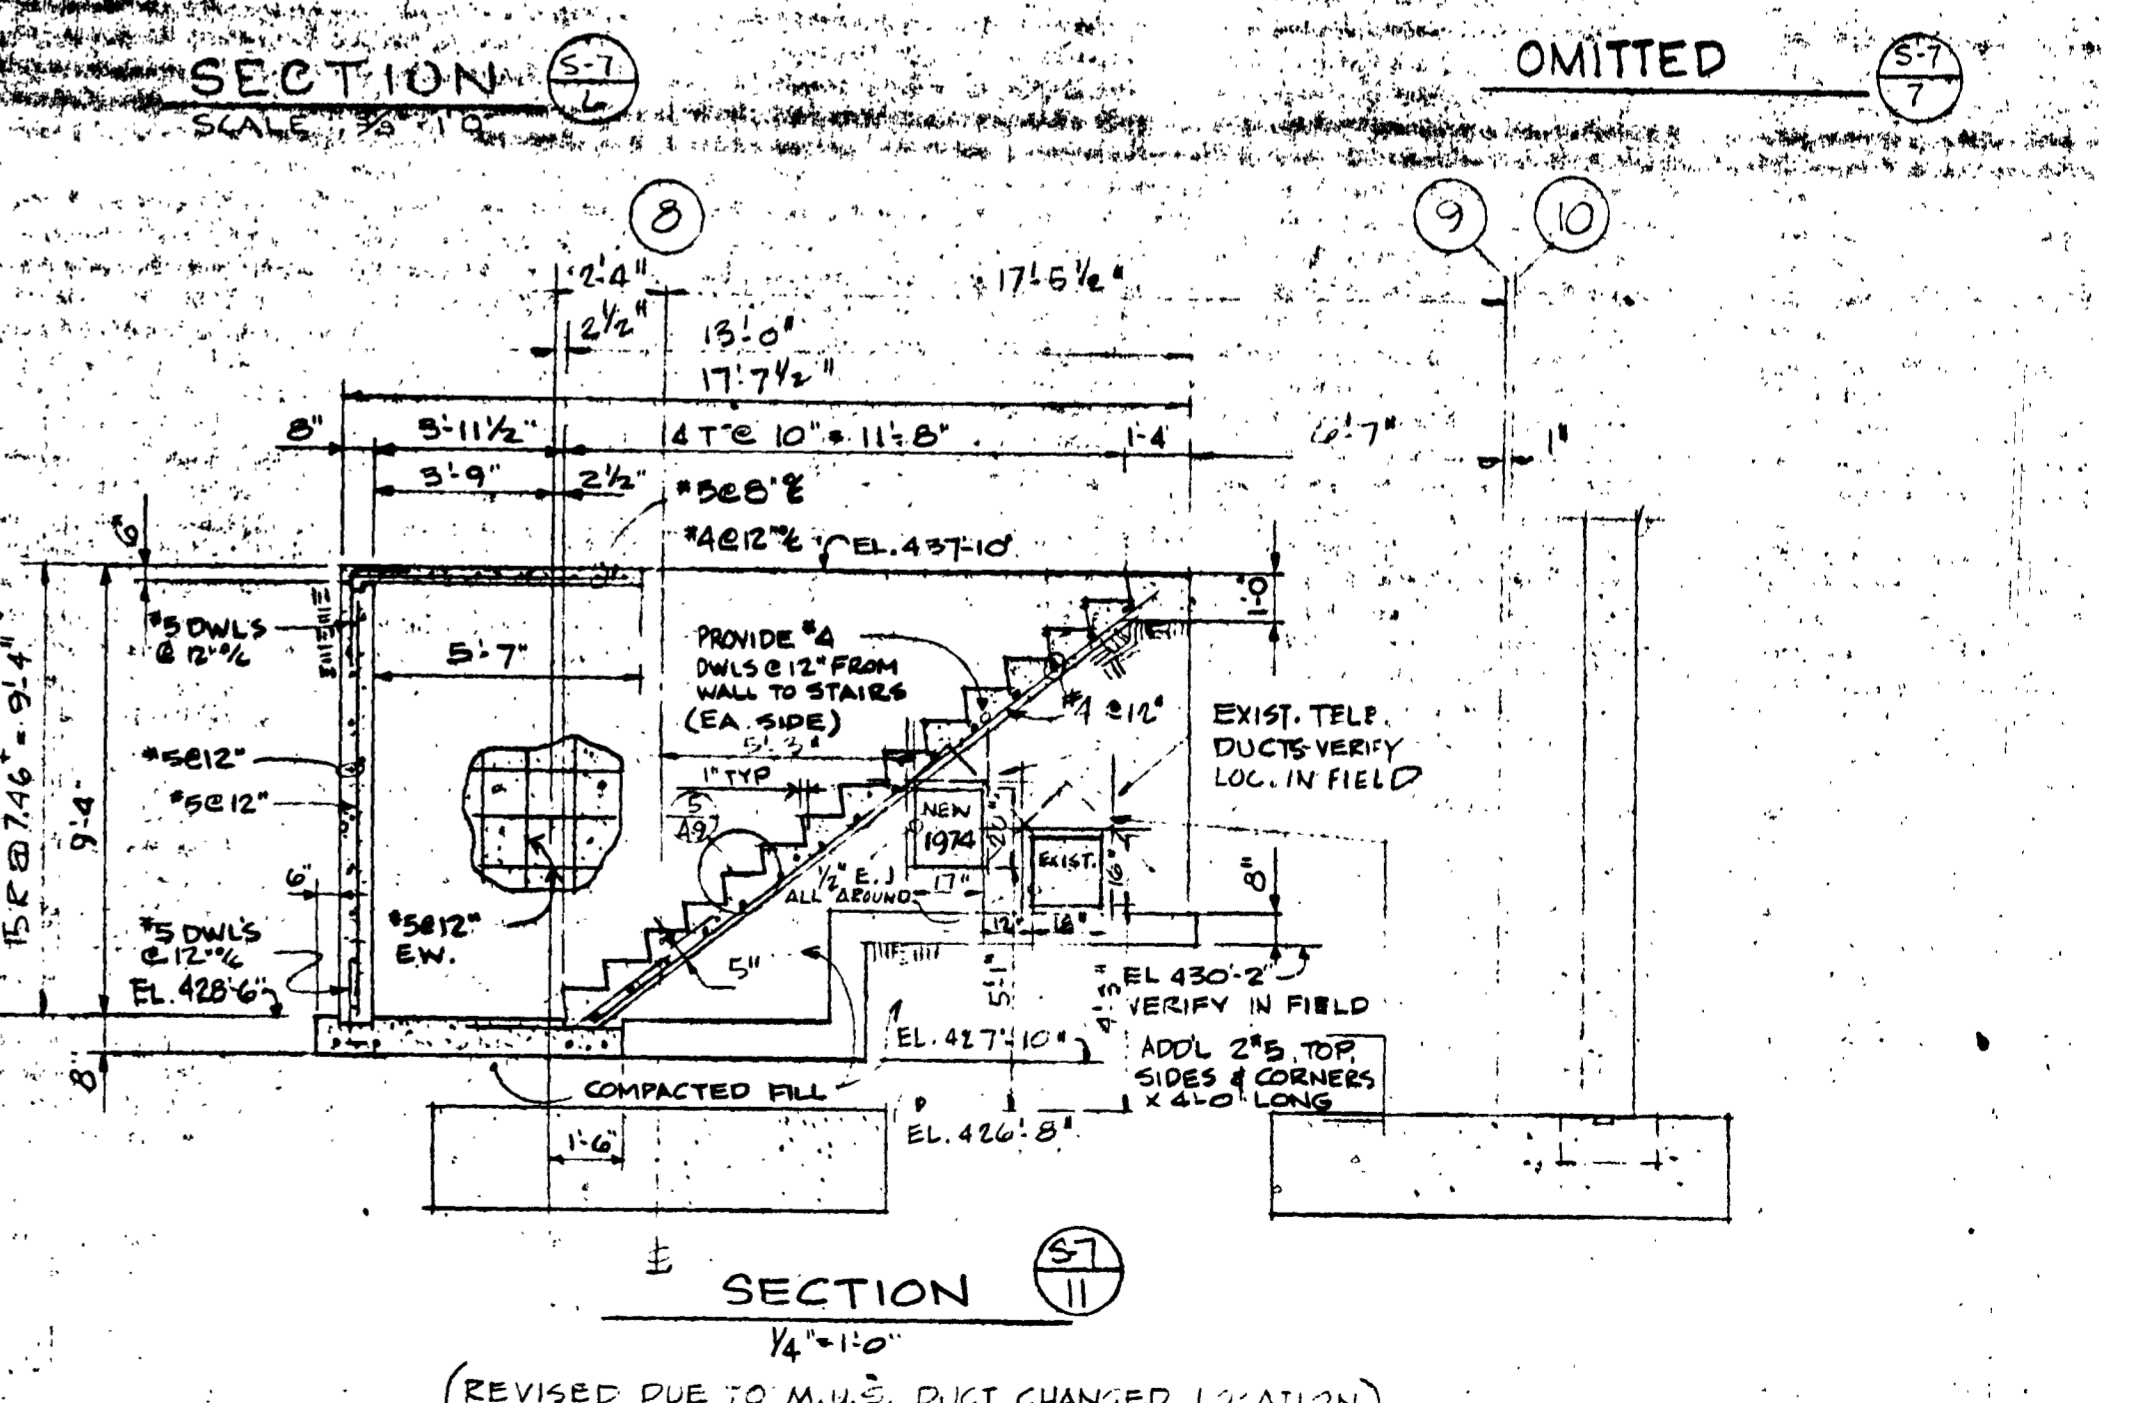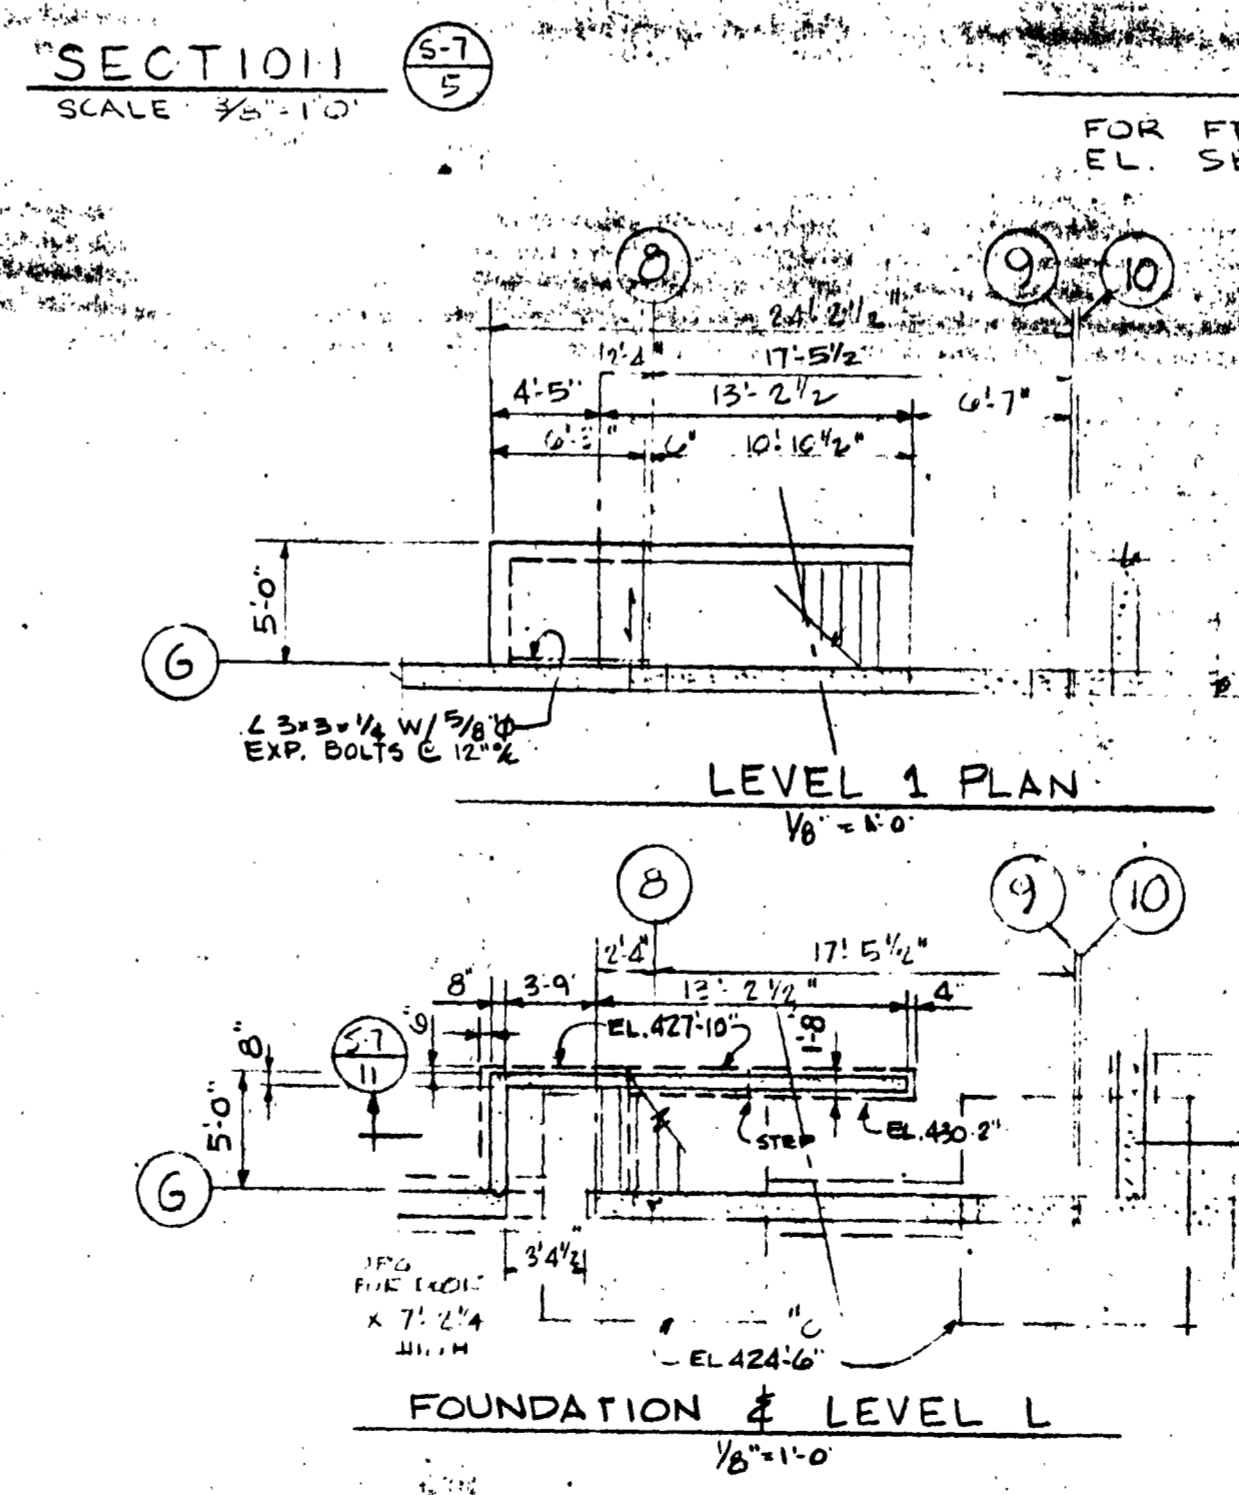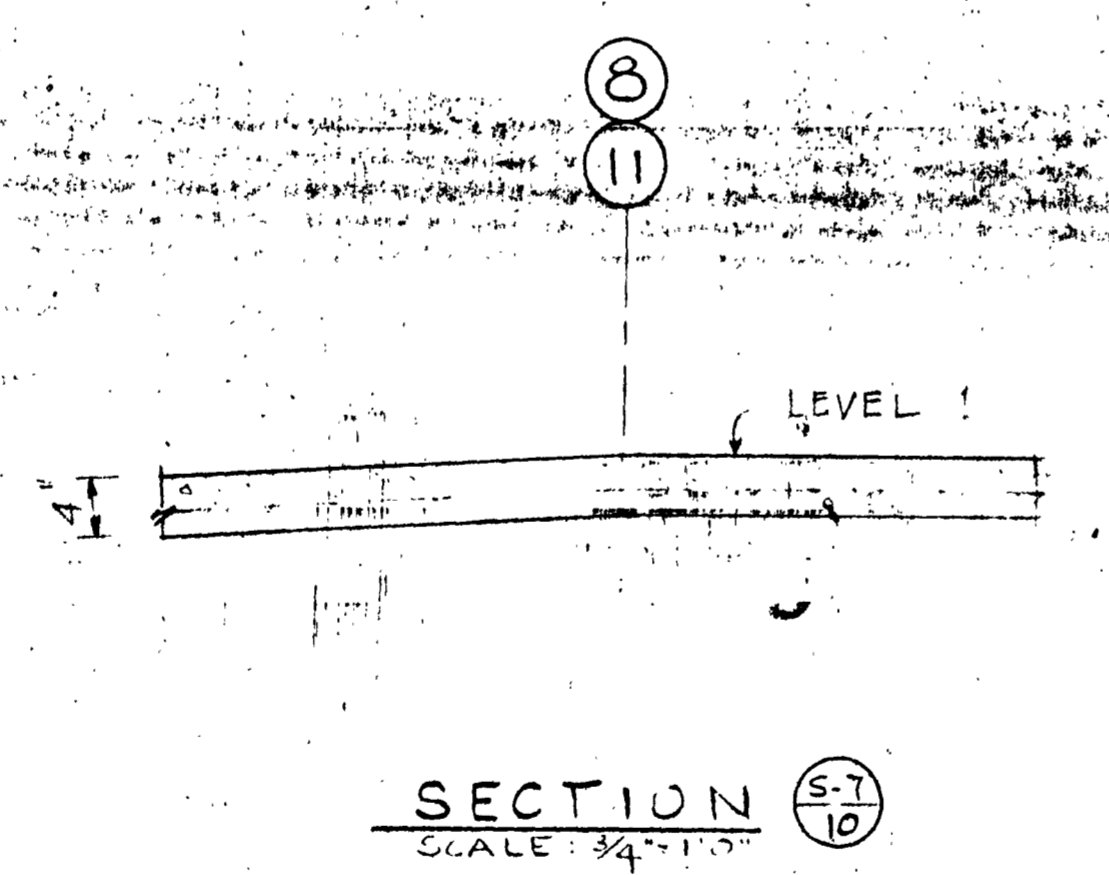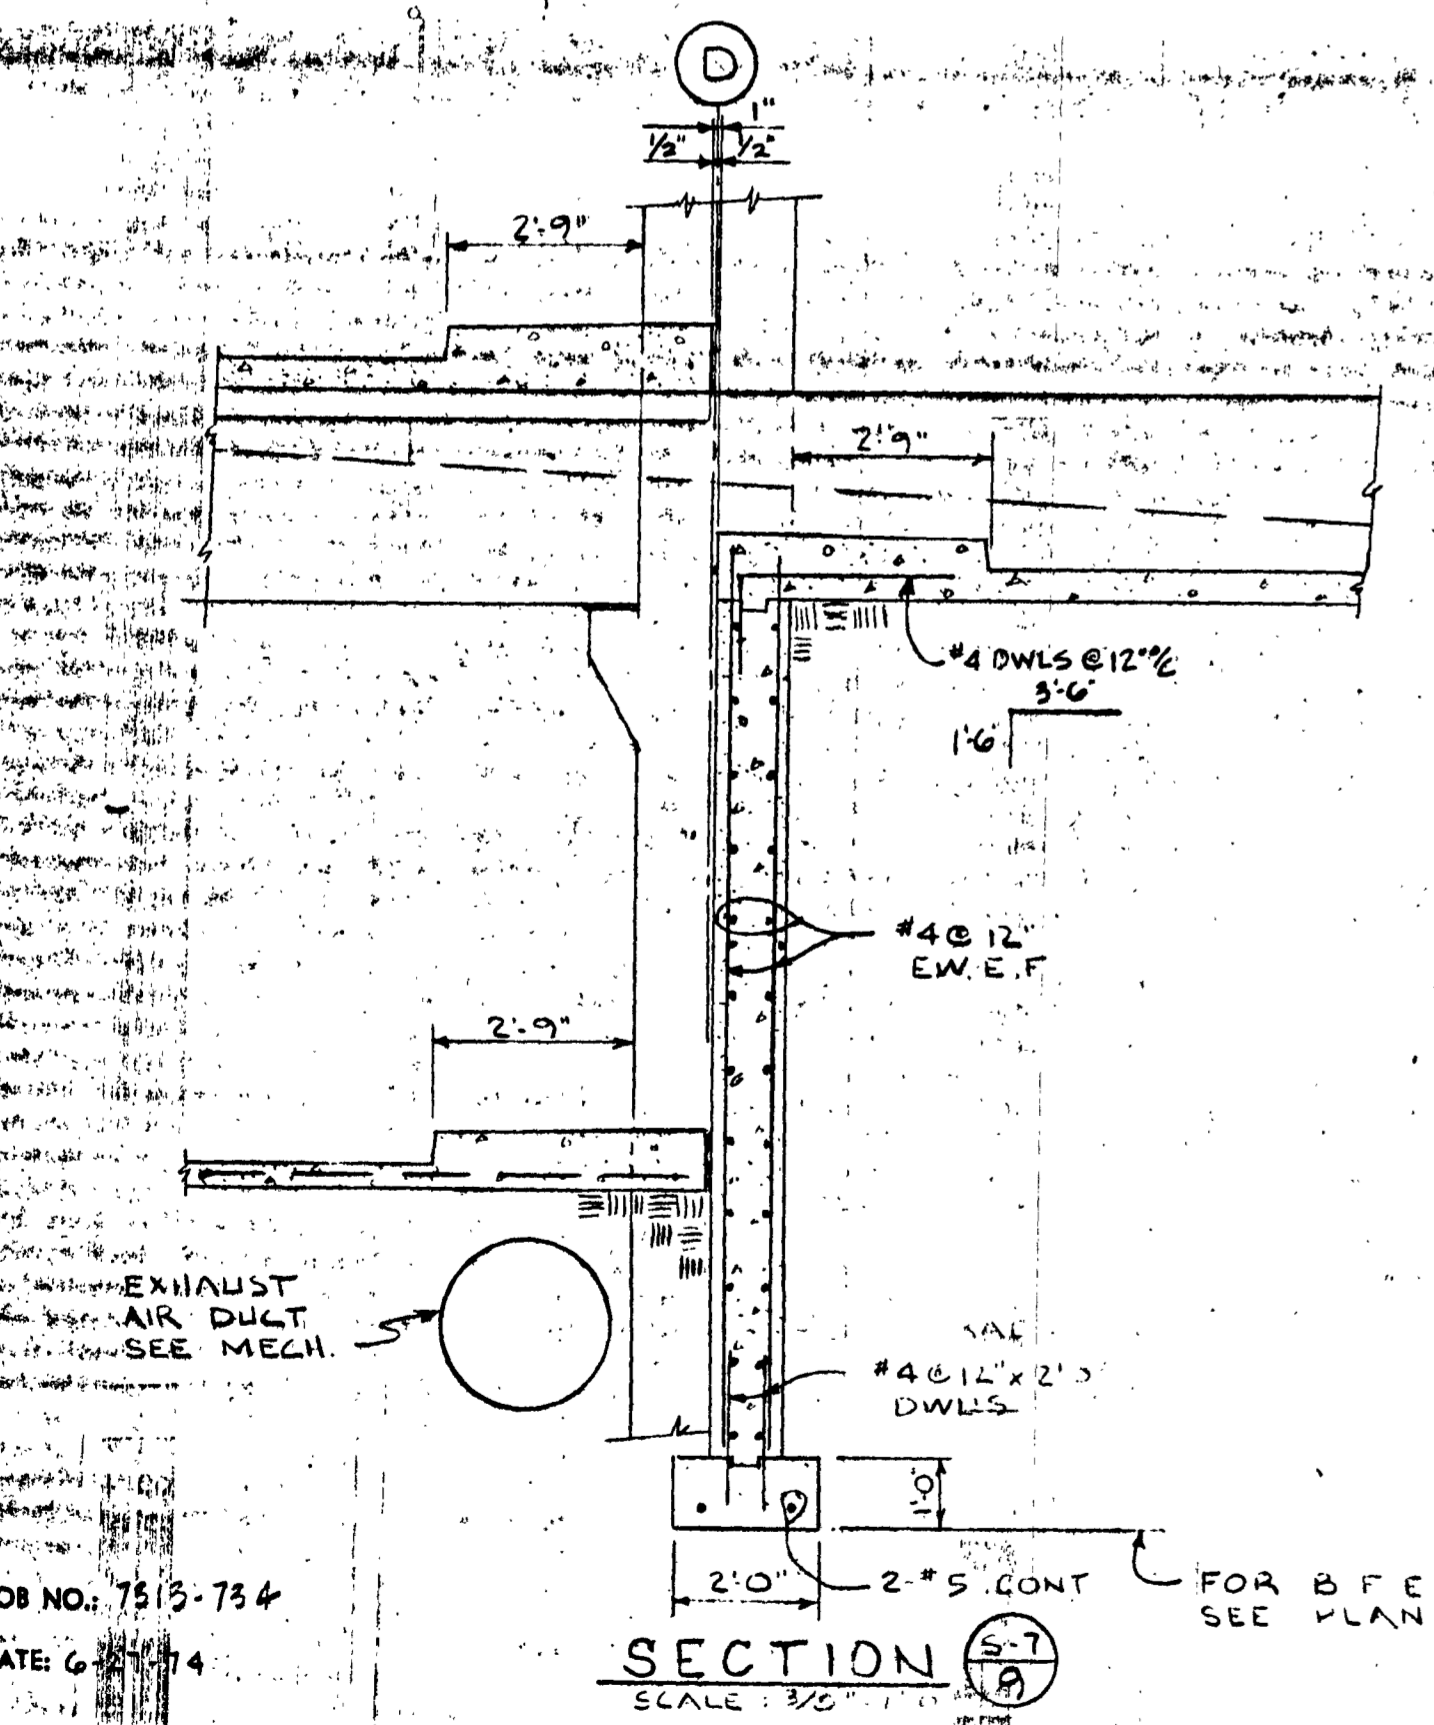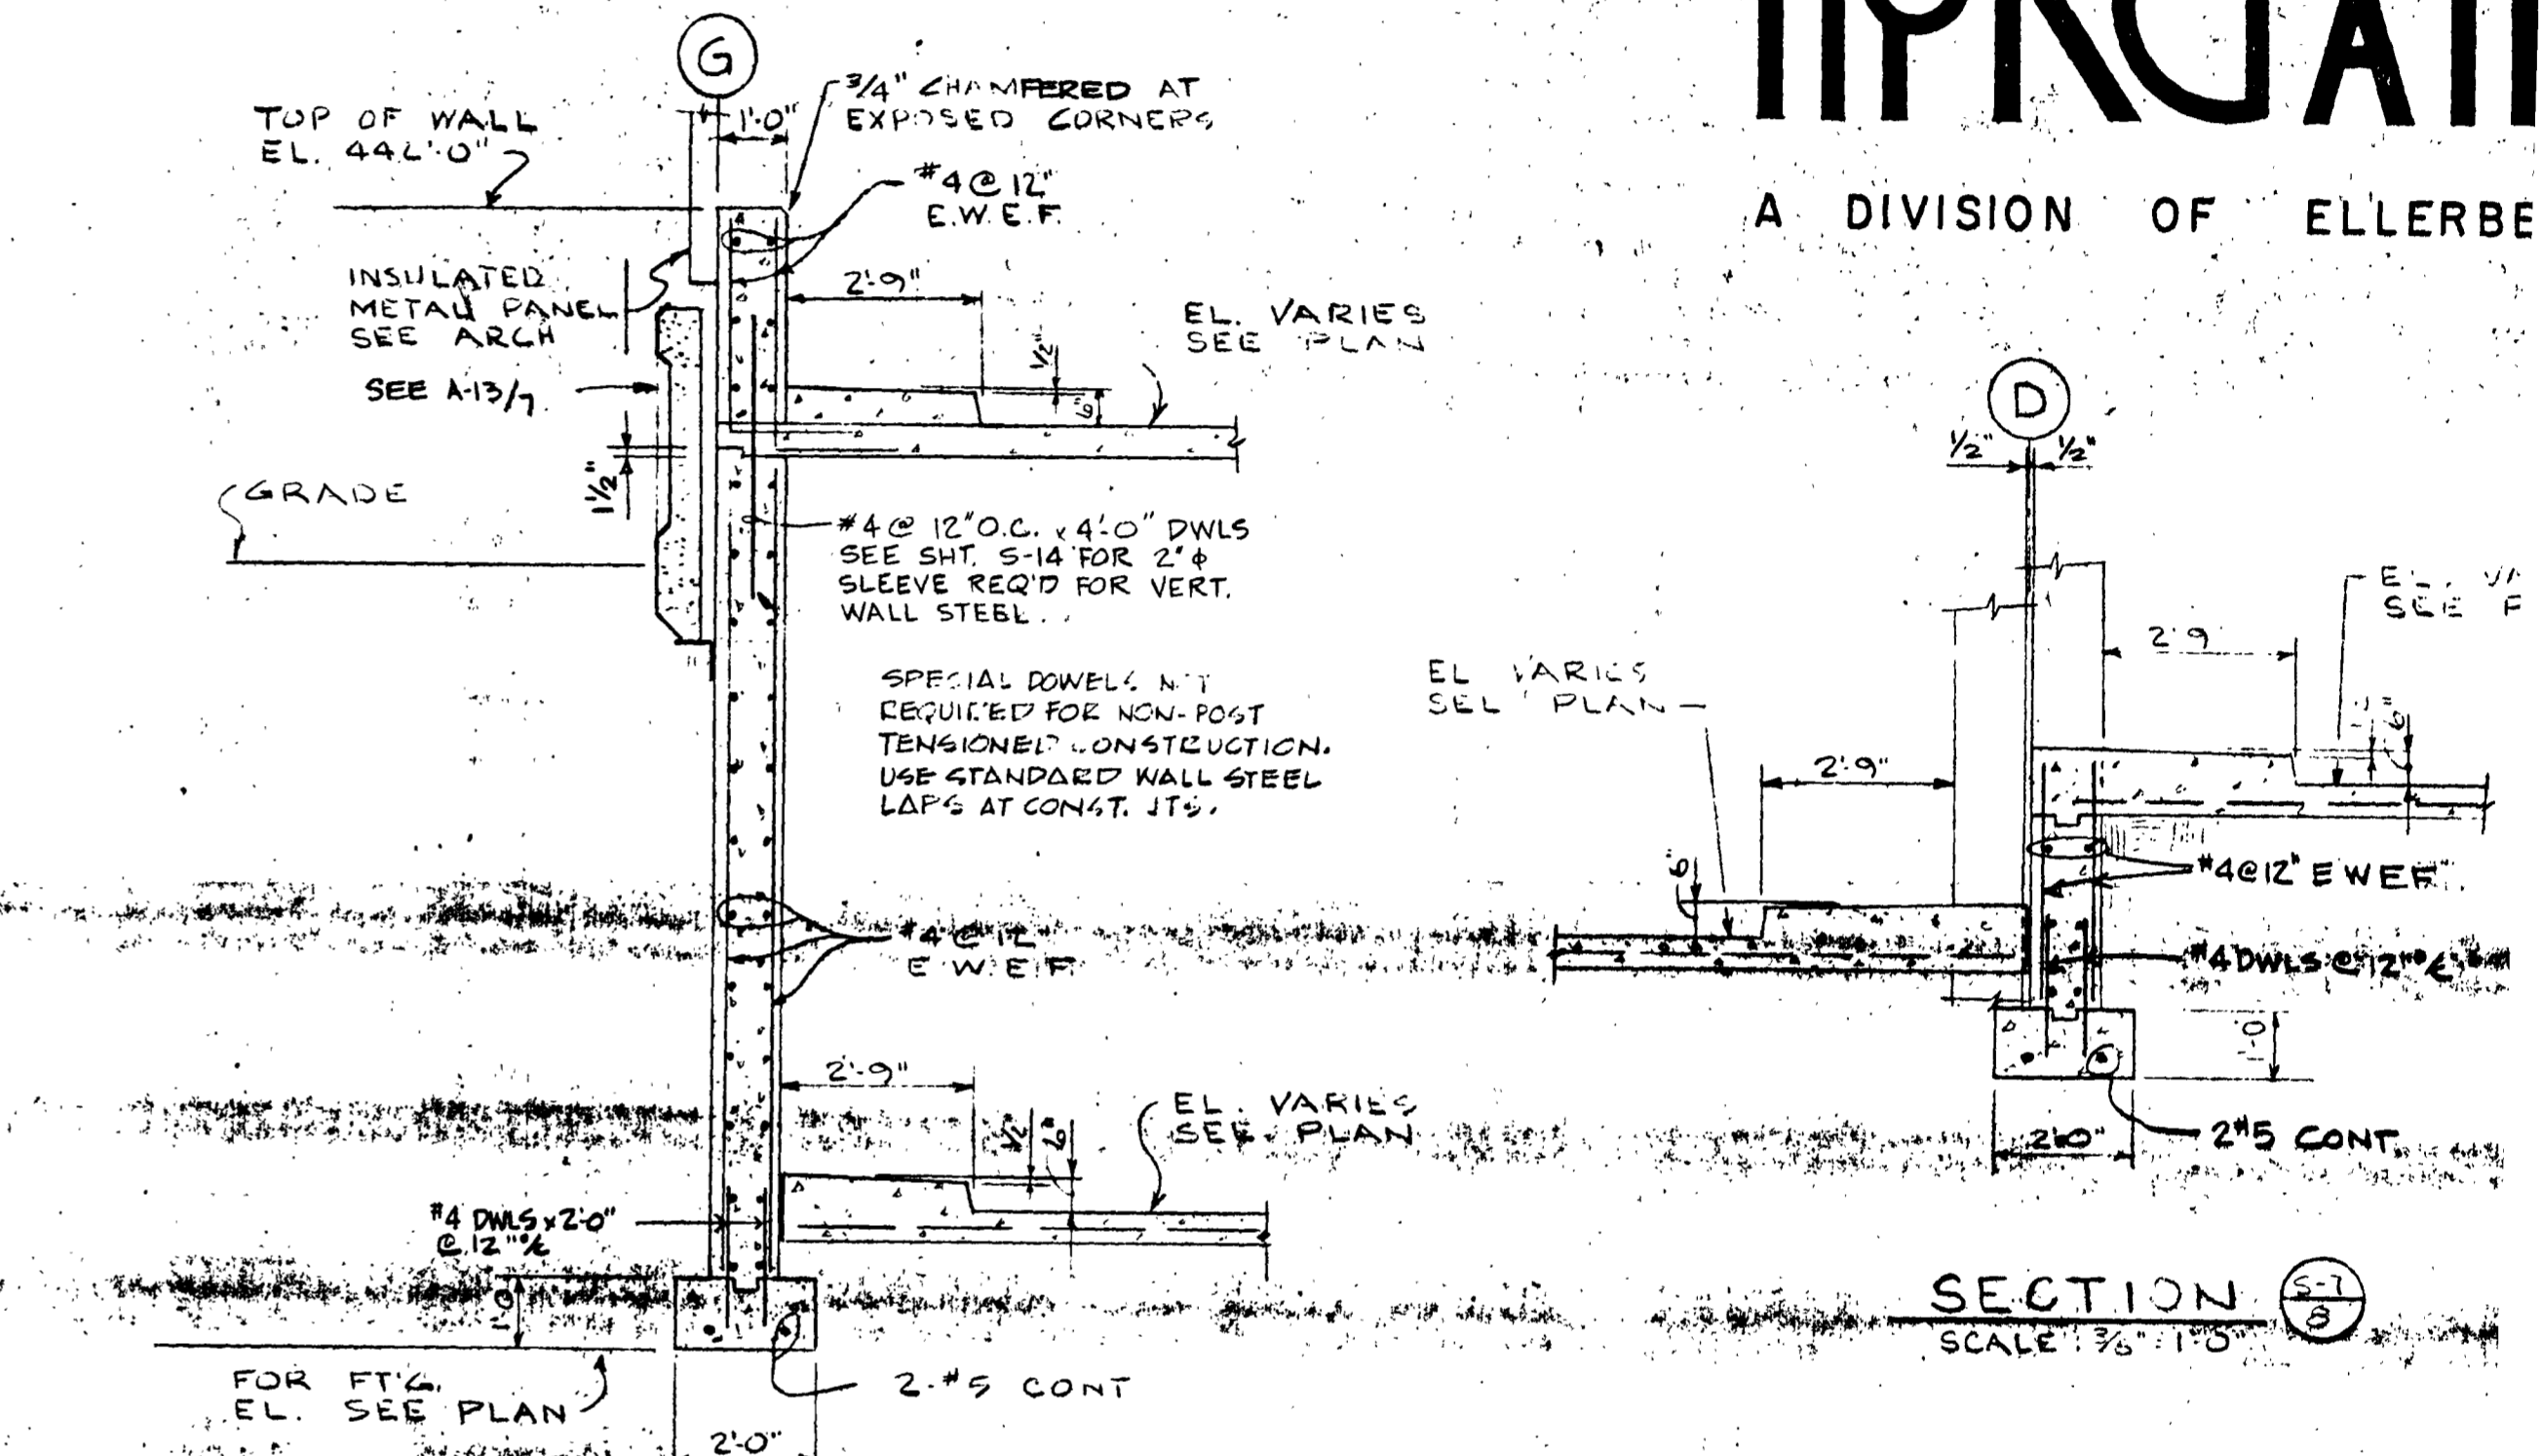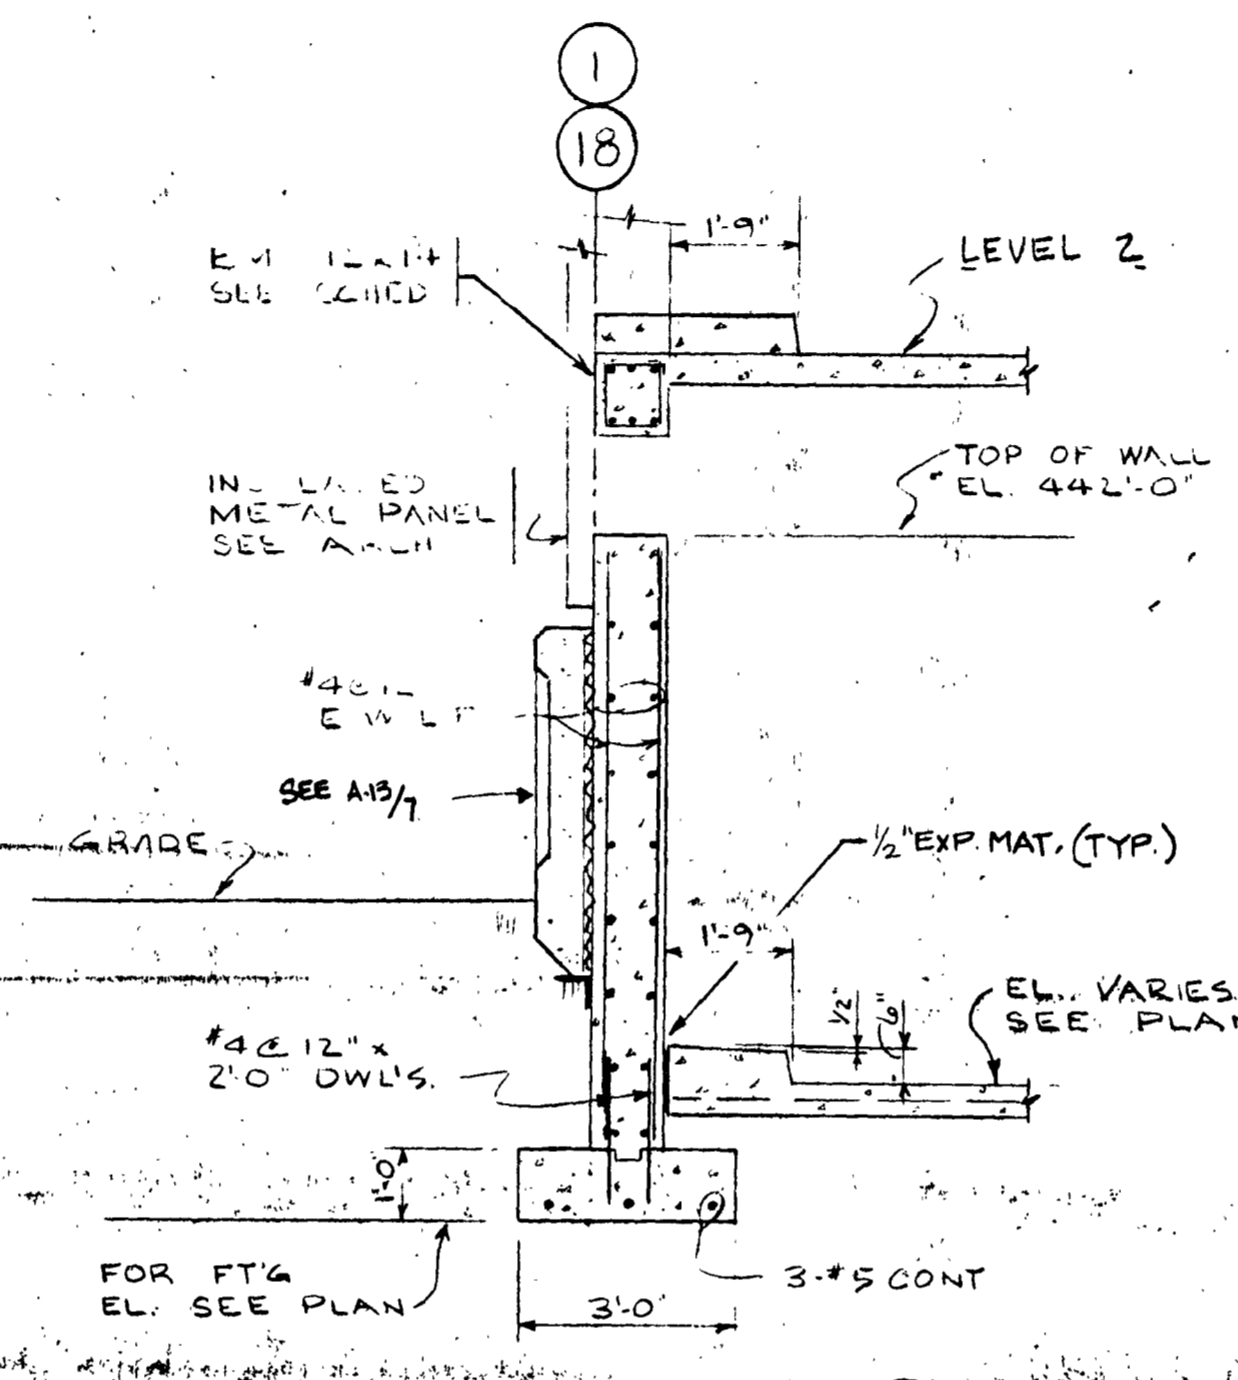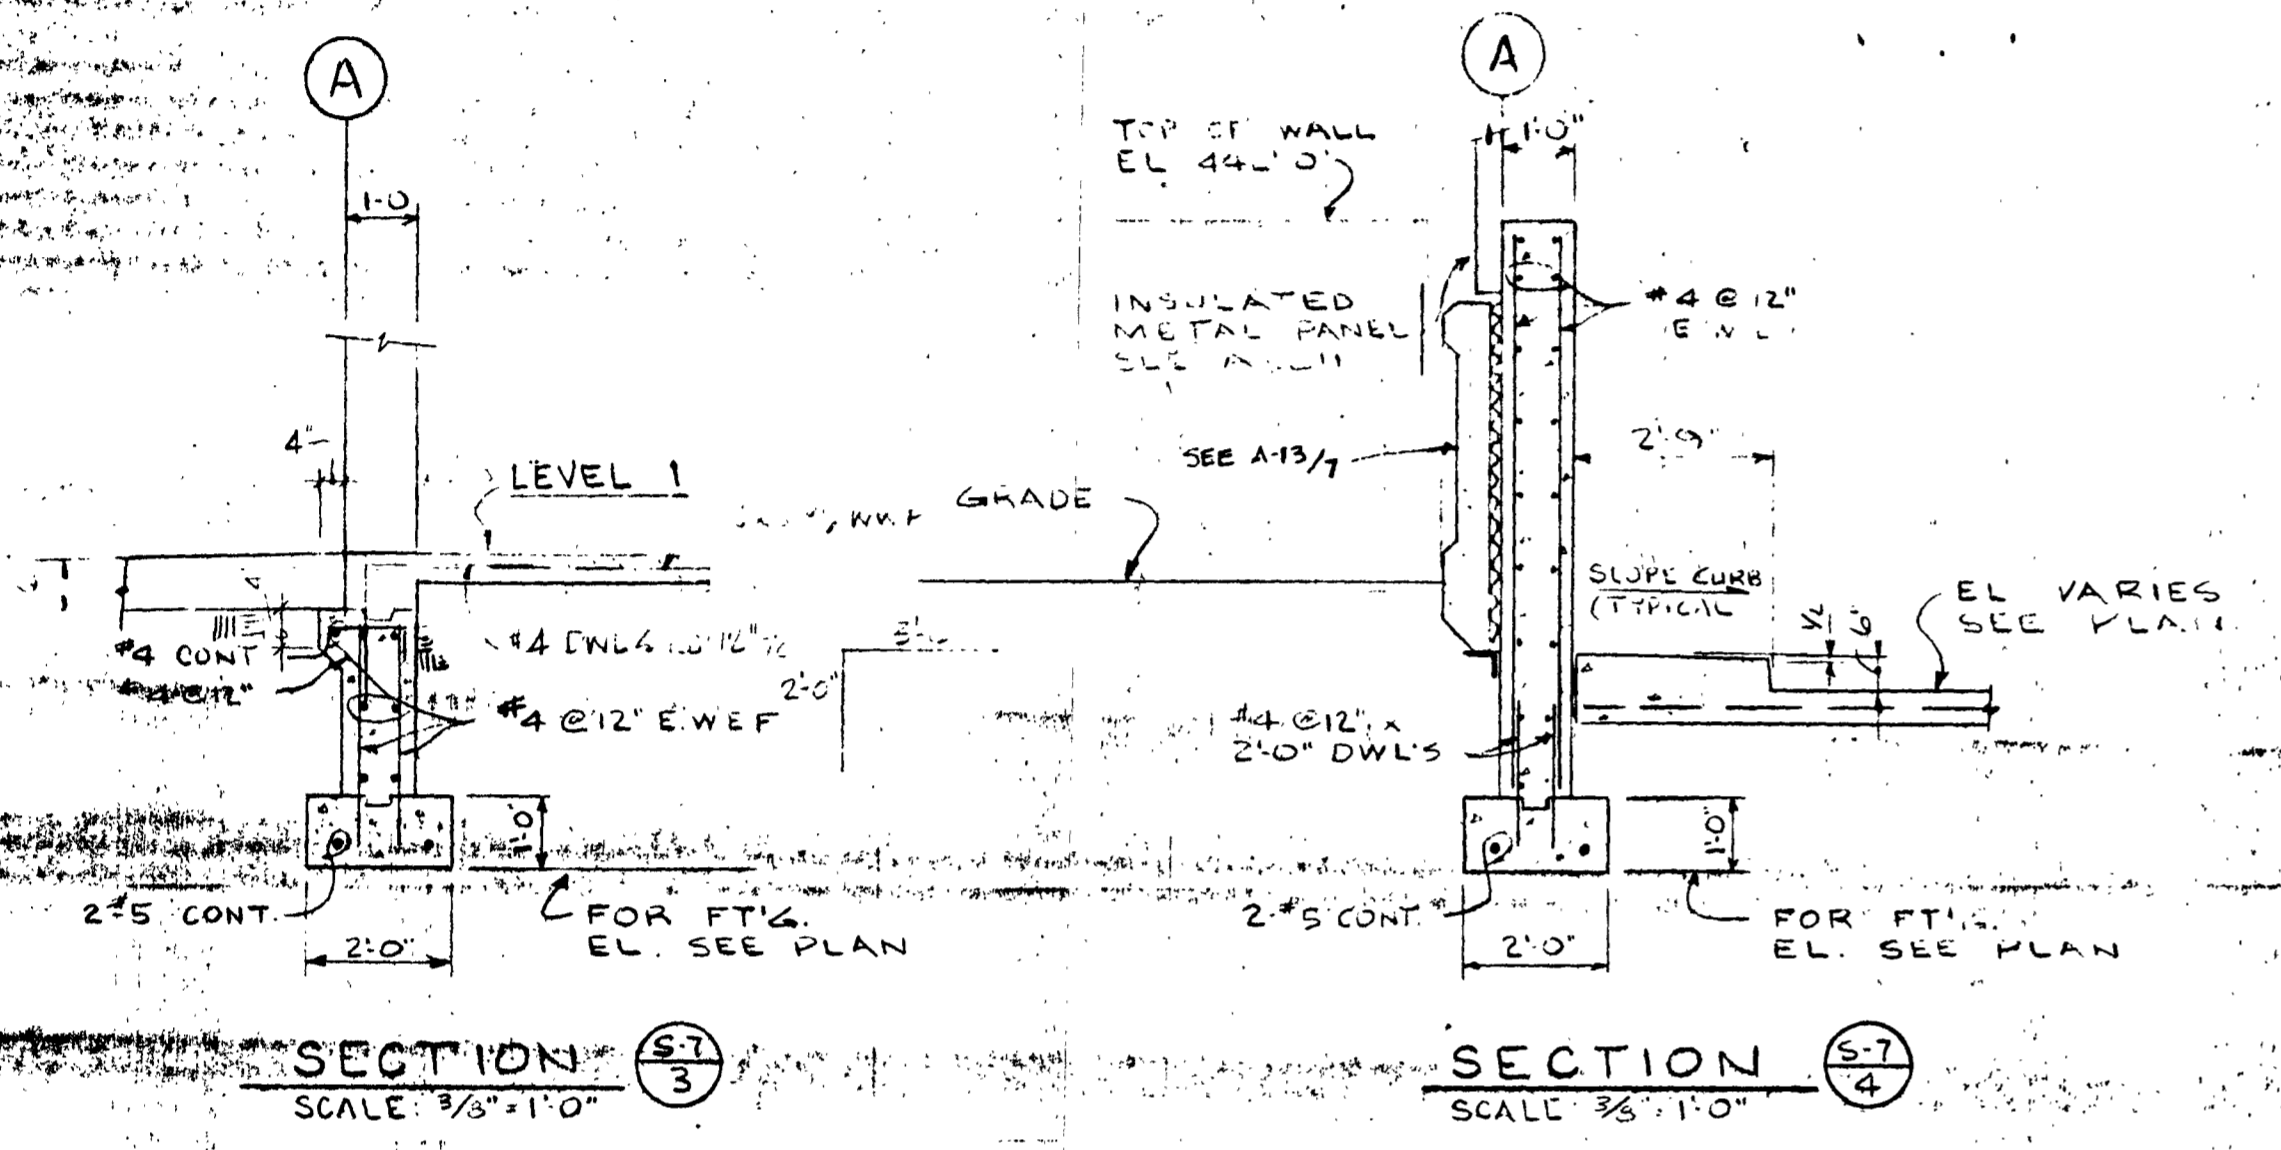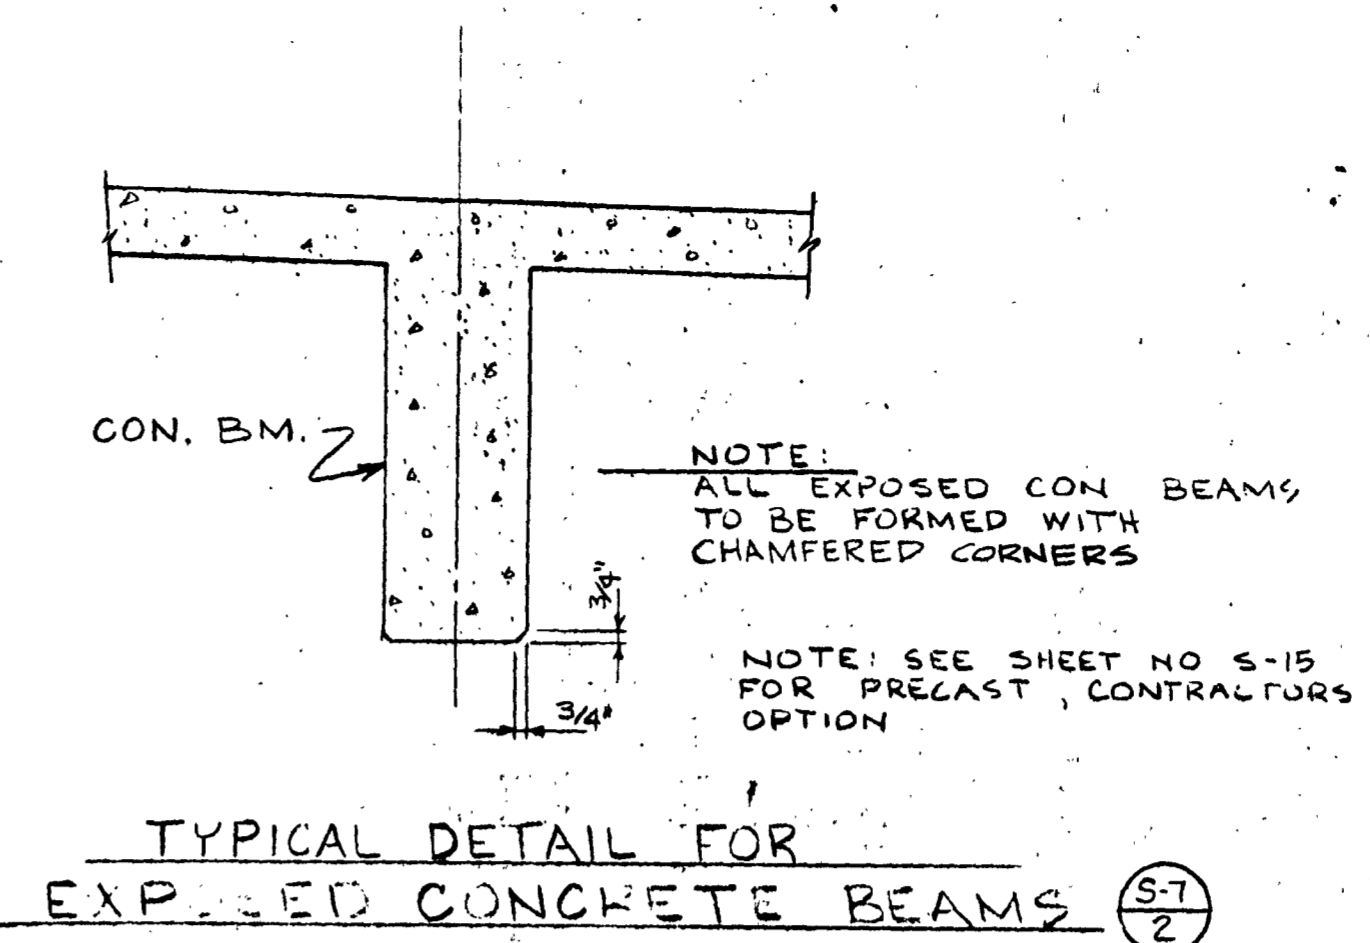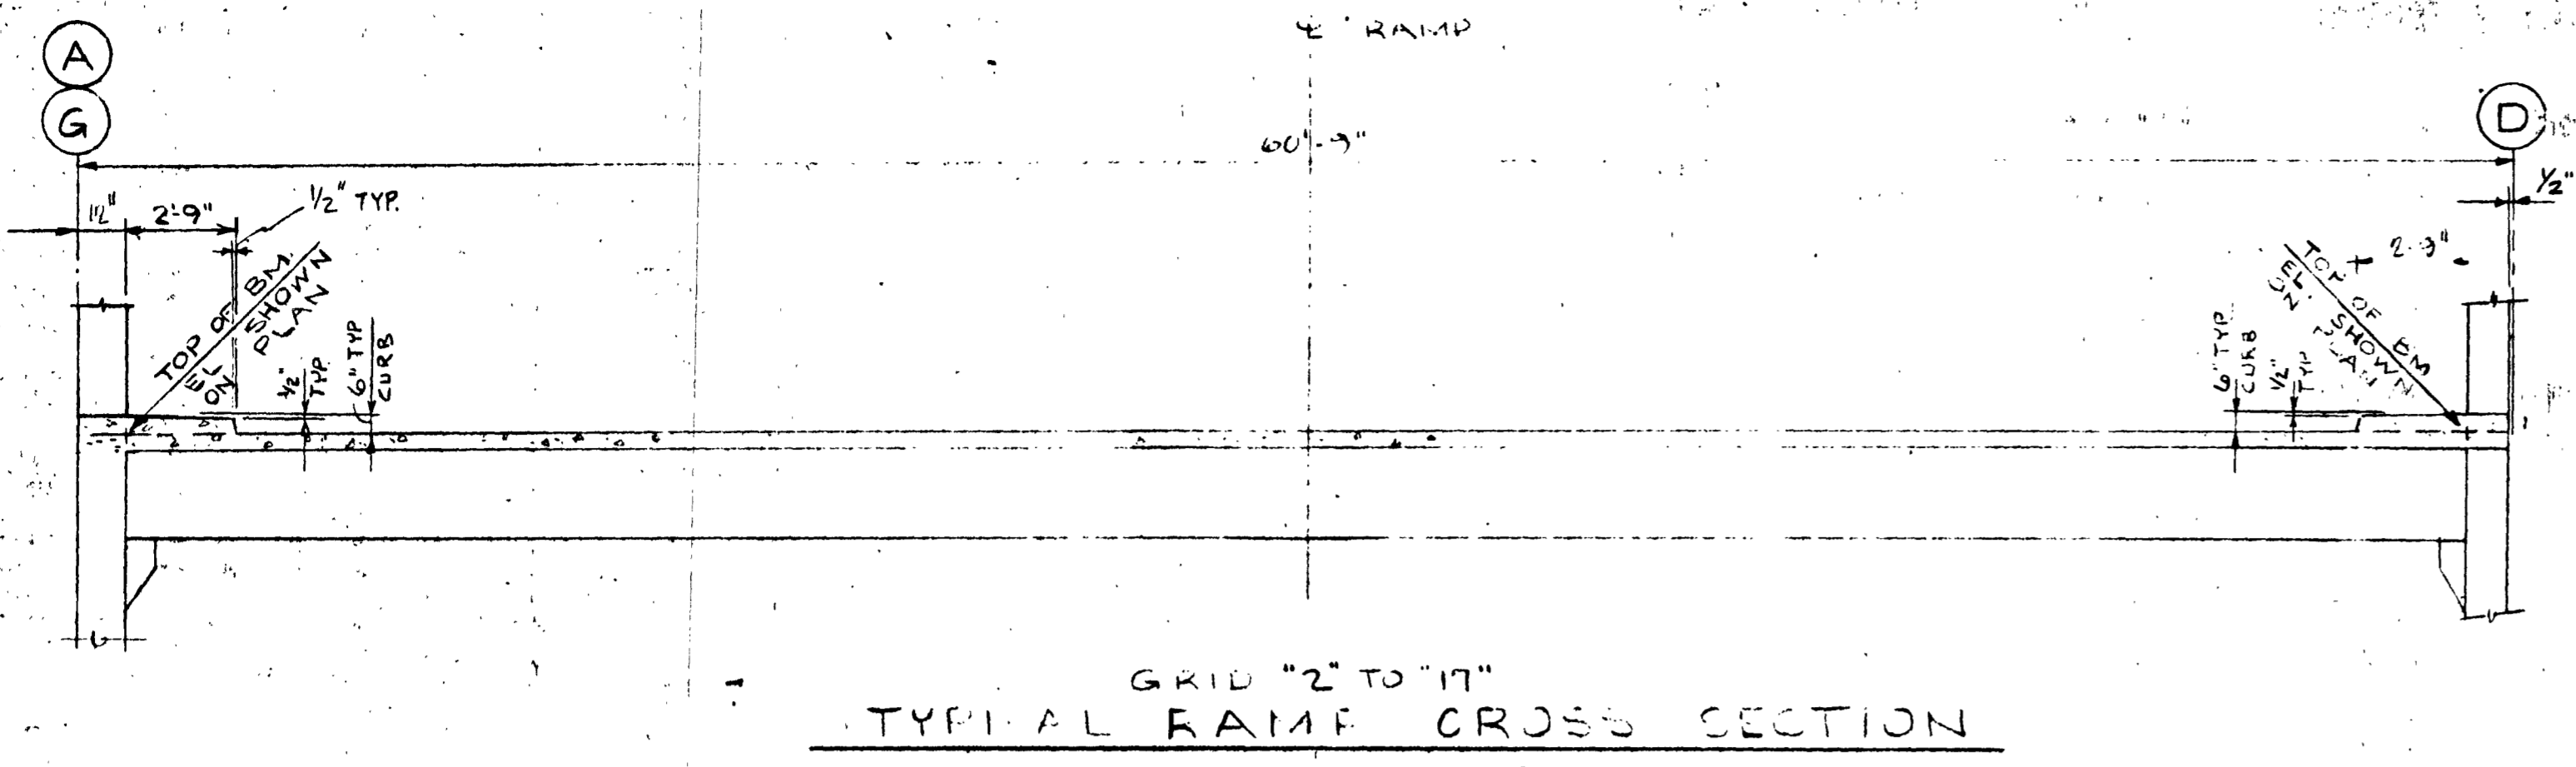

JOB NO. 7513-734
DATE: 6/1/74

ARCHITECTS • ENGINEERS • SURVEYORS
601 COLLEGE ROAD, FAIRBANKS, ALASKA 99701, PHONE: 452-1241

STATE OF ALASKA
DEPT. OF PUBLIC WORKS
DIVISION OF BUILDINGS
JUNEAU ALASKA












FAIRBANKS PARKING STRUCTURE
FAIRBANKS, AK.
DBA - 2 - 0130

PREPARED BY: PETER HANCOCK CONSULTING CO.
DATE:

FOUNDATION DE

S-7

AS-BLT. SHEET 27

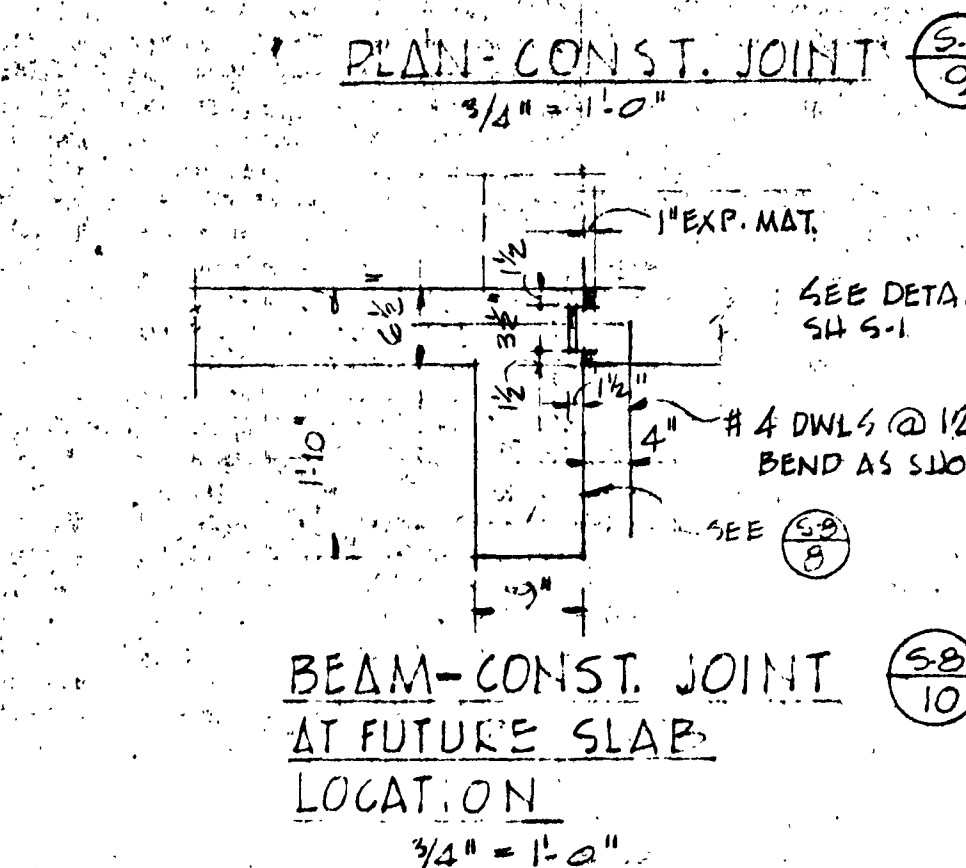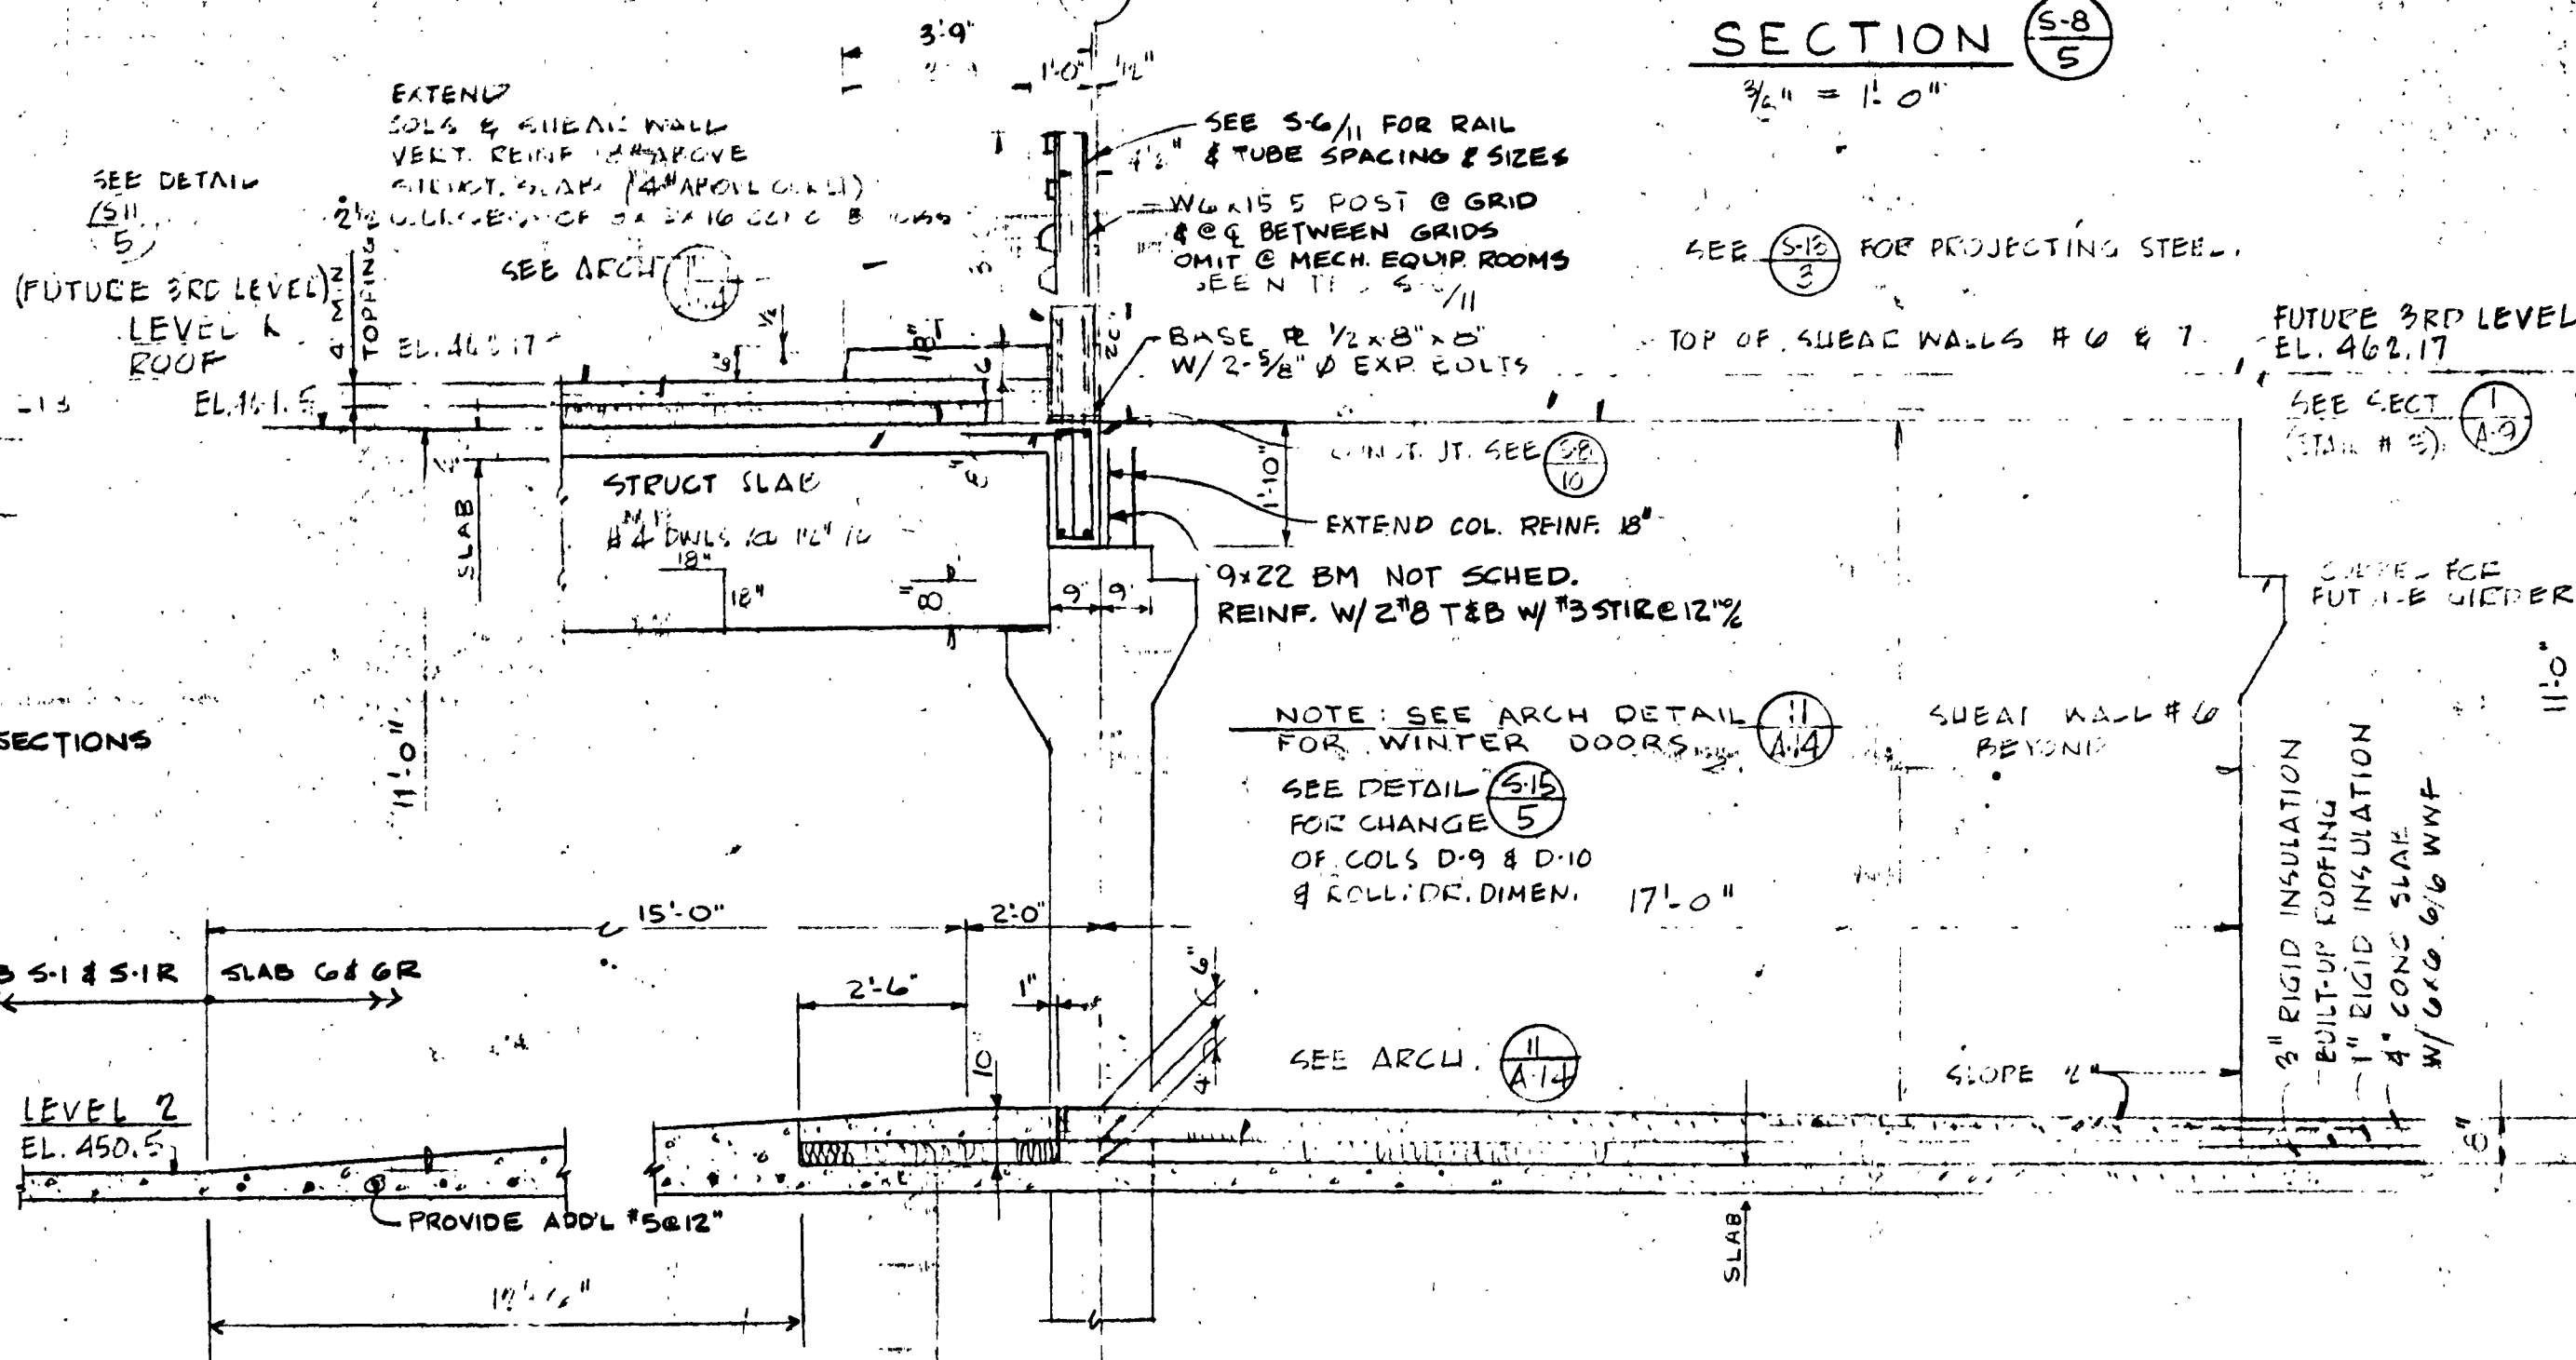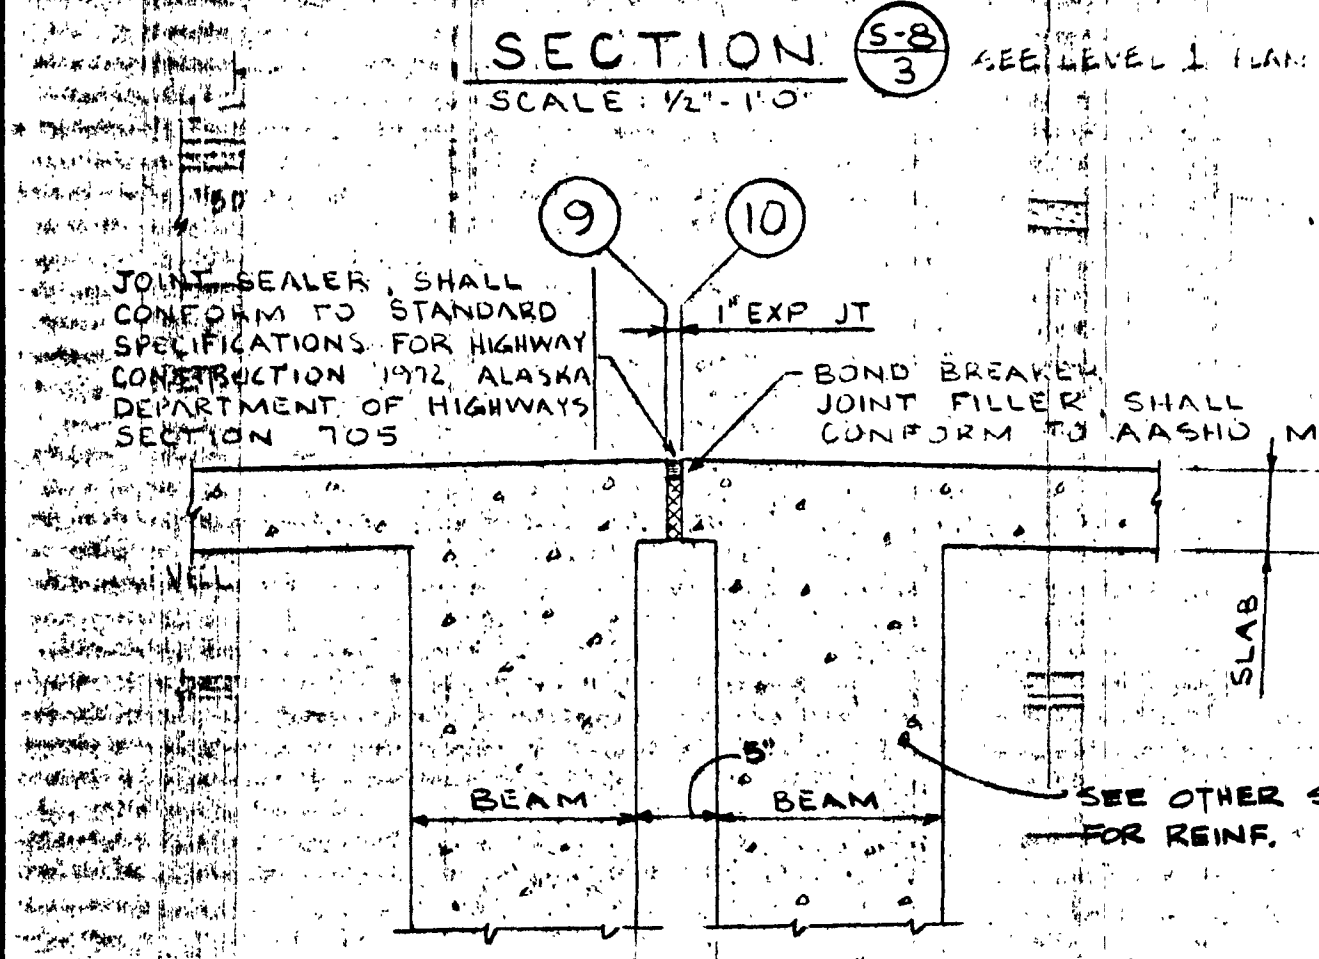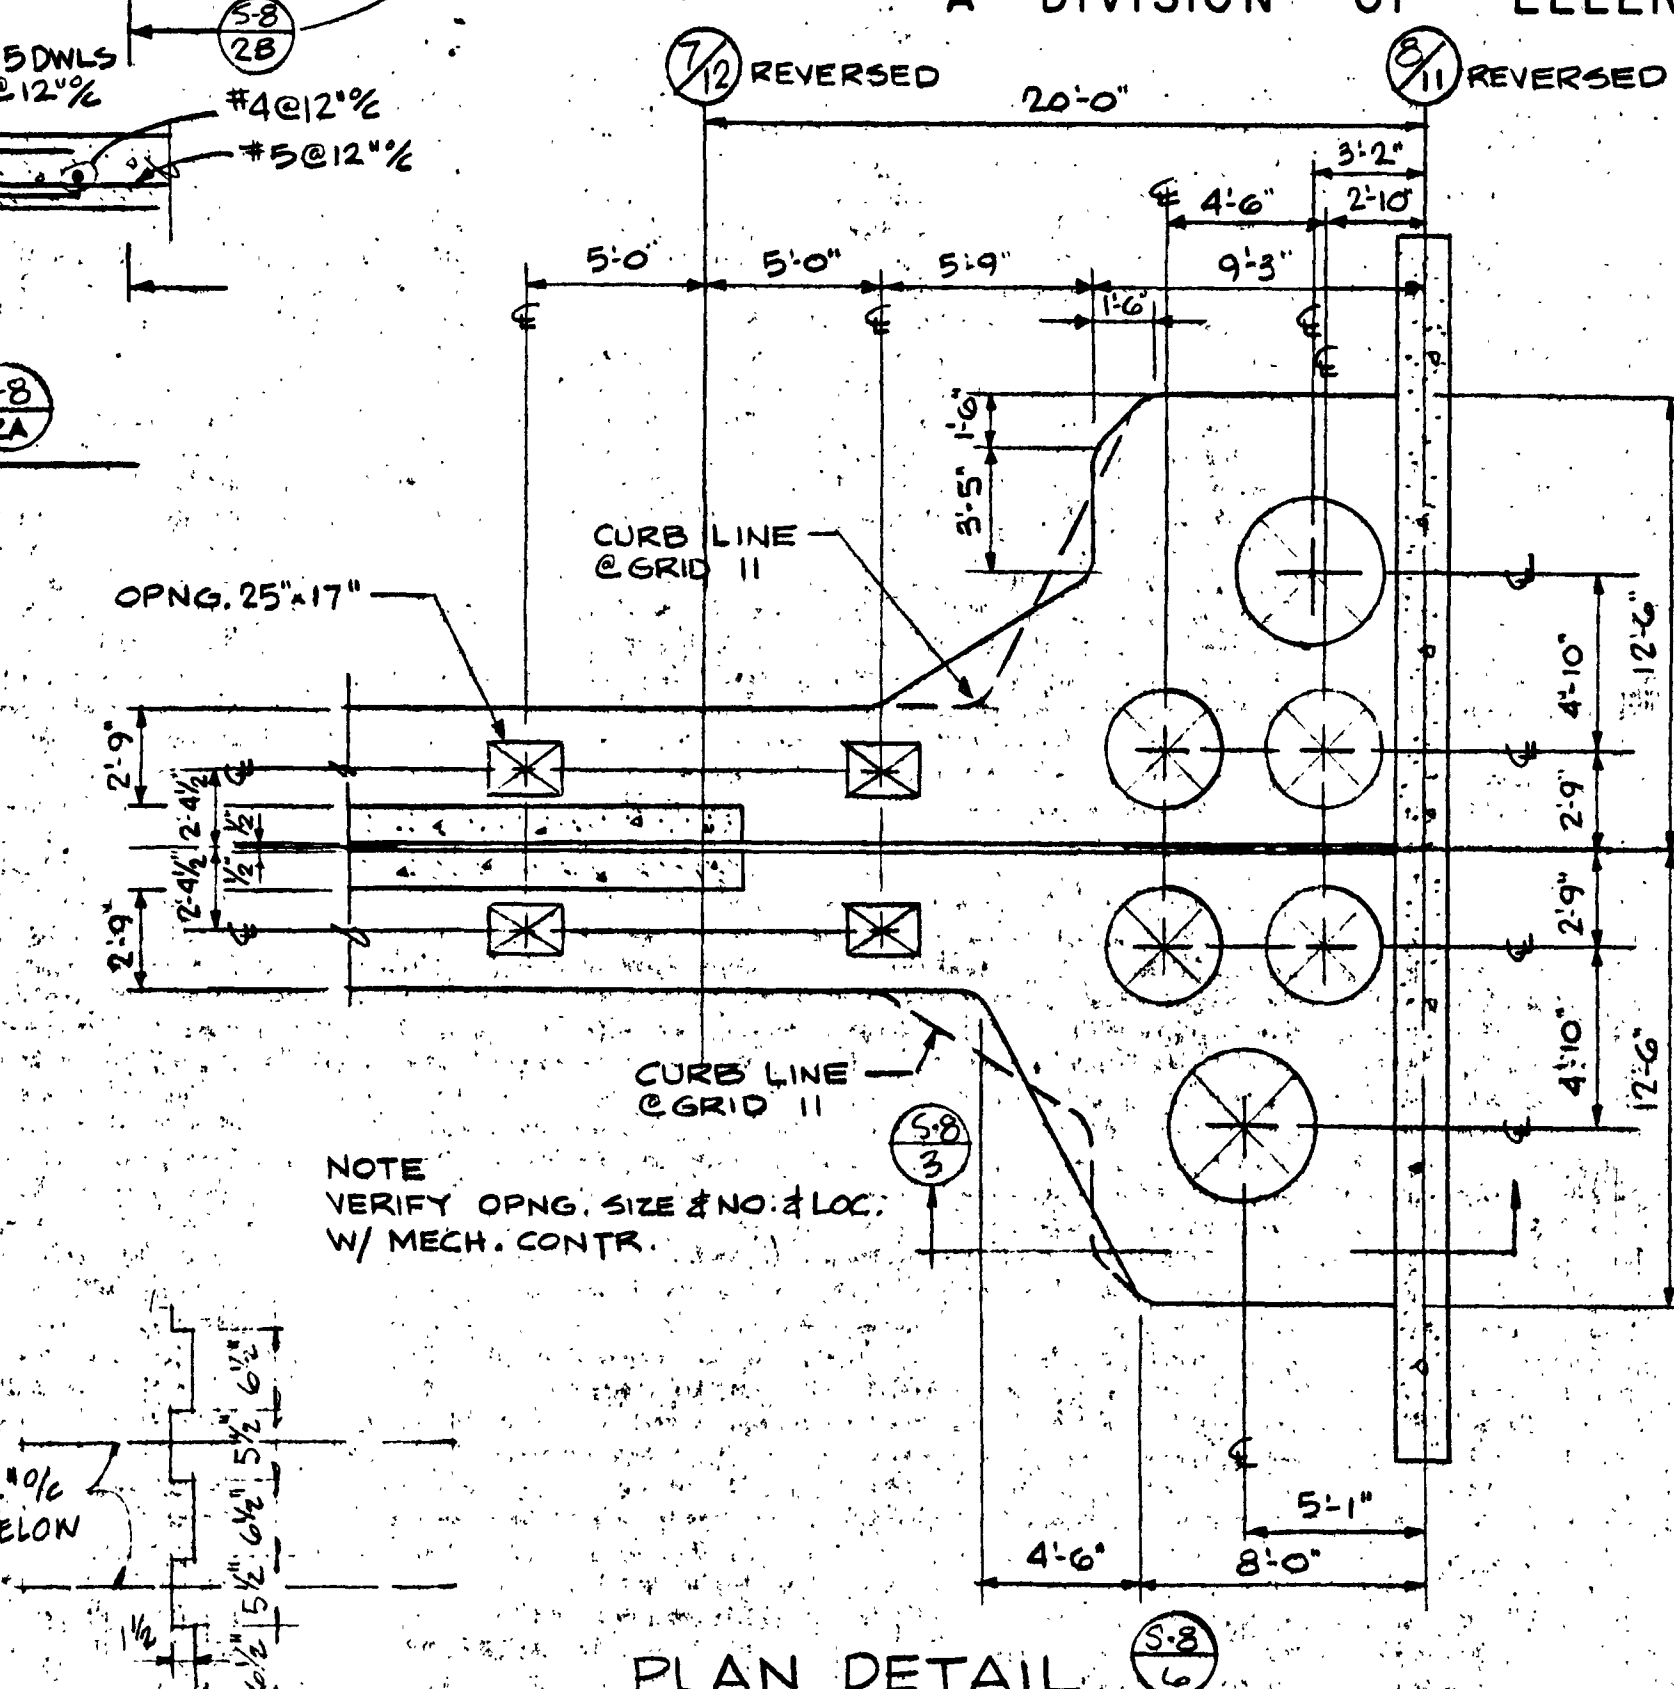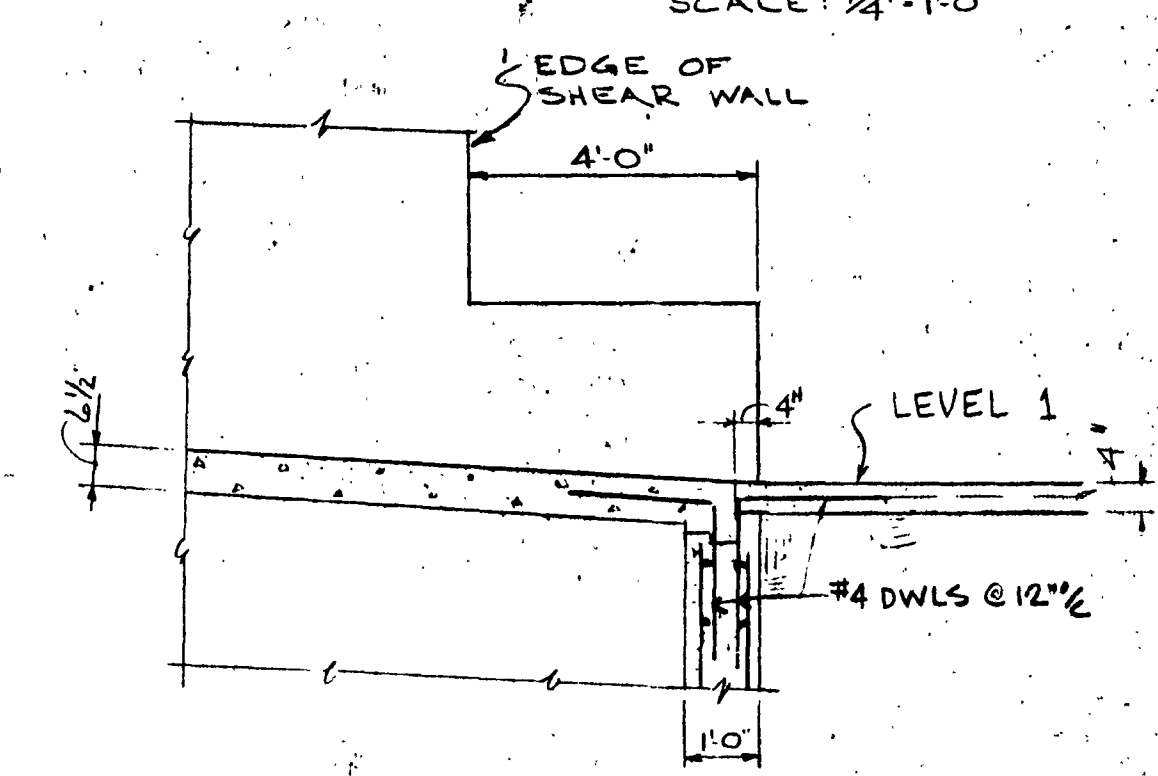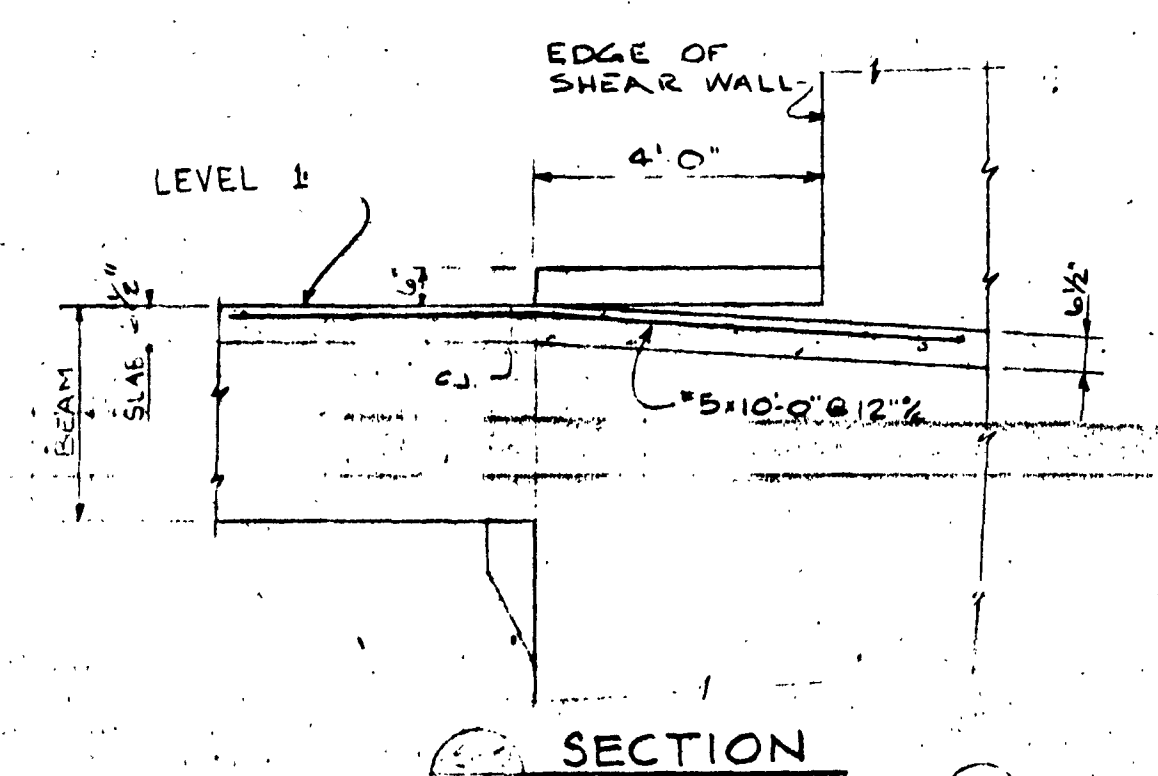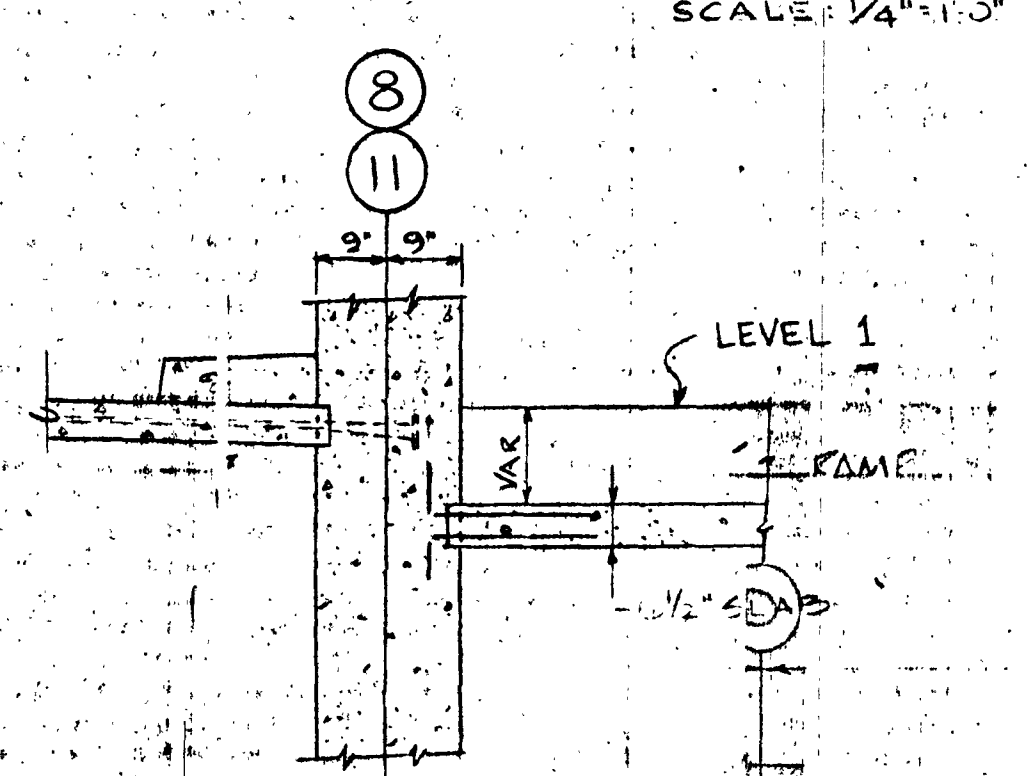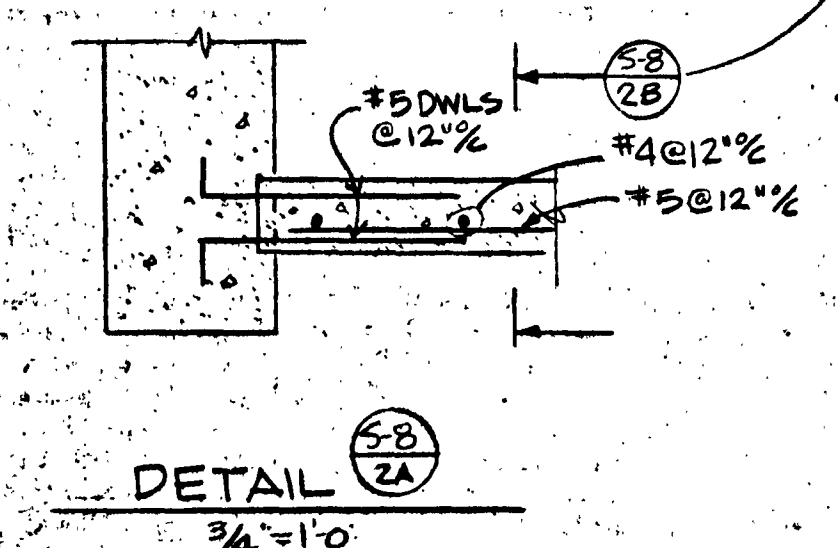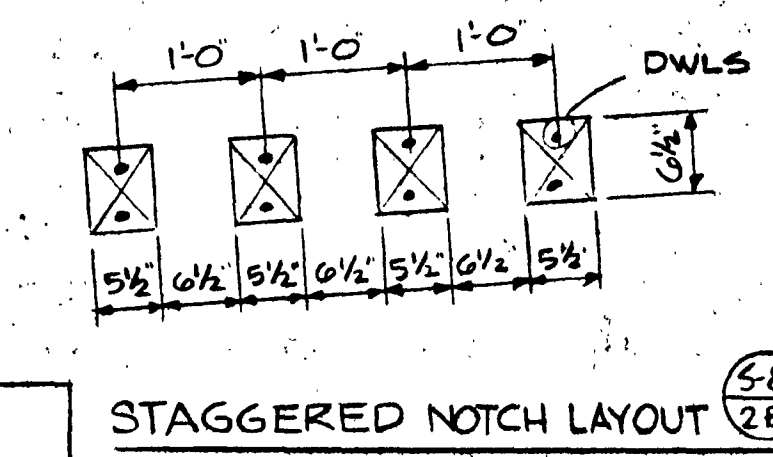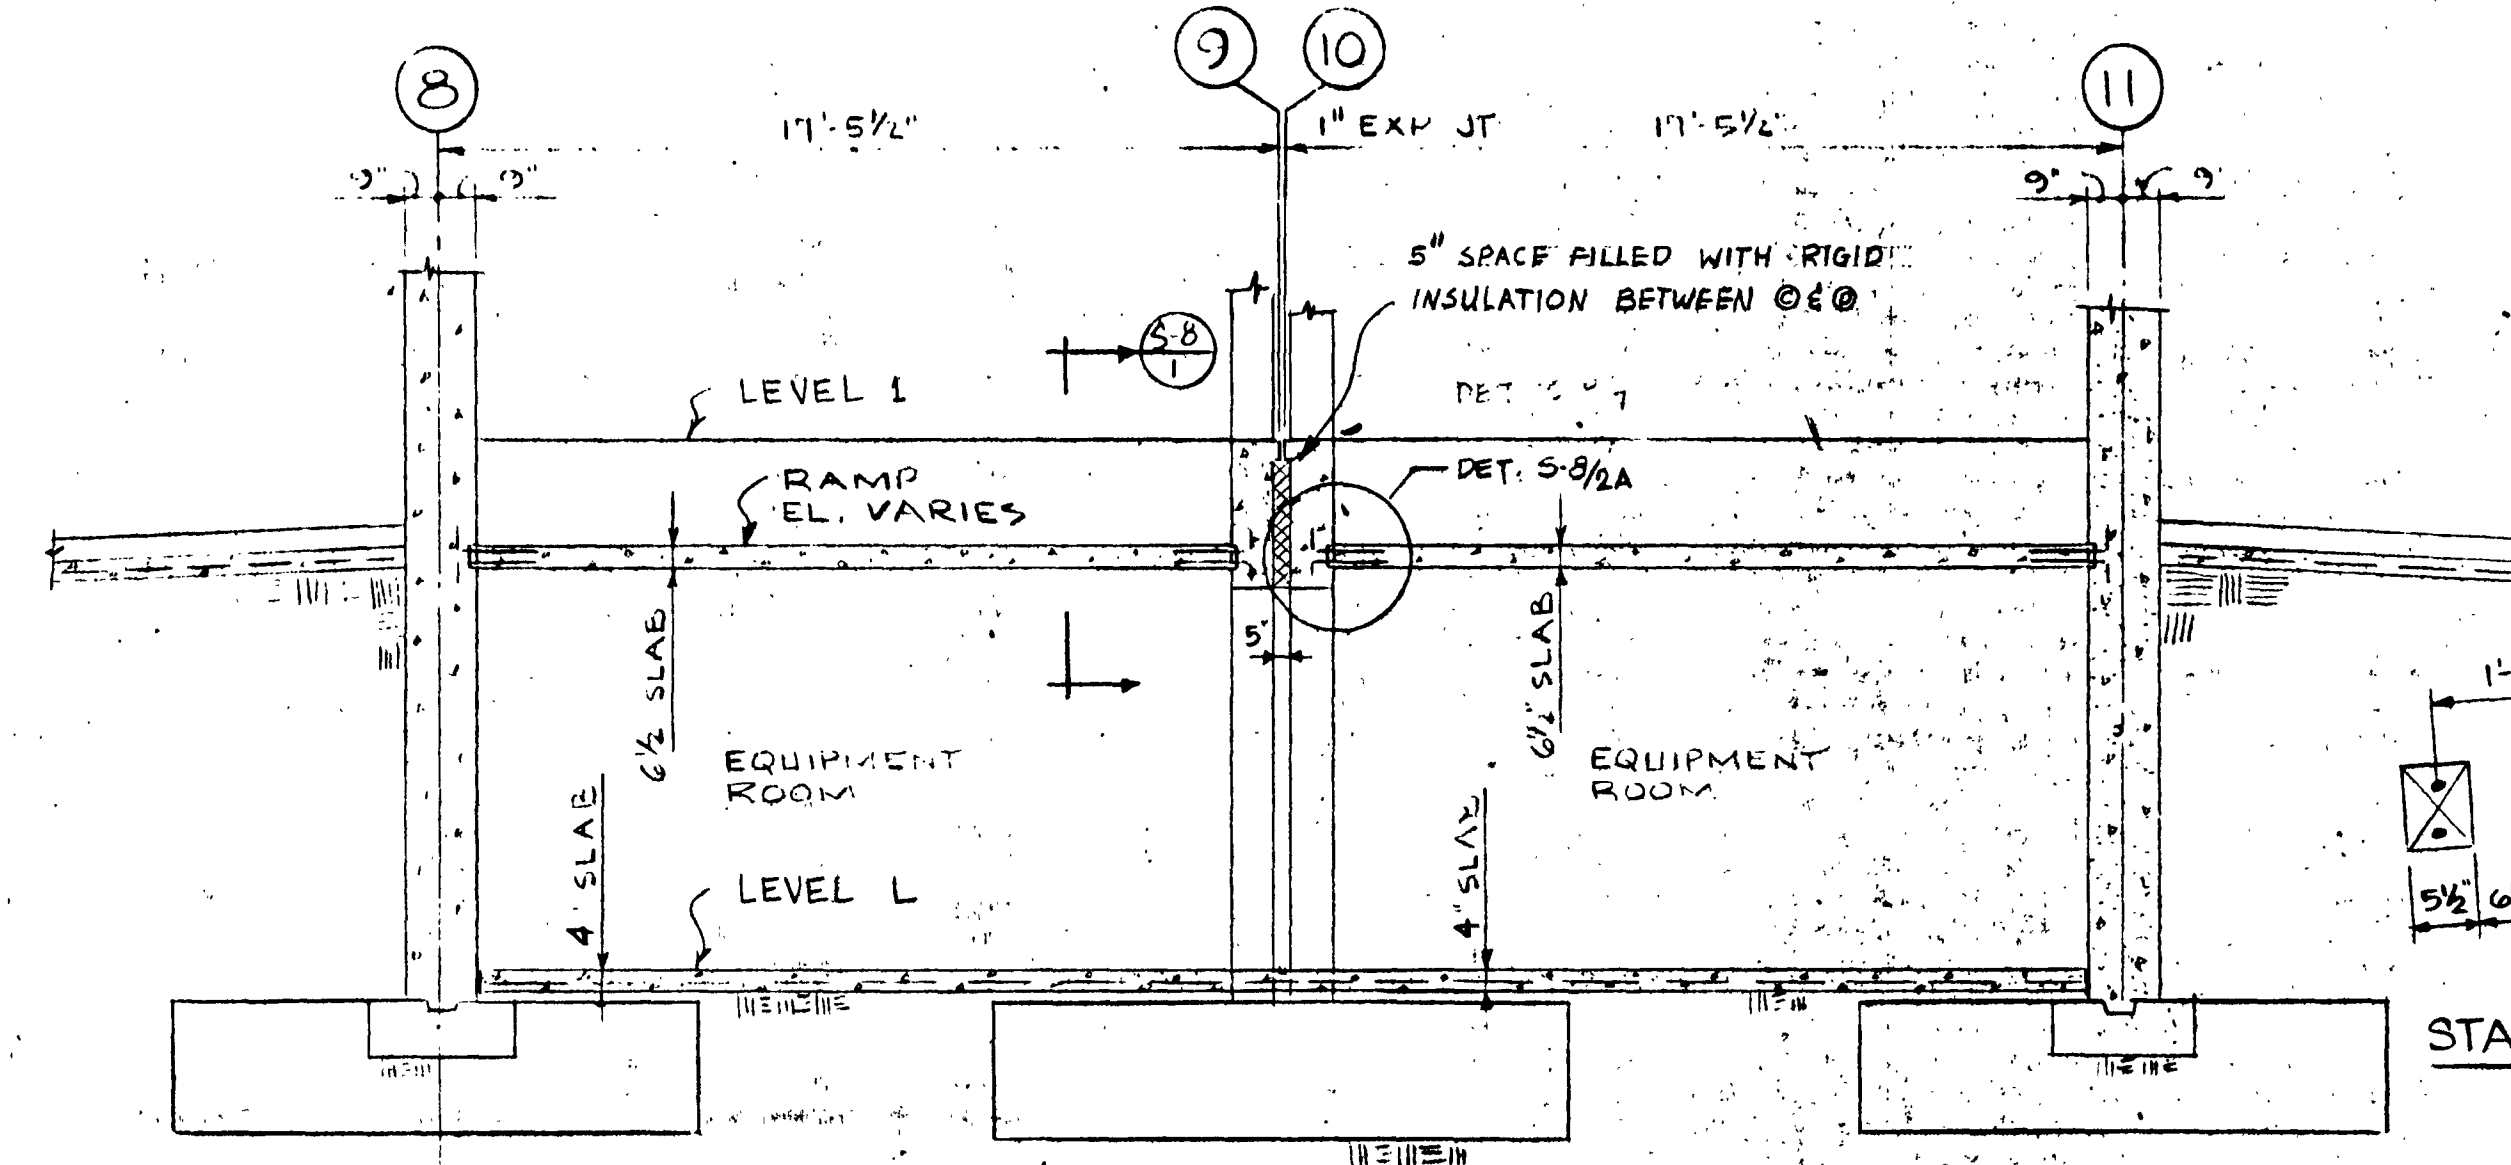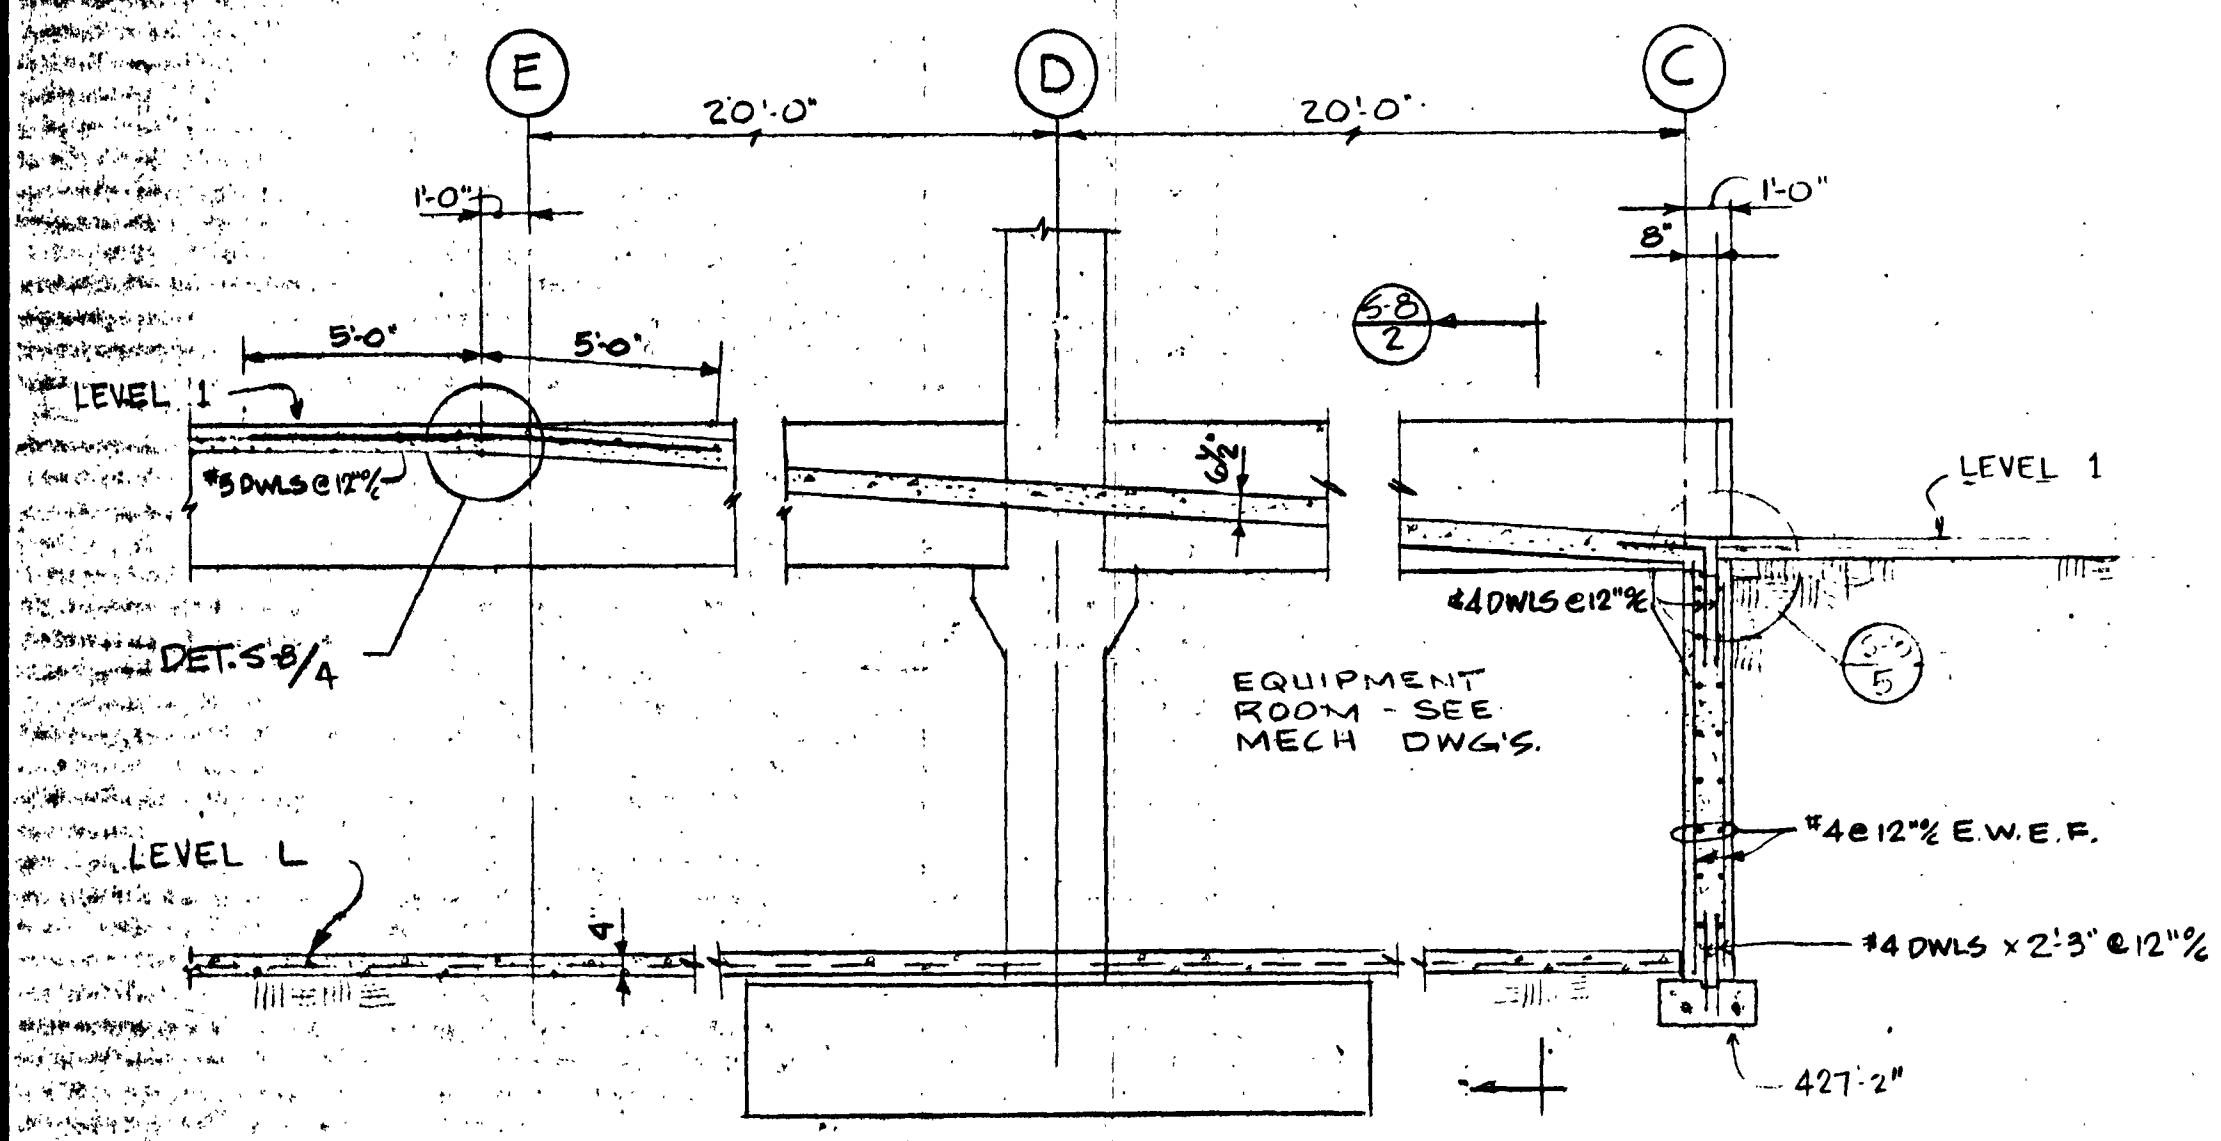


JOB NO. 75-37734
DATE: 6-27-74

ARCHITECTS • ENGINEERS • SURVEYORS
601 COLLEGE ROAD, FAIRBANKS, ALASKA 99701, PHONE: 452-1241


STATE OF ALASKA
DEPT. OF PUBLIC WORKS
DIVISION OF BUILDINGS
EUNEAU ALASKA

FAIRBANKS PARKING STRUCTURE
DBA - 2 - 0130
FAIRBANKS, AK.

STRUCTURAL DET

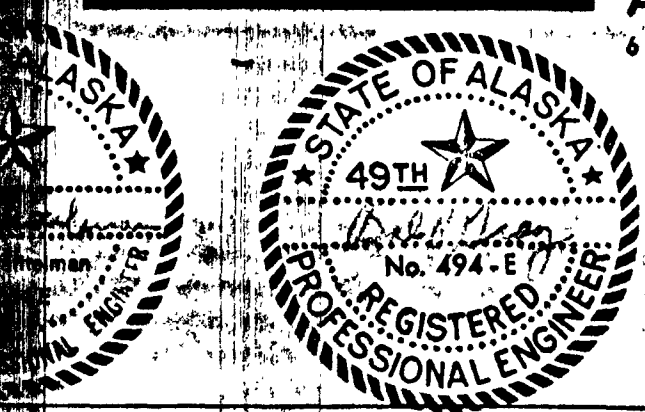


PETER KENNY SCOTT CO.
DATE: _____
AS-BLT SHEET 28

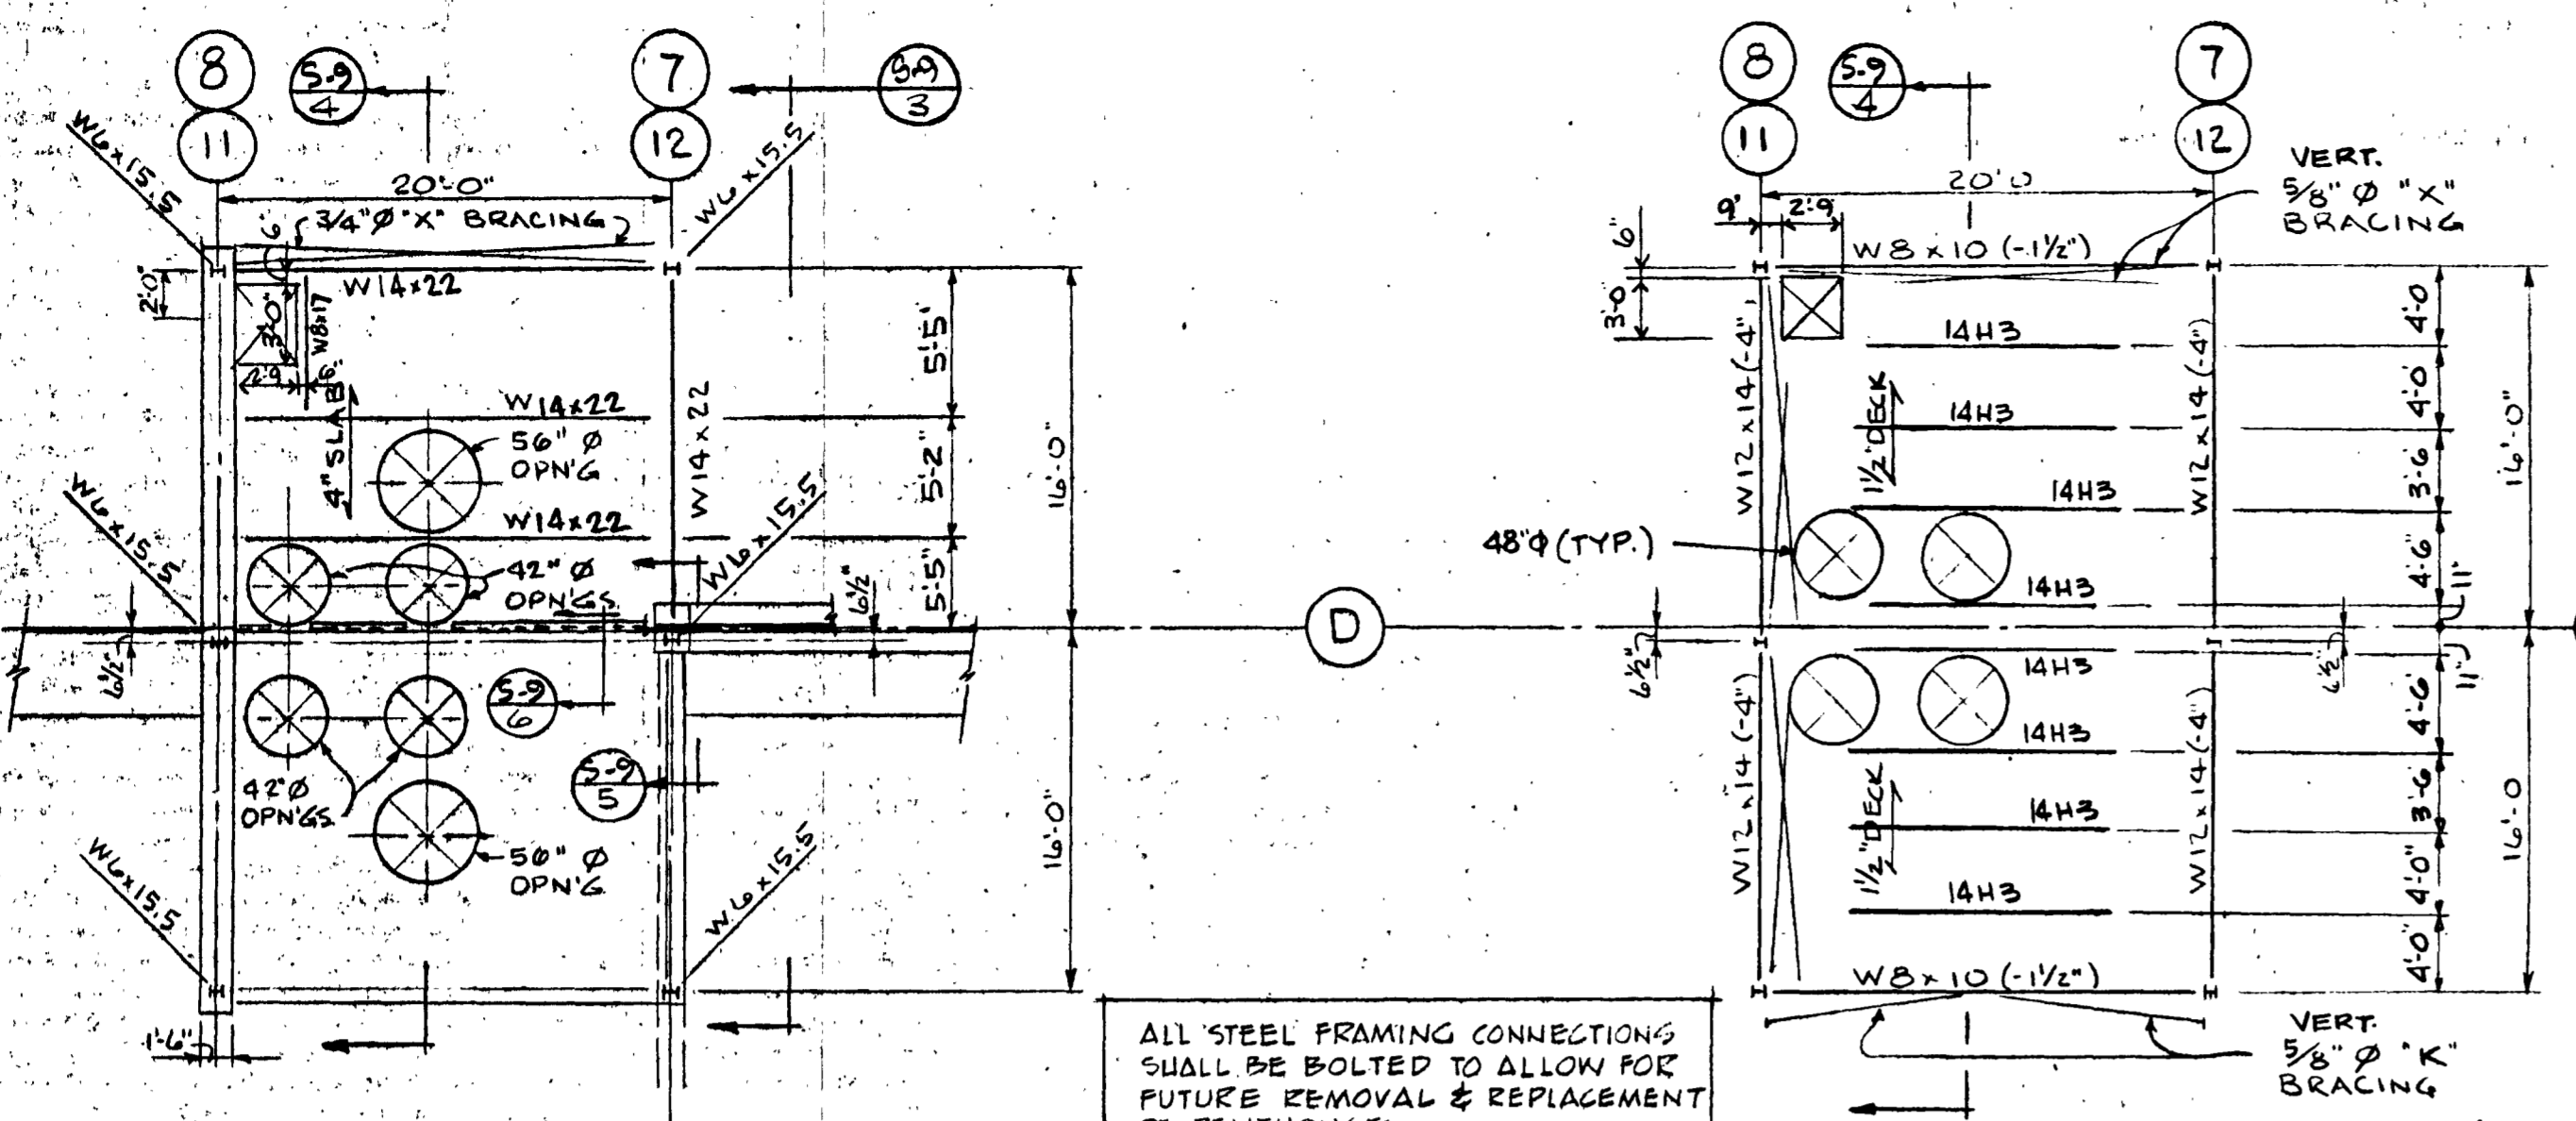

PART PLAN
SCALE: 1/8" = 1'-0"
(MECH. EQUIP. ROOM ROOF)

- NOTES:**
1. REFER TO ARCH. DRAWINGS FOR LOC. OF CURB AROUND MECH. EQUIP. ROOM.
 2. VERIFY OPNG LOC. W/ MECH. CONTRACTOR.
 3. TOP OF 1/2" (20 GA.) TYPE A METAL ROOF DECK EL. 475.42'
 4. ROOF BMS SHOWN THUS (4) FROM EL. 475.42'
 5. JOIST TO BOLT TO BEAM W/ 2-1/2" DIA. BOLTS @ 3/2" GAGE EA END IN LIEU OF WELDING. STEEL FABRICATOR TO PROVIDE HOLES IN TOP BEAM FLANGE TO RECEIVE JOIST BOLTS.

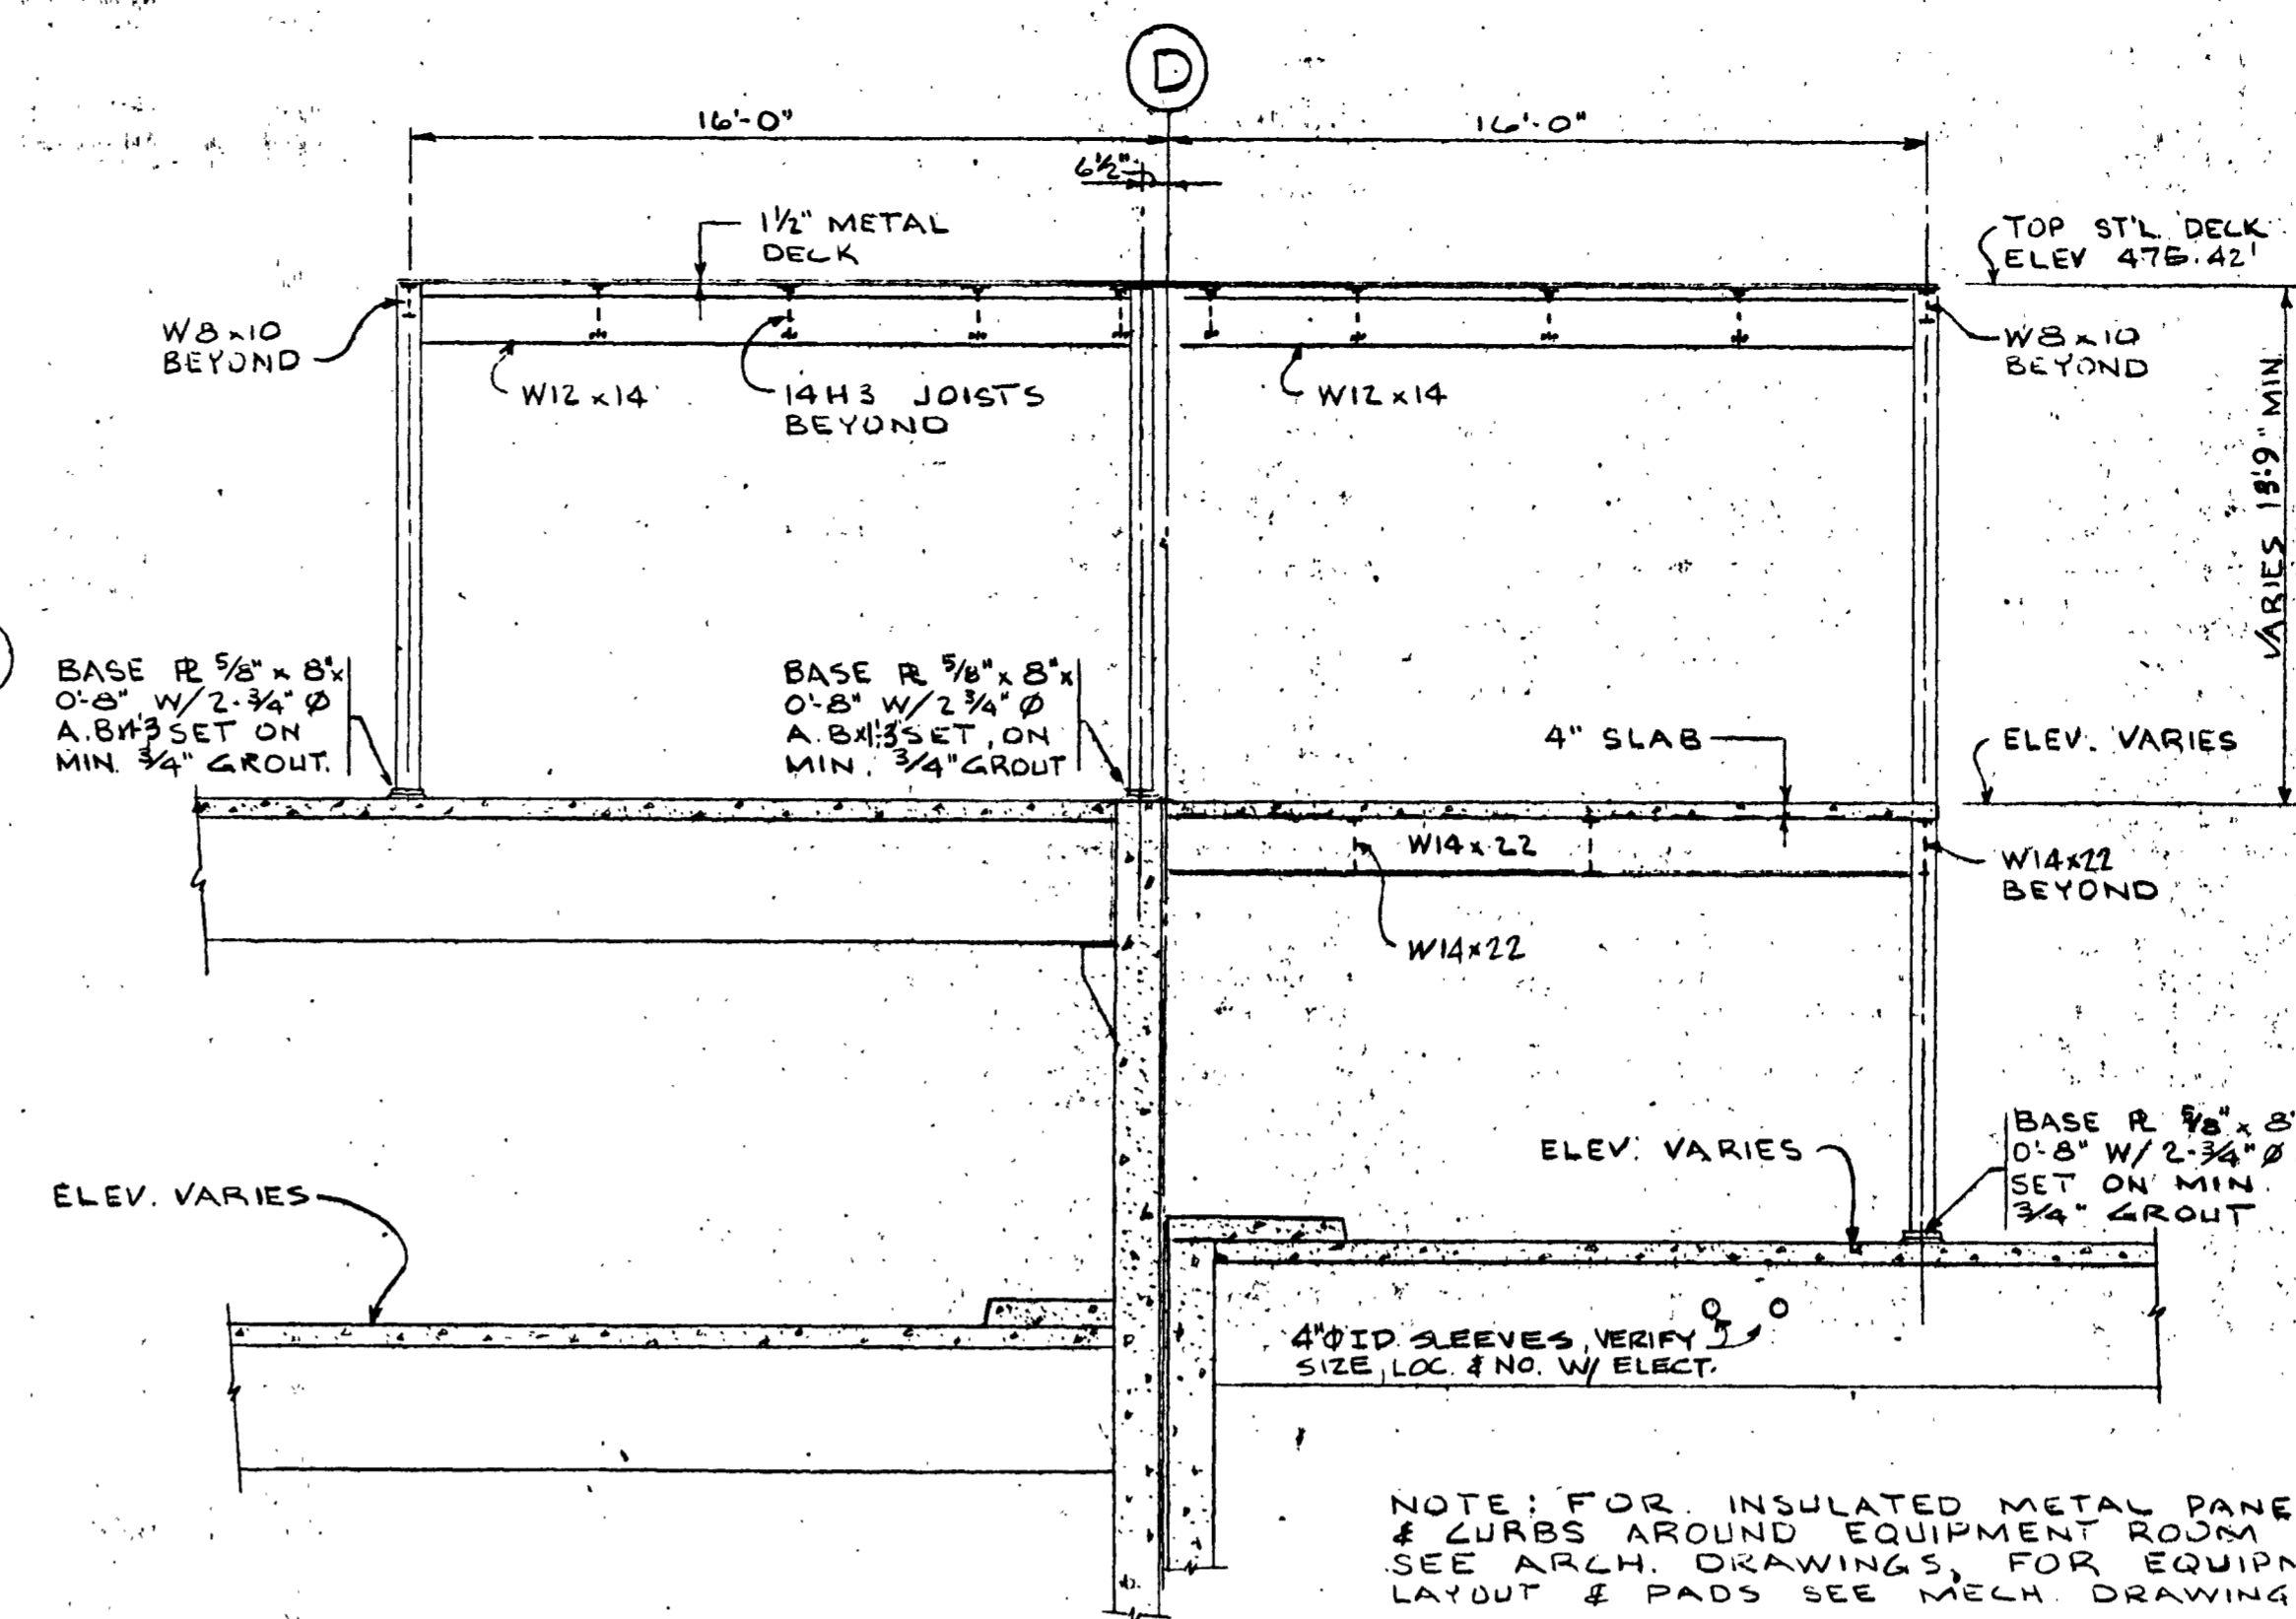

SECTION (3)
SCALE: 1/4" = 1'-0"
NOTE: ALL STEEL COLUMN ANCH. BOLTS 1-3 LG.

SEE TABLE FOR NO. AND SIZE OF R.S. A-325 BOLTS.



SPAN DEPTH (INCHES)	NO. OF R.S. A-325 BOLTS	CORNER ANGLE	1/4" R.S. WELD SIZE	1/2" R.S. WELD SIZE
18	20	2-2 1/2"	1/4"	5/16"
24	24	2-2 1/2"	1/4"	5/16"
30	28	2-2 1/2"	1/4"	5/16"
1398	940	2-2 1/2"	1/4"	5/16"
14				

BEAM SCHEDULE

"A" DIMENSION AT NORTH OR WEST




NUMBER	SIZE	NO. & SIZE	L	BOL.	TOP	HOOK	A	B	D	F	G	S	HOOK	SECTION
B-1	12x14	3#7	30-9	✓	✓	✓	3-0				7-9	20-0		
B-2	12x14	3#6	24-3	✓	✓	✓	3-0				1-3			
B-3	12x14	3#6		✓	✓	✓	1-3				7-9	13-5		
B-4	12x14	3#9	35-9	✓	✓	✓	0-3				5-0	20-6		
B-5	12x36	3#6	8-6	✓	✓	✓				8-0	0-6	16-10		
B-6	12x14	3#7	21-7	✓	✓	✓	0-6				3-0	18-1		
B-7	12x36	3#6	2-9	✓	✓	✓	9-10							
B-7A	12x26	3#6	2-9	✓	✓	✓				0-7	2-2	2-4		
B-8	8x26	2#6	22-1	✓	✓	✓	0-3				0-1	22-9		
B-9	12x16	2#7	12-3	✓	✓	✓	0-6				0-6	11-3		
B-10	12x36	3#7		✓	✓	✓	0-6							
B-11	12x36	3#8	38-5	✓	✓	✓	0-6				3-0	34-11		
B-12	14x64	4#6	20-0	✓	✓	✓	0-9				11-5	7-10		
B-13	14x64	4#6	20-0	✓	✓	✓	0-9				11-5			
B-14	12x16	2#7	12-3	✓	✓	✓	0-6				0-6	11-3		
B-15	8x16	2#5	7-4	✓	✓	✓	1-3				0-3	5-10		
B-16	8x16	2#5	6-0	✓	✓	✓				5-9	0-3	9-0		
B-17	8x24	2#5	11-11	✓	✓	✓	0-3			11-8		20-9		
B-18	8x16	2#5	9-3	✓	✓	✓	0-3				0-3	9-0		
B-19	8x20	3#8		✓	✓	✓	0-6				3-0	15-3		
B-20	8x18	2#6	21-3	✓	✓	✓	0-3				0-3	20-9		
B-21	8x18	2#5	9-2	✓	✓	✓	0-6				0-3	8-5		
B-22	12x18	2#6		✓	✓	✓	1-2				0-6			
B-23	12x18	2#6	16-2	✓	✓	✓	0-6				0-3	15-7		
B-24	12x18	2#6	17-10	✓	✓	✓	0-6				0-6	16-10		
B-25	8x18	2#6	22-1	✓	✓	✓	0-3				0-1	21-9		
B-26	12x18	2#7	17-9	✓	✓	✓	0-6				0-6	16-9		
B-27	12x18	2#7	9-6	✓	✓	✓	0-3				0-3	9-0		
B-28	12x18	2#8	25-4	✓	✓	✓	4-0				0-3	21-1		

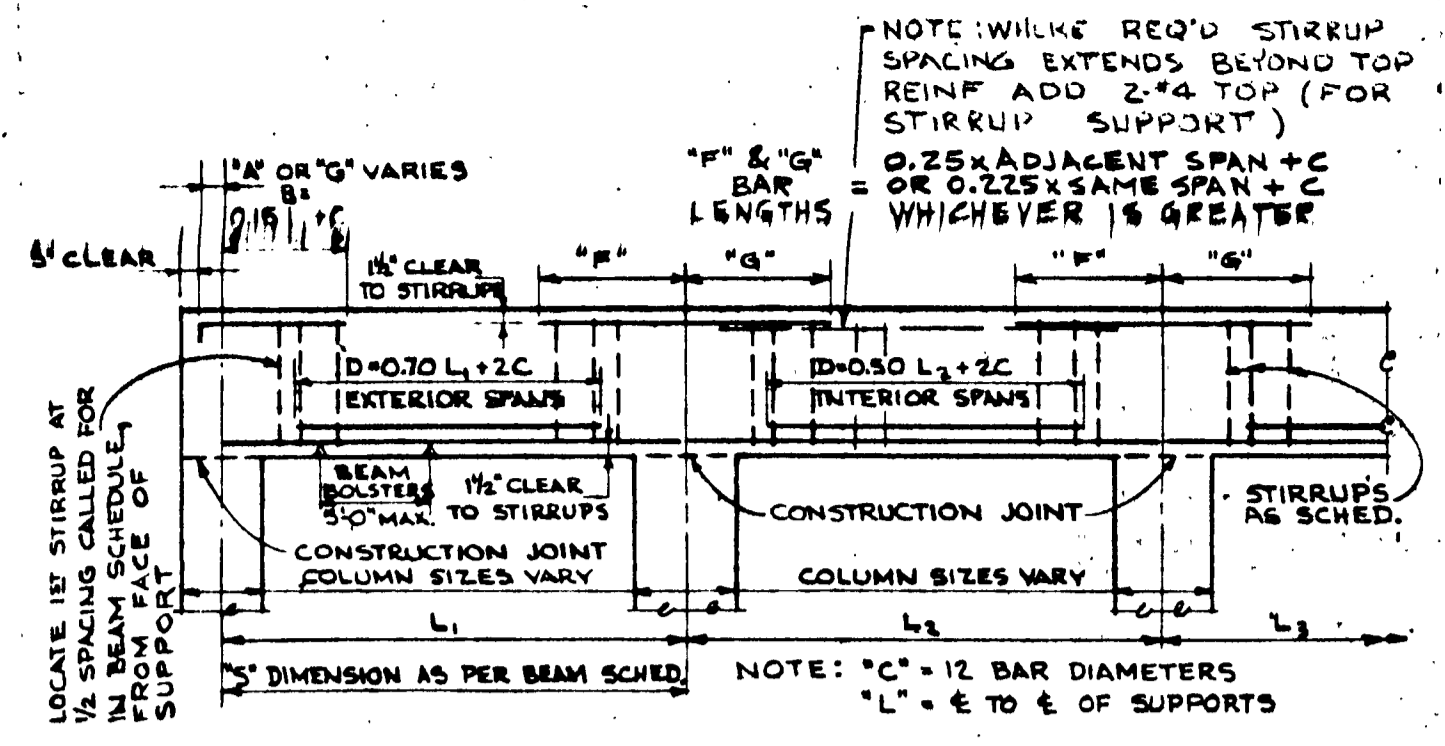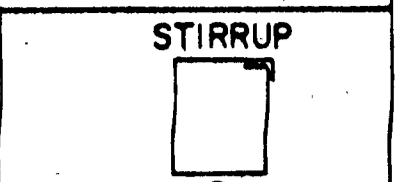


TYPICAL BEAM DIAGRAM

- NOTES:
- UNLESS SHOWN OTHERWISE IN BEAM SCHEDULE, THE FOLLOWING CONDITIONS SHALL GOVERN FABRICATION OF REINFORCING STEEL: ALL LENGTHS GIVEN IN SCHEDULE ARE FINISHED BAR LENGTHS AND DO NOT INCLUDE ADDITION OR REDUCTION REQUIRED FOR MAKING BENDS ALL VARIATIONS FROM TYPICAL DIAGRAM ARE NOTED IN SCHEDULE.
 - FOR SPANDREL BEAMS LAP TOP BARS 12" MINIMUM.

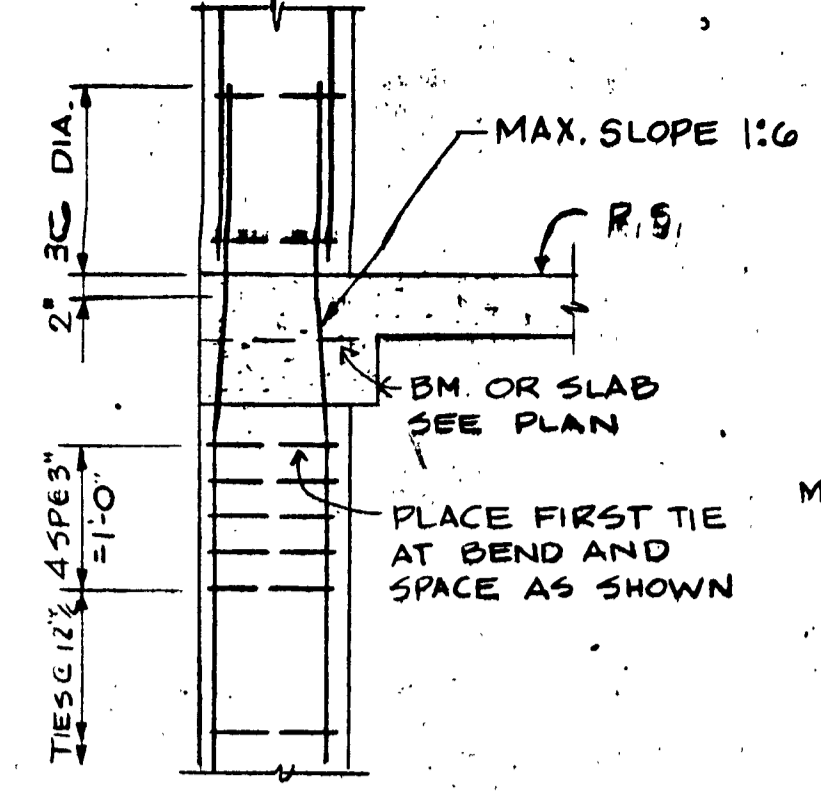

EXTERIOR TIED

NOTE: ALL COLUMN TIES TO BE #3 @ 12" MIN. U.N.

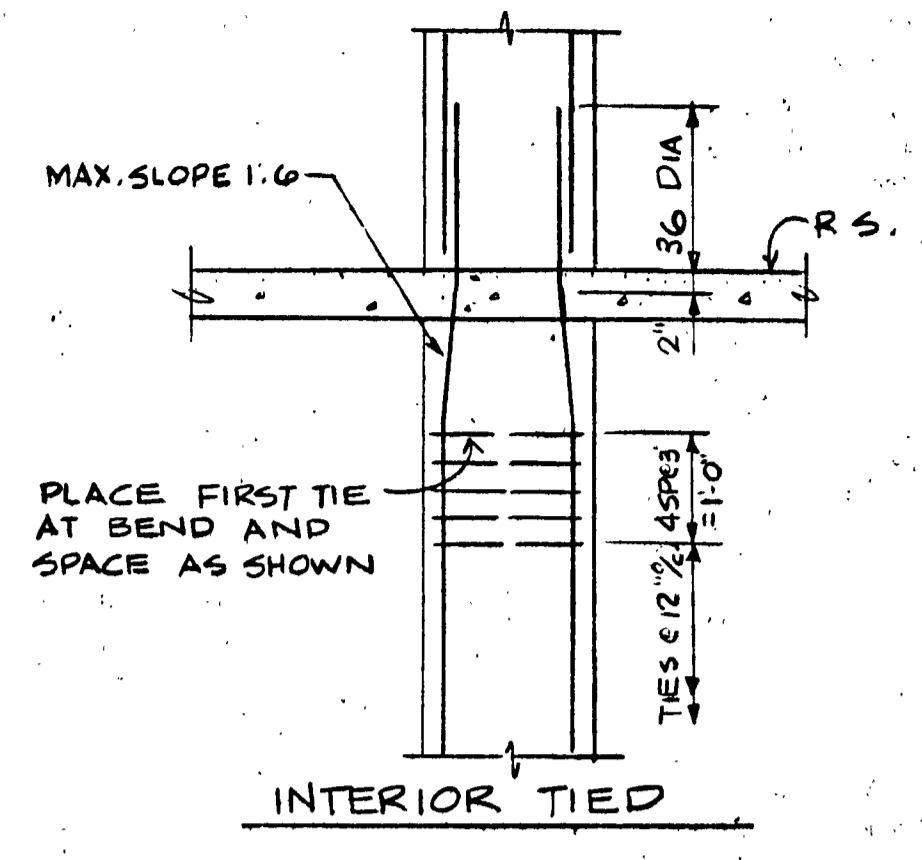

INTERIOR TIED

GRAY ROGERS MYERS & MORGAN

A DIVISION OF ELLERBE

Sheets S-1 thru S-14 indicate a cast-in-place post-tensioned beam and slab structural system. The quantities of post-tensioning force and materials along with the quantities of conventional reinforcing shown on Sheet S-1 thru S-14 are the Engineer's solution to sustain the gravity floor loads as indicated on the plans and meet the indicated code requirements. The Engineer is aware that there may be other combinations of post-tensioning materials and conventional reinforcing materials that will adequately sustain the gravity floor loads and still meet the indicated code requirements. The Contractor may at his own option submit an alternate design to the post-tensioned beam and slab structural system only utilizing other combinations of post-tensioning and conventional reinforcing materials. Member sizes, widths, thicknesses, lengths, depths, etc. shall remain as indicated on the drawings. The proposed alternate design for the post-tensioned beam and slab structural system shall be submitted to the Engineer for approval prior to the commencement of any work. The submitted alternate design shall clearly indicate the amounts of post-tensioning materials and conventional reinforcing materials to be used and all pertinent details. The submitted alternate design shall be accompanied by structural calculations done under the supervision of a registered professional engineer experienced in post-tensioned concrete design. These calculations shall clearly indicate the post-tensioning force assumed, friction losses assumed, conventional reinforcing used, working stresses, shear reinforcement calculations, ultimate moment capacity, and all other pertinent calculations required to satisfy the ACI 318-71 Code and the Uniform Building Code 1973.

FUTURE 3RD LEVEL

COLUMN SCHEDULE


POURED-IN-PLACE COLUMNS

COLUMN NUMBER	A-3-1*	A-7-17	A-15, 2, 6 THRU 13, 17, 17, 7	D-2	D-9	G-8	B-1-1, 3*	A-7-17, 7
SUPPORTING	A-3-18*	F-7-1	Dw-4, 15, 16, De-3, 4, 15, 16	D-17	D-10	G-9	G-10	A-7-17, 7
STAIR TOWER	F-7-18		F-1, 15, G-1, 2, 6, 7, 13, 12, 17			G-11		
SIZE	4*7		12x18				8x16	
REINF.			4*7					
LEVEL R			12x18	18x25	16x18	12x18	8x16	
ROOF	4*8		4*8	4*10	4*8	4*8		
LEVEL 2	4*10	14x14	12x18	18x25	16x18	12x18	8x16	8x16
LEVEL 1	4*10	4*7	4*10	6*10	4*10	4*10	4*6	
SECTION	1	2	2	2, 4, 3	2	2	2	2


SEE S-14 FOR COLUMN TIE REQUIREMENTS & CORNER DETAILS FOR PRECAST GIRDER TOWER

EXTEND COL. REINF. BARS (GENERAL) 18" AT ROOF LEVEL (FUTURE 3RD LEVEL) FOR FUTURE COLUMNS. ENCLOSE IN CONC. FLK. - SEE S-14

EXTEND REINF. BARS 4" AT ROOF LEVEL STAIRS. SEE S-14 - ALSO ALL COLS. ON A.G. 1 & 2

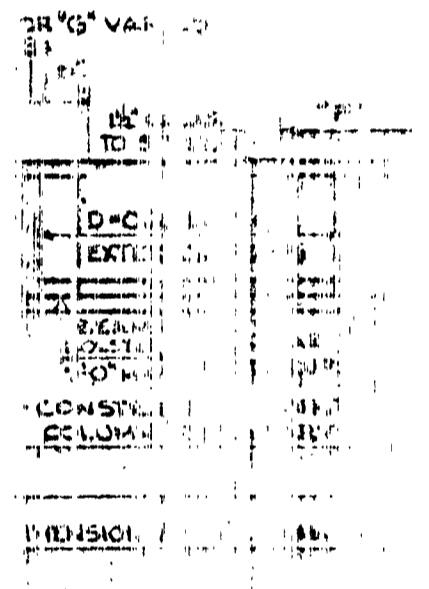


- NOTES:
- UNLESS SHOWN OTHERWISE, ALL COLUMN TIES SHALL BE #3 @ 12" MIN. U.N.
 - SEE S-14 FOR REINFORCING SCHEDULE
 - SEE S-14 FOR REINFORCING SCHEDULE
 - SEE S-14 FOR REINFORCING SCHEDULE

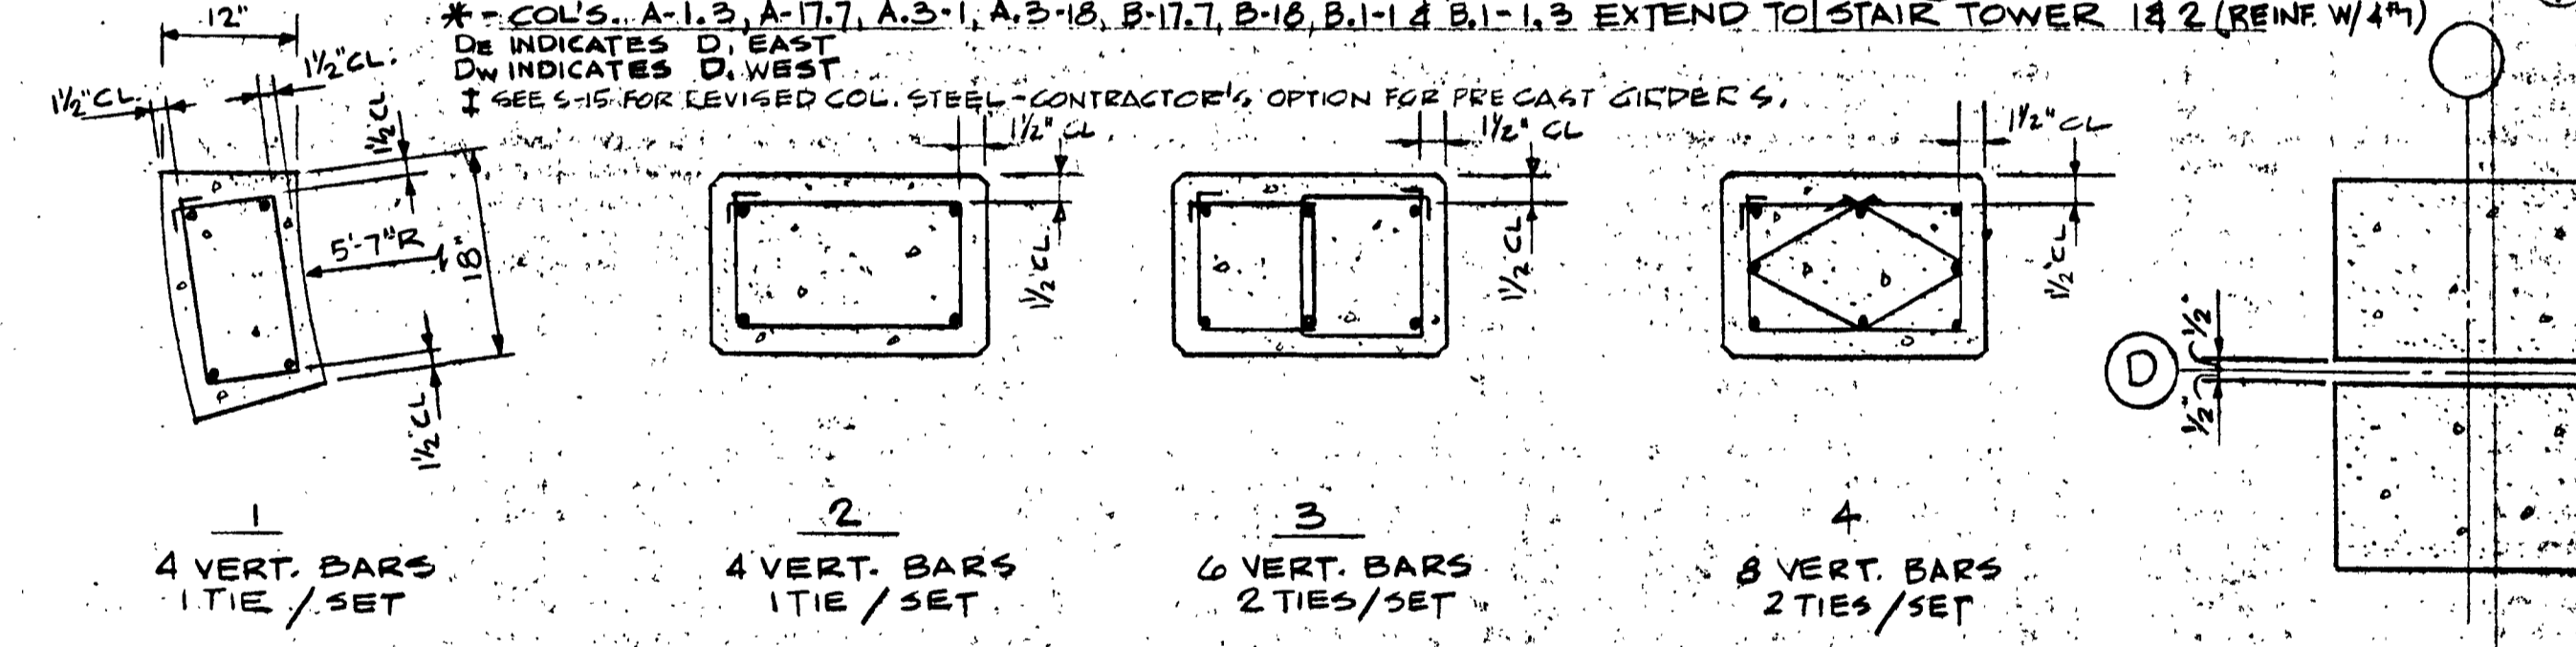

COLUMN SECTIONS

- NOTES: 1. FOR COL. SIZE & REINF. IN SHEAR WALLS SEE SHTS. S-11, S-12 & S-13. 2. CHAMFER EXPOSED CORNERS OF COLUMNS 3/4" @ 45°. SEE DET. ON SHT. S-11

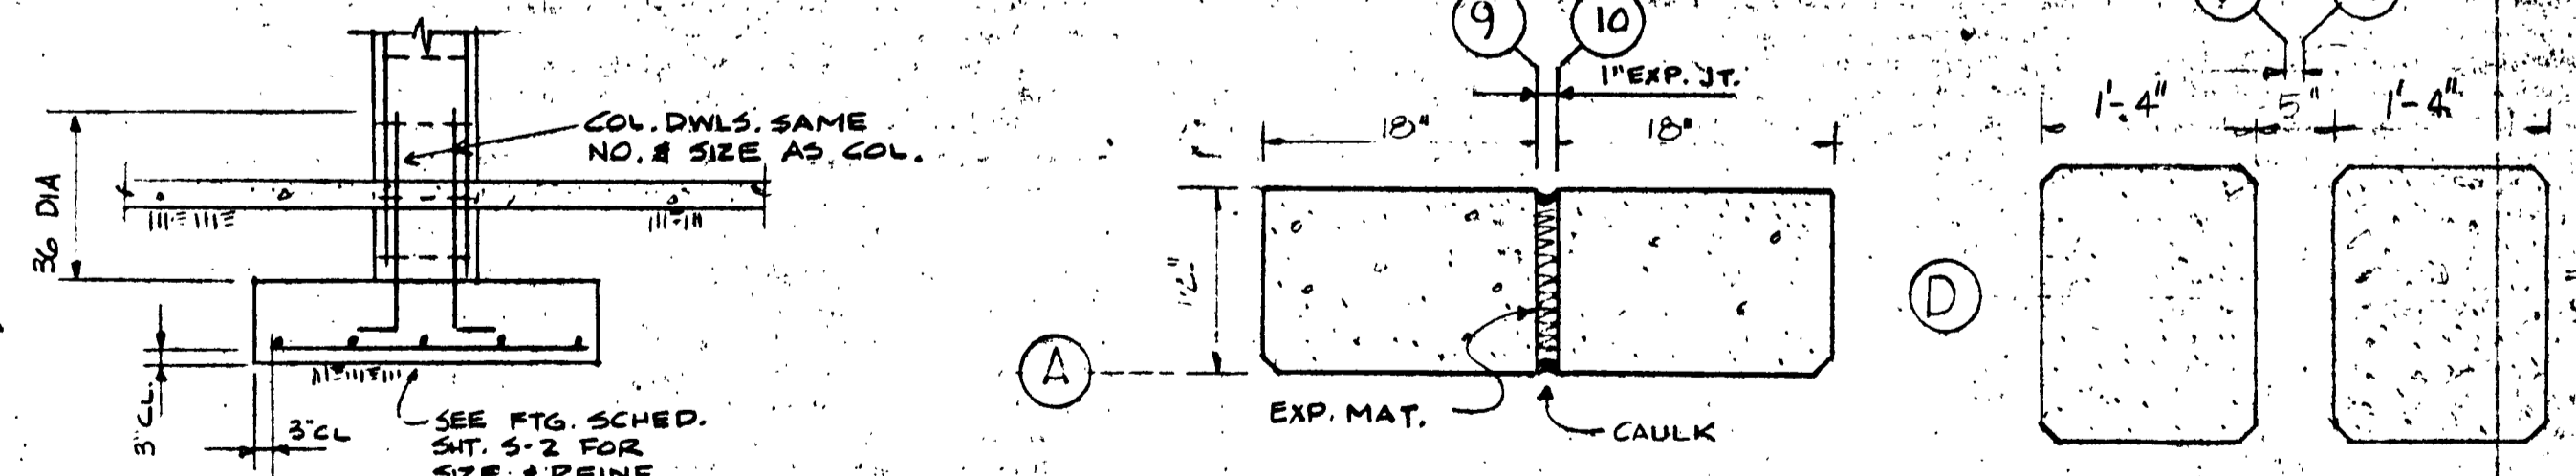

TYP. FOOTING DETAIL

POURED-IN-PLACE COL.

DETAIL 5-10

1" @ 12"

DETAIL 5-10

1" @ 12"

NOTE: CHAMFER CORNERS EXCEPT COLS. AT ROLLING DOOR JAMB'S

NOTES:
1. SEE PLAN DETAILS SHT. S-3, S-4 & S-5 FOR CURVED BEAMS
2. INDICATES BM. STIRRUPS TO BE CONT. & SPACING INDICATED.

JOB NO. 7374-734
DATE: 6-27-74

ARCHITECTS • ENGINEERS • SURVEYORS
601 COLLEGE ROAD, FAIRBANKS, ALASKA 99701, PHONE: 452-1241

STATE OF ALASKA
DEPT. OF PUBLIC WORKS
DIVISION OF BUILDINGS
JUNEAU ALASKA

FAIRBANKS PARKING STRUCTURE

DBA - 2 - 0130
FAIRBANKS, AK.


BEAM AND COLUMN SCHEDULE AND DETAILS

S-10

AS-BLT SHEET 30 OF 49

GRAY ROGERS MYERS & TORGAN

A DIVISION OF ELLERBE


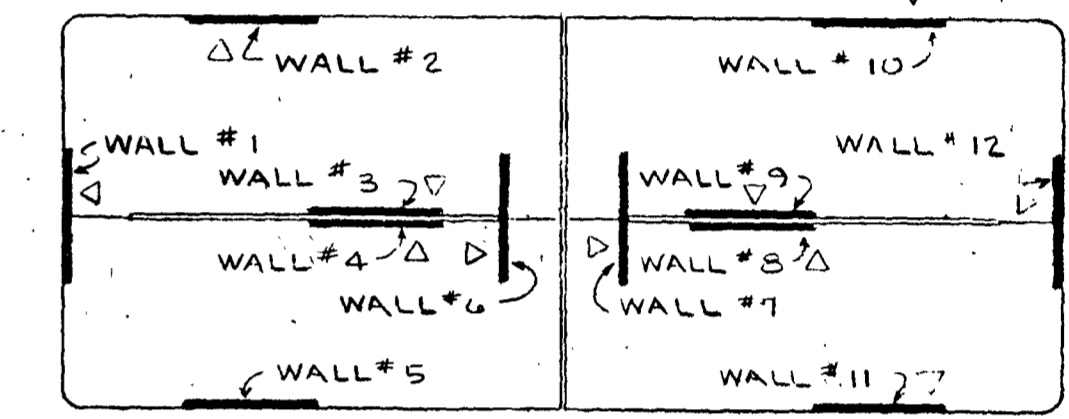


KEY PLAN


SHEAR WALL NOTES:

1. ALL HORIZONTAL REINFORCING SHALL BE HOOKED INTO CAGE OF BOUNDARY REINFORCING.
2. ALL VERTICALS SHALL BE FULLY DEVELOPED WITH DOWELS INTO THE FOOTING.
3. ALL SPLICES IN REINFORCING BE TREATED AS CLASS B TENSION LAP SPLICES AND SHALL BE STAGGERED SUCH THAT NOT MORE THAN 50% ARE SPLIKED AT A GIVEN SECTION.
4. TIES FOR BOUNDARY REINFORCING SHALL BE #4 @ 12" O.C. W/ 3 EXTRA TIES @ 3" SPACING AT BAR BENDS AND 10 EXTRA TIES @ 2" SPACING BELOW AND ABOVE BEAM BEARING POINTS.
5. ALL CONSTRUCTION JOINTS AND DETAILS MUST FOLLOW THOSE SHOWN ON THESE DRAWINGS.
6. SEE S-14/5 FOR TYPICAL POST-TENSIONED BEAM TO SHEAR WALL DETAIL.
7. SEE SHT. S-15 FOR HAUNCH DETAILS FOR PRECAST GIRDER OPTION.
8. PLACE ADDL #4 @ 4" VERT. @ 12" E.F. ALL HORIZ. CONSTRUCTION JOINTS IN SHEAR WALLS. SEE DETAIL AT LEFT.
9. ALL SHEAR WALL DETAILS INDICATED FOR P-T SYSTEM ONLY.


BAR SIZE	REQUIRED LAP
#5	20"
#6	24"
#7	30"
#8	36"
#9	42"
#10	48"
#11	63"
#12	77"

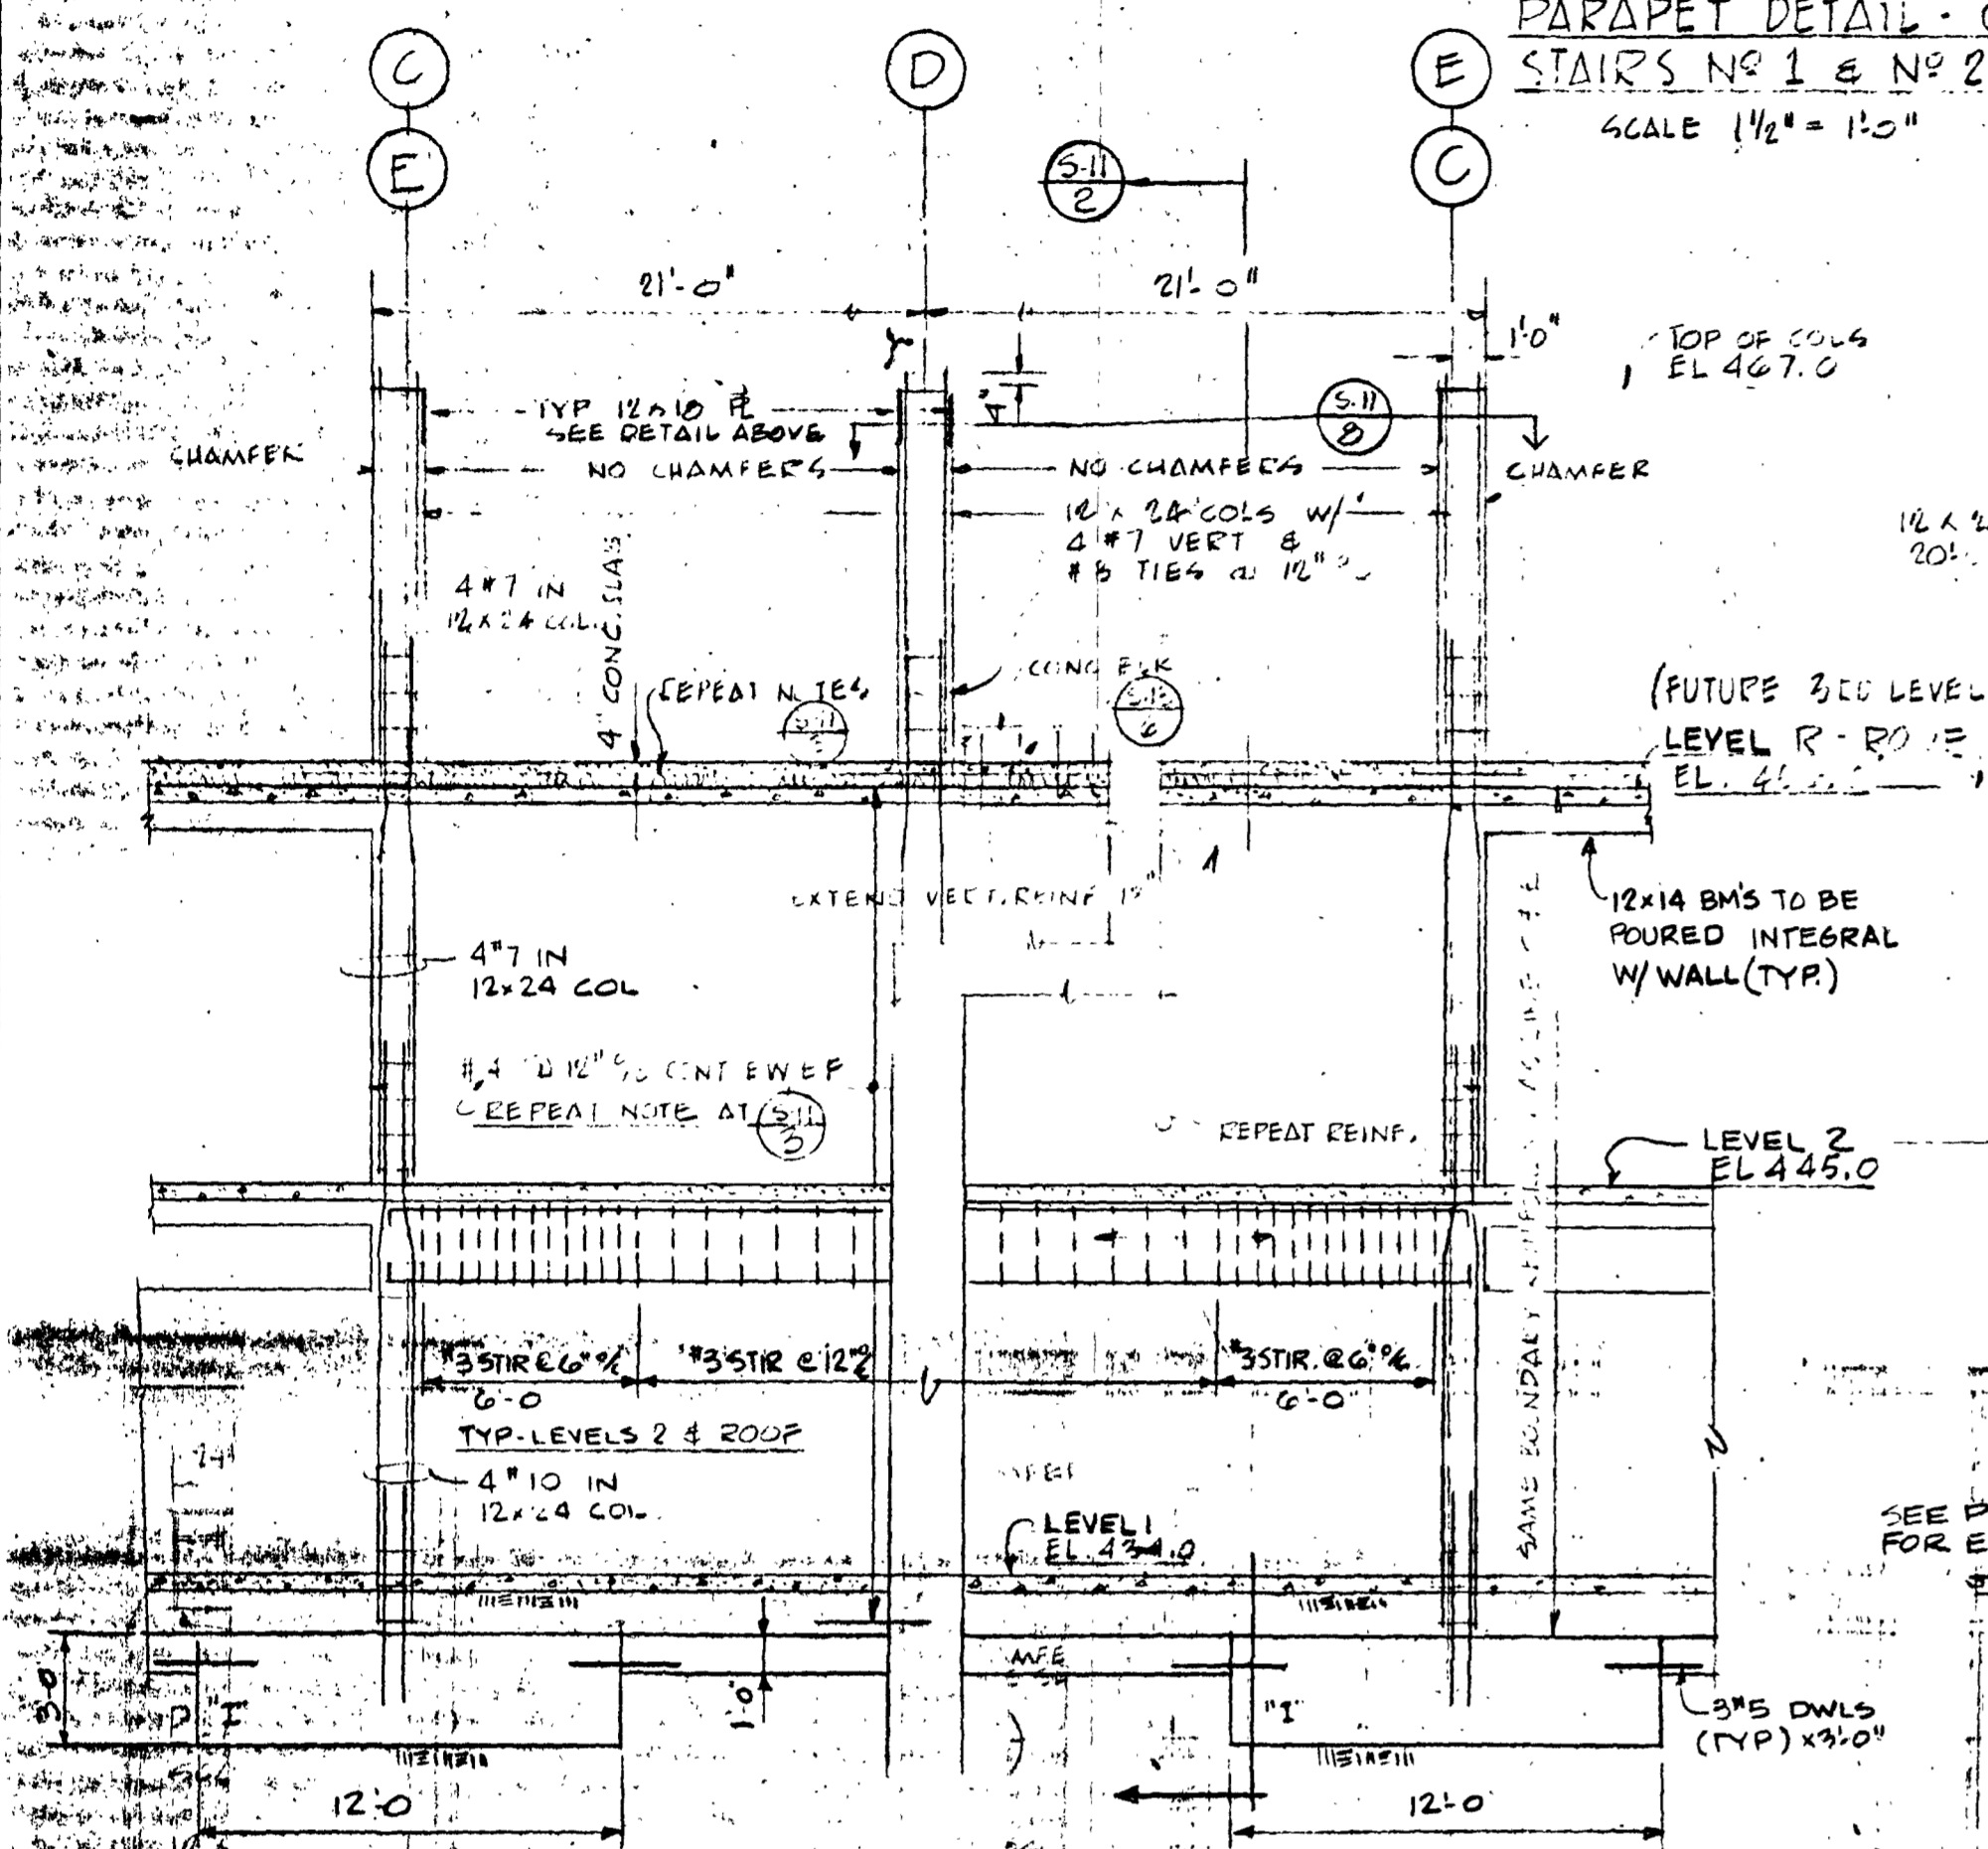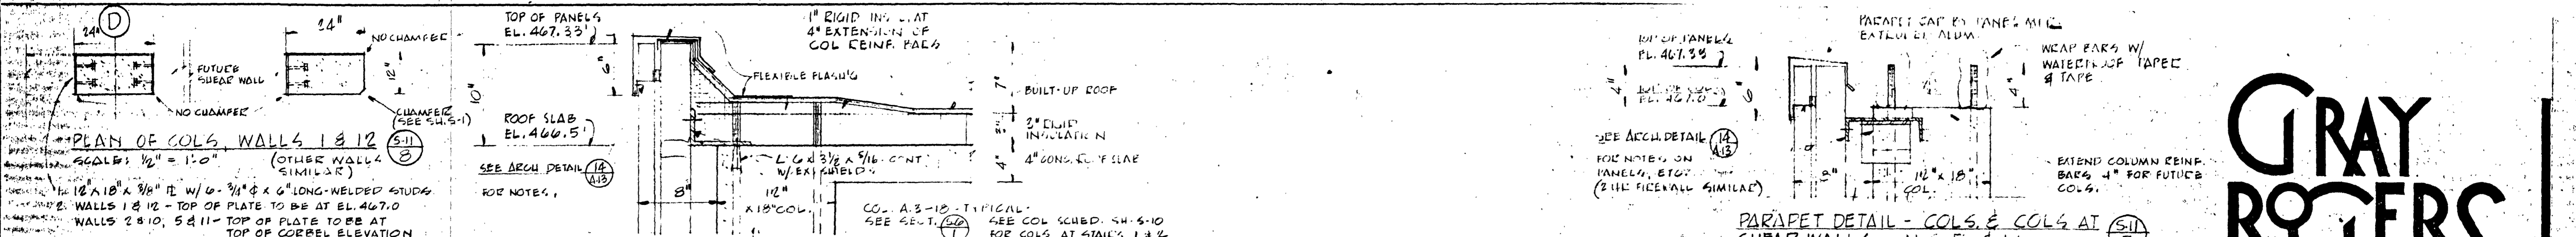


LOOKING NORTH WALL #1 & WALL #12 SCALE: 3/16" = 1'-0"

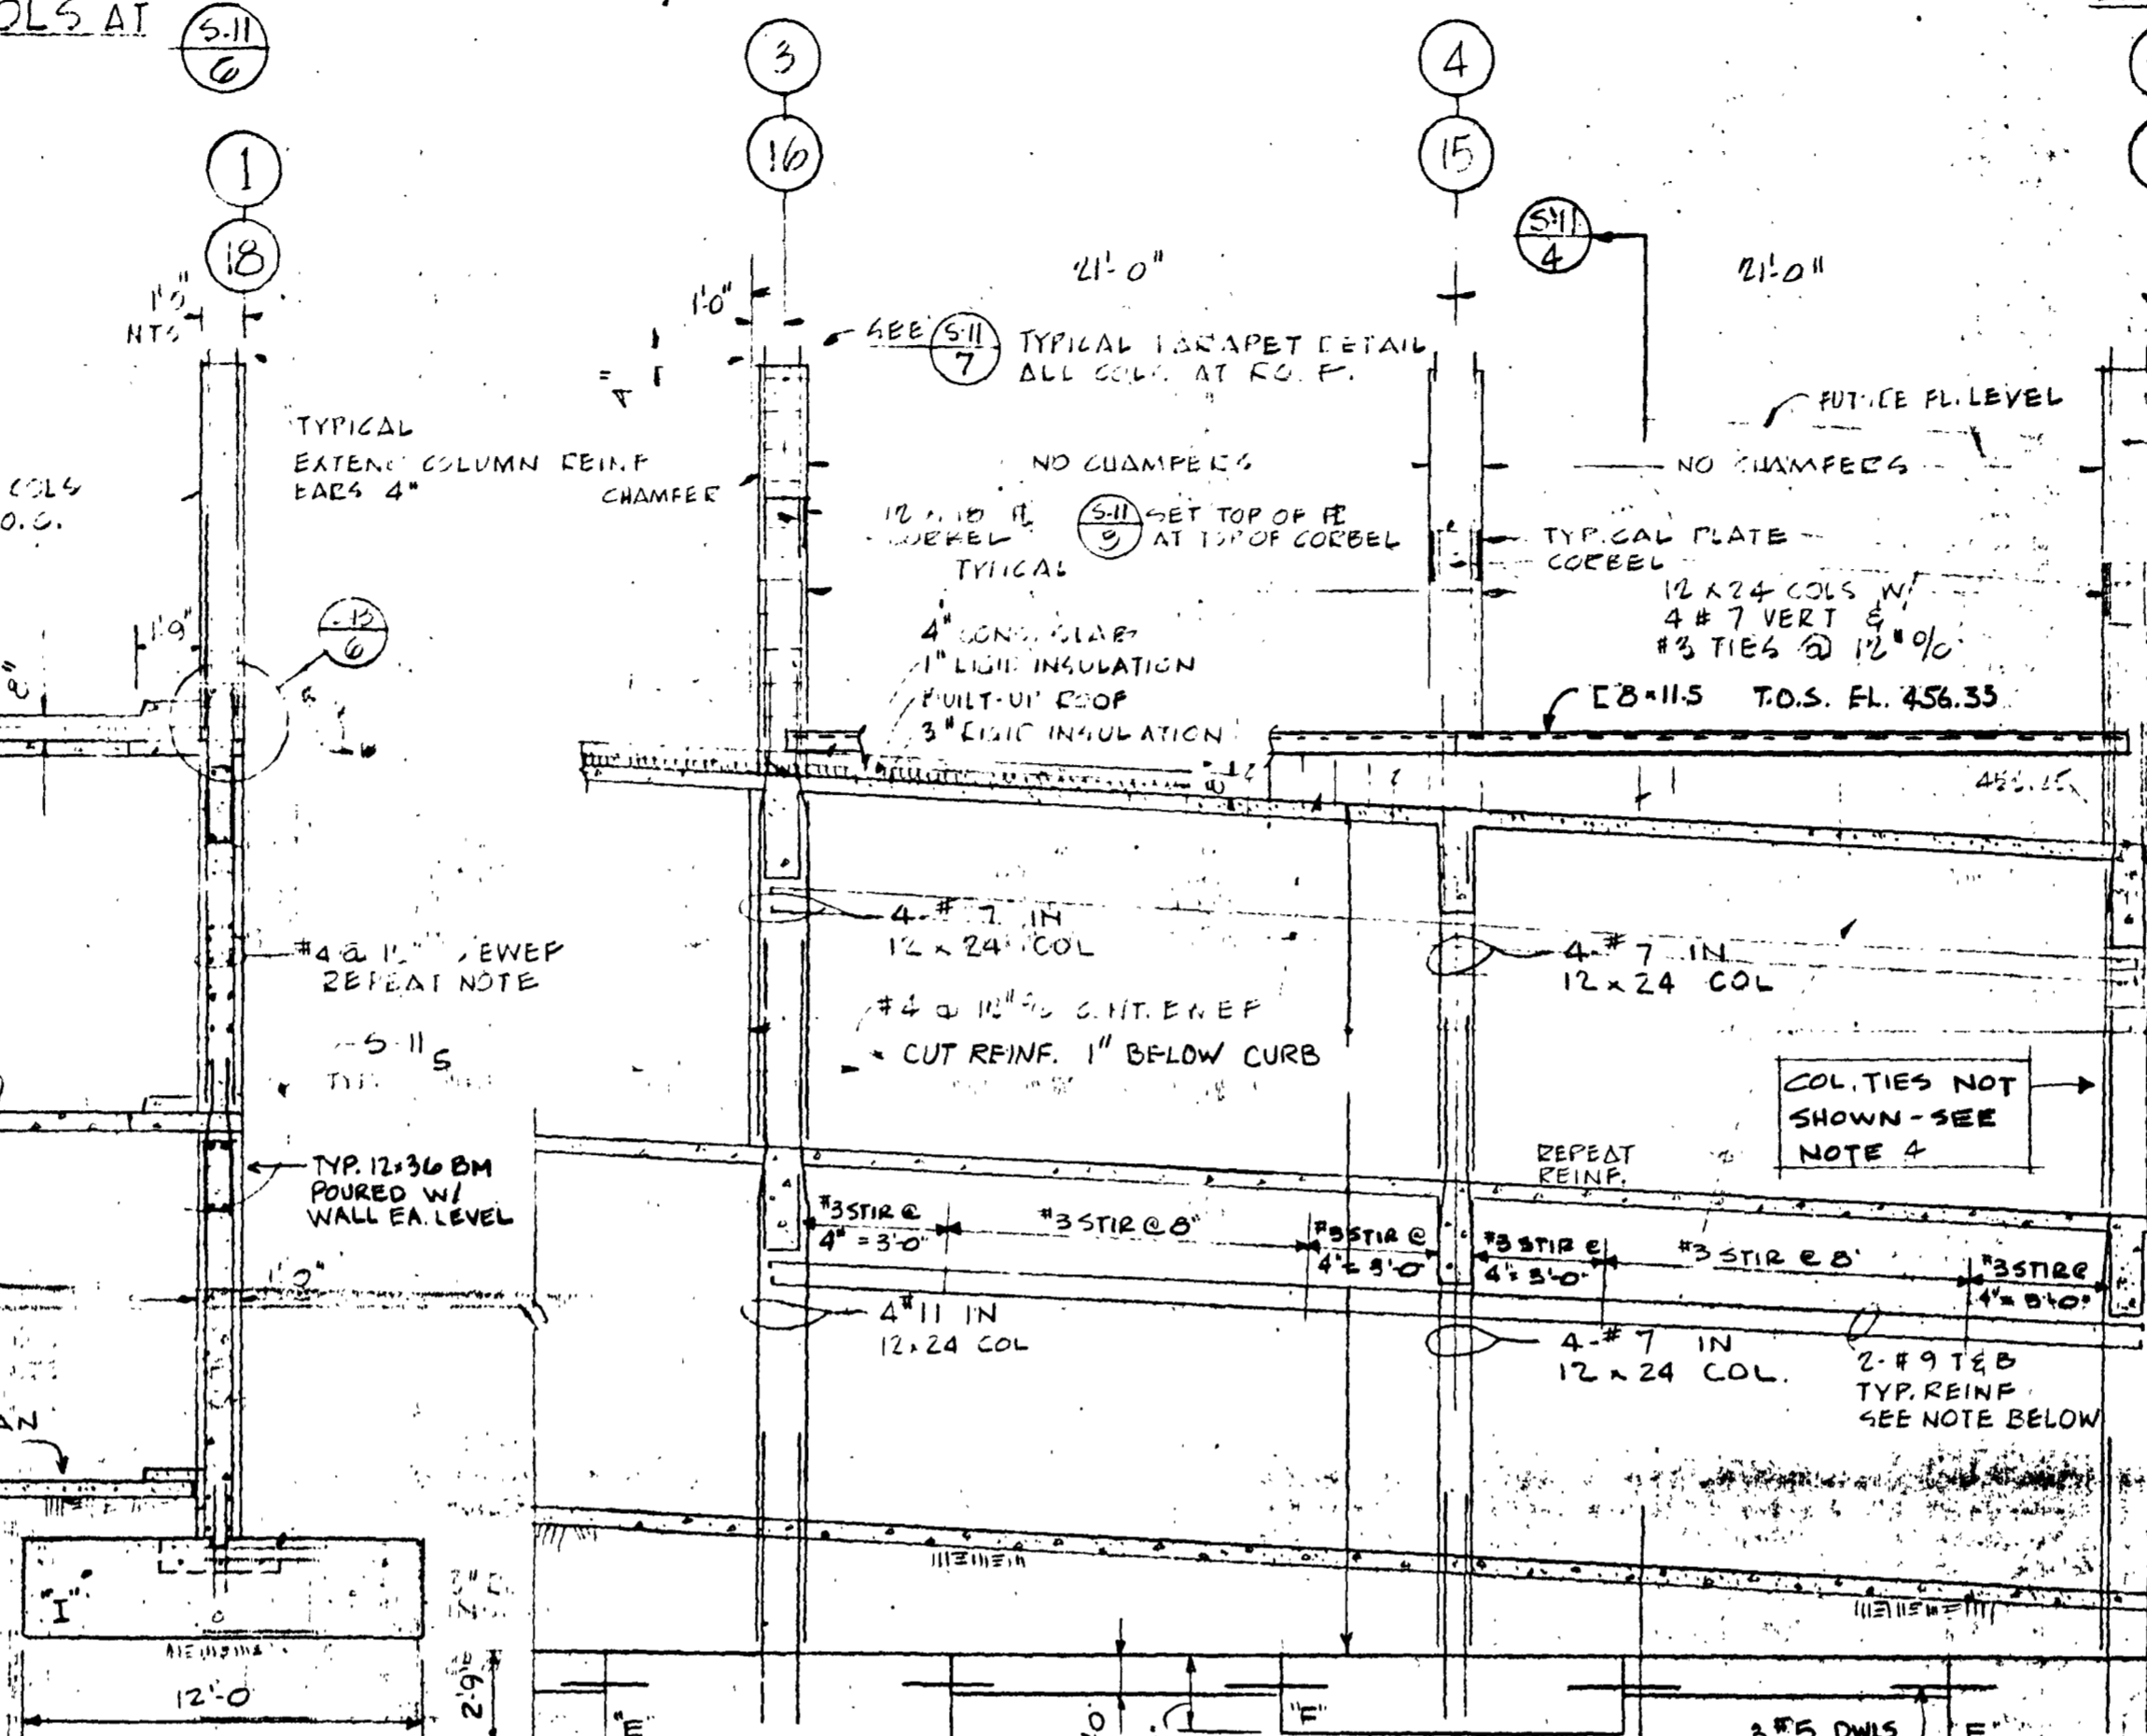


LOOKING EAST WALL #2 & WALL #10 SCALE: 3/16" = 1'-0"

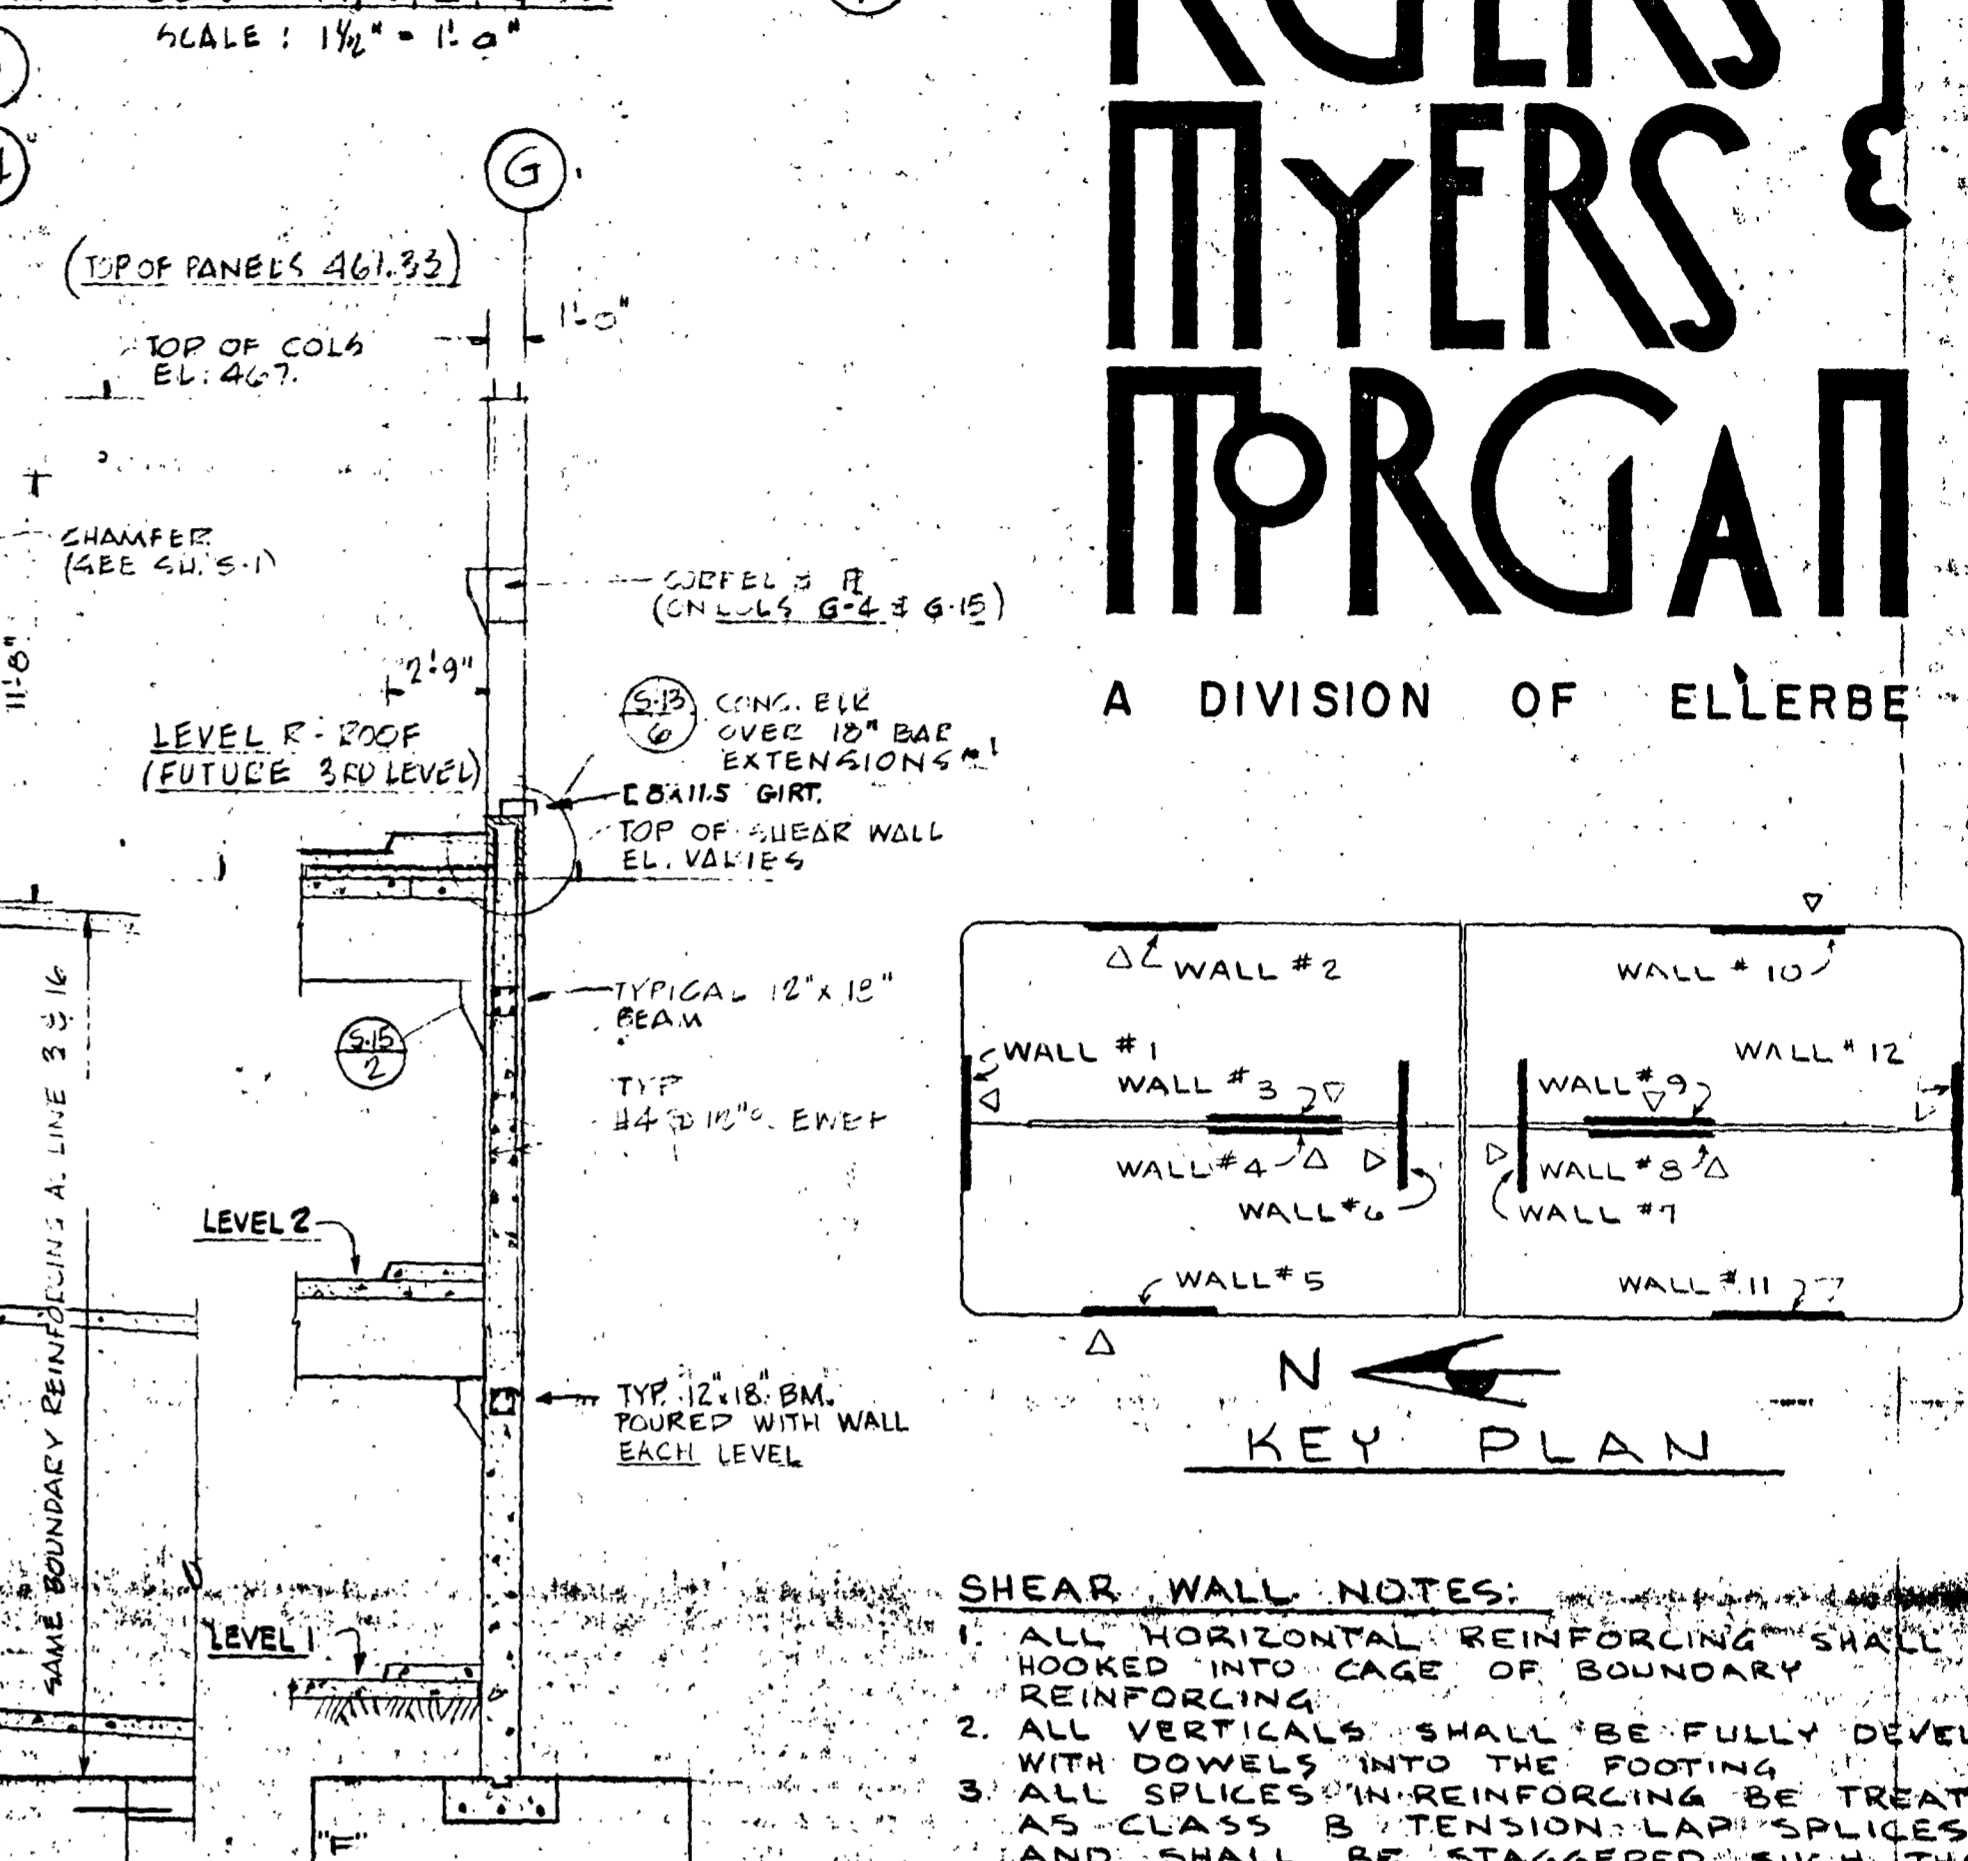


SECTION 5-11 SCALE: 3/16" = 1'-0"

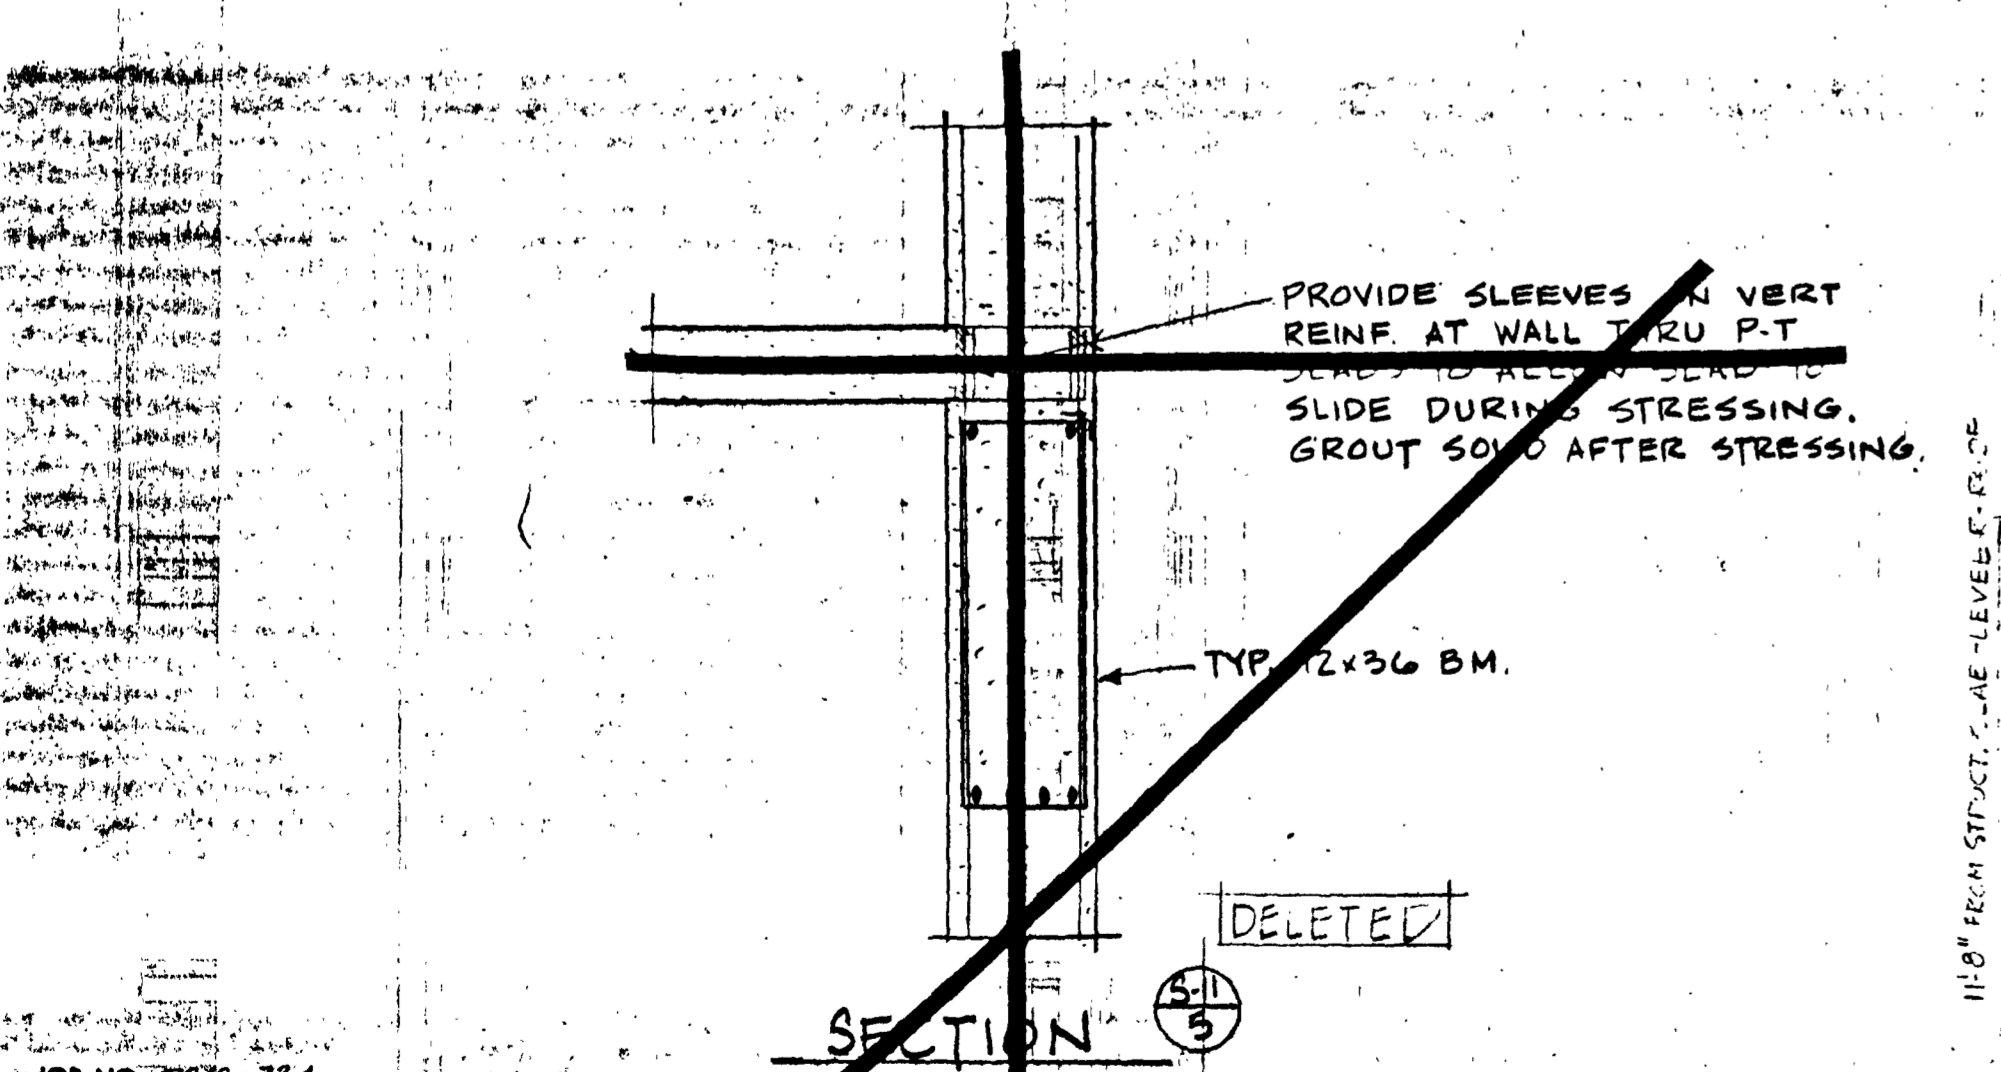

SECTION 5-15 SCALE: 3/16" = 1'-0"

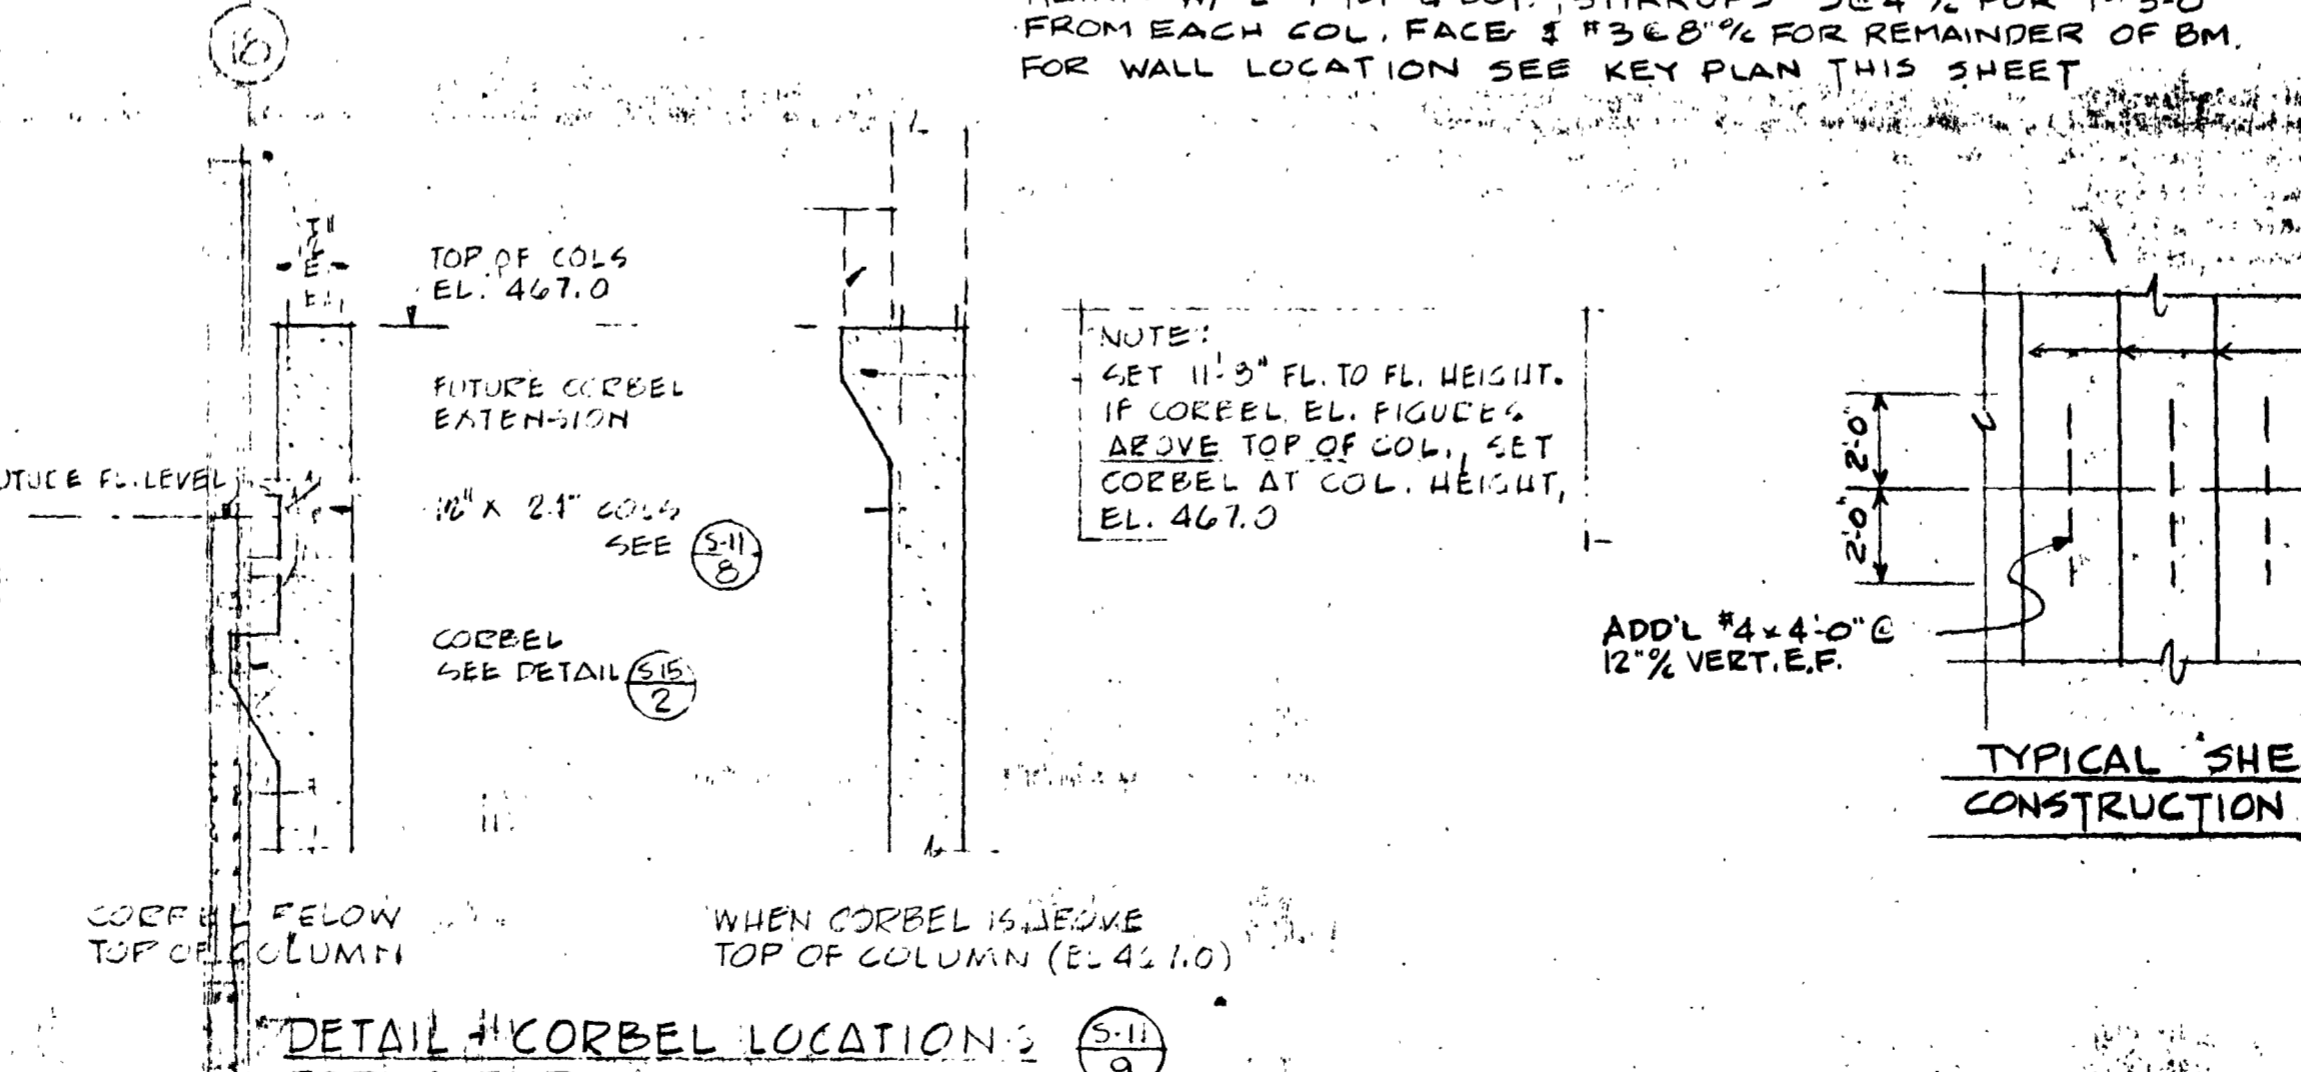


DETAIL CORBEL LOCATION 2 FOR FUTURE FL. LEVEL SCALE: 3/16" = 1'-0"

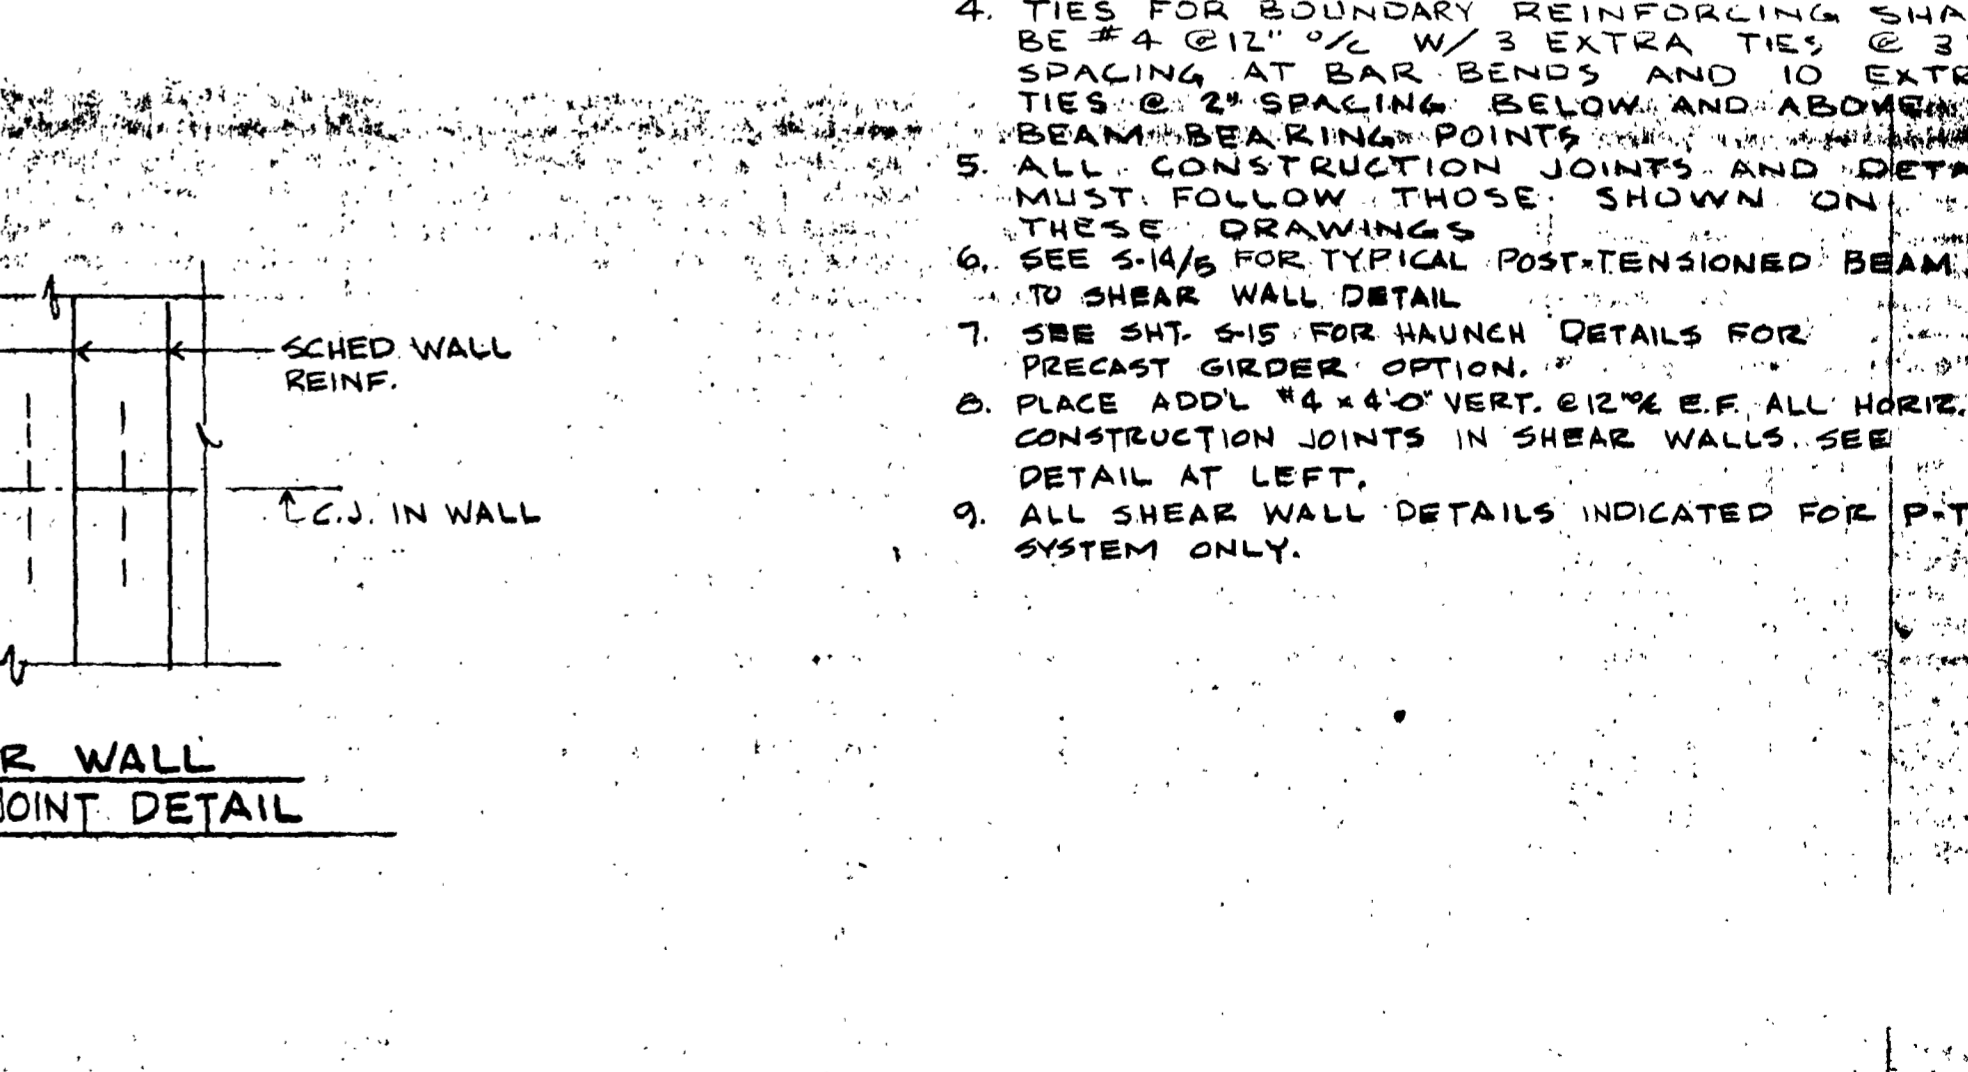

TYPICAL SHEAR WALL CONSTRUCTION JOINT DETAIL


ARCHITECTS • ENGINEERS • SURVEYORS 601 COLLEGE ROAD, FAIRBANKS, ALASKA 99701, PHONE: 452-2124

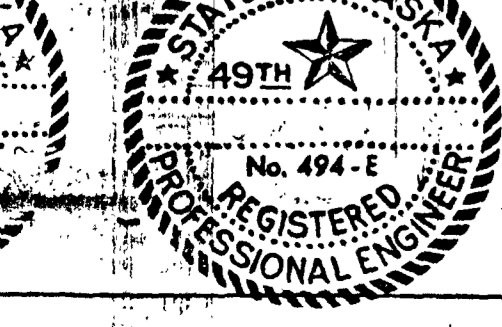

STATE OF ALASKA
DEPT. OF PUBLIC WORKS
DIVISION OF BUILDINGS
JUNEAU ALASKA


FAIRBANKS PARKING STRUCTURE
DBA - 2 - 0130
FAIRBANKS, AK.

AS-BLT SHEET 31 OF 49
R 27-16

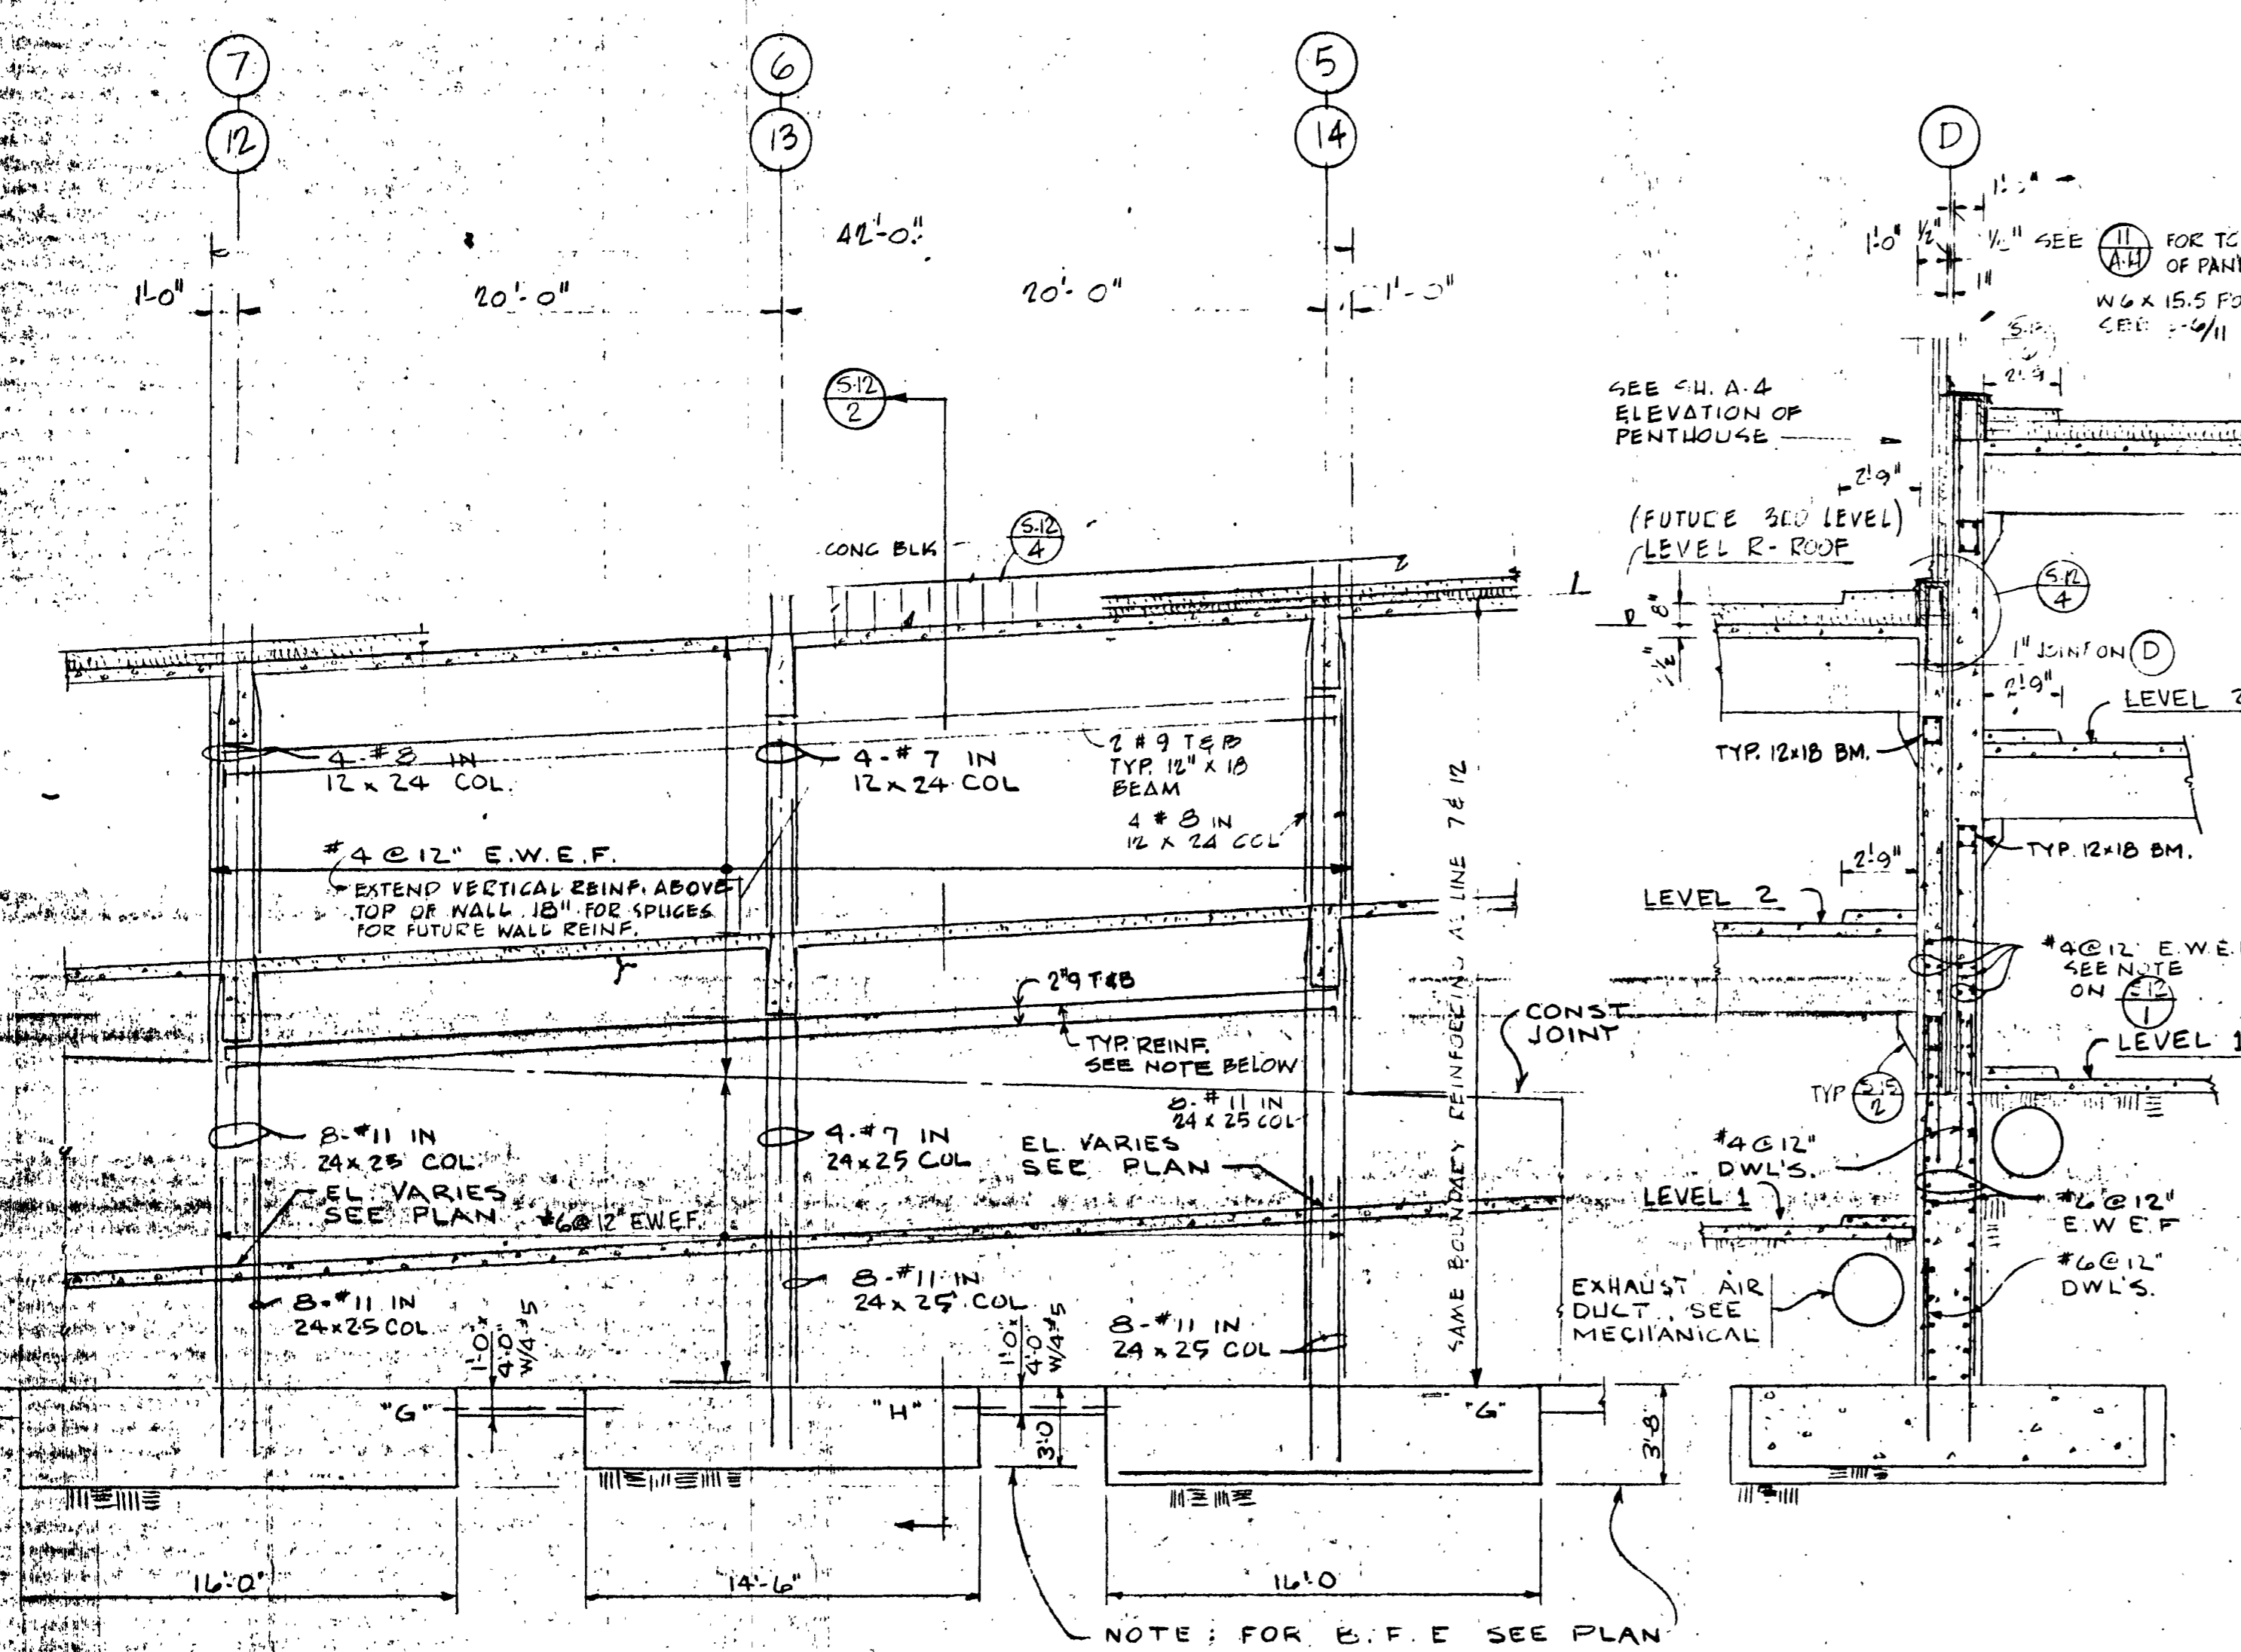


LOOKING WEST WALL #3 & LOOKING EAST WALL #9
SCALE 3/16" = 1'-0"

NOTE: PROVIDE 12x18 BEAM (TYPICAL ALL FRAMED LEVELS, SEE WALL ELEV REINF WITH 2 #3 TOP & BOT. STIRRUPS #3 @ 4" FOR 12" 3'-0" FROM EACH COLUMN & #3 @ 8" FOR REMAINDER OF BEAM. FOR WALL LOCATION SEE KEY PLAN ON SHEET NO. S-11. SEE ADDL NOTES ON SHT. S-11.

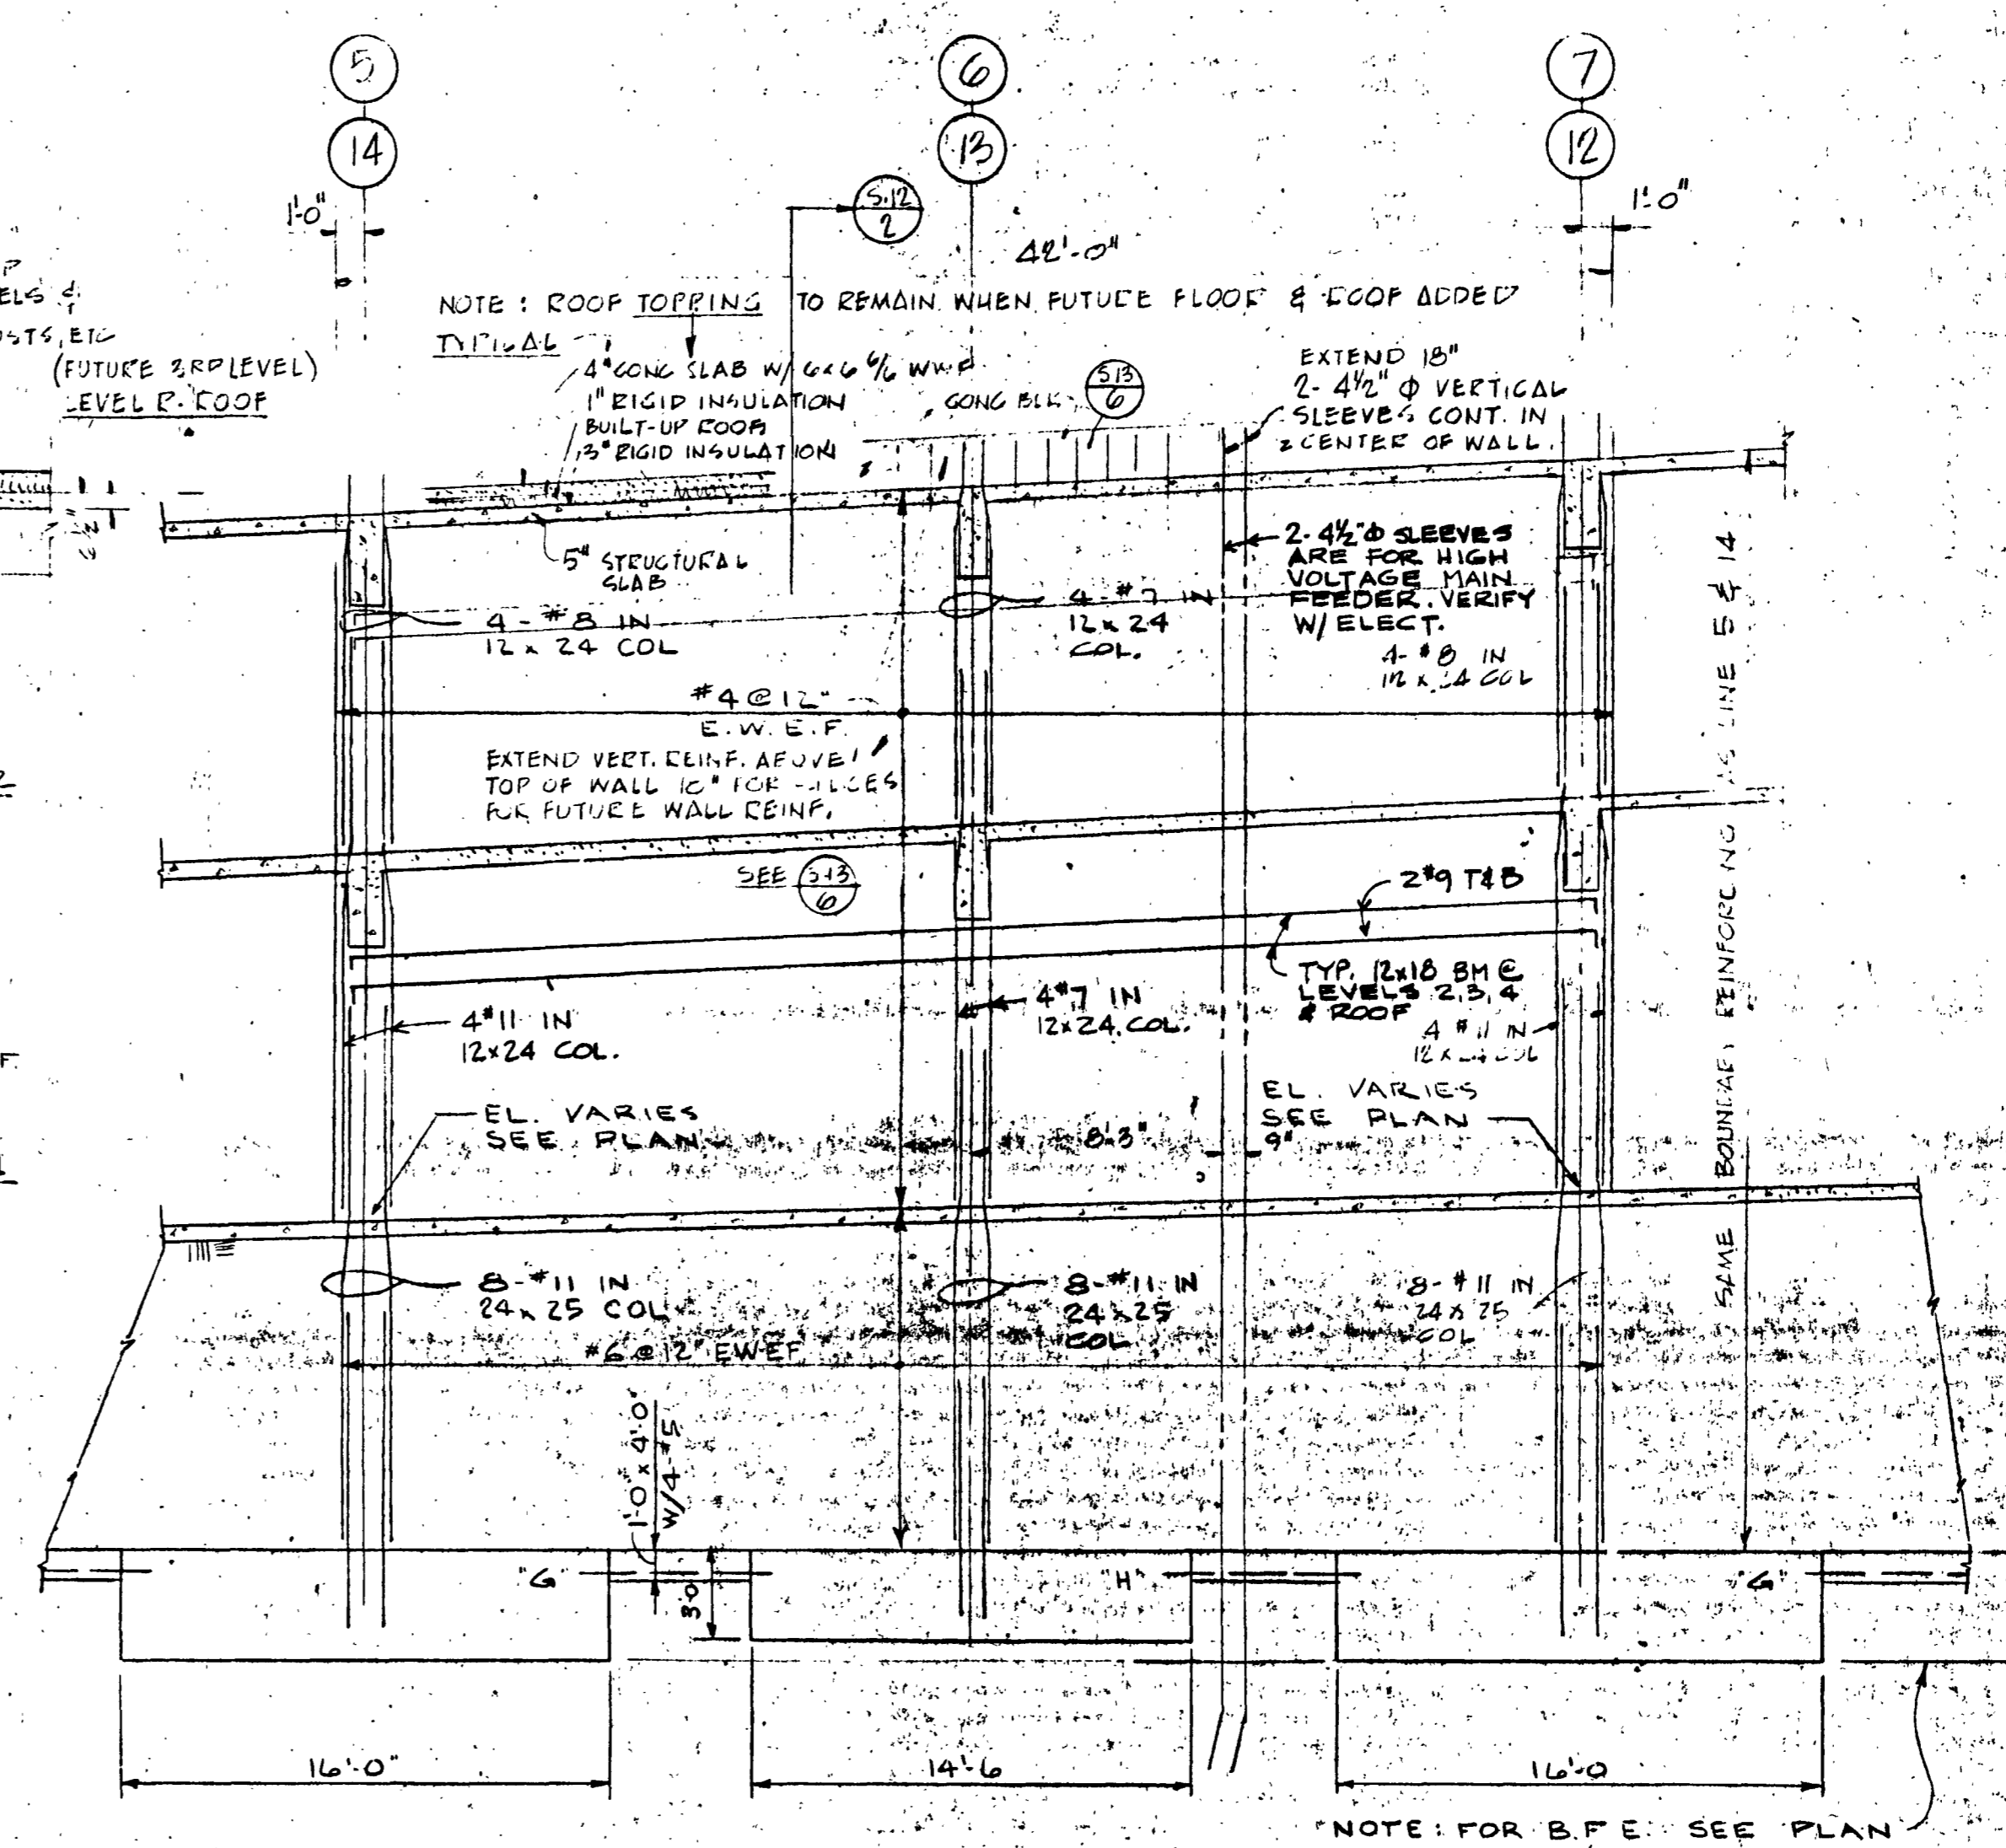

LOOKING EAST WALL #4 & LOOKING WEST WALL #8
SCALE 3/16" = 1'-0"

NOTE: FOR WALL LOCATION SEE KEY PLAN ON SHEET NO. S-11. SLEEVES SHOWN ARE FOR WALL #4 ONLY. SEE ADDL NOTES ON SHEET S-11.

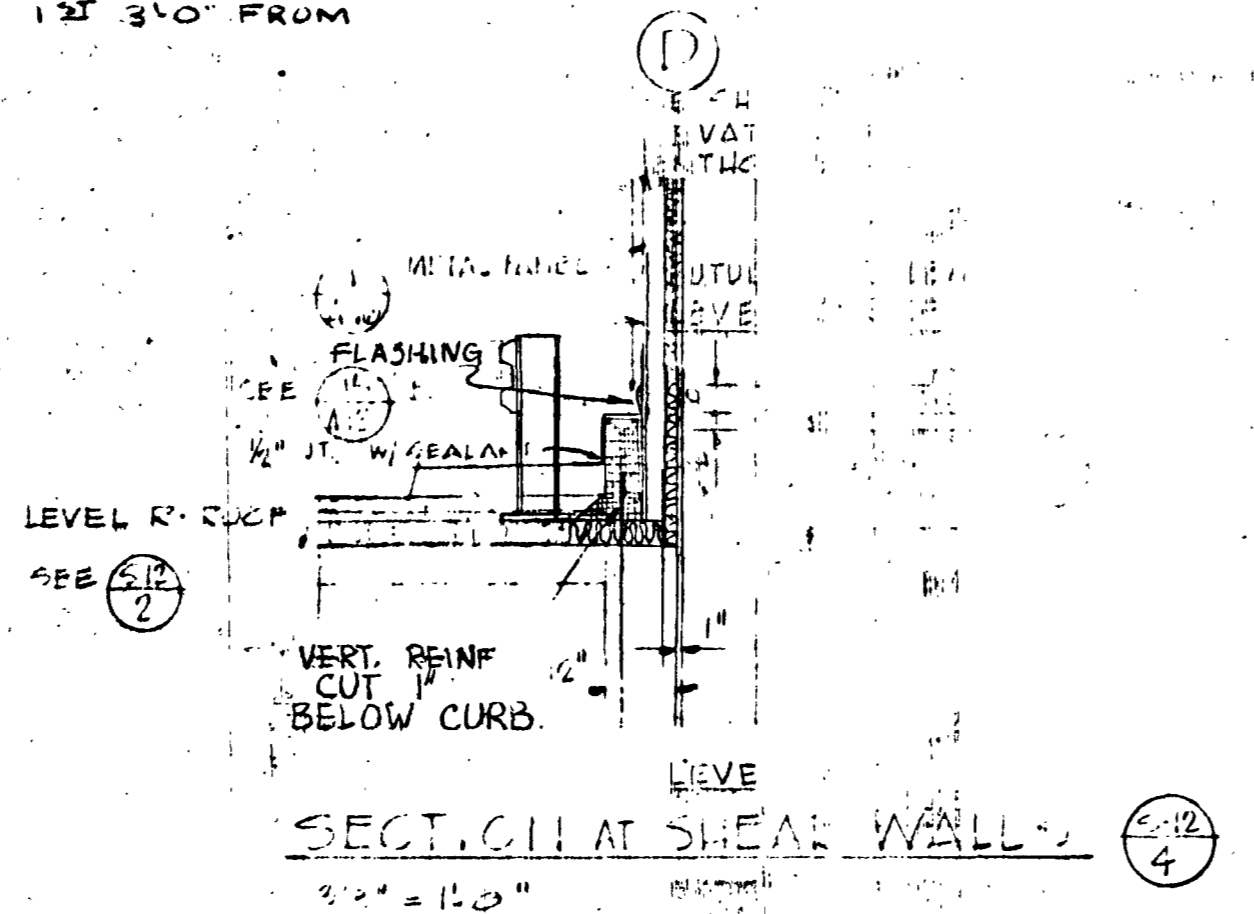

SECTION C11 AT SHEAR WALL
SCALE 3/8" = 1'-0"

ARCHITECTS • ENGINEERS • SURVEYORS
601 COLLEGE ROAD, FAIRBANKS, ALASKA 99701. PHONE: 452-1241


STATE OF ALASKA
DEPT. OF PUBLIC WORKS
DIVISION OF BUILDINGS
JUNEAU ALASKA

FAIRBANKS PARKING STRUCTURE
FAIRBANKS, AK.
DBA - 2 - 0130


SHEAR WALL ELEVATIONS

PETER KIEWIT SONS' CO.
DATE: 6-27-74
AS-BLT
SHEET 32 OF 49


S-12

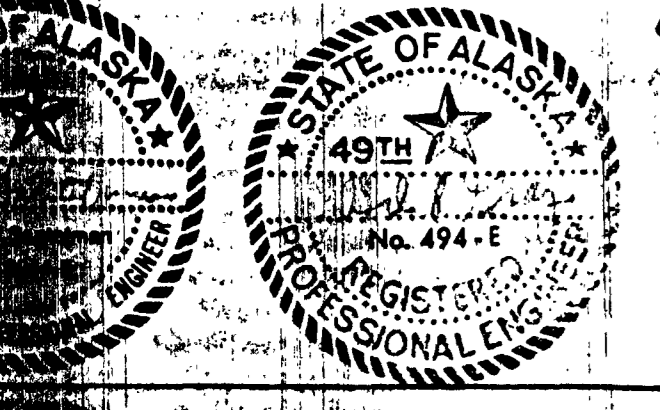


A DIVISION OF ELLERBE

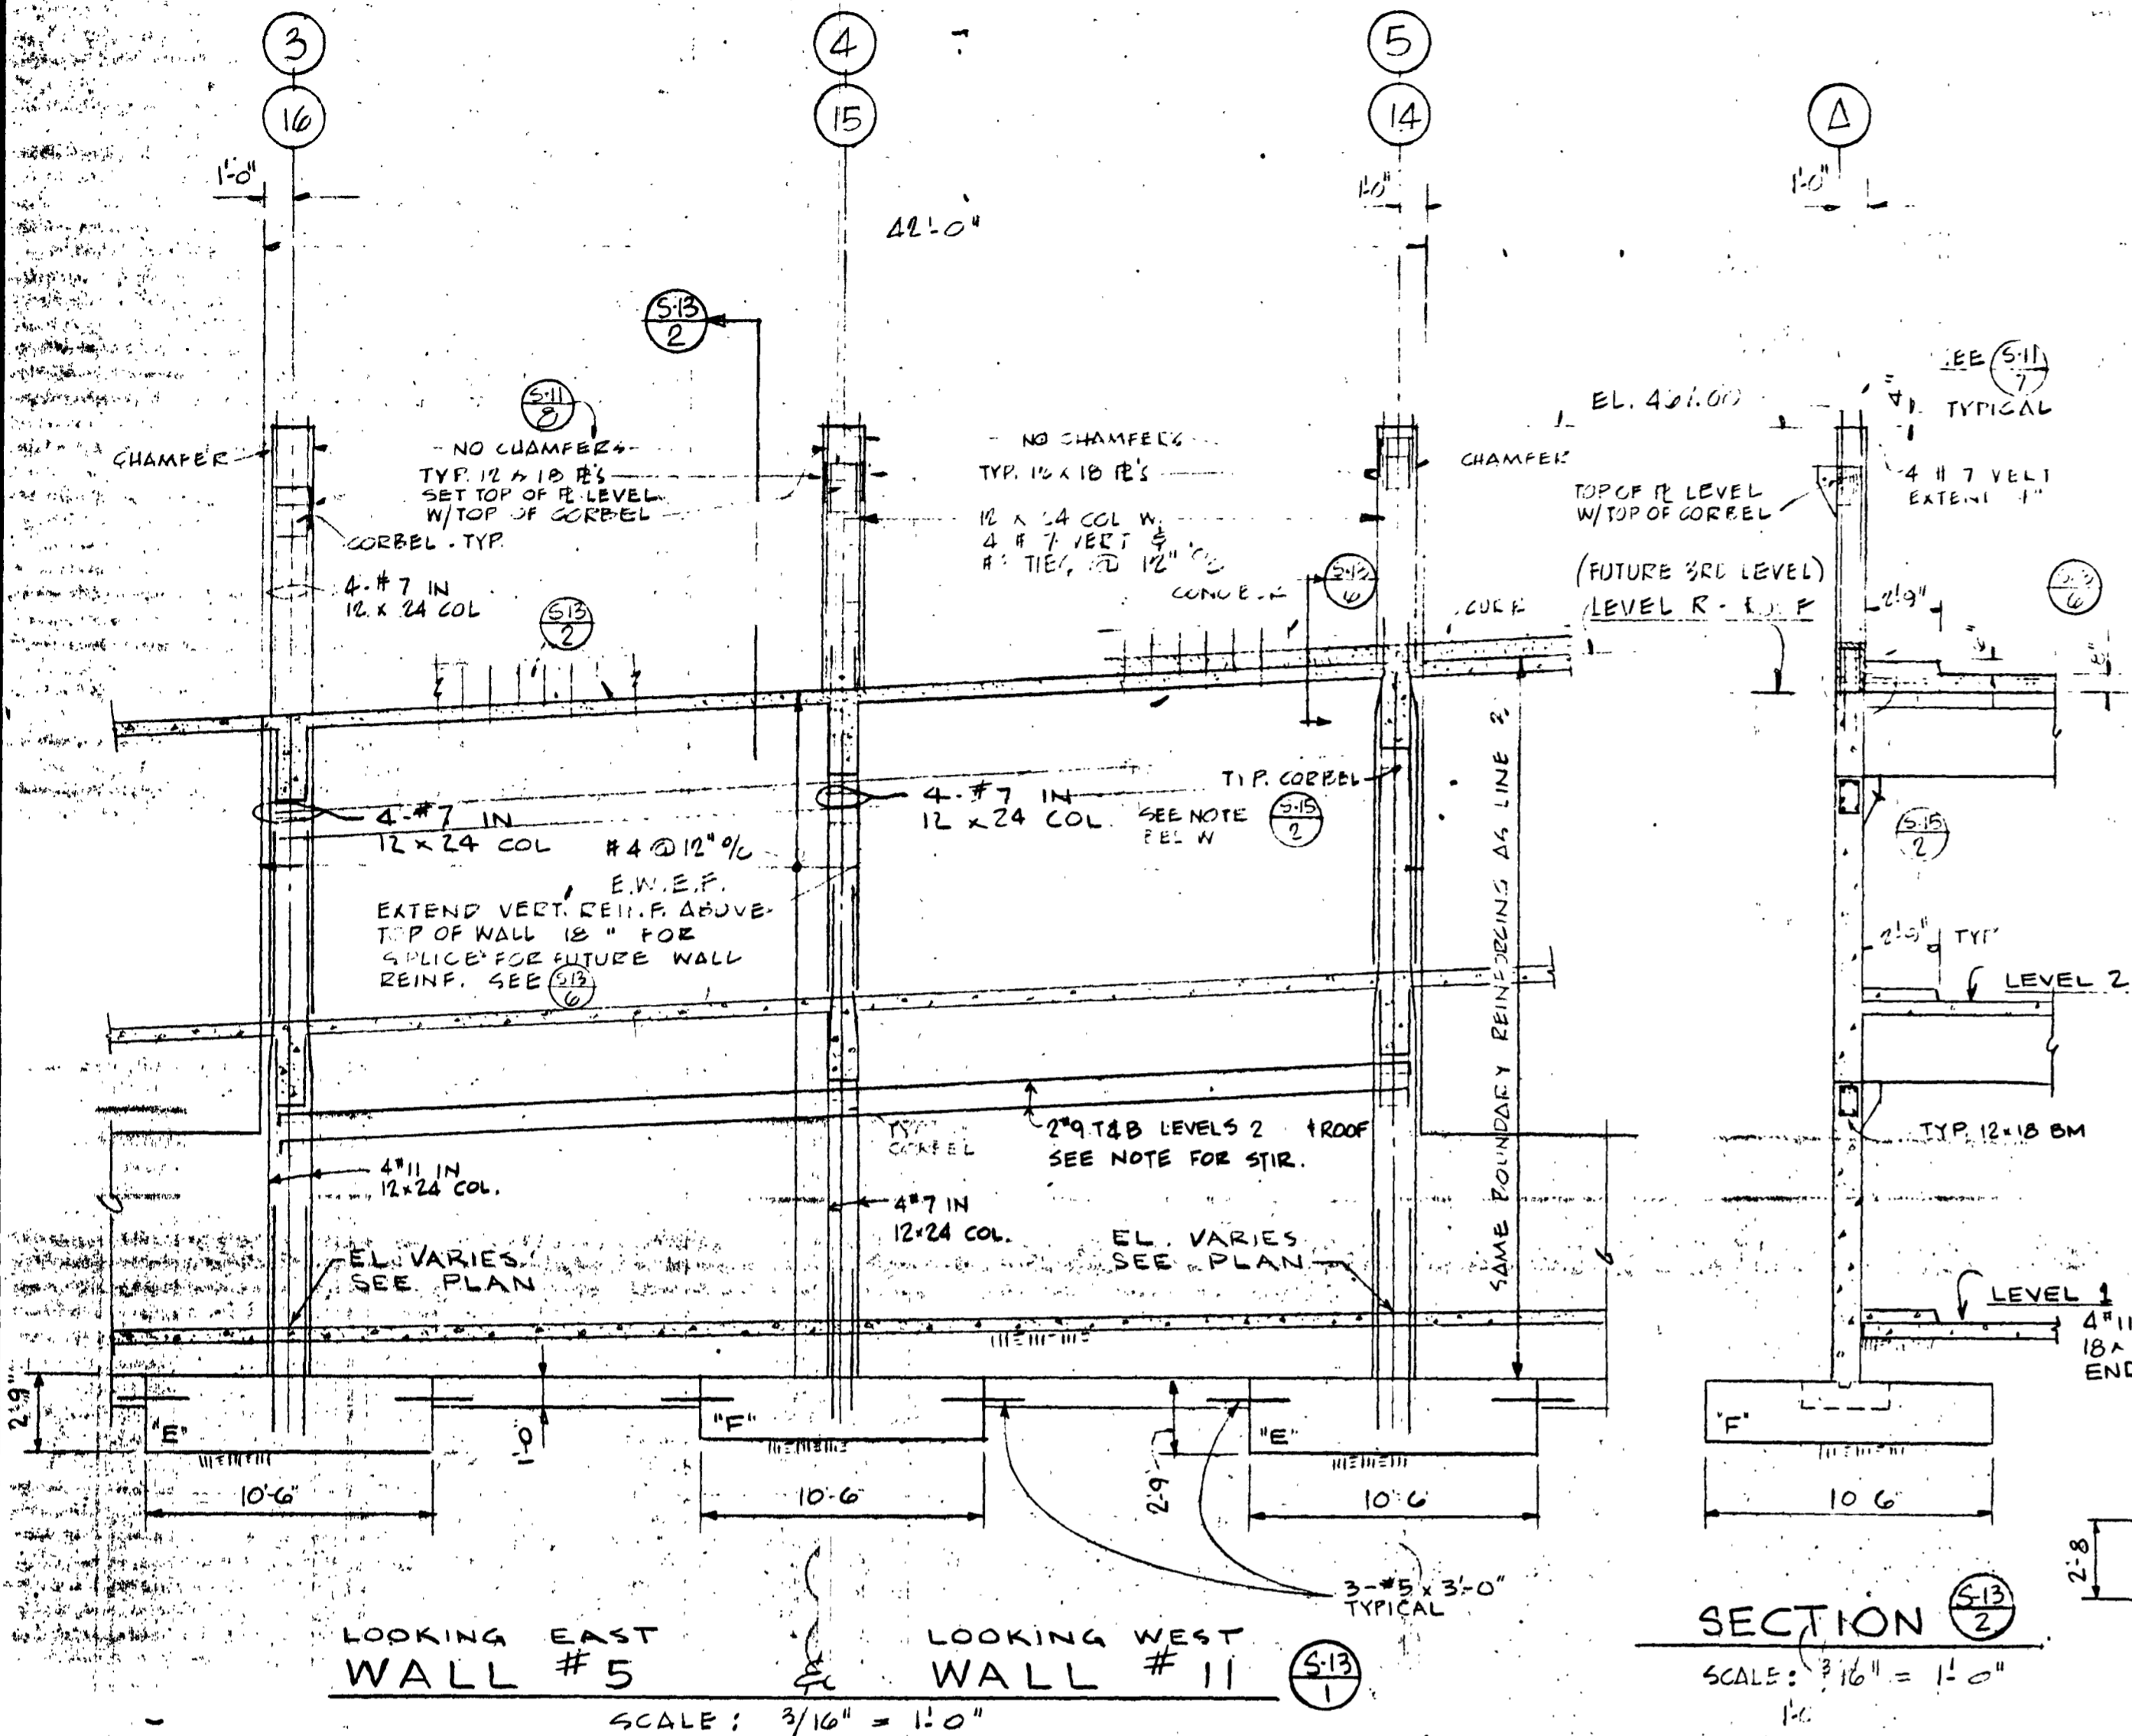


LOOKING EAST WALL #5
LOOKING WEST WALL #11
SCALE: 3/16" = 1'-0"

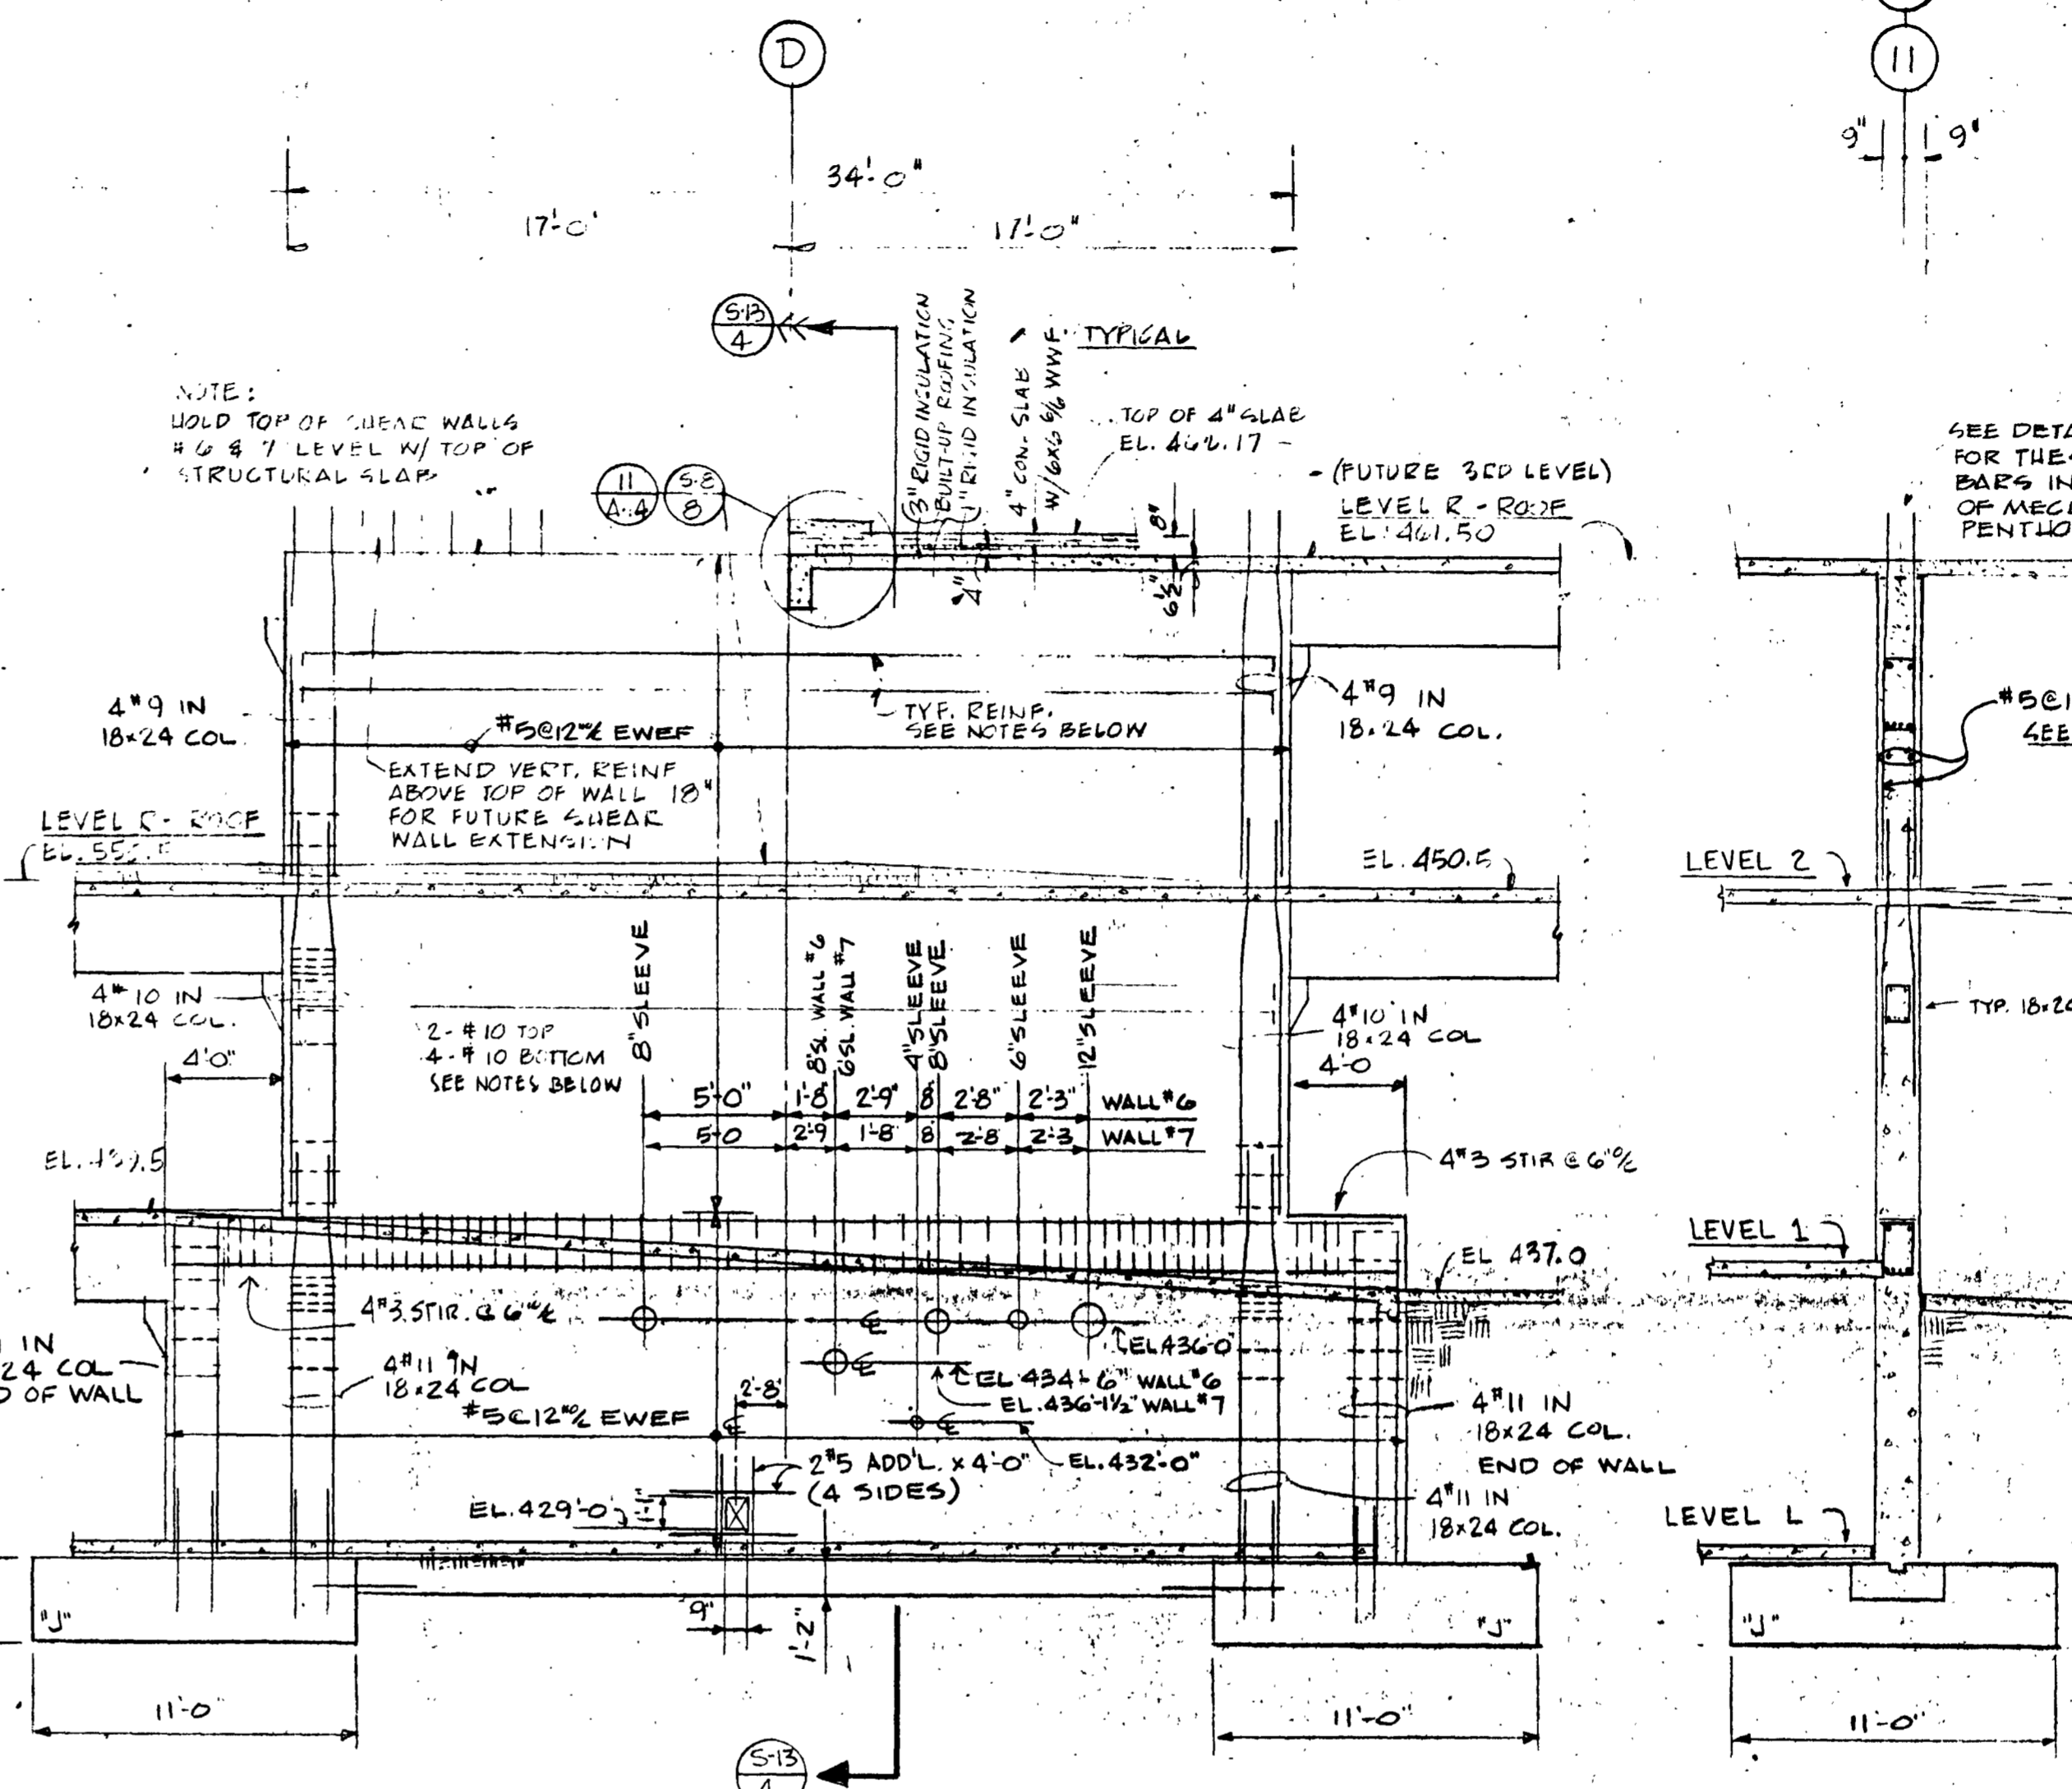


SECTION WALL #6 & WALL #7
SCALE: 3/16" = 1'-0"

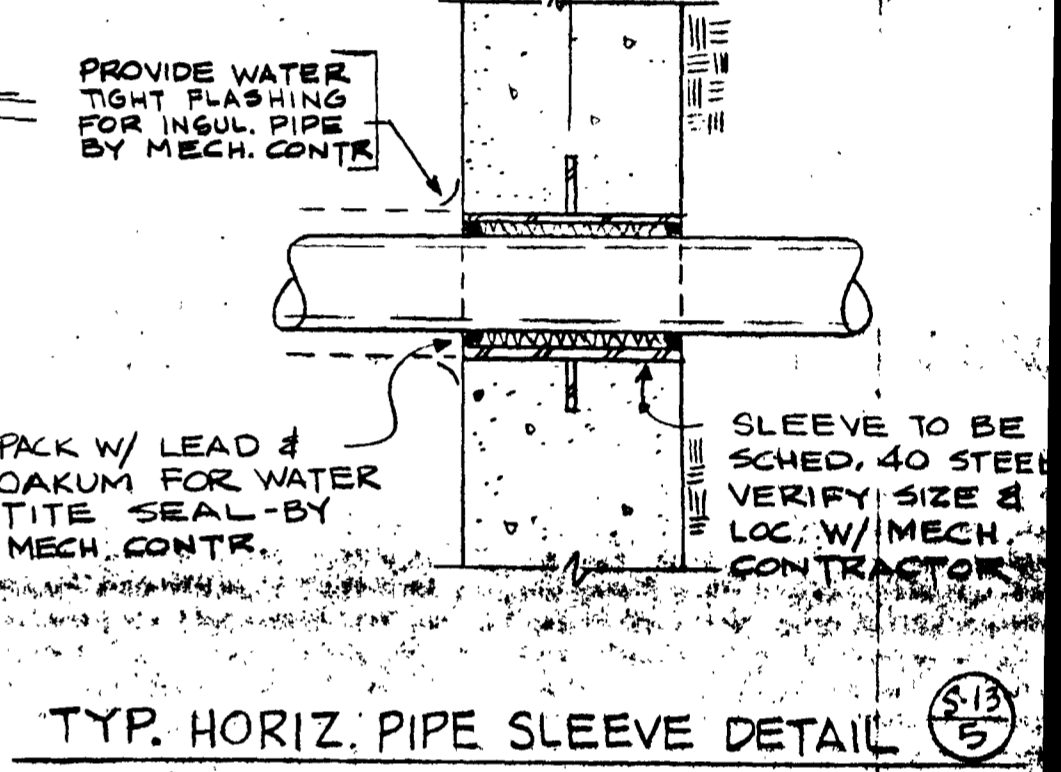

TYP. HORIZ. PIPE SLEEVE DETAIL
SCALE: 3/4" = 1'-0"

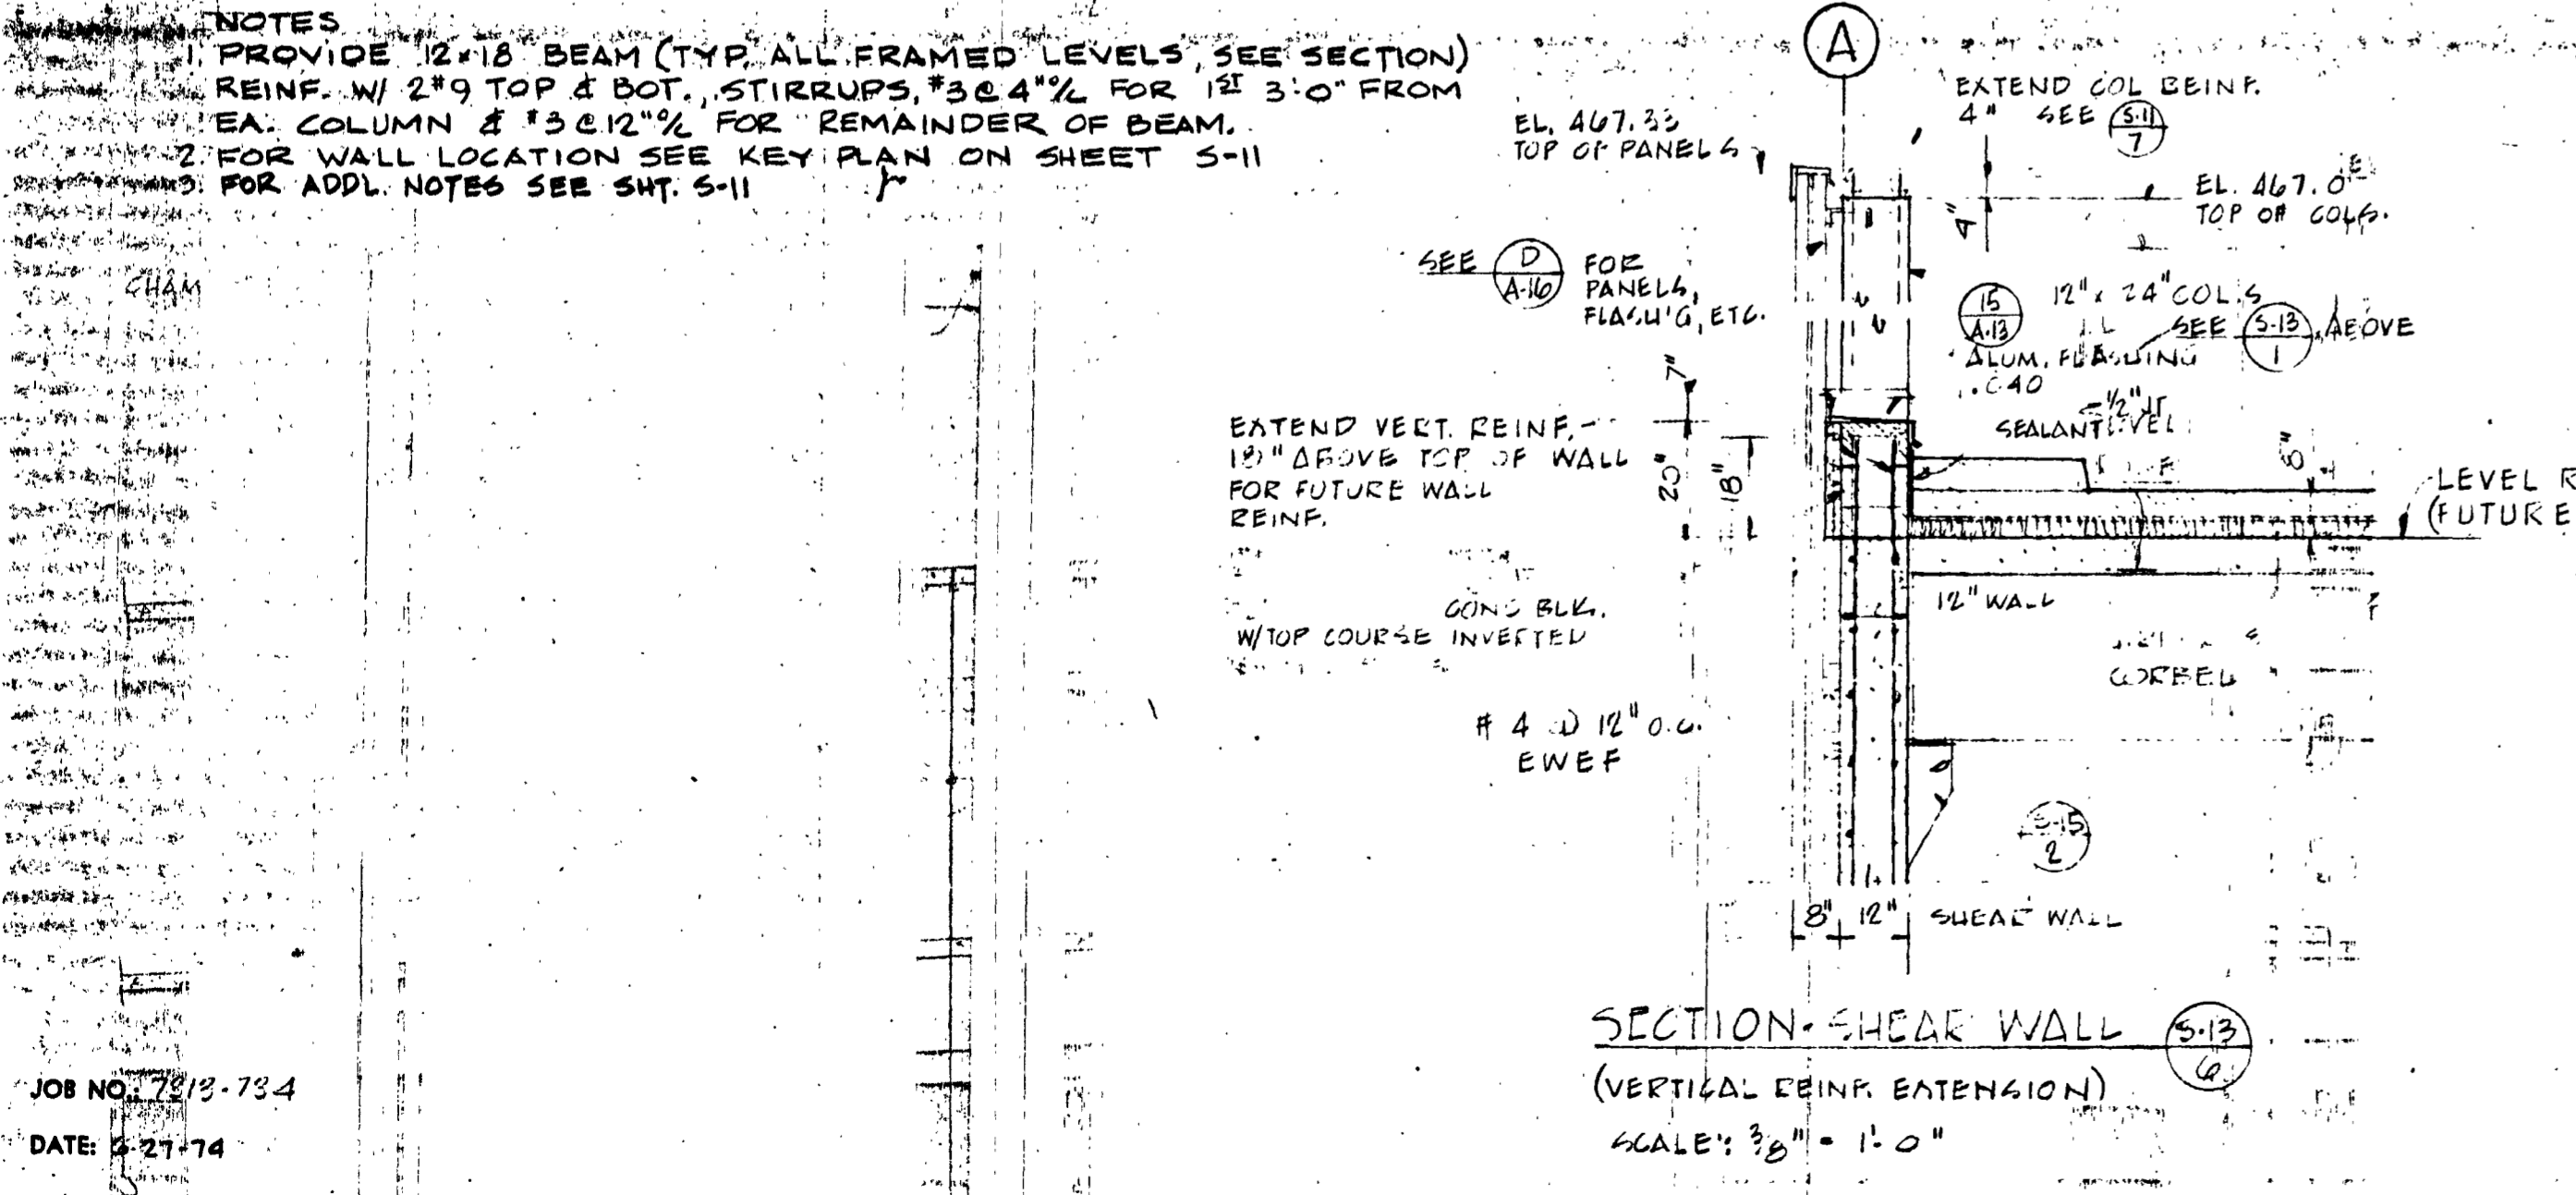

SECTION-SHEAR WALL
(VERTICAL REINF. EXTENSION)
SCALE: 3/8" = 1'-0"

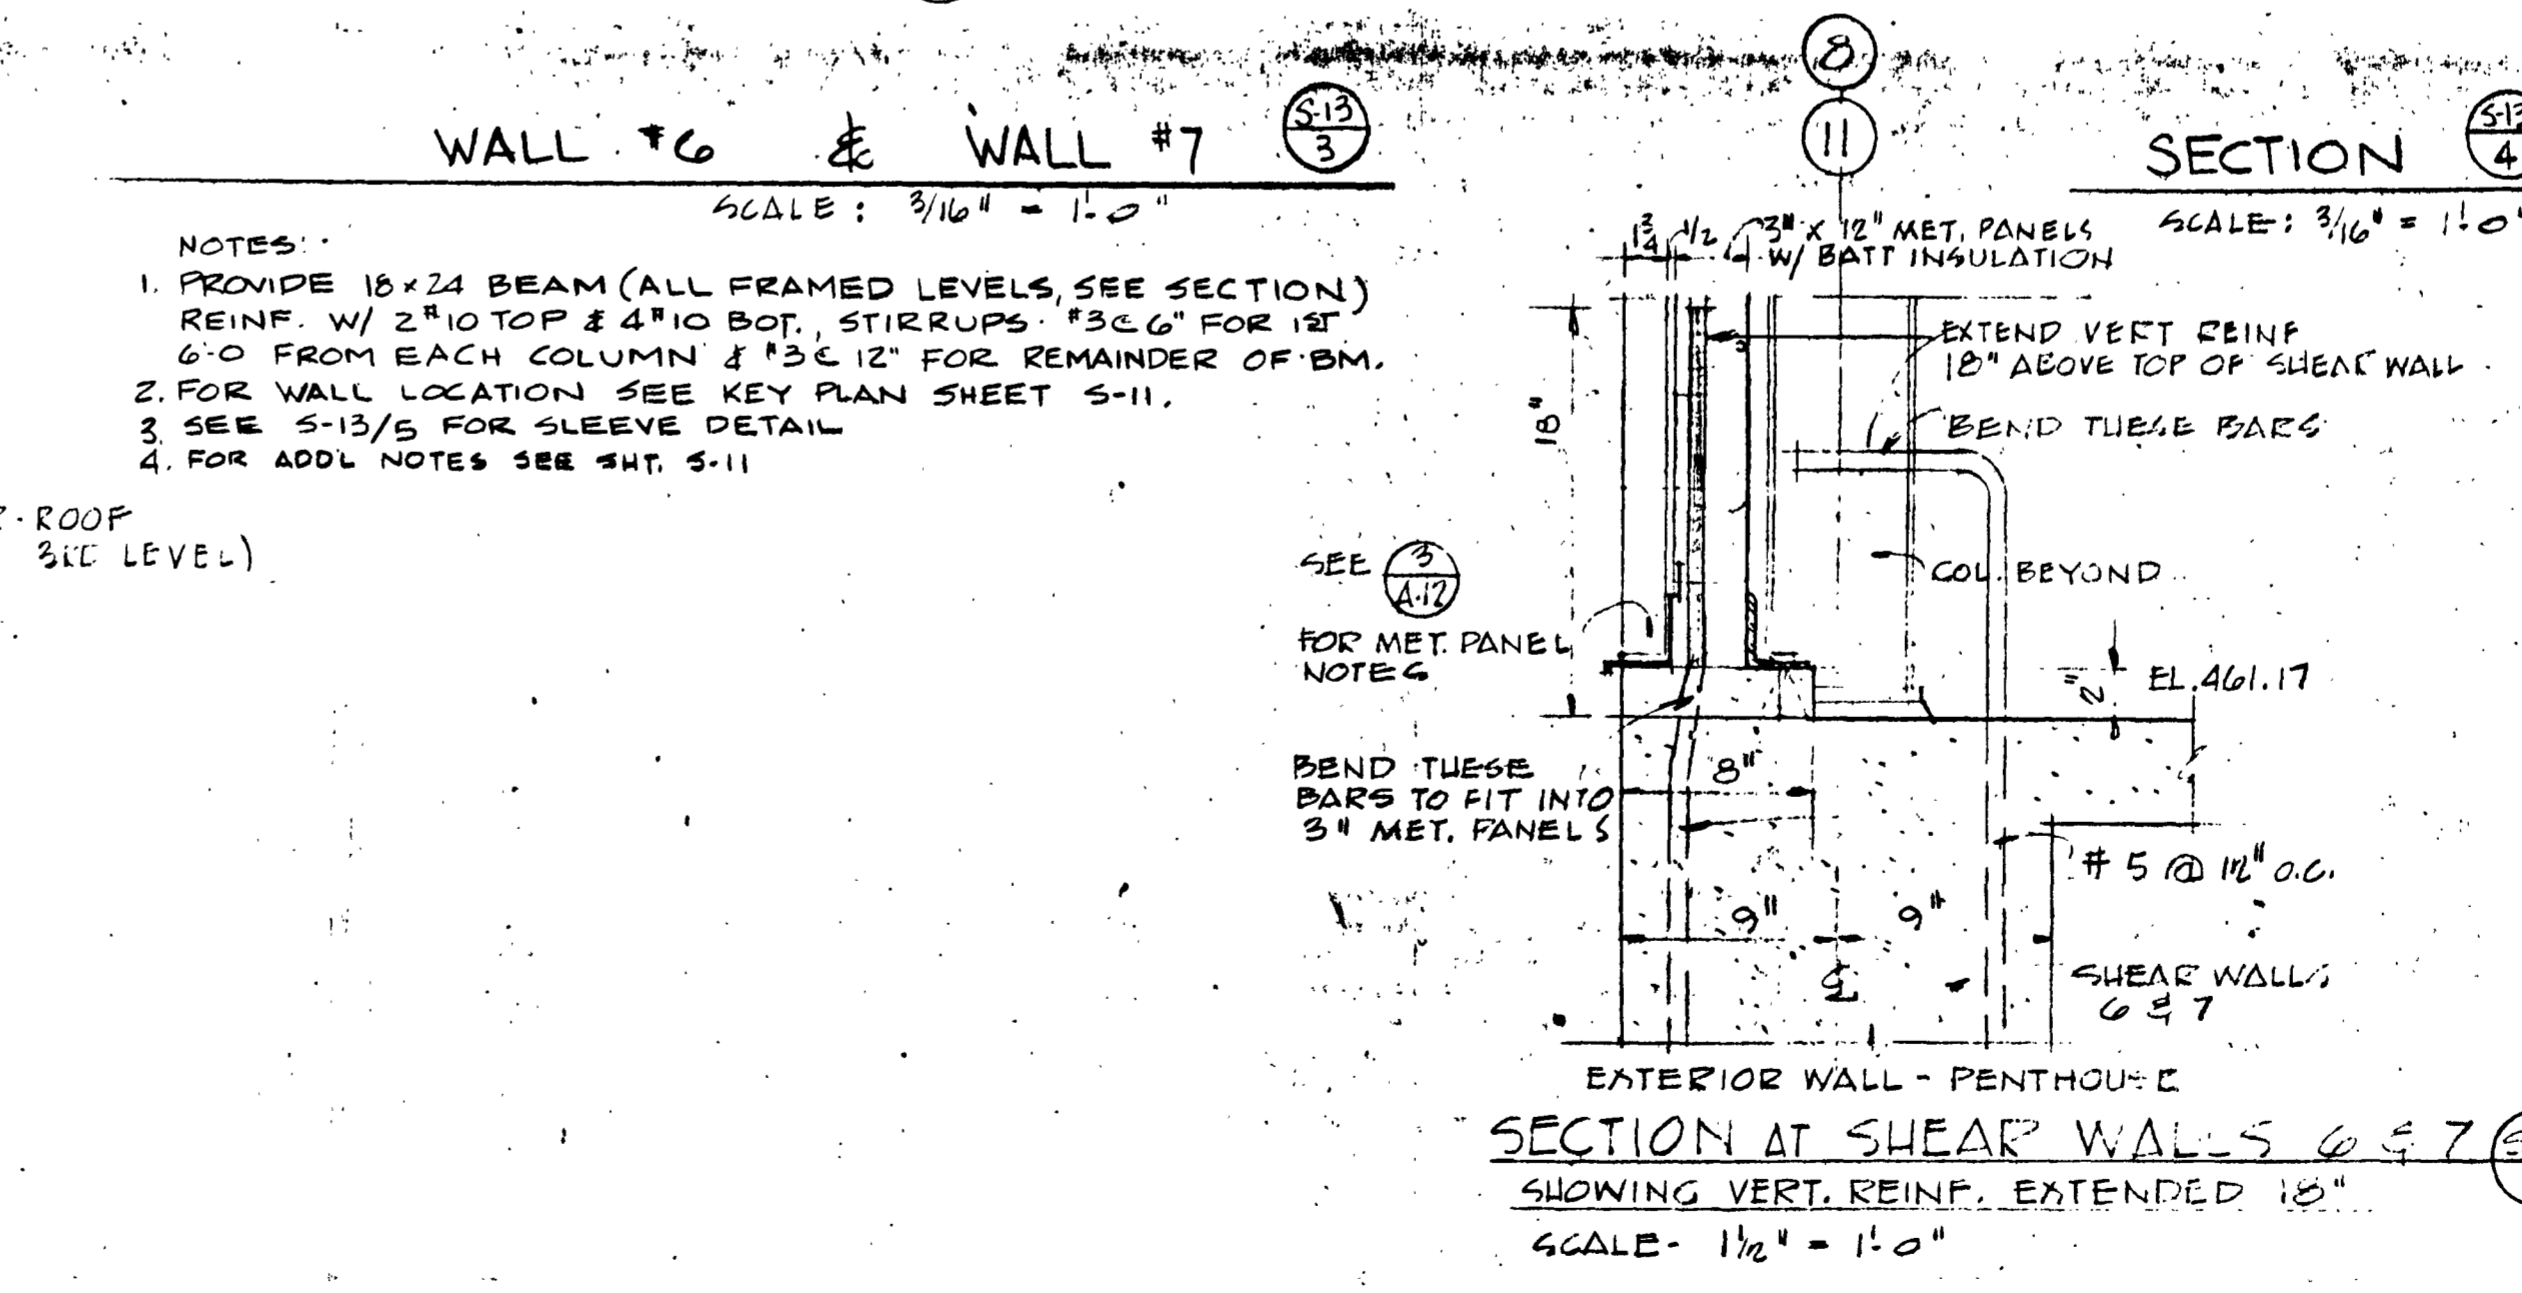


SECTION AT SHEAR WALL
SHOWING VERT. REINF. EXTENDED 18"
SCALE: 1/2" = 1'-0"

NOTES:
1. PROVIDE 12x18 BEAM (TYP. ALL FRAMED LEVELS, SEE SECTION) REINF. W/ 2#9 TOP & BOT., STIRRUPS #3 @ 4" FOR 12' 3'-0" FROM EA. COLUMN & #3 @ 12" FOR REMAINDER OF BEAM.
2. FOR WALL LOCATION SEE KEY PLAN ON SHEET S-11
3. FOR ADDL. NOTES SEE SHT. S-11

JOB NO. 7818-78.4
DATE: 2-21-74

ARCHITECTS • ENGINEERS • SURVEYORS
601 COLLEGE ROAD, FAIRBANKS, ALASKA 99701, PHONE: 452-1241

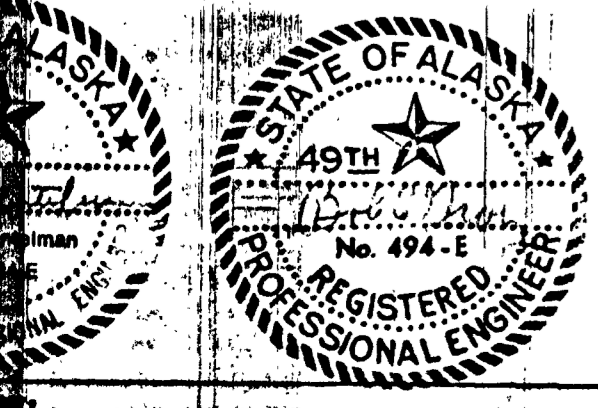

STATE OF ALASKA
DEPT. OF PUBLIC WORKS
DIVISION OF BUILDINGS
JUNEAU ALASKA


FAIRBANKS PARKING STRUCTURE
DBA - 2 - 0130
FAIRBANKS, AK.

PELLE KROHN SONS' CO.
DATE: 2/21/74
AS-BLT









S-13
SHEET 33 OF 49

SHEAR WALL ELEVATIONS

TYPICAL POST-TENSION STRAND PROFILES

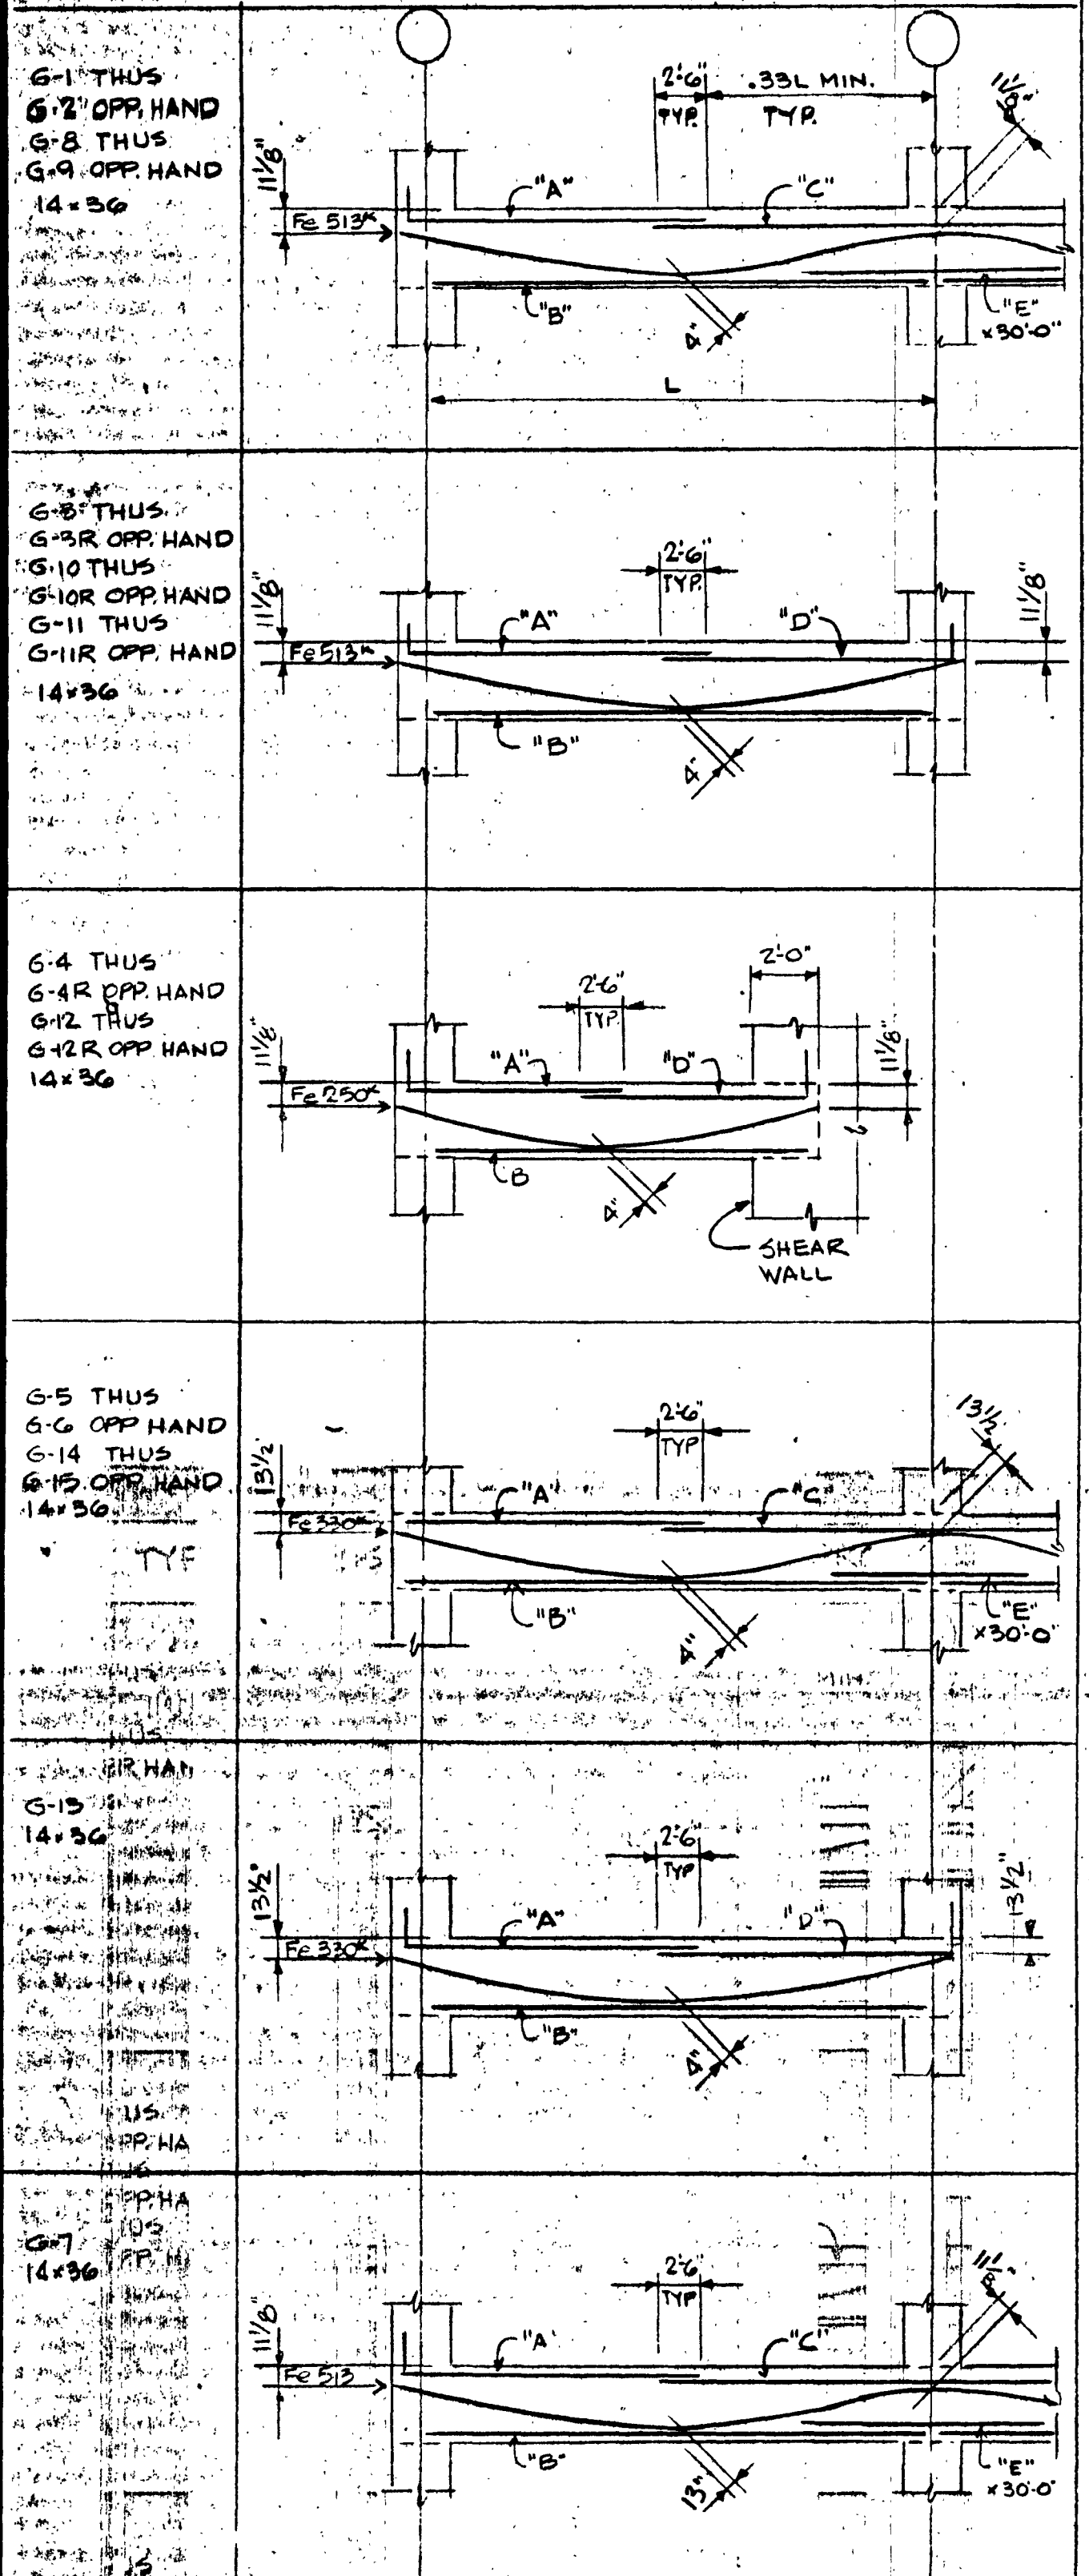

GIRDER	ADDITIONAL REINFORCING REQUIRED					STIRRUPS REQ'D @ SPACING FROM EA. END			
	"A"	"B"	"C"	"D"	"E"	3'	6'	12'	24'
G-1, G-2 OPP. HAND	2#7	2#7	2#9	2#7	2#7				
G-3, G-4 OPP. HAND	2#7	2#7	2#7	2#7	2#7				
G-5, G-6 OPP. HAND	2#7	2#7	2#9	2#7	2#7				
G-7	2#7	2#7	2#9	2#7	2#7				
G-8, G-9 OPP. HAND	2#5	2#8	2#9	2#7	2#7	22			
G-10, G-11 OPP. HAND	2#7	2#7	2#7	2#7	2#7	22			
G-12, G-13 OPP. HAND	2#7	2#7	2#7	2#7	2#7	17	13		
G-14	2#7	2#7	2#7	2#7	2#7	9			
G-15, G-16 OPP. HAND	2#7	2#7	2#9	2#7	2#7				

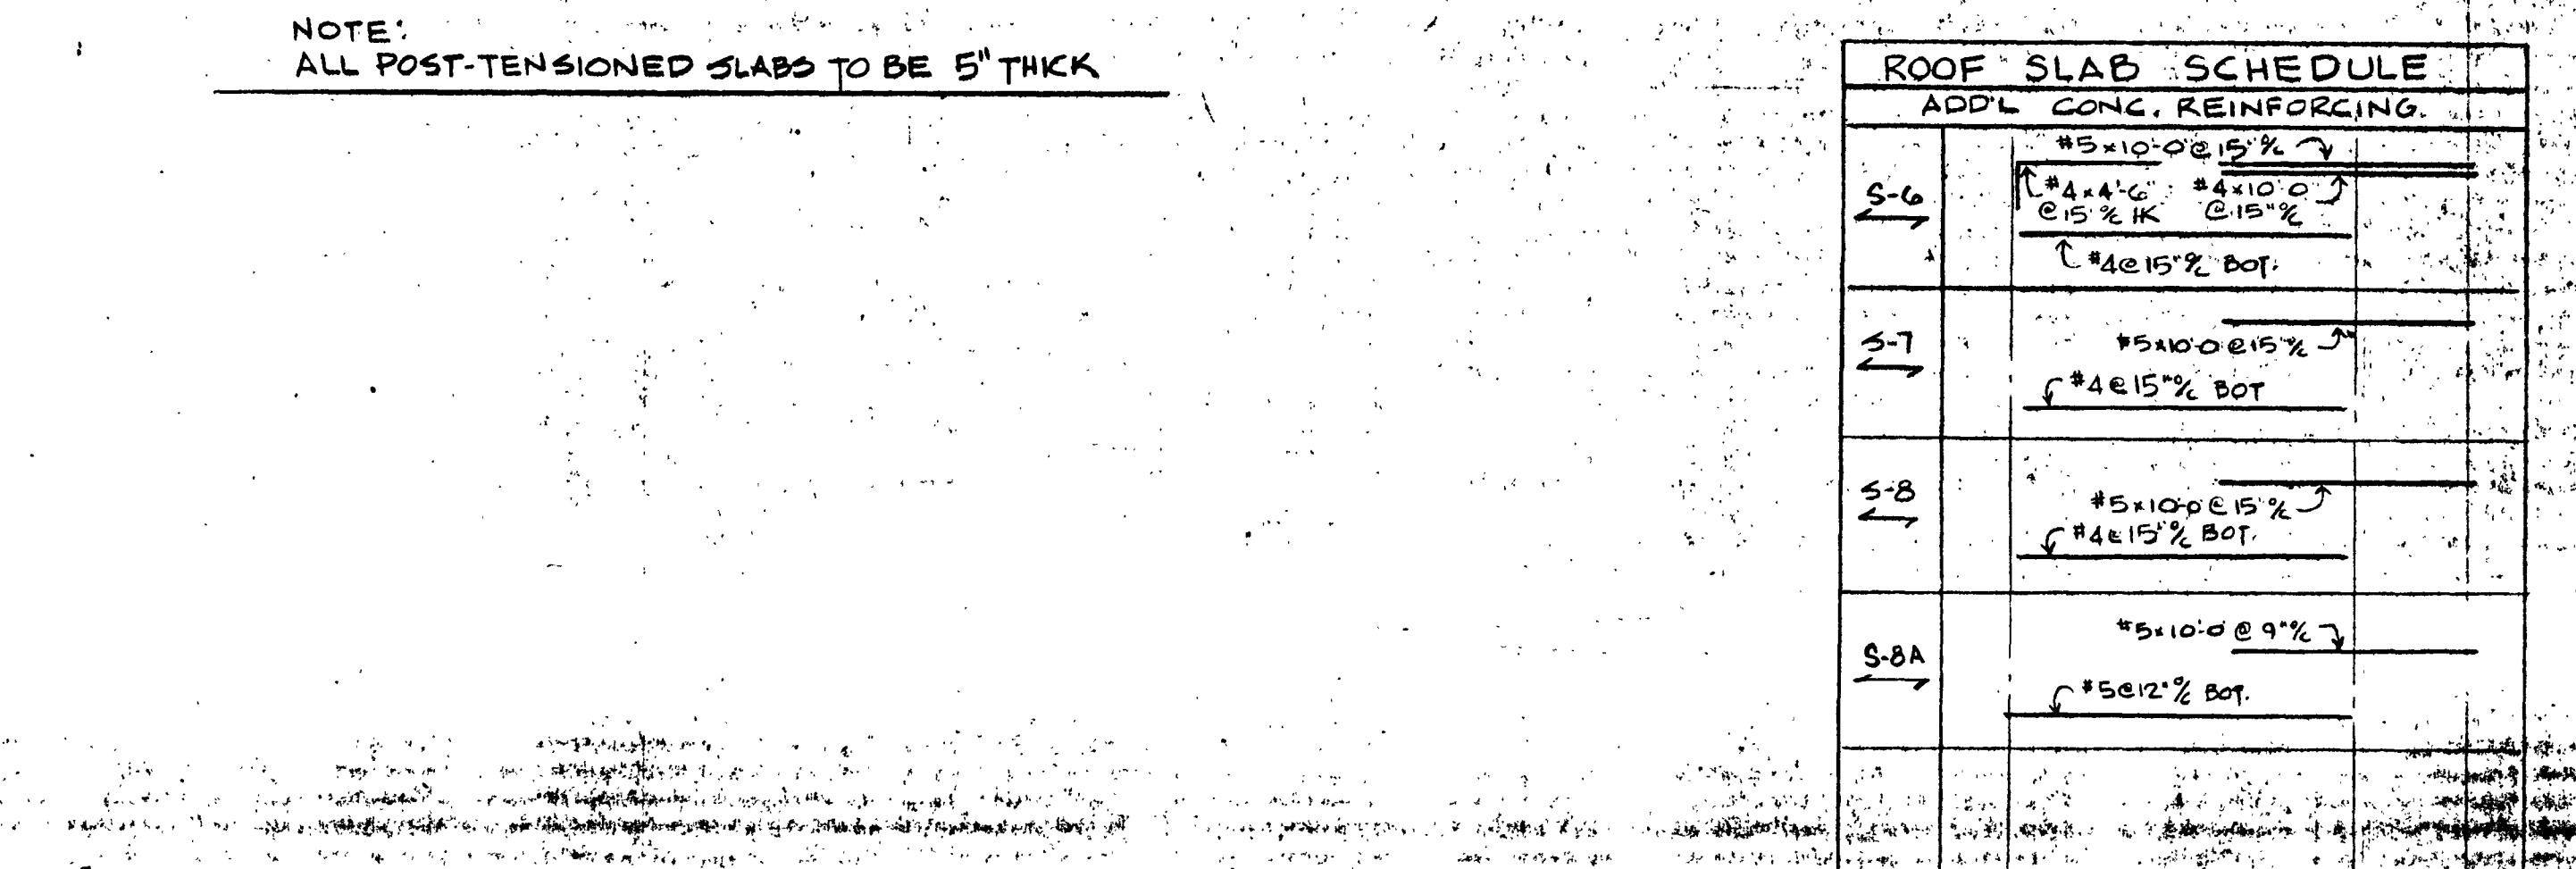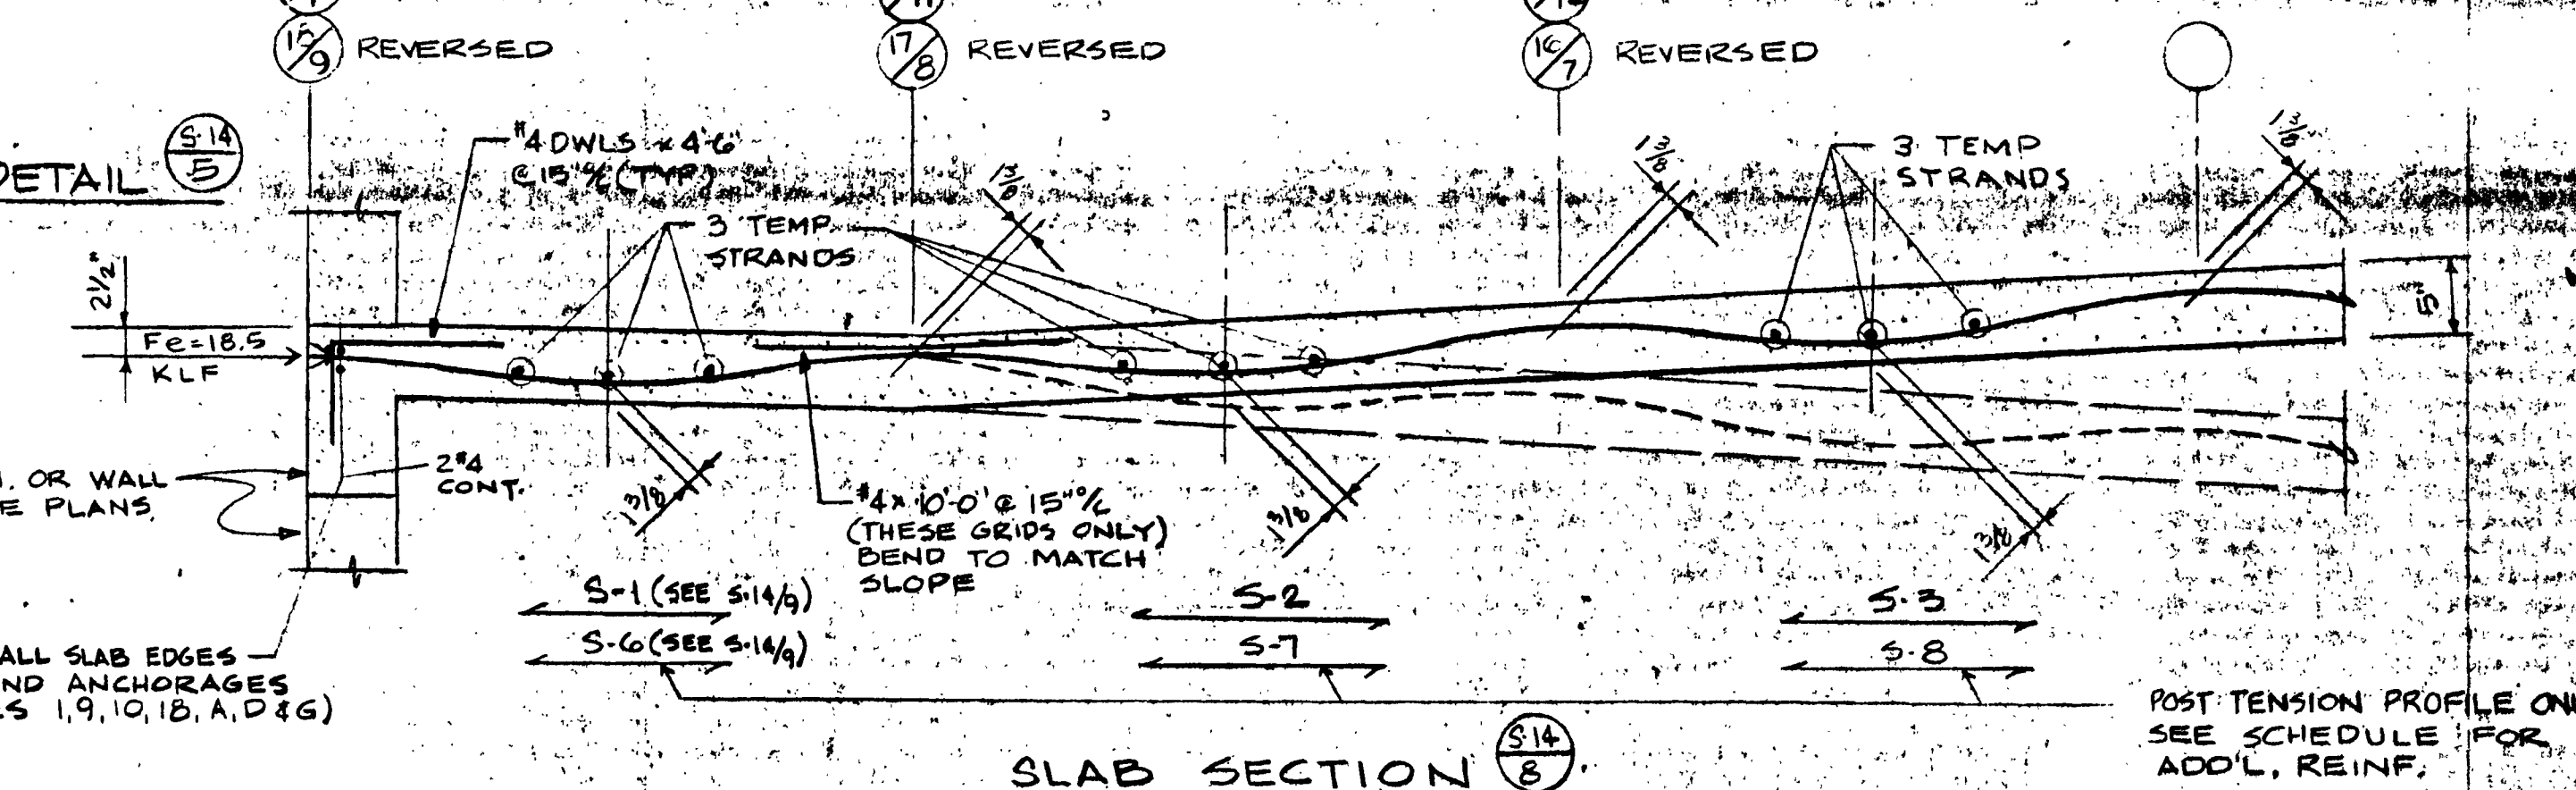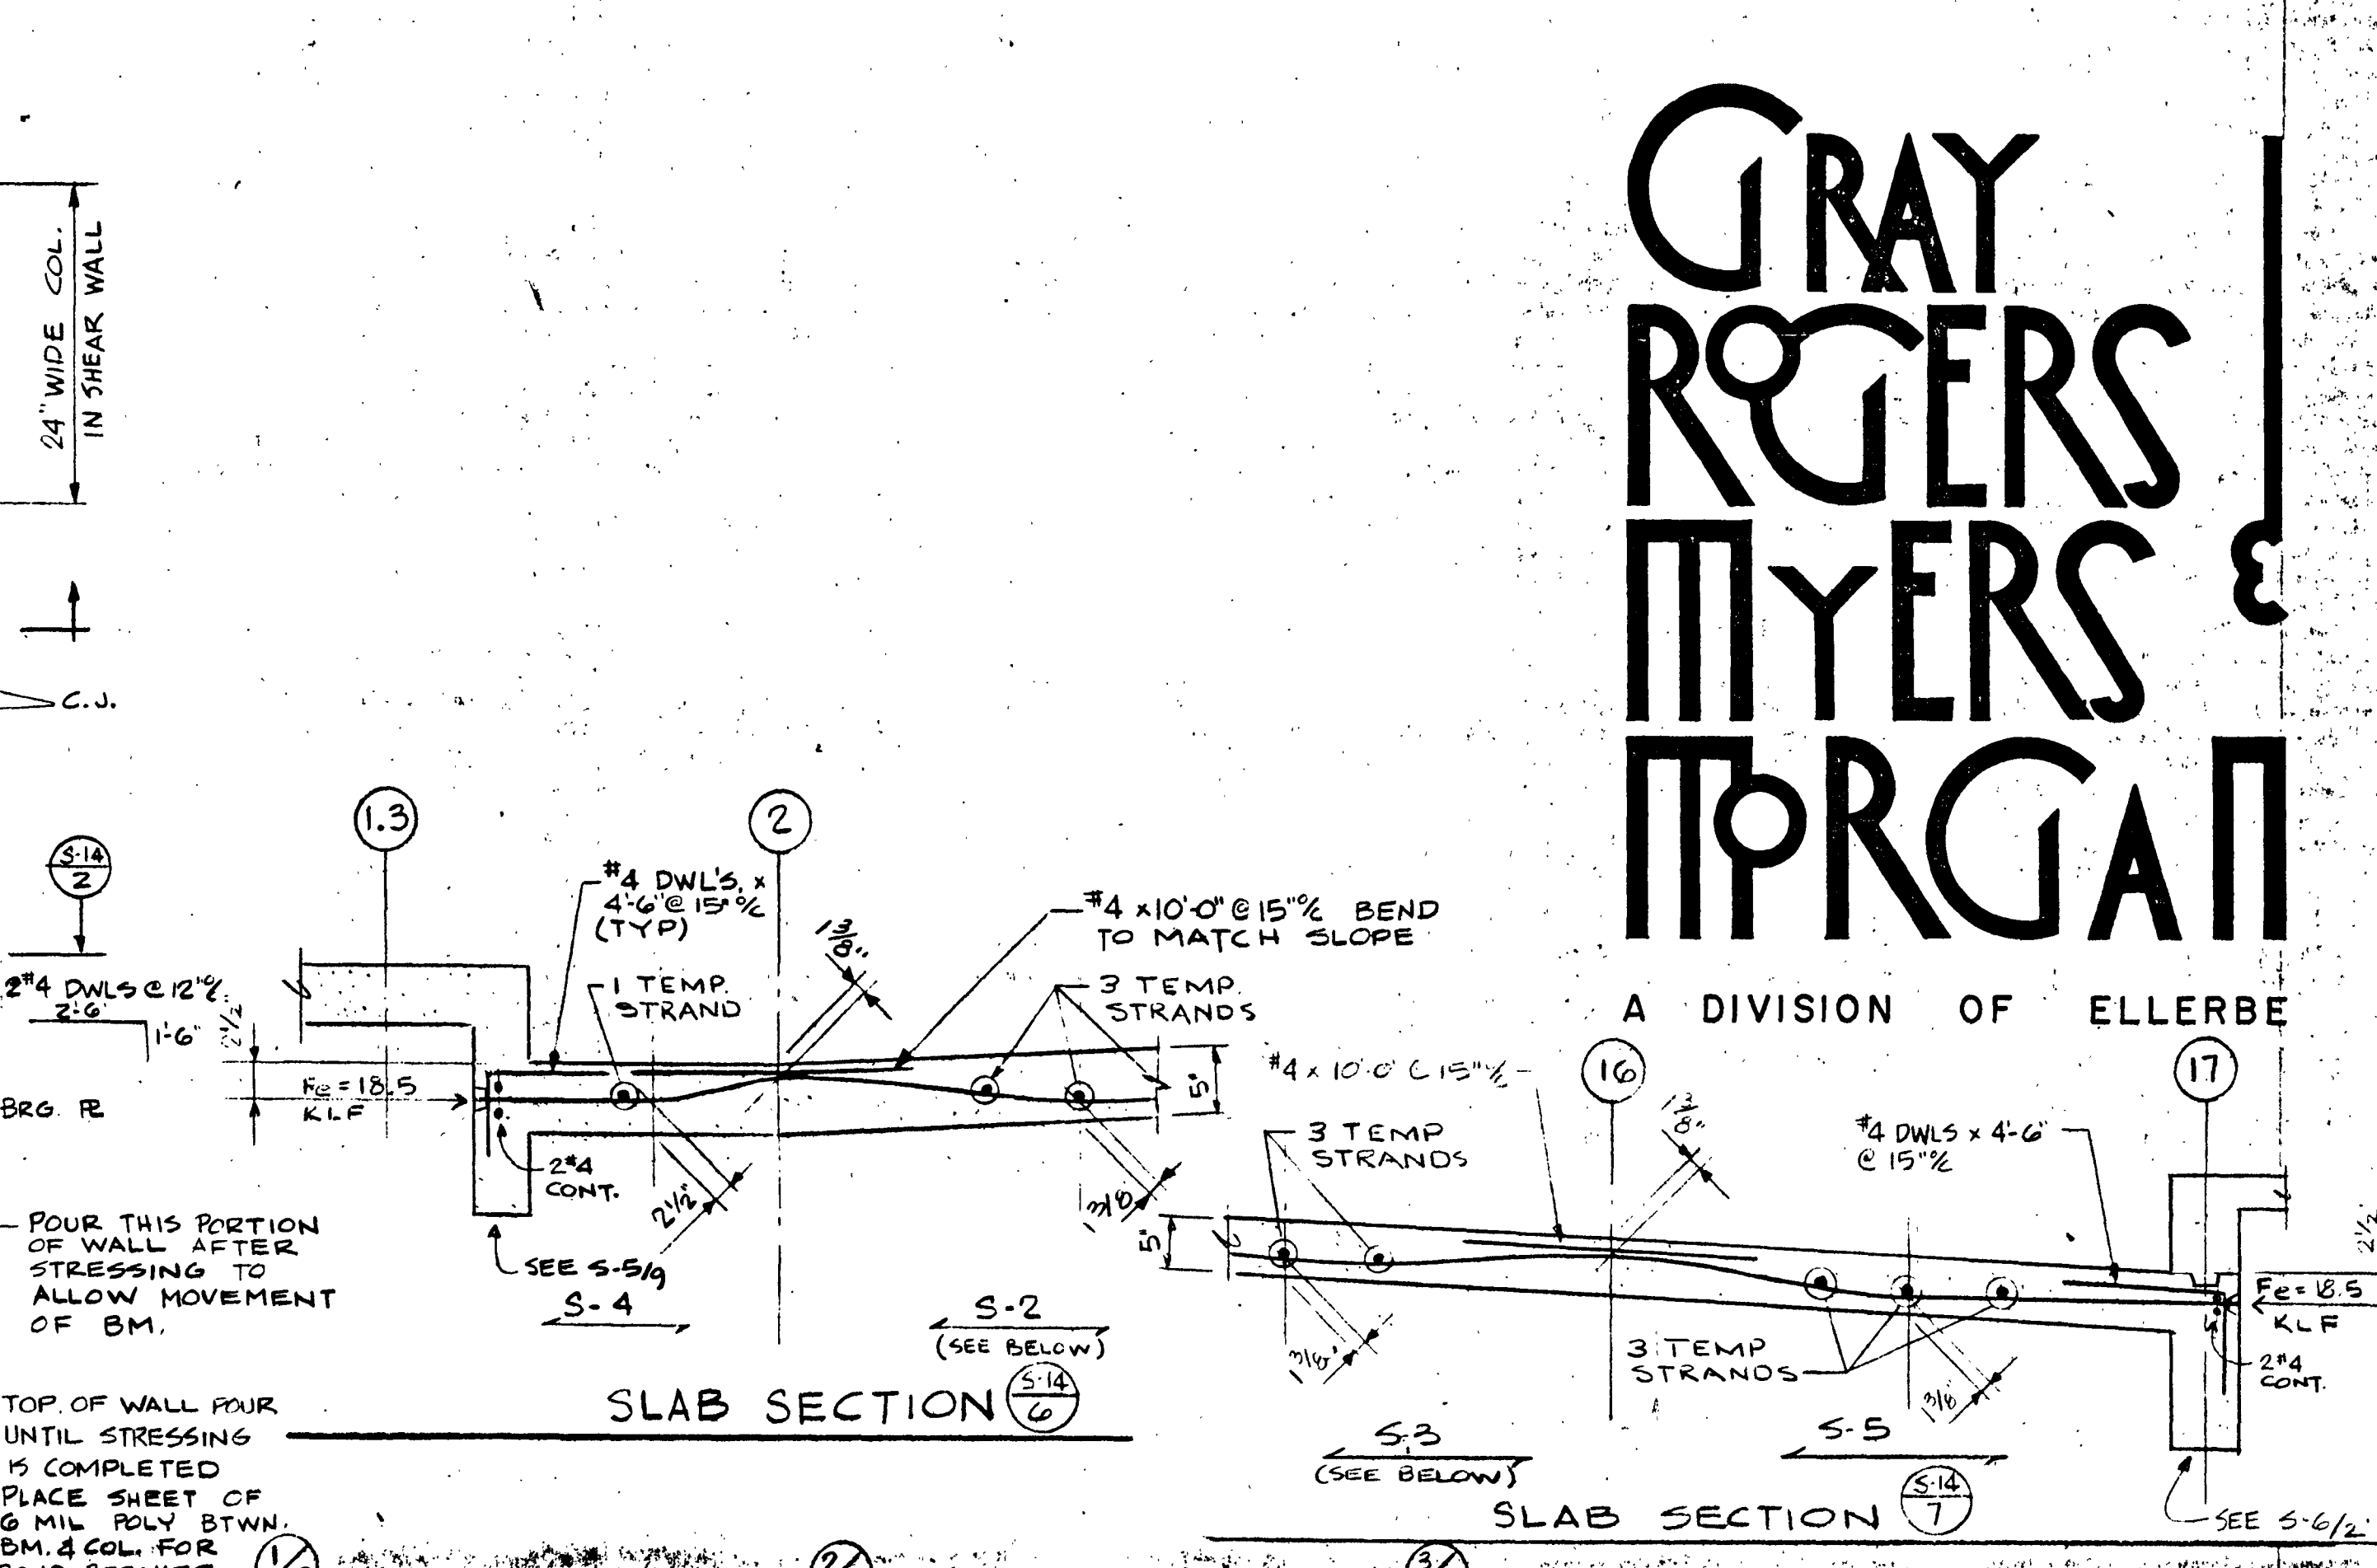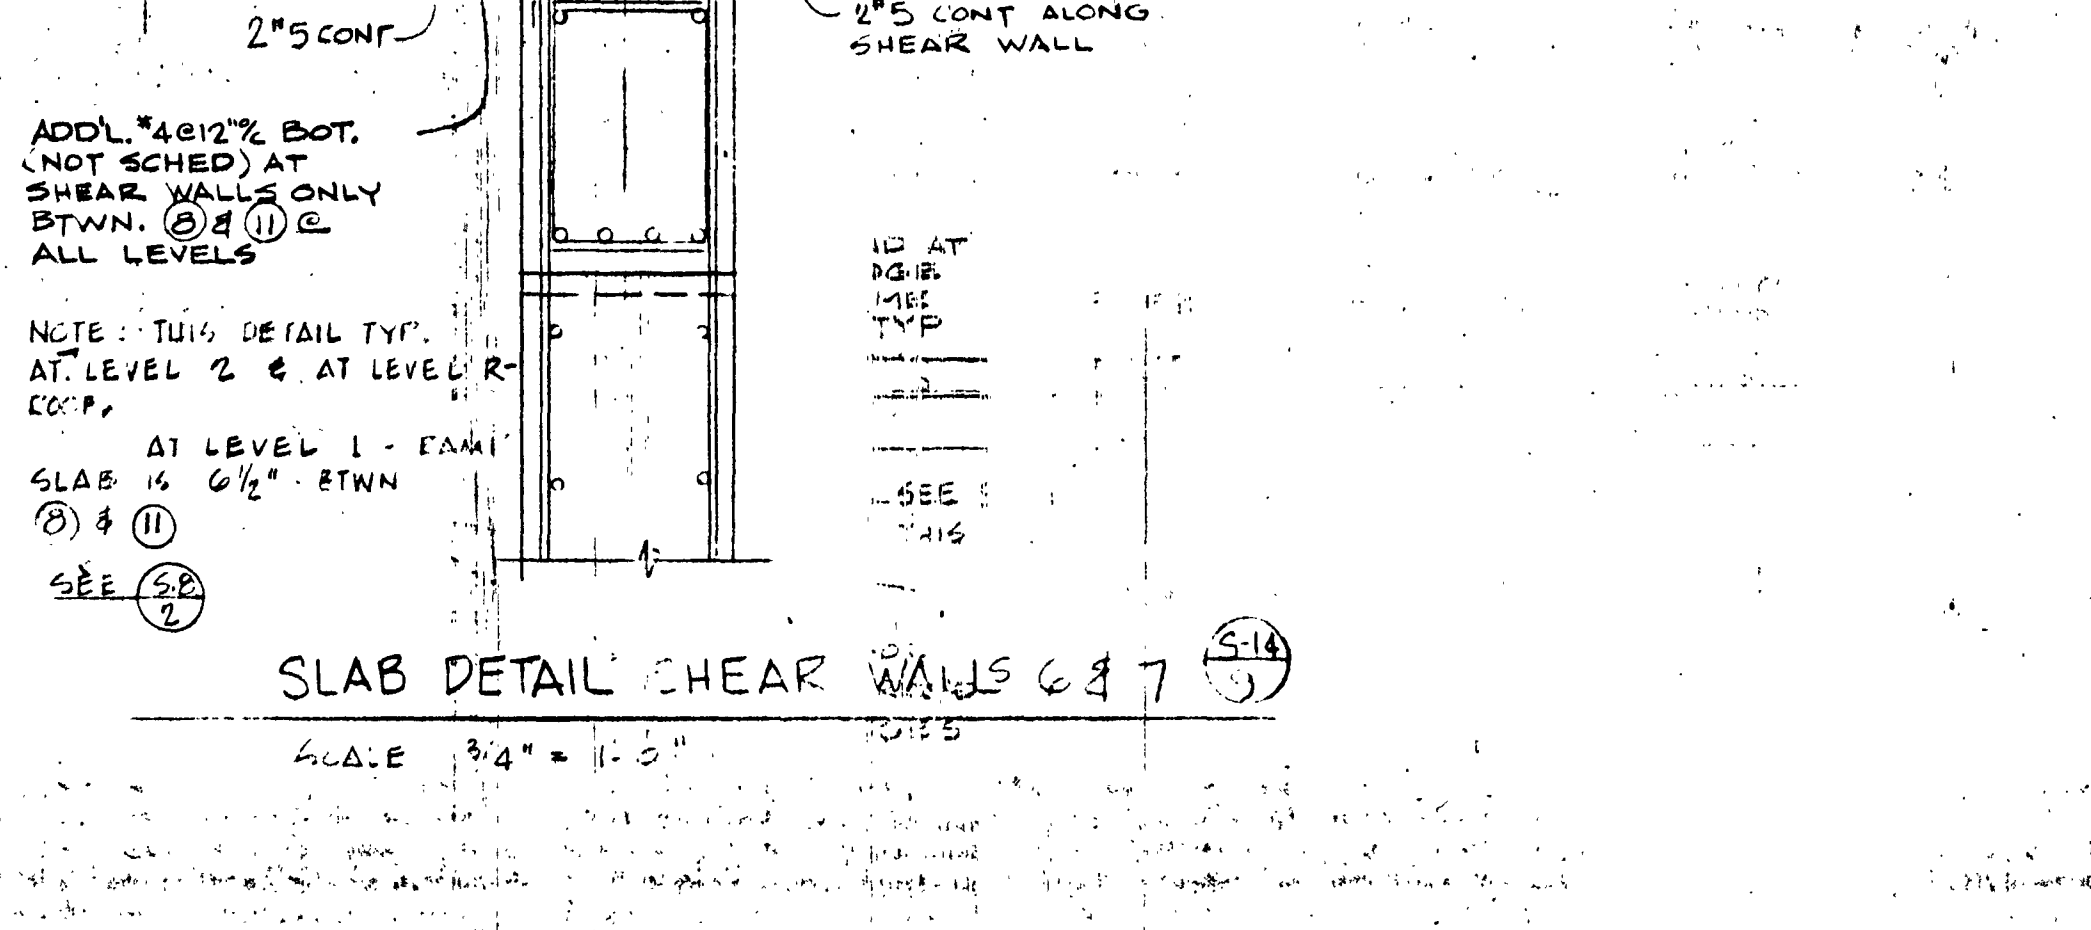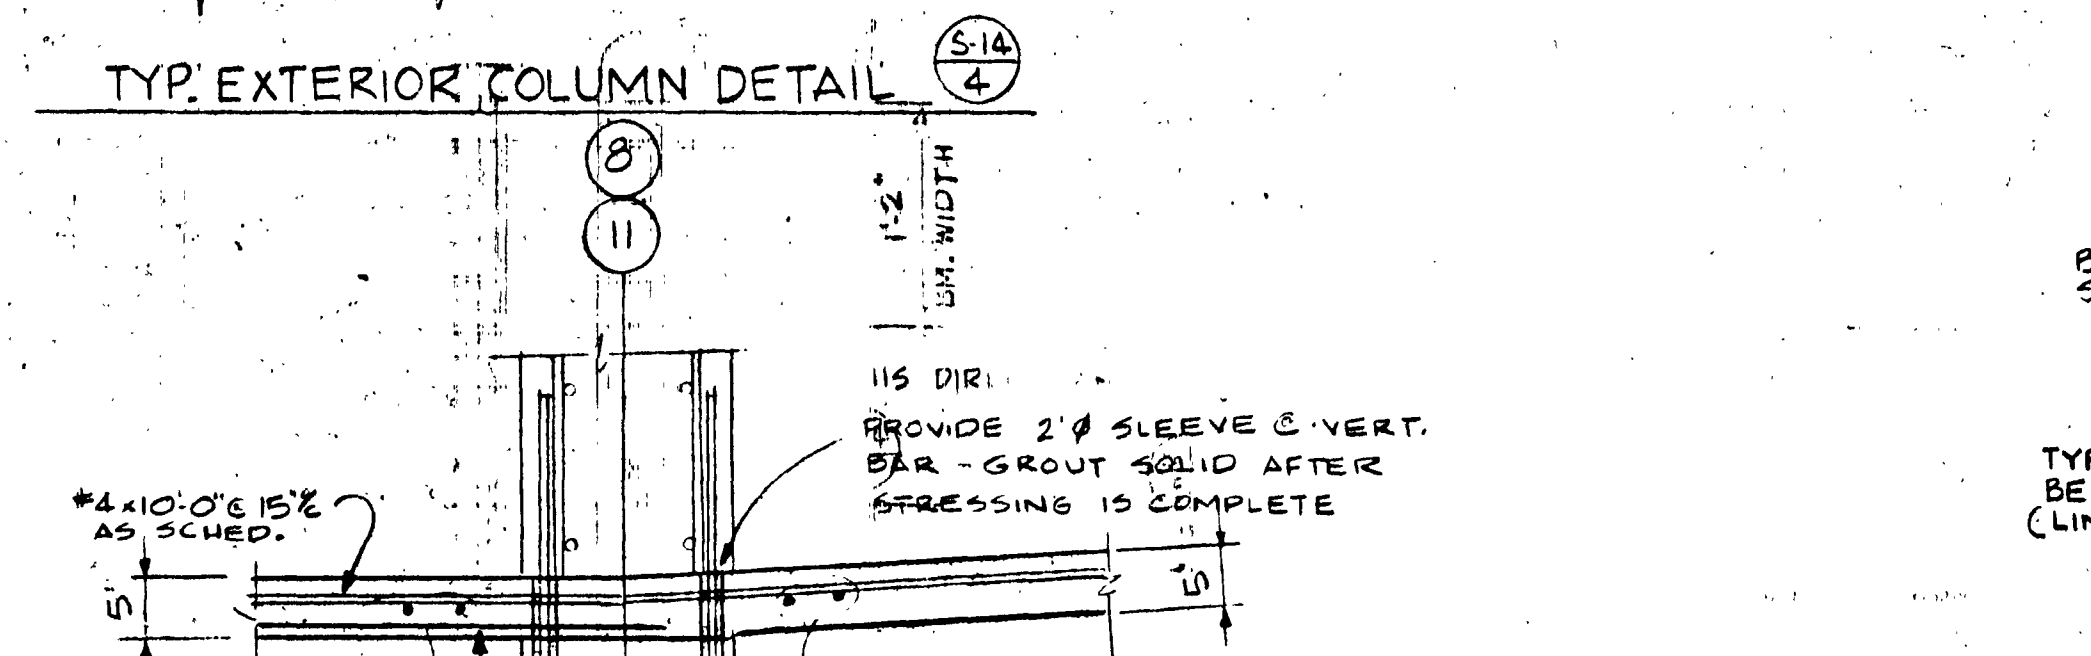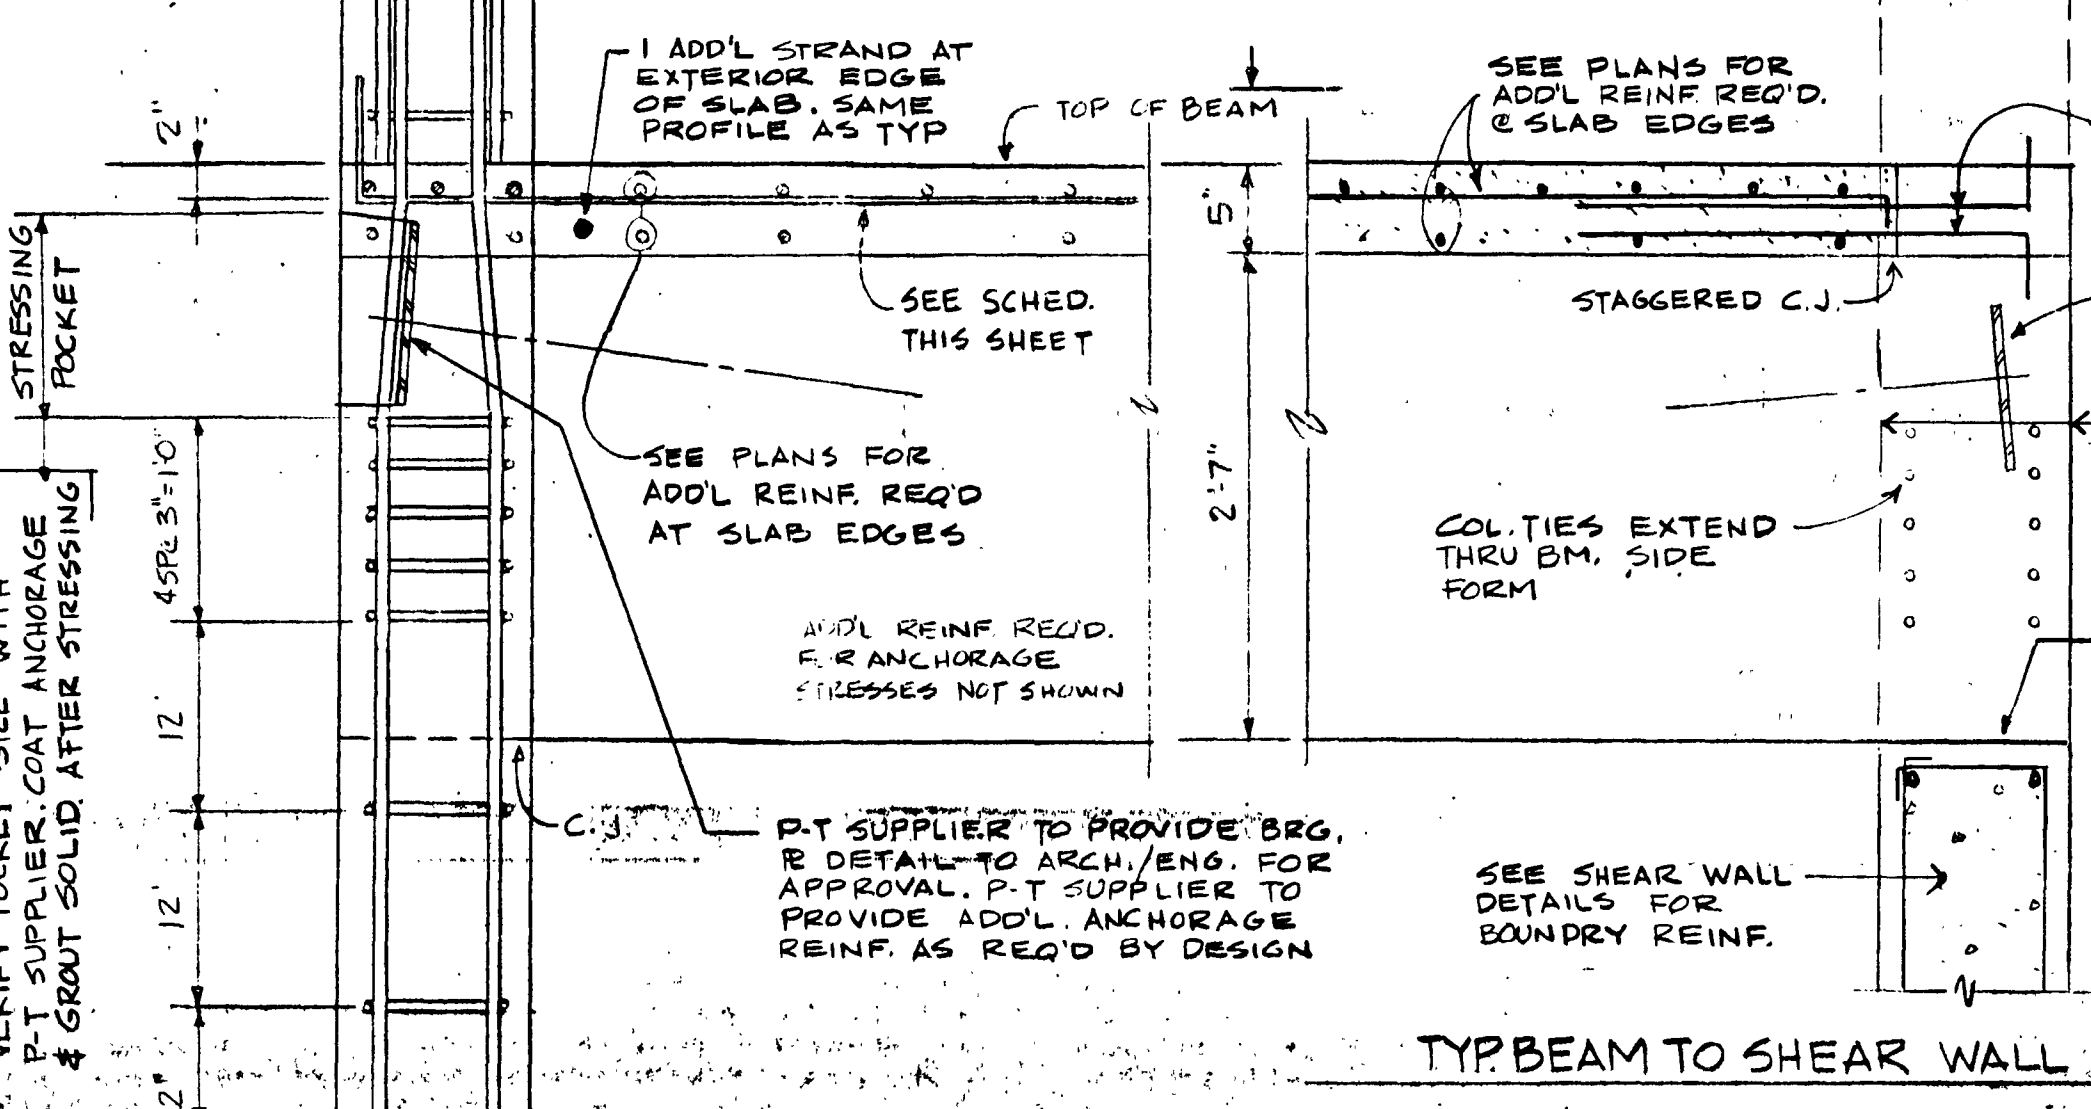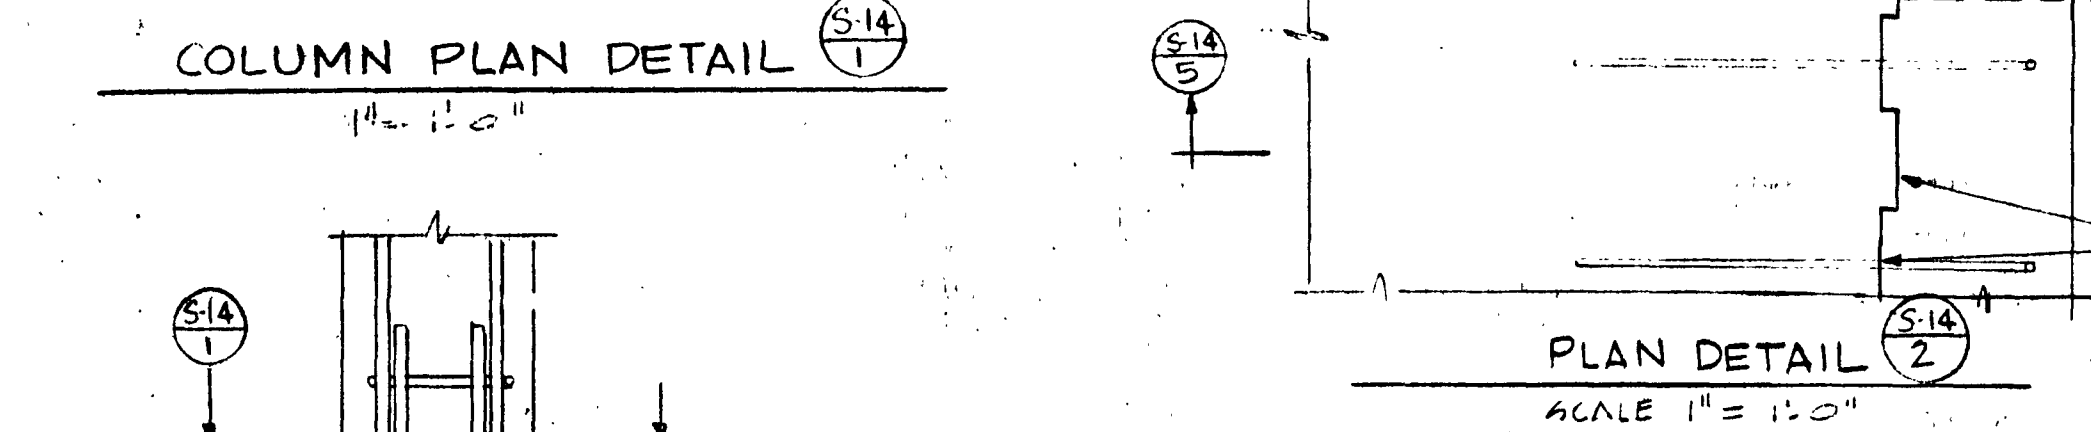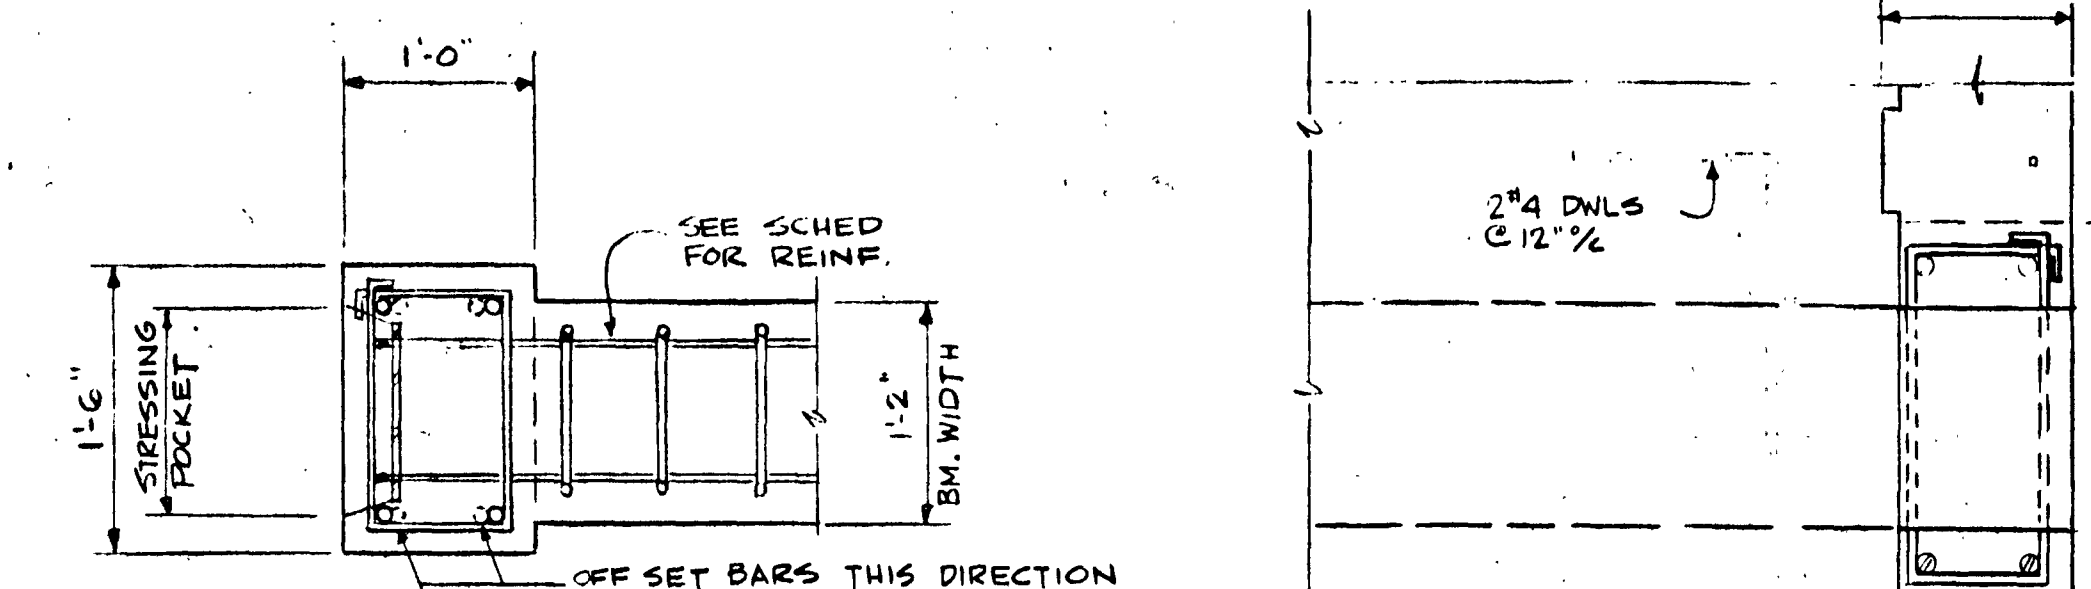

GRAY ROGERS MYERS & PRGAN

A DIVISION OF ELLERBE

ROOF SLAB SCHEDULE	
APPL. CONG. REINFORCING	
S-6	#5x10'-0" @ 15% #4x4'-0" @ 15% #4 @ 15% BOT.
S-7	#5x10'-0" @ 15% #4 @ 15% BOT.
S-8	#5x10'-0" @ 15% #4 @ 15% BOT.
S-8A	#5x10'-0" @ 9% #5 @ 12% BOT.

NOTE: ALL POST-TENSIONED SLABS TO BE 5" THICK

POST-TENSION PROFILE ONLY SEE SCHEDULE FOR ADD'L. REINF.

JOB NO. 091374
DATE: 6-21-74

ARCHITECTS • ENGINEERS • SURVEYORS
601 COLLEGE ROAD, FAIRBANKS, ALASKA 99701, PHONE: 452-1244

STATE OF ALASKA
DEPT. OF PUBLIC WORKS
DIVISION OF BUILDINGS
JUNEAU ALASKA

FAIRBANKS PARKING STRUCTURE
FAIRBANKS, AK.
DBA - 2 - 0130


THIS SHEET NOT REVISED
P.T. DETAILS NOT USED
AT CONTRACTOR'S OPTION.

S-14


SHEET 34 OF 40

GRAY ROGERS MYERS & MORGAN


A DIVISION OF ELLERBE

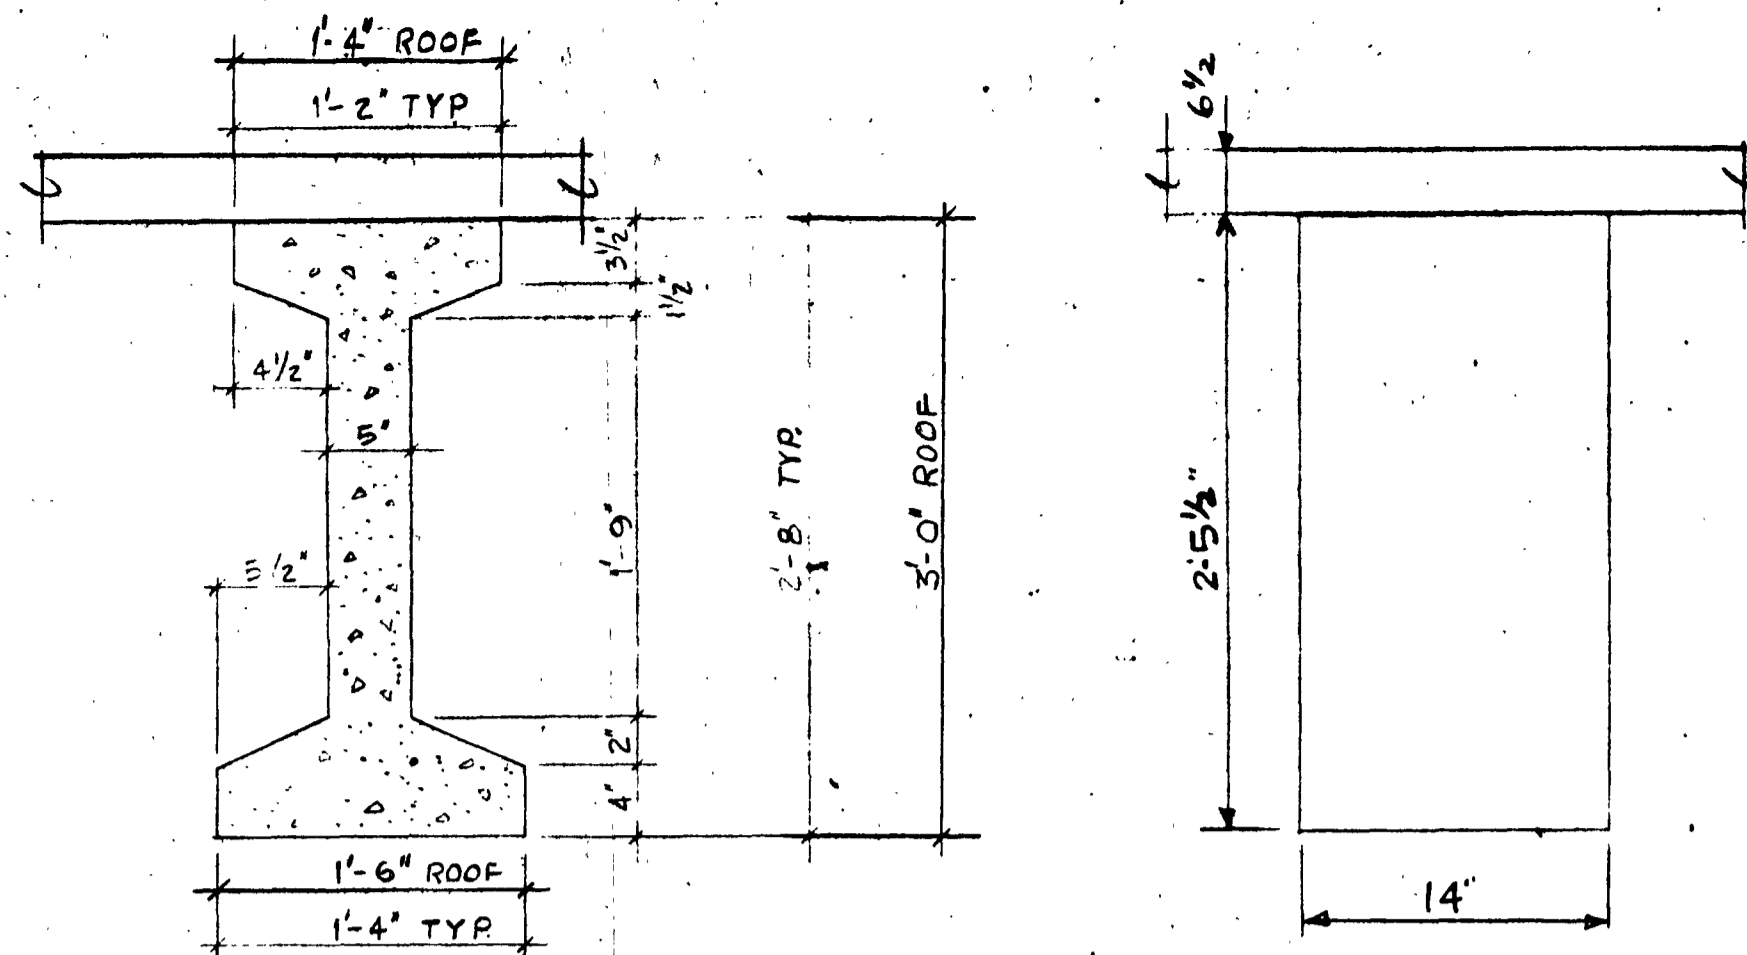

PRECAST CONC. GIRDER SECTION
FC = 6000 PSI @ 28 DAY
SCALE: NONE

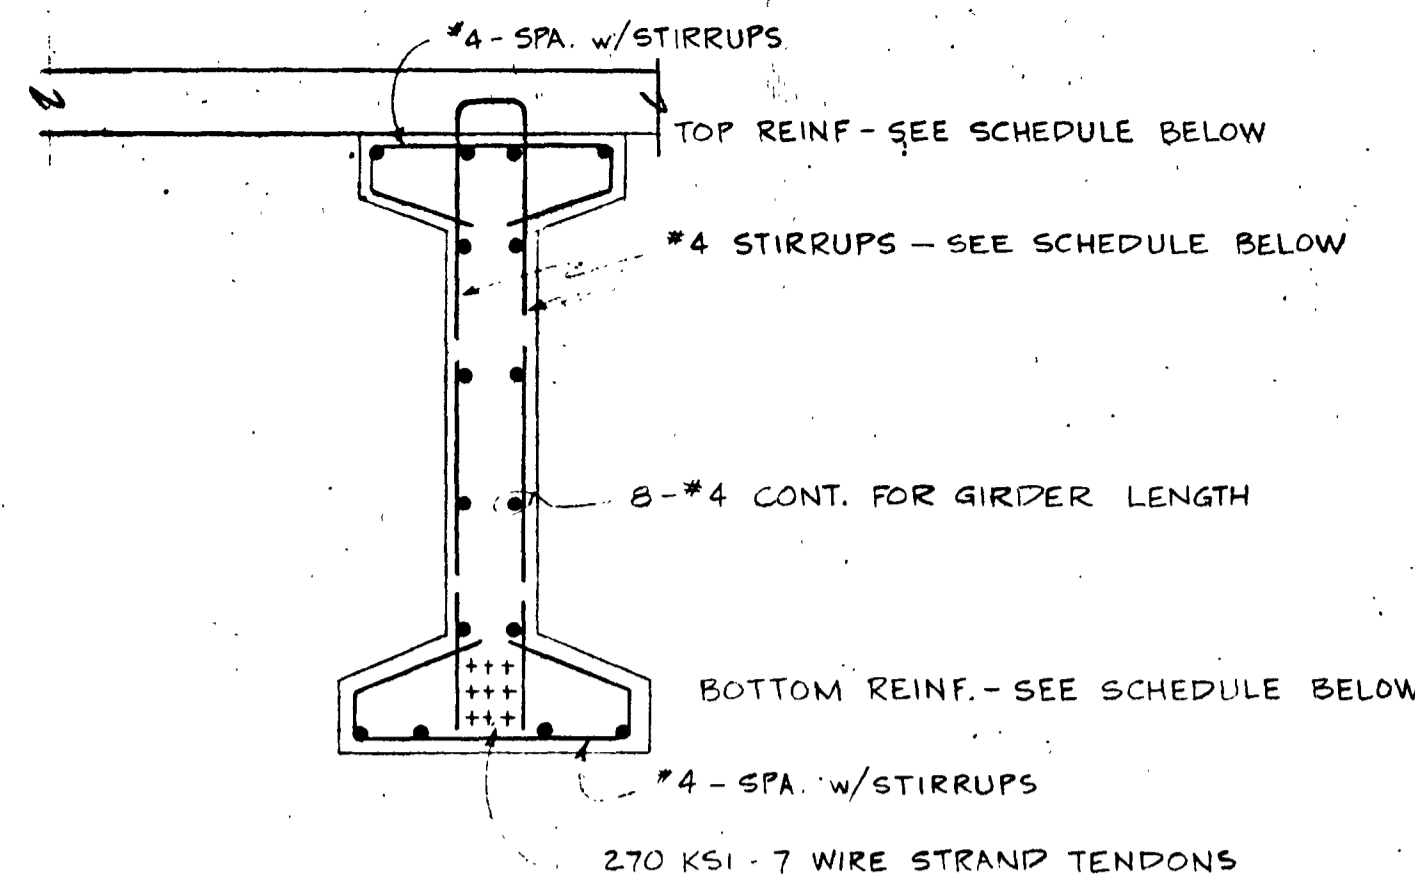

TYP. REINF. FOR PRECAST GIRDER
SCALE: NONE

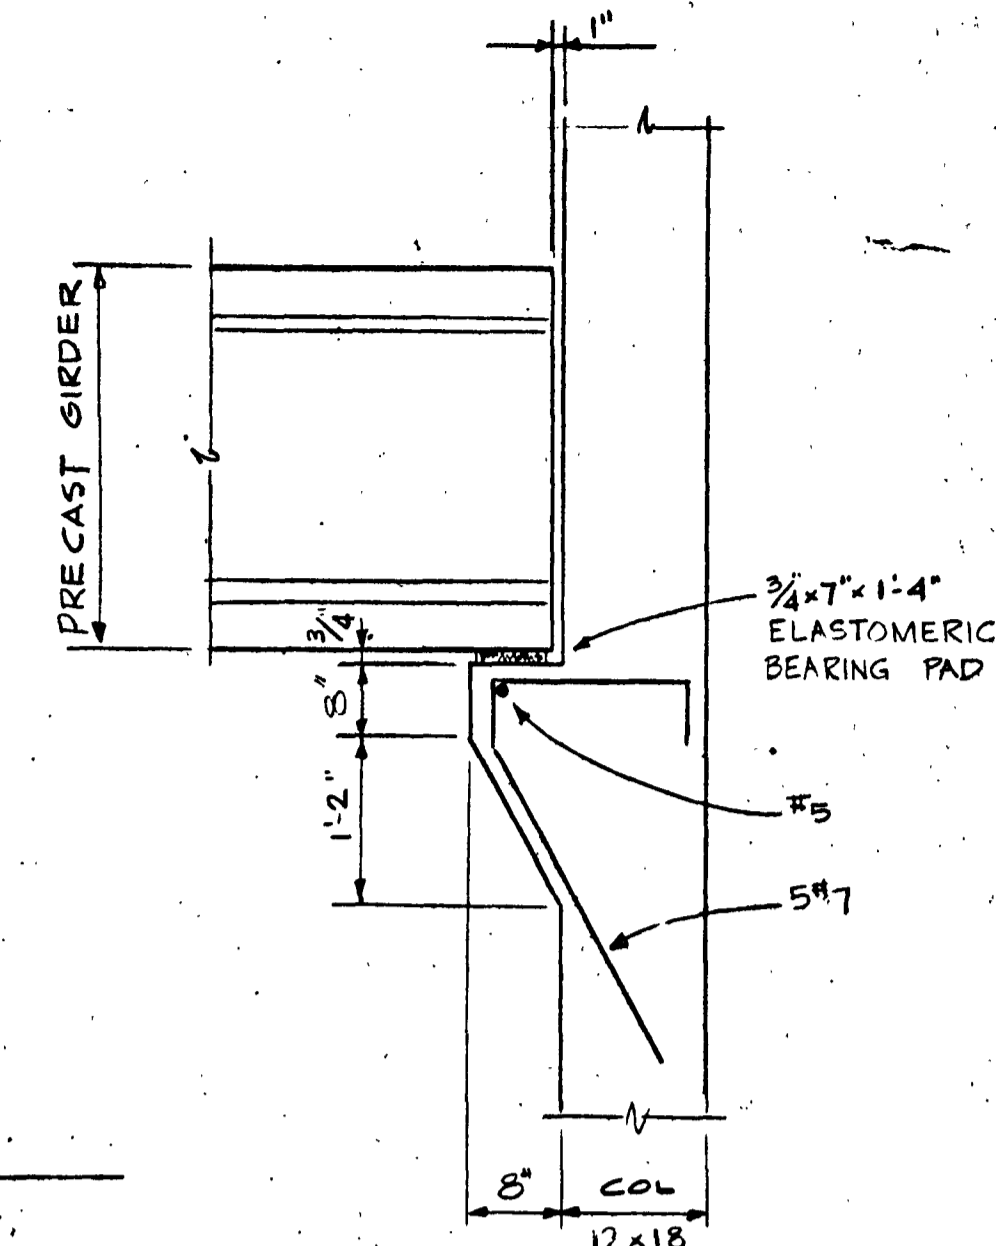


DETAIL

ACCEPTABLE CONTRACTORS OPTION PRECAST GIRDERS

Sheet 15 indicates the Contractor's Option for furnishing a precast concrete girder in lieu of the post-tensioned beam shown on Sheets S-1 thru S-14. The Contractor has also the option of furnishing a conventionally reinforced 6-1/2" concrete slab as detailed on Sheet S-15 in lieu of the 5" post-tensioned slab as shown on Sheets S-1 thru S-14. The Contractor has the option of furnishing precast columns as detailed on Sheet S-15 in lieu of the cast-in-place concrete column shown on Sheets S-1 thru S-14. The quantities of prestressing force and/or materials along with the quantities of conventional reinforcing materials shown for the precast girder are only one solution to sustain the gravity floor loads as indicated on the plans and meet the indicated Code requirements. The Engineer is aware that there may be other combinations of prestressing - post-tensioning materials along with conventional reinforcing that will adequately sustain the gravity floor loads and still meet indicated Code requirements. The Contractor has the option to submit alternate designs for the precast girder utilizing combinations of prestressing, post-tensioning, and conventional reinforcing materials. Precast girder sizes shall conform to the acceptable shapes shown on this sheet. Contractor shall also refer to Precast Option Note on Sheet S-1. The proposed alternate design for the precast girder shall be submitted to the Engineer for approval prior to commencement of any work. The submitted alternate design shall clearly indicate the amounts of prestress, post-tension, and conventional reinforcing materials, and all pertinent details. The submitted alternate design shall be accompanied by structural calculations done under the supervision of a registered professional engineer experienced in prestress - post-tension concrete design. These submitted calculations shall clearly indicate the prestress - post-tension force, conventional reinforcement, working stresses, shear calculations, ultimate moment capacity, and all other pertinent calculations required to satisfy the ACI 318-71 Code and the Uniform Building Code.


A-2, 6, 11, 12, 13, 14, 15, 16, 17	D-2	2-9	6-2
D-3, 4, 15, 16	D-7	2-10	6-9
D-8, 9, 15, 16			6-10
G-2, 6, 7, 12, 13, 17			6-11

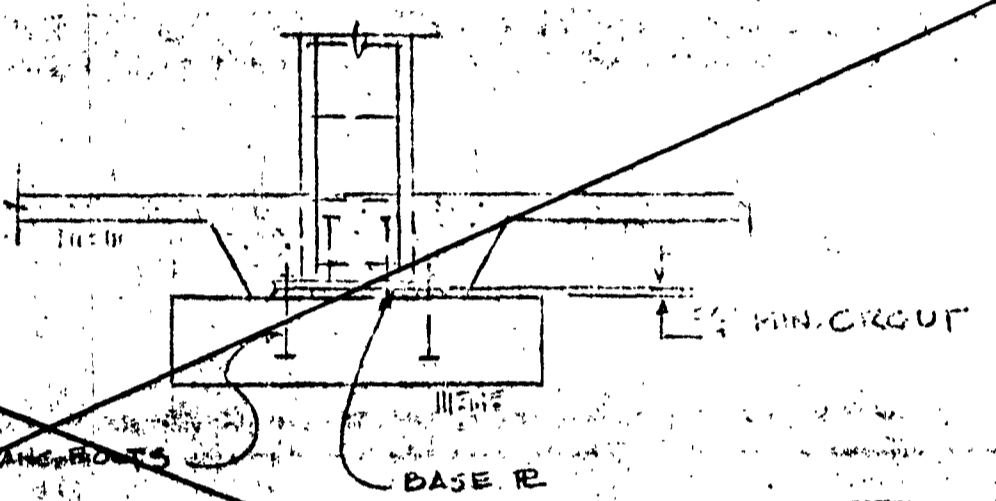

TYP. FOOTING DETAIL
PRECAST COLUMN (CONTRACTORS OPTION)
NOTE: PT. COL. DETAILS NOT USED AT CONTRACTORS OPTION


GIRDER	P.T. FORCE	TOP BARS	BOT. BARS	4"	8"	12"	16"
G1, G2, G3, G3R	353 KIPS	4-#6	4-#9	12	6	8	✓
G4, G4R	353 K	4-#6	4-#9	12	6	8	✓
G5, G6	353 K	4-#6	4-#9	12	6	8	✓
GT	353 K	4-#6	4-#9	12	6	8	✓
G8, G9, G10, G10R	353 K	4-#9	8-#9	36	6	8	✓
G11, G11R, G12, G12R	353 K	4-#9	8-#9	36	6	8	✓
G13, G14, G15	353 K	4-#9	8-#9	36	6	8	✓

NOTE: PRECAST CONC. GIRDER SHALL BE SHORED FOR CAST-IN-PLACE CONC. SLAB. CONTRACTOR SHALL HAVE OPTION OF SUBMITTING ALTERNATE PRE-CAST CONCRETE GIRDER SCHEMES TO ENGINEER FOR APPROVAL. ALL ALTERNATE PROPOSALS SHALL BE SUBMITTED WITH ENGINEERING CALCULATIONS PERTAINING TO MEMBER SIZES, REINFORCING STEEL AND PRESTRESSING STRANDS. CONTRACTOR SHALL ALSO HAVE THE OPTION OF SUBMITTING A PARTIAL PRESTRESSING, PARTIAL POST-TENSIONING SCHEME.

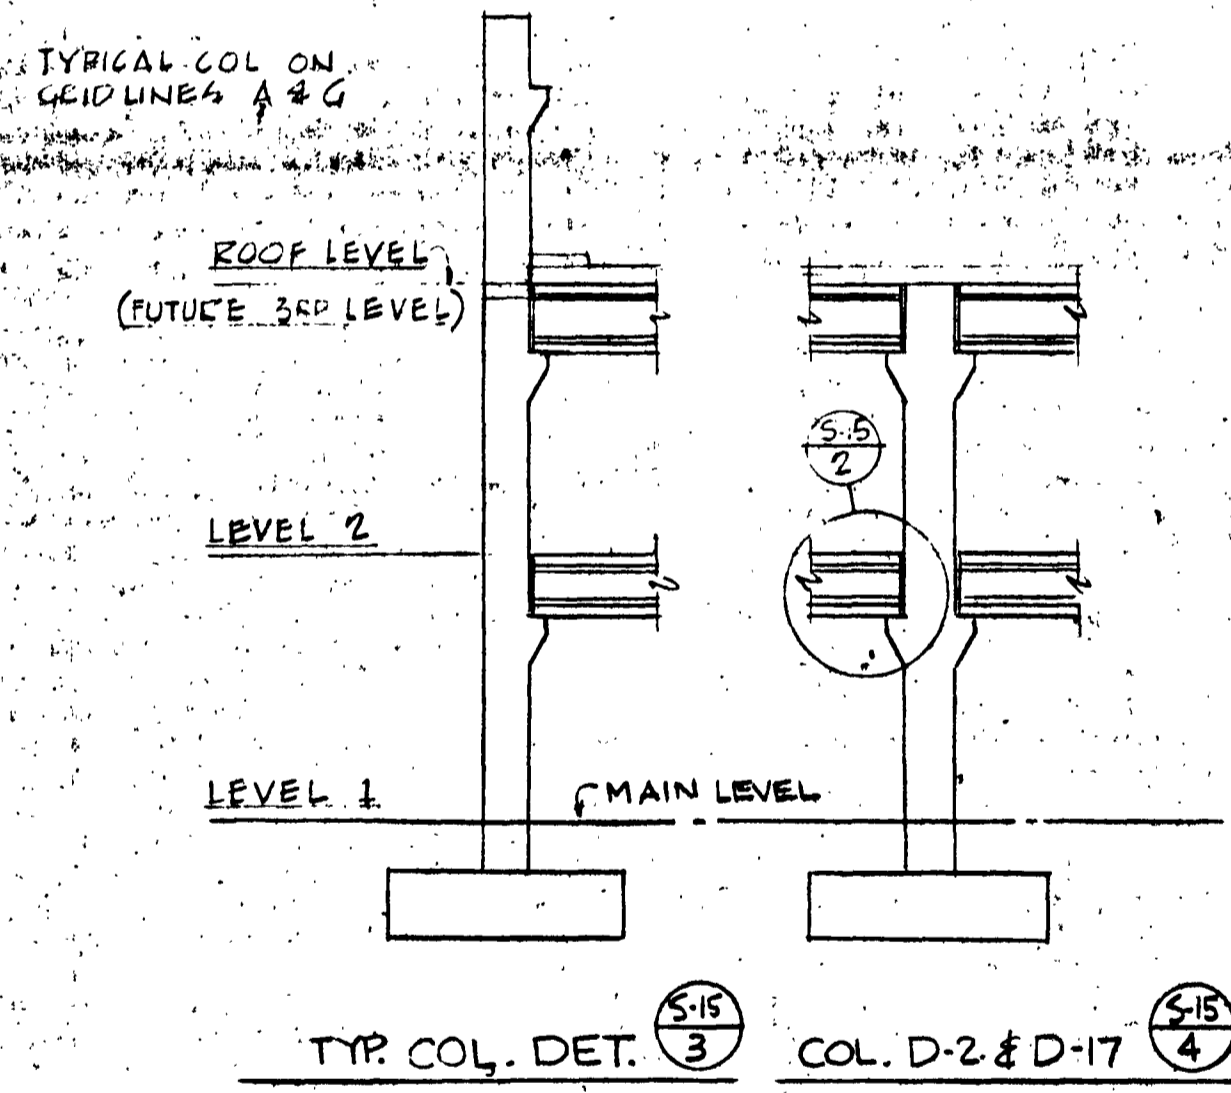

SLAB NO.	SECTION	REINFORCEMENT
S-1		#5E12, #5E12, #5E10
S-1R		#5E12, #5E12, #5E10
S-2		#5E12, #5E10
S-2R		#5E12, #5E10
S-3		#5E12, #5E10
S-4		#5E12, #5E12
S-5		#5E12, #5E12
S-6		#5E12, #5E12
S-6R		#5E12, #5E12
S-7		#5E12, #5E12
S-7R		#5E12, #5E12
S-8		#5E12, #5E12
S-9		#5E12, #5E12
S-10		#5E12, #5E12

NOTES:
1. USE TYP. BEAM DIAGRAM SHEET S-10 FOR BAR LENGTH REQ'D FOR SLABS.
2. TEMP. STEEL TO BE #4 @ 12" @

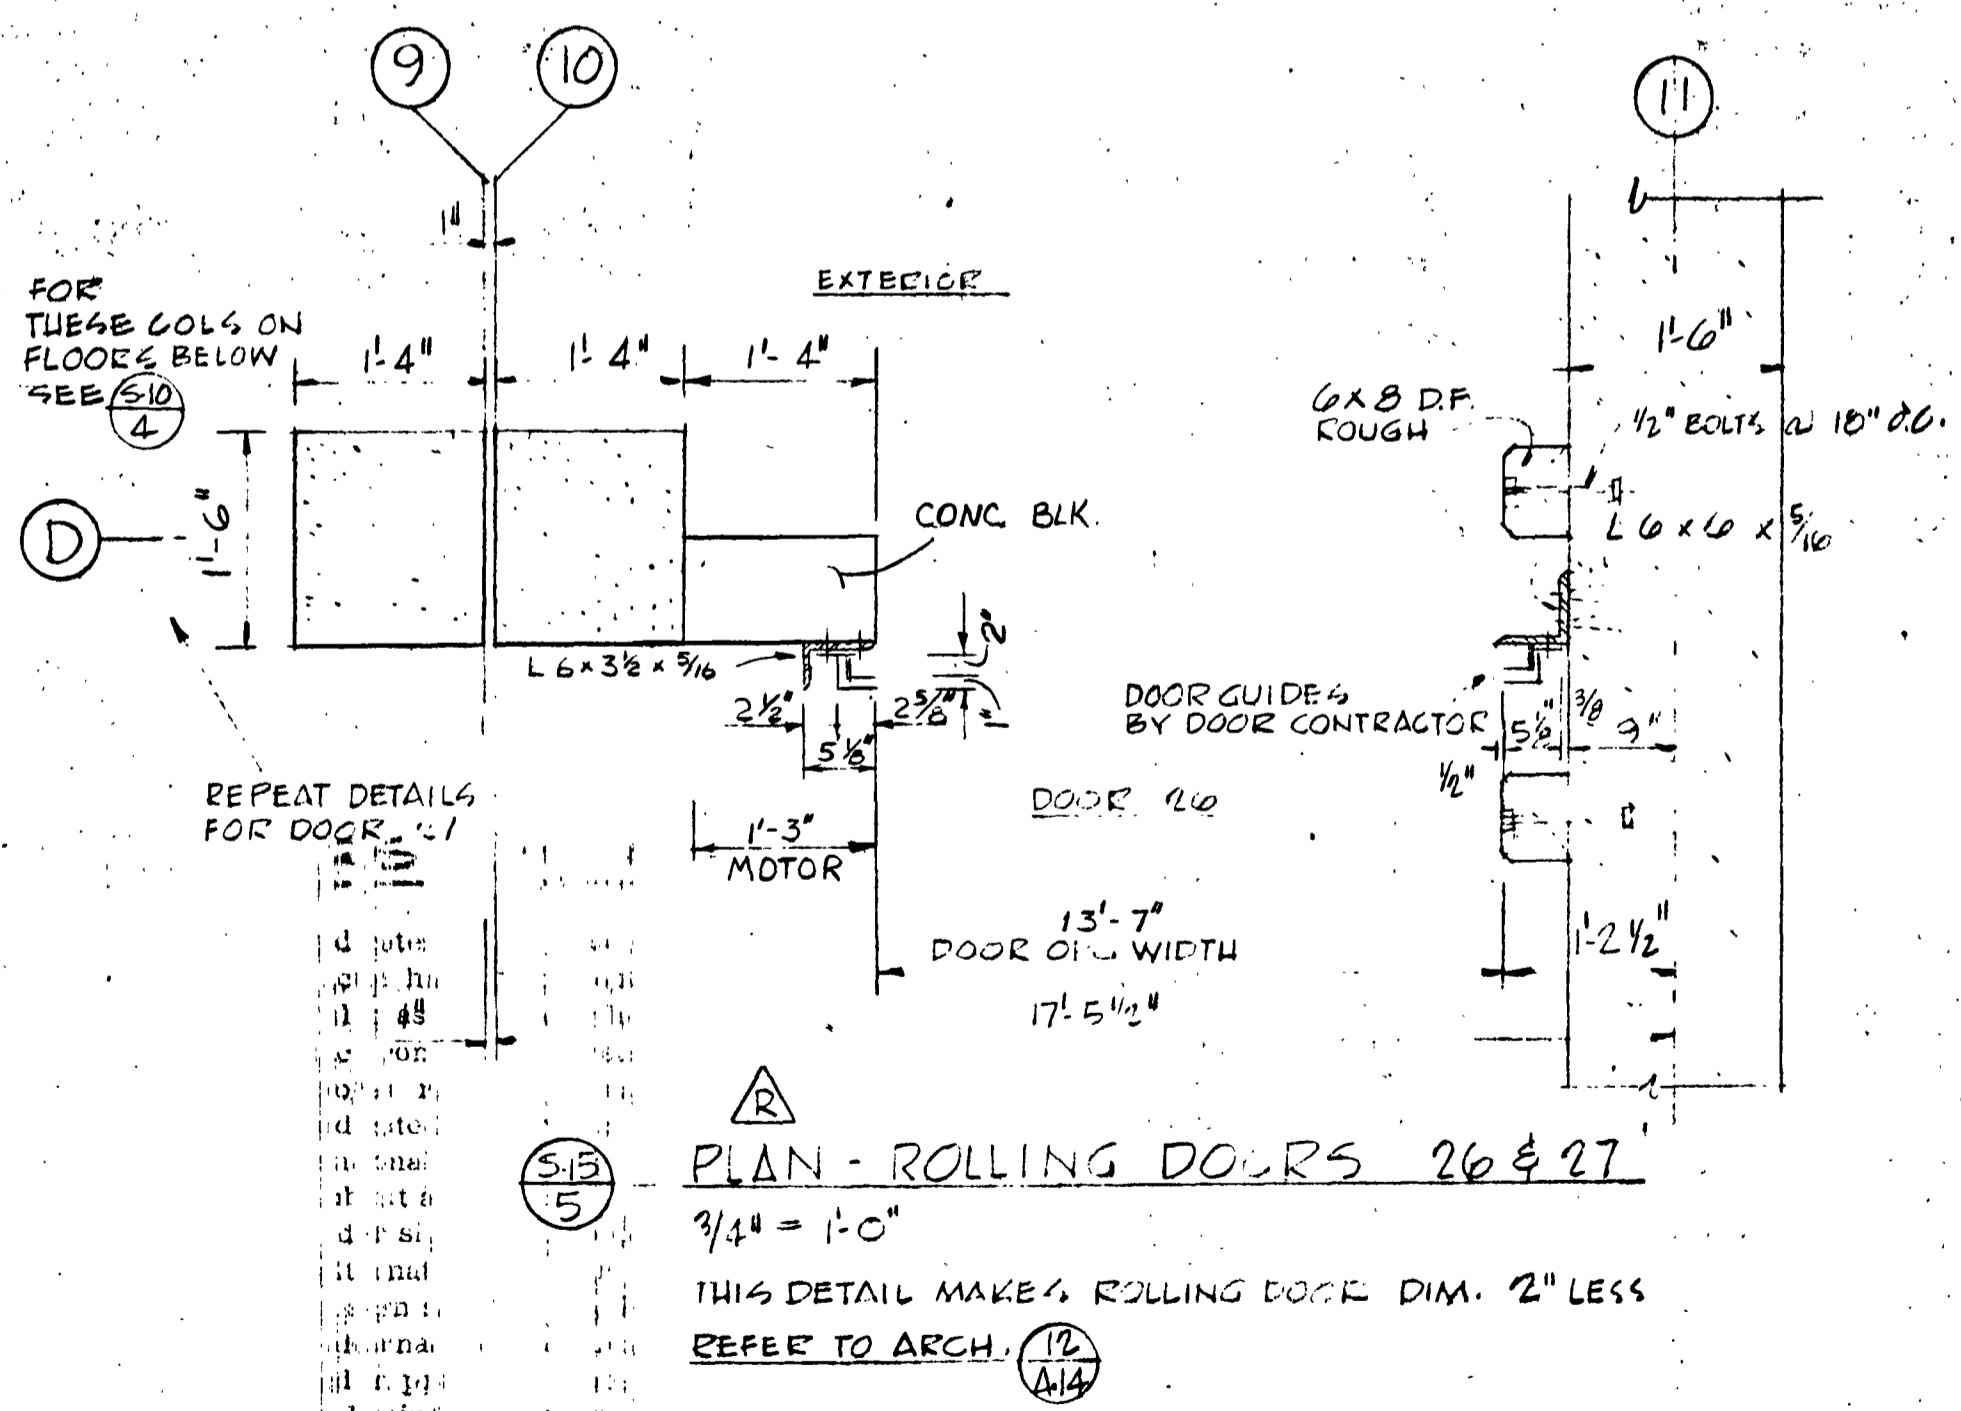

PLAN - ROLLING DOORS 26 & 27
3/4" = 1'-0"
THIS DETAIL MAKES ROLLING DOOR DIM. 2" LESS
REFER TO ARCH. 12 A14

JOB NO. 62
DATE: 6-2-77

ARCHITECTS • ENGINEERS • SURVEYORS
901 COLLEGE ROAD, FAIRBANKS, ALASKA, 99701, PHONE: 452-1241

STATE OF ALASKA
DEPT. OF PUBLIC WORKS
DIVISION OF BUILDINGS
JUNEAU ALASKA



FAIRBANKS PARKING STRUCTURE
FAIRBANKS, AK.
DBA - 2 - 0130

PRECAST GIRDERS AND CONVENTIONAL REINFORCED SLAB DETAILS


S-15

GRAY ROGERS MYERS & PRGAN

A DIVISION OF ELLERBE

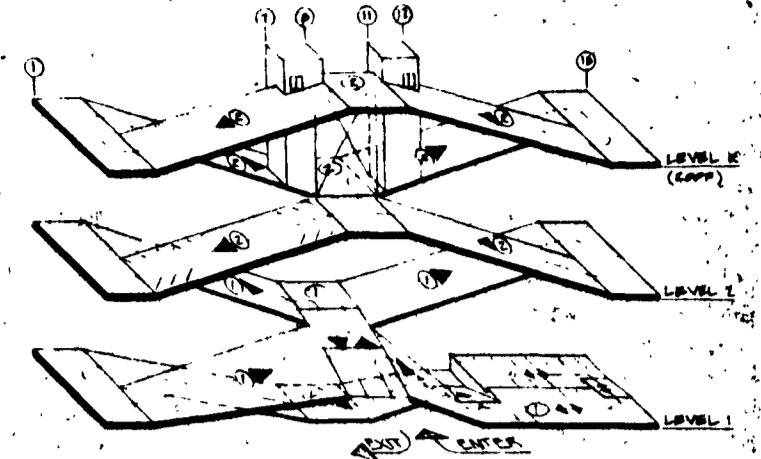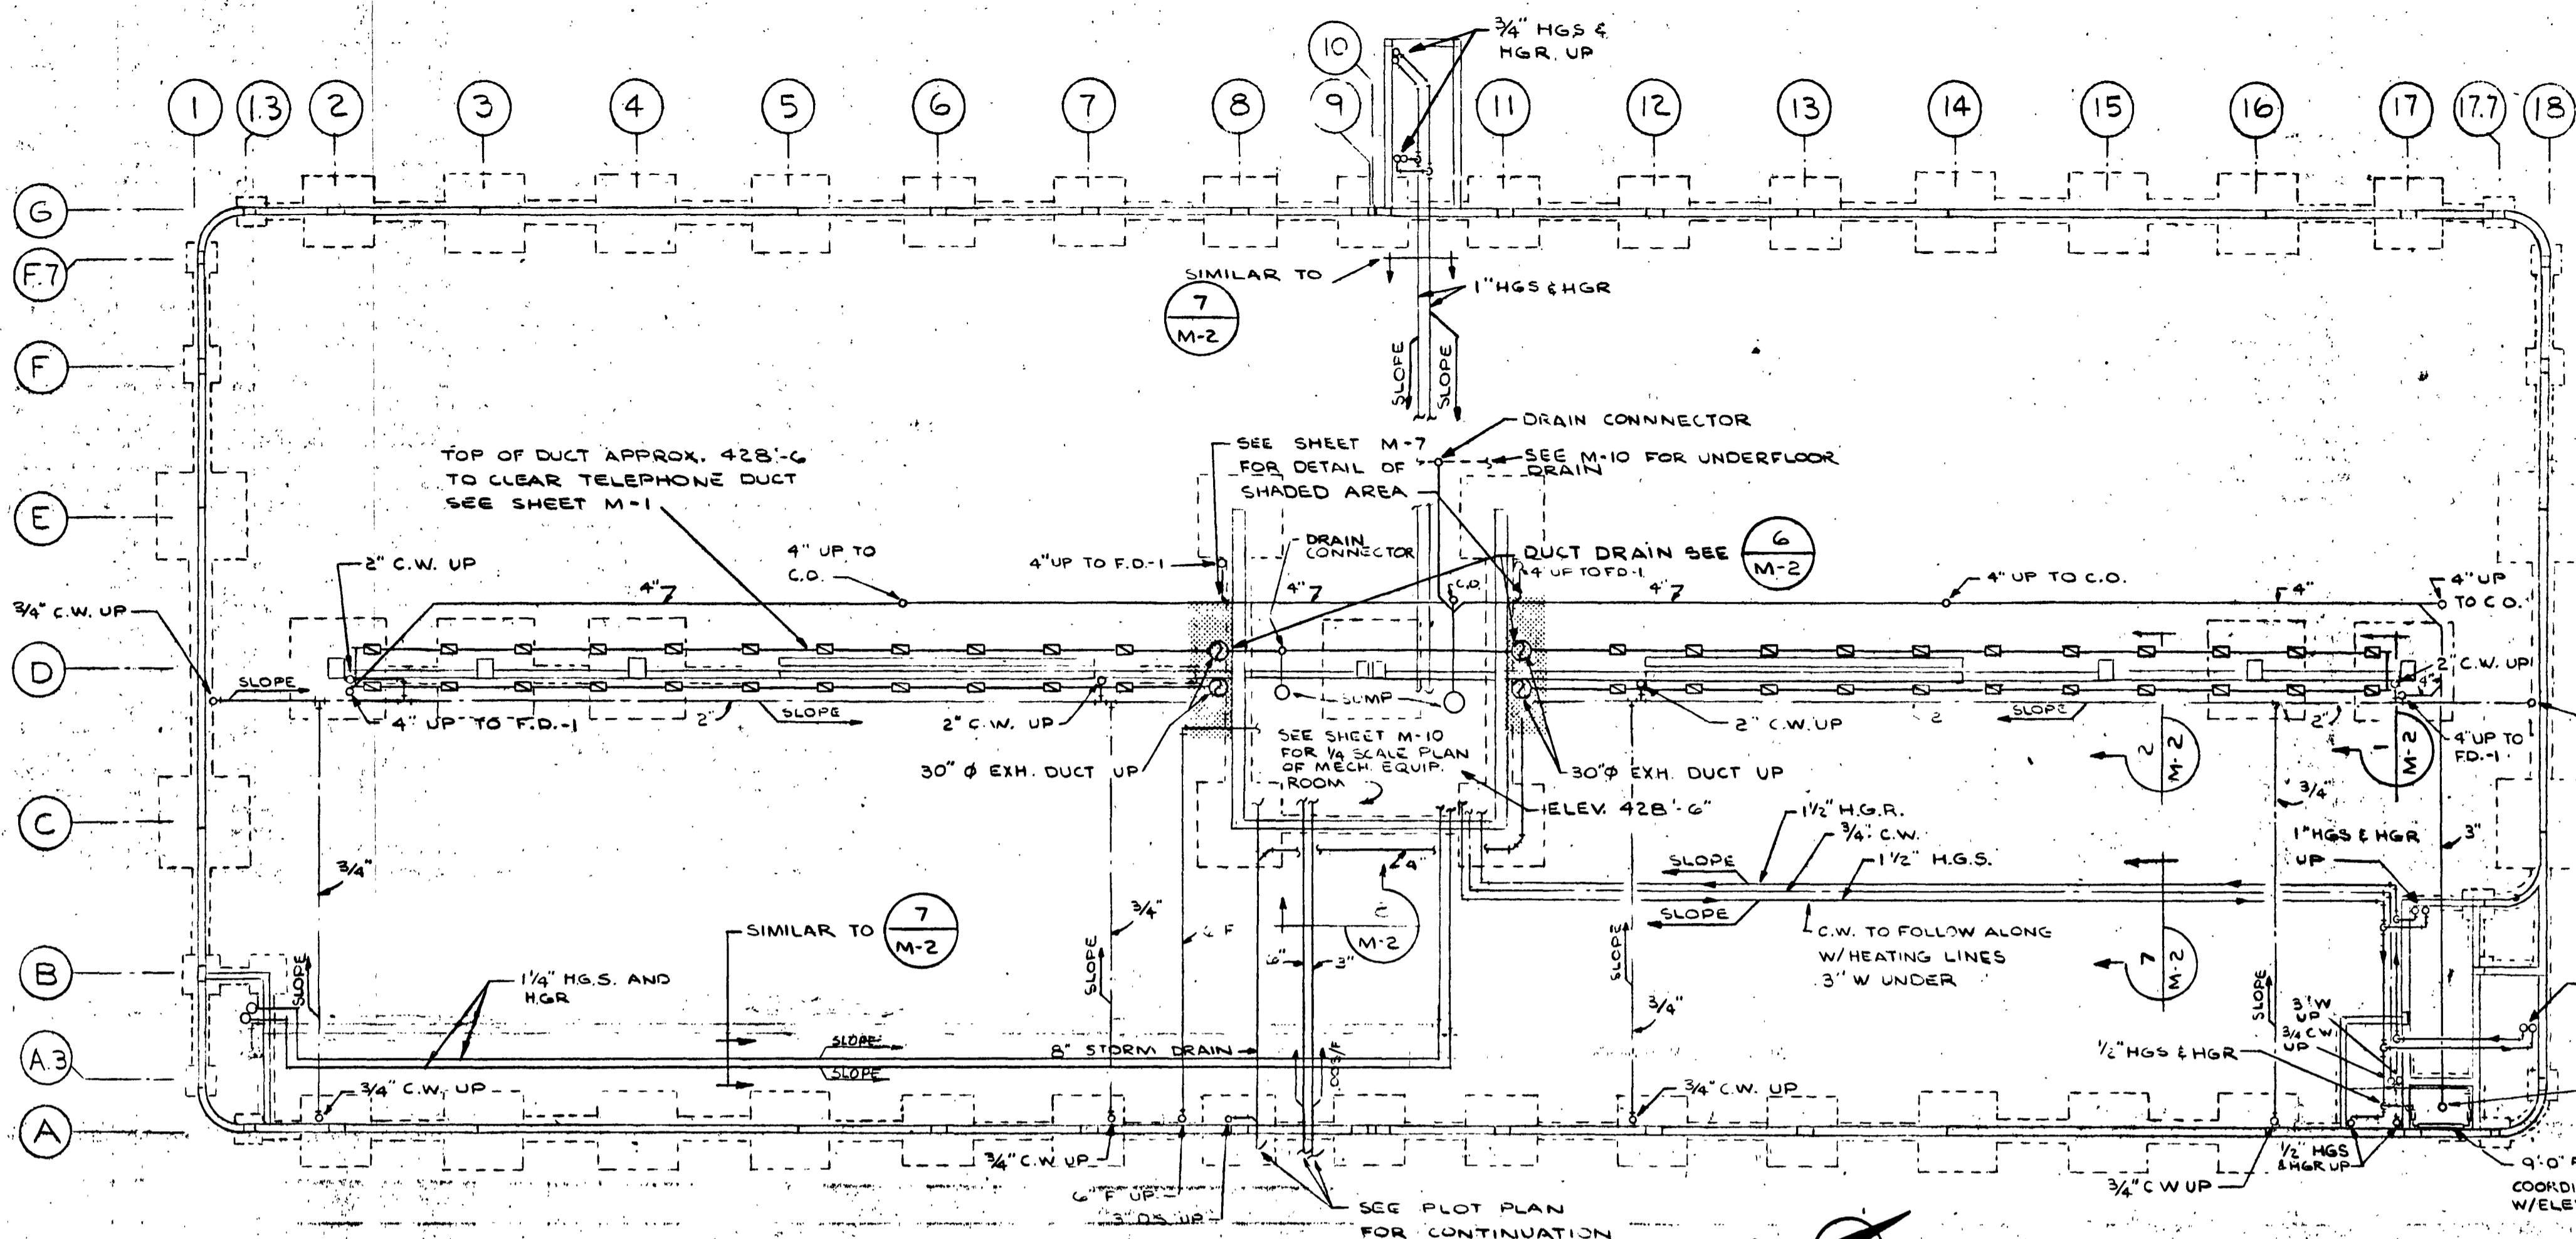


KEY PLAN
NO SCALE

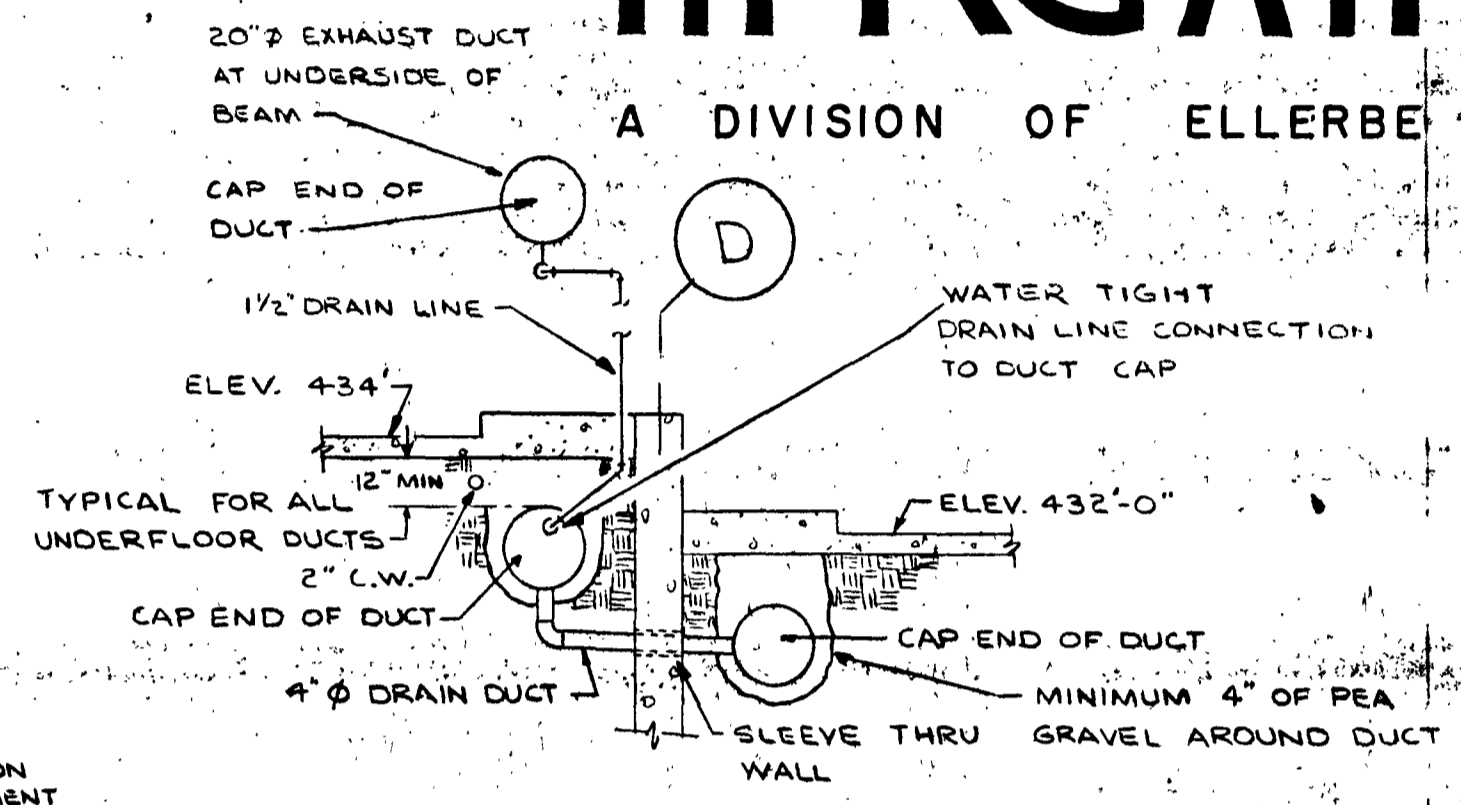


SECTION M-2
SCALE 1/4\"/>


FOUNDATION PLAN
SCALE 1/16\"/>

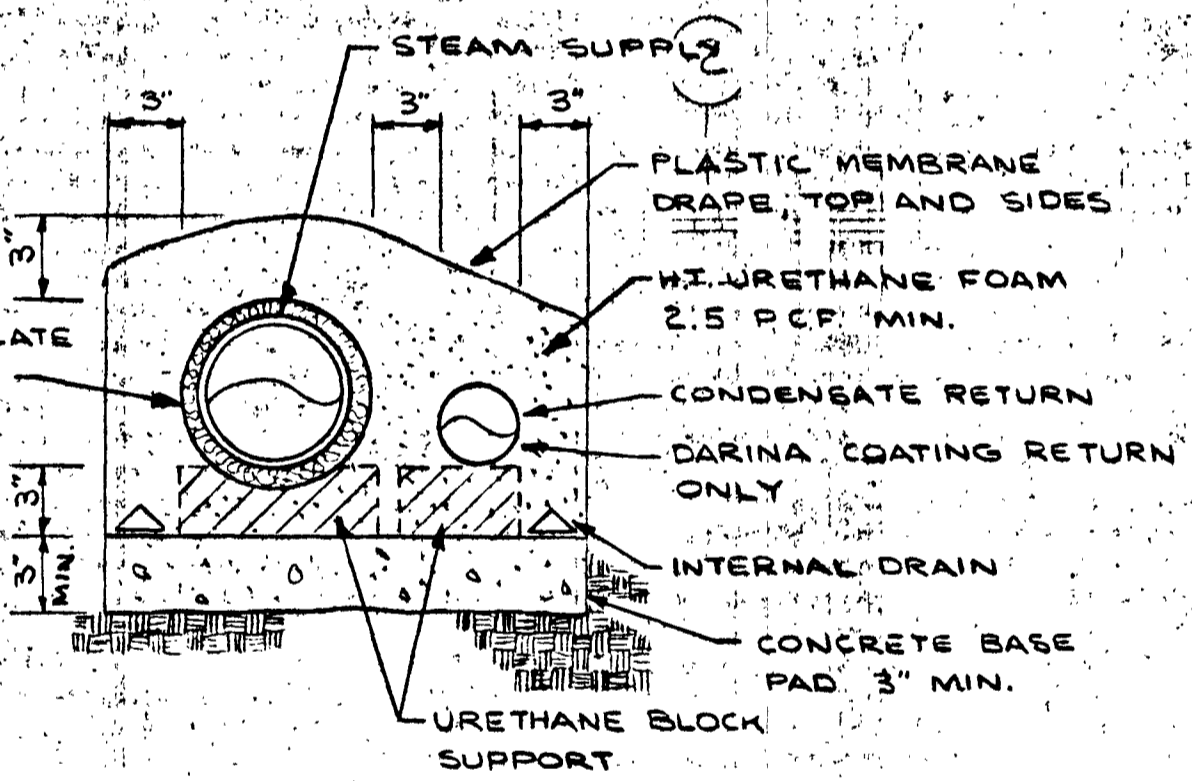


SECTION 8
NO SCALE

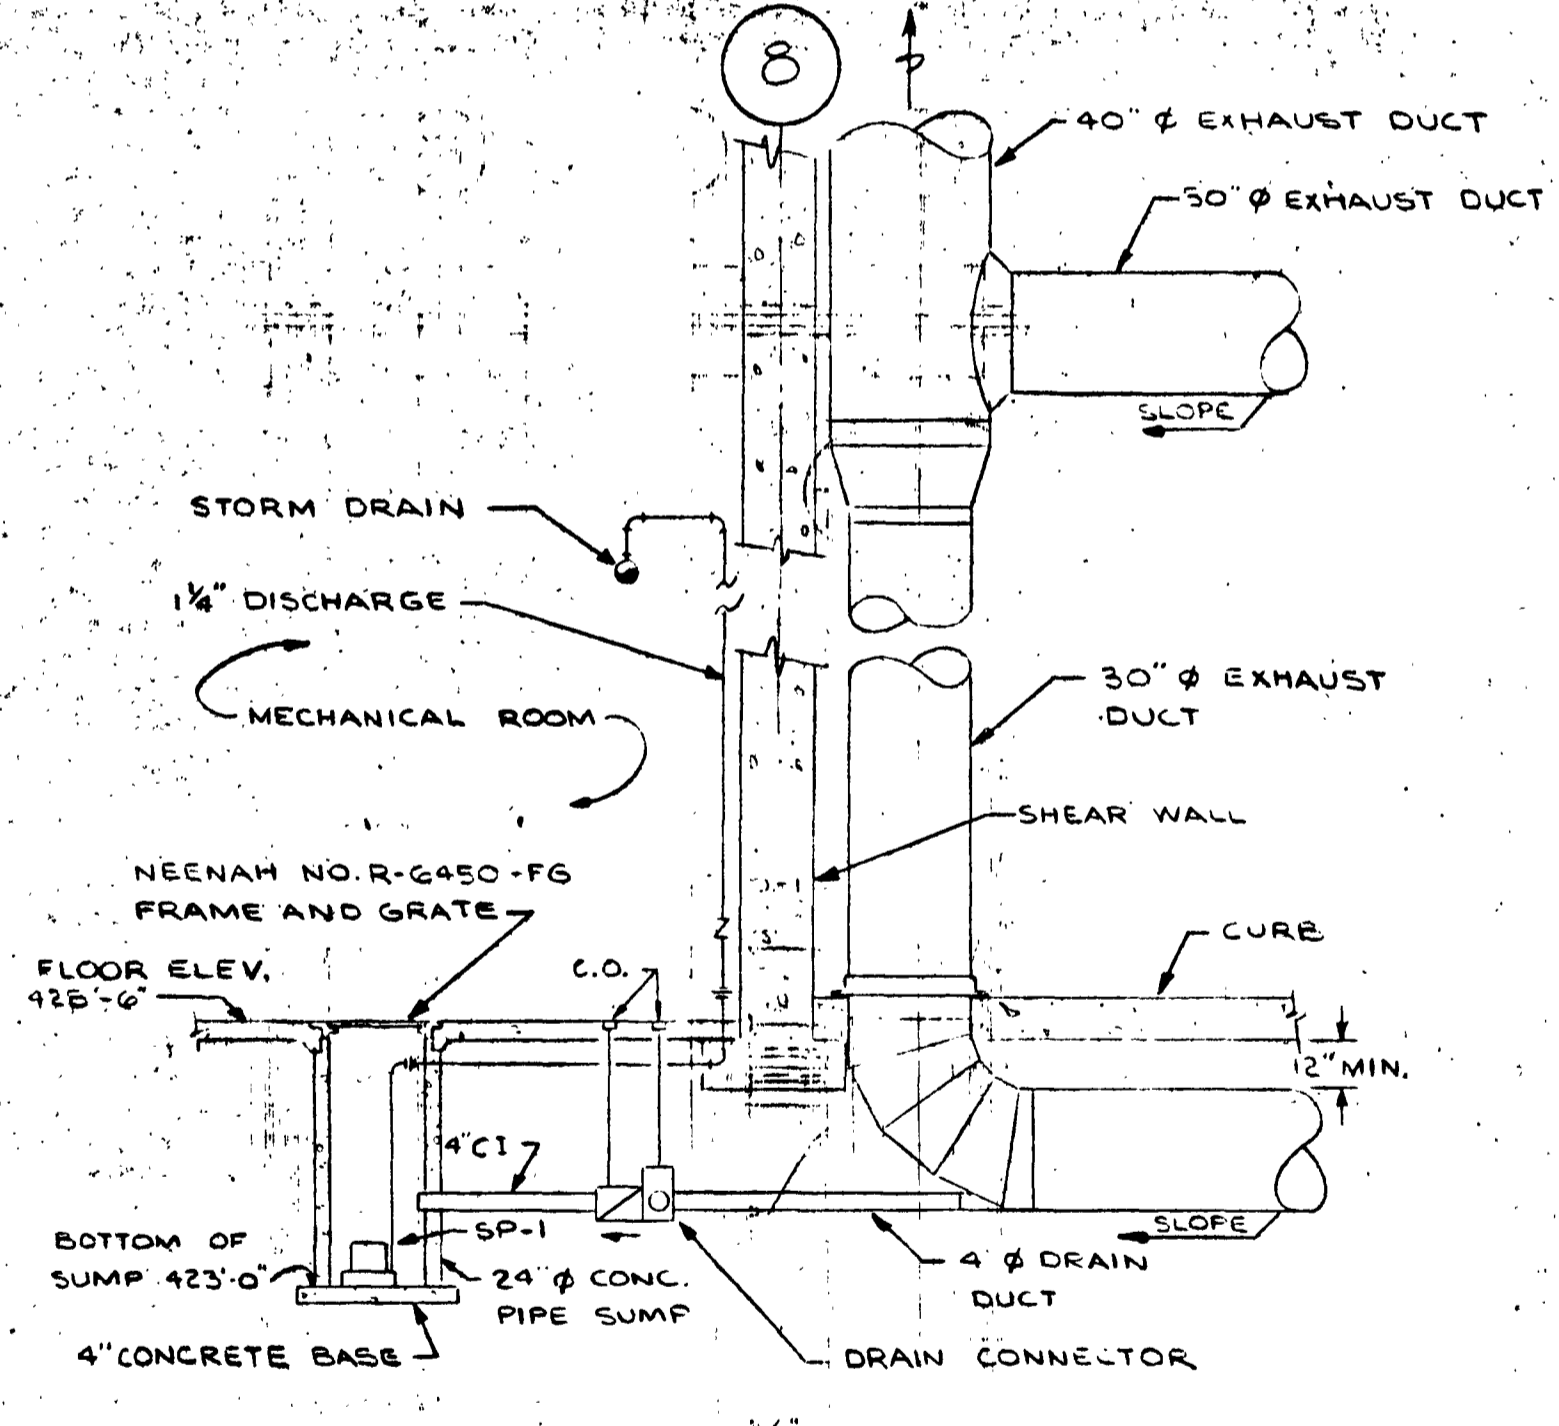


SUMP PUMP DETAIL
SCALE 1/4\"/>

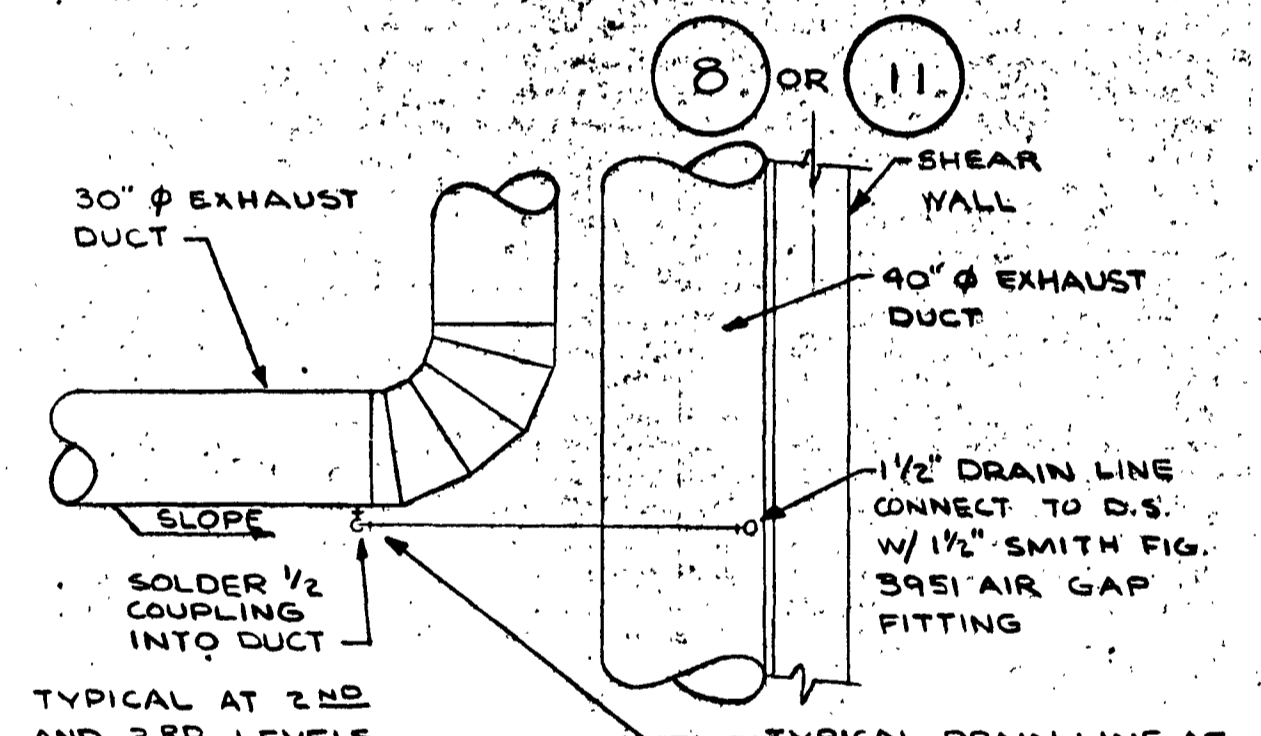


DETAIL 5
NO SCALE

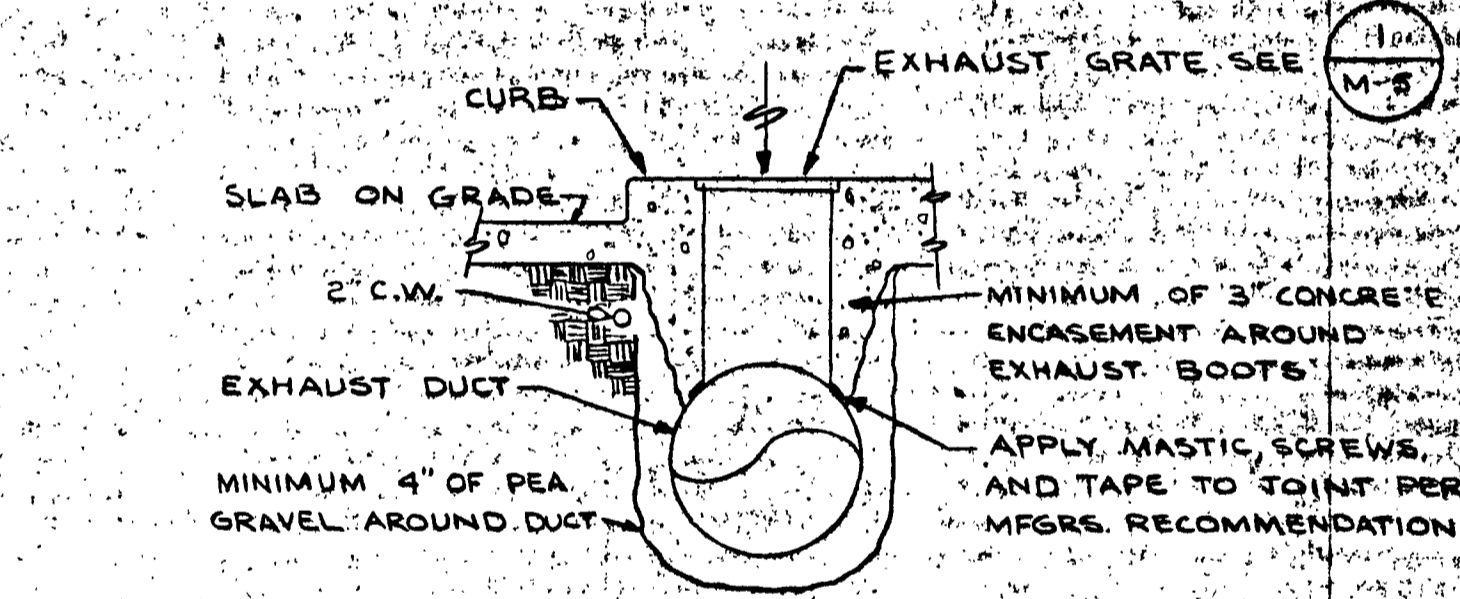

SECTION AT EXHAUST BOOT
SCALE 1/2\"/>

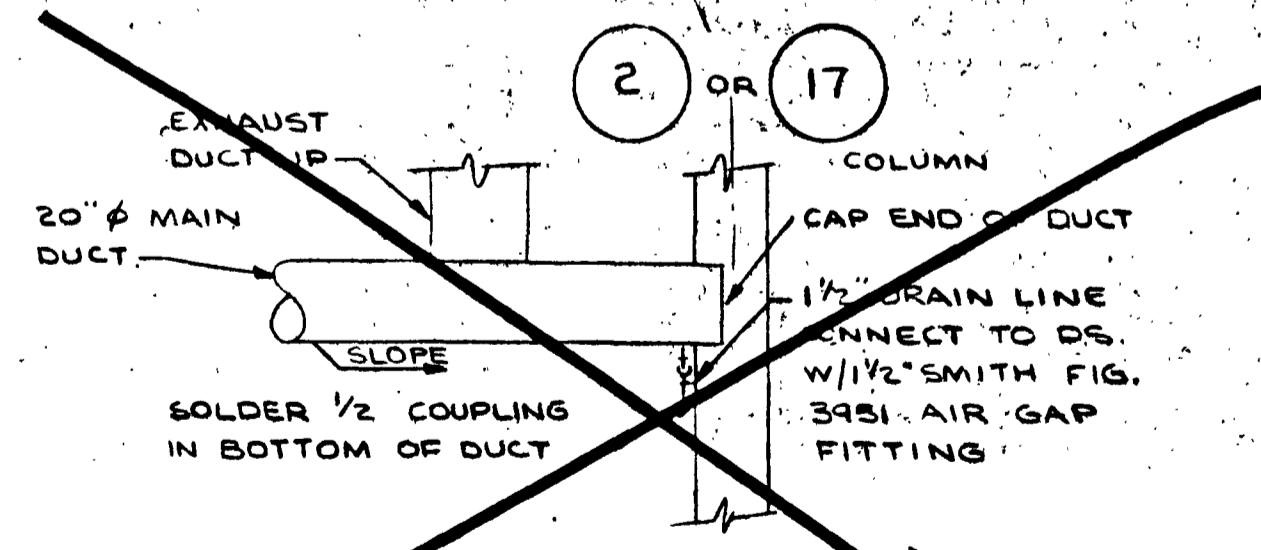

DELETED DETAIL 4
NO SCALE

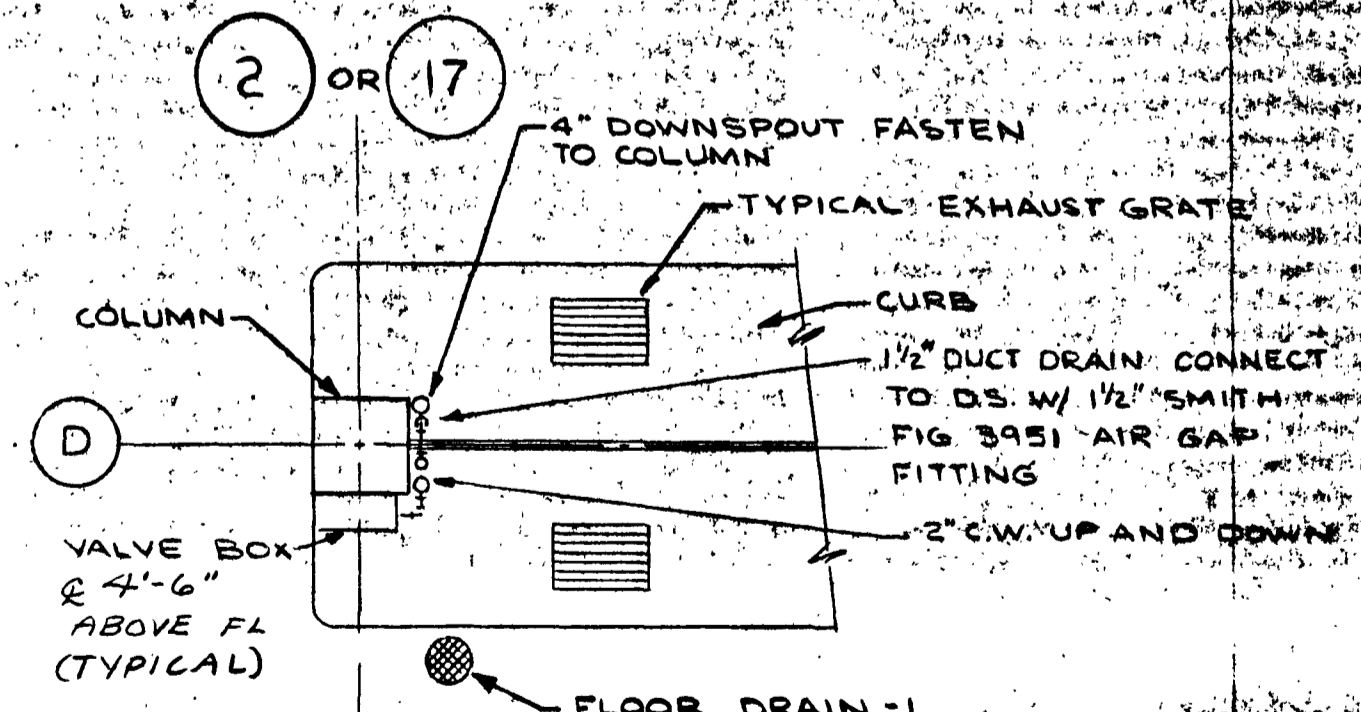

DETAIL 3
SCALE 1/2\"/>

JOB NO.
DATE: 6-07-74

ARCHITECTS - ENGINEERS - SURVEYORS
601 COLLEGE ROAD, FAIRBANKS, ALASKA 99701, PHONE: 452-1241

STATE OF ALASKA
DEPT. OF PUBLIC WORKS
DIVISION OF BUILDINGS
JUNEAU ALASKA



FAIRBANKS PARKING STRUCTURE
DBA - 2 - 0130
FAIRBANKS, AK.

PETER MEWIT SONS' CO.
FAIRBANKS, ALASKA
CONTRACTOR
DATE



M-2
AS-BLT SHEET 37 OF 49

GRAY ROGERS MYERS & ORGAN


A DIVISION OF ELLERBE

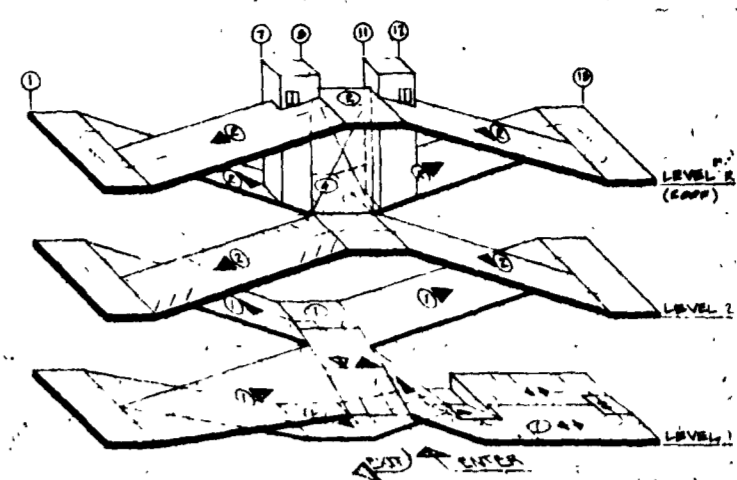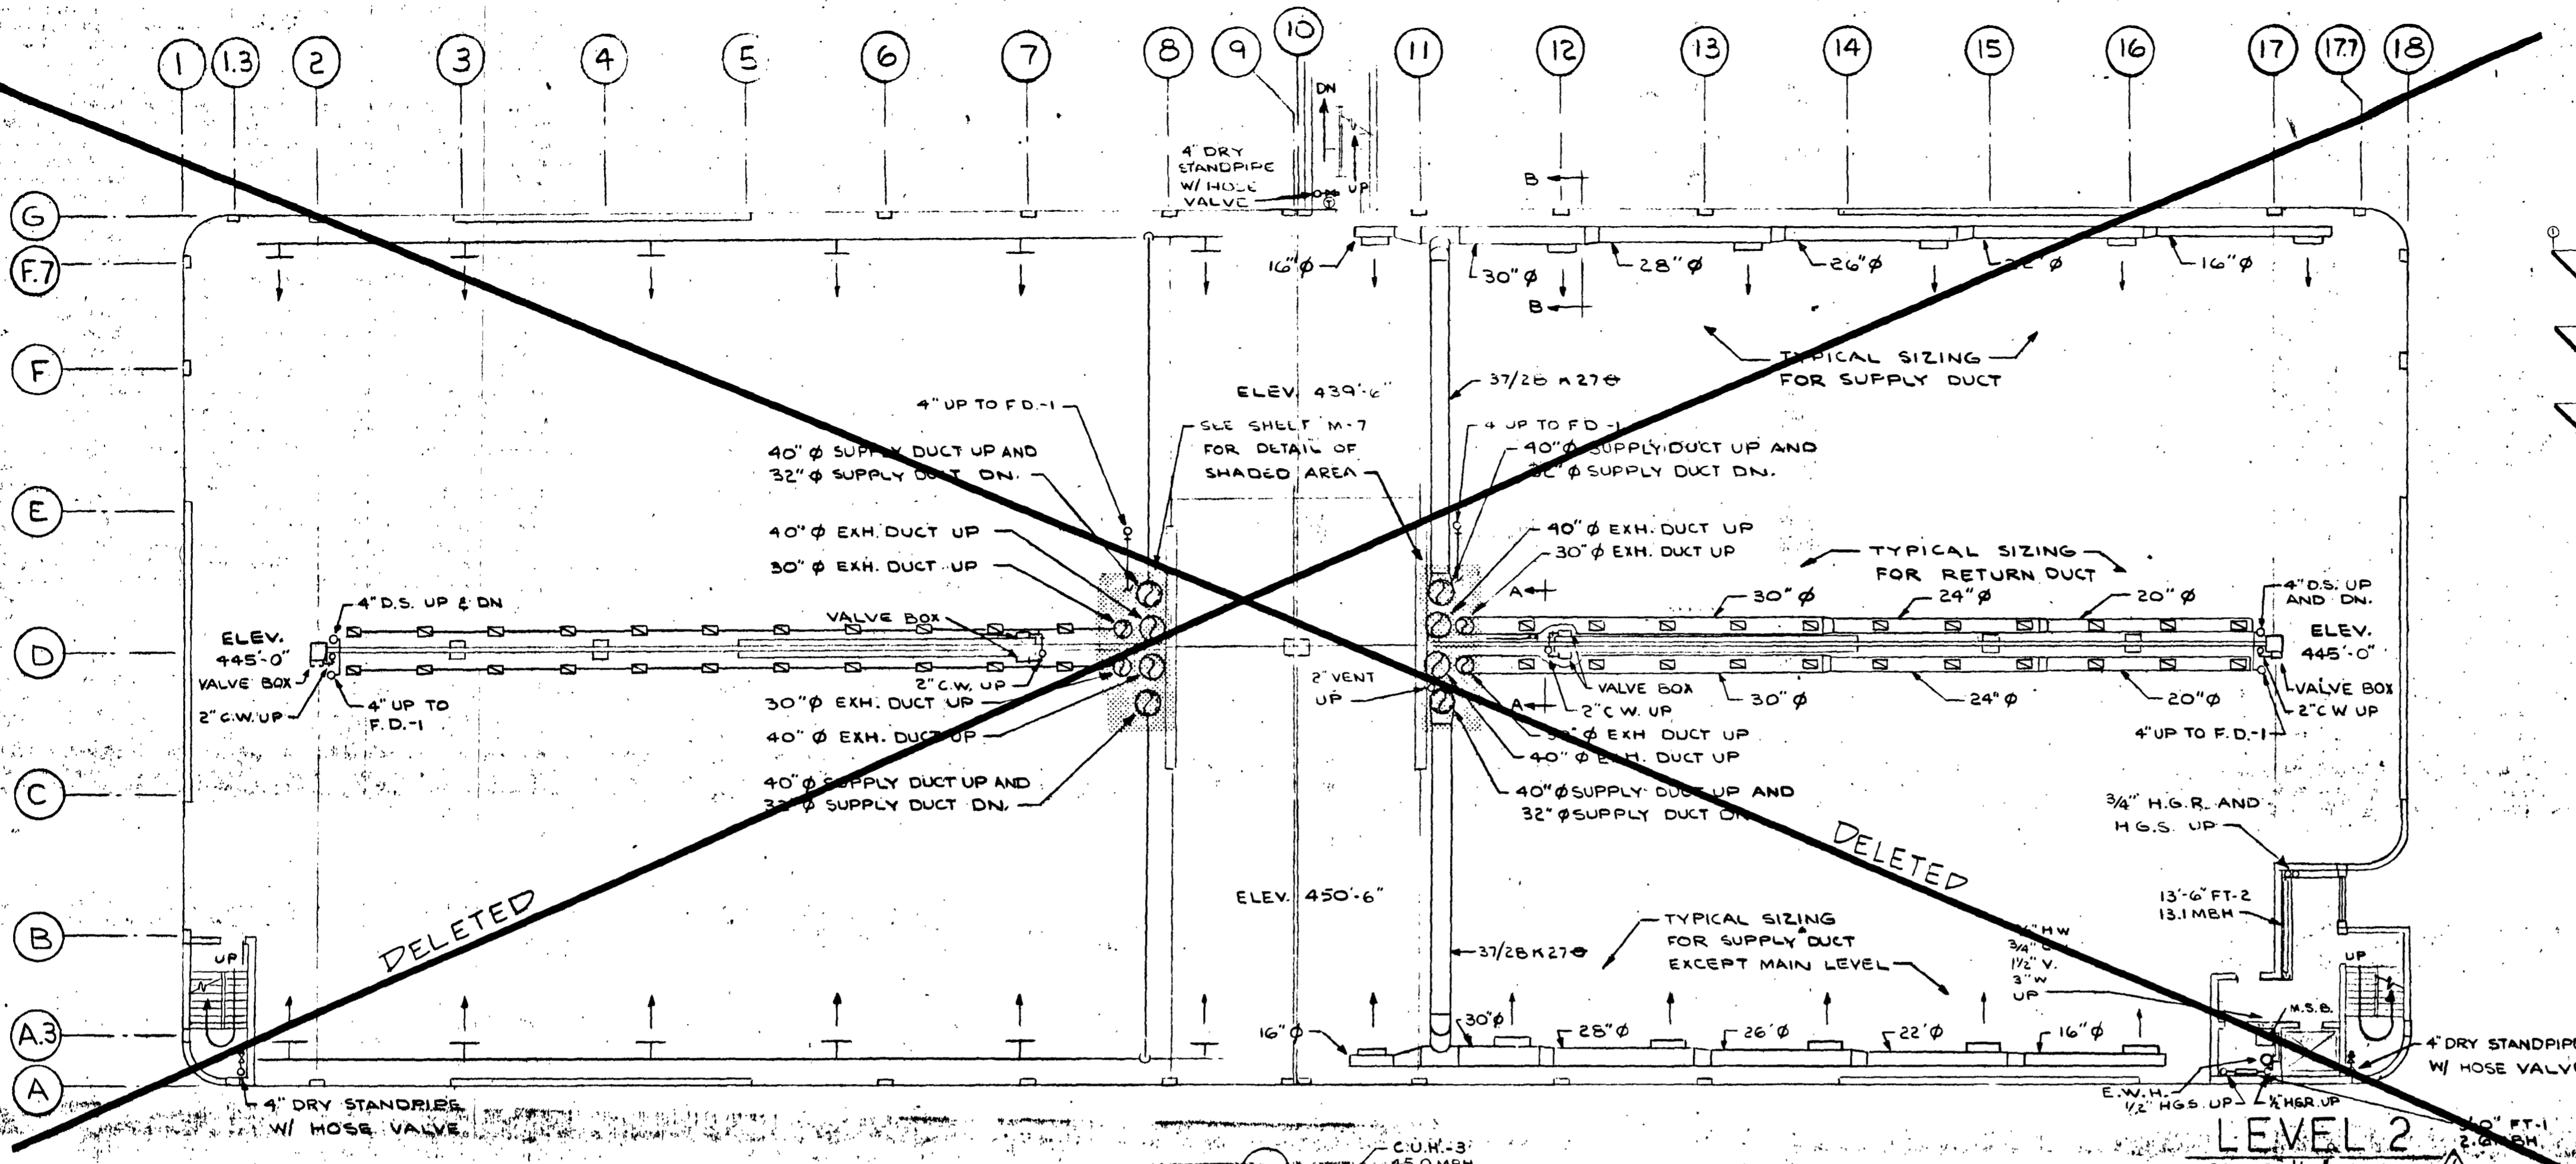

KEY PLAN
NO SCALE

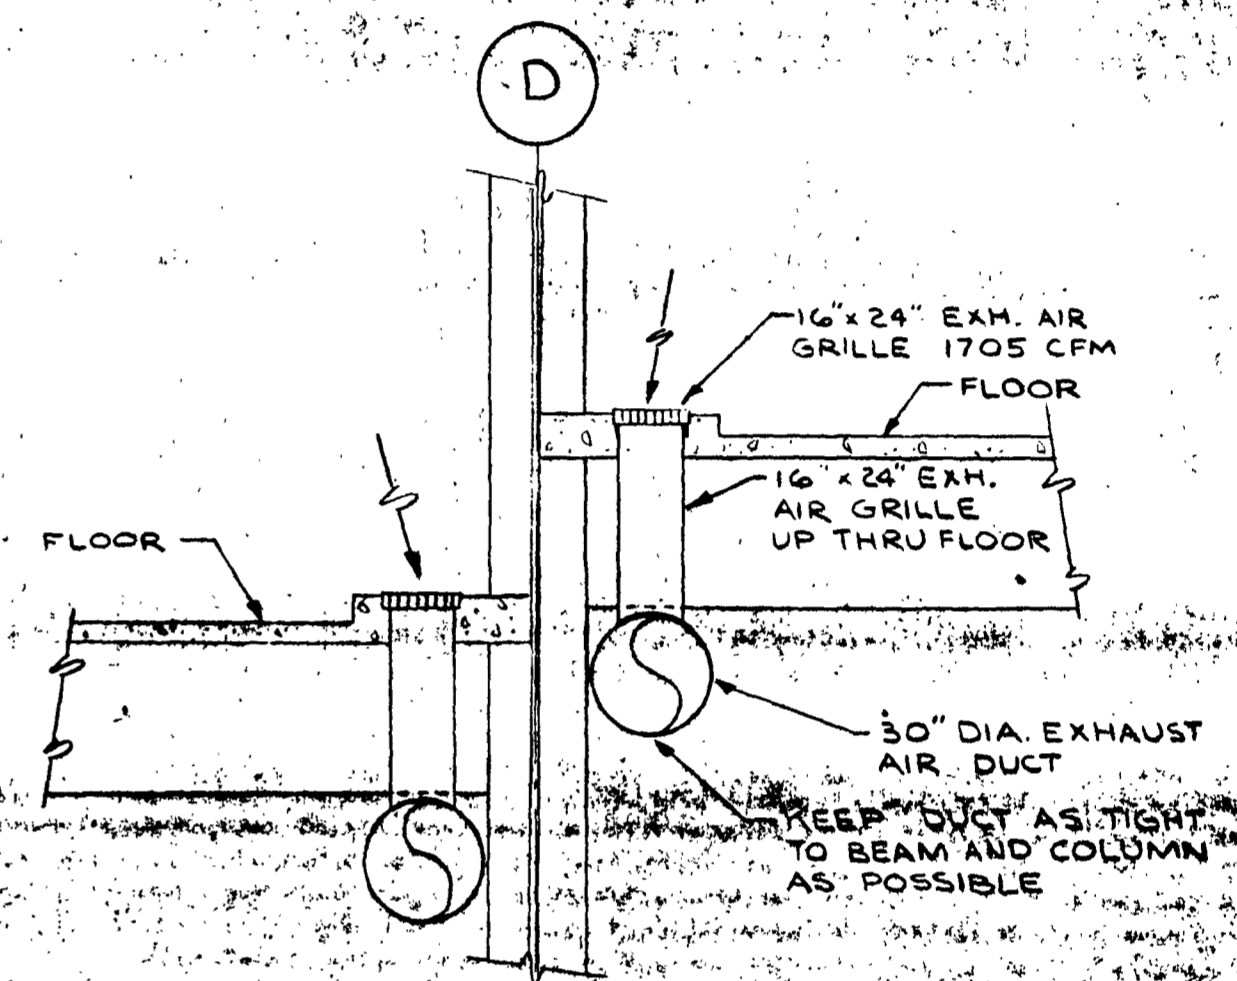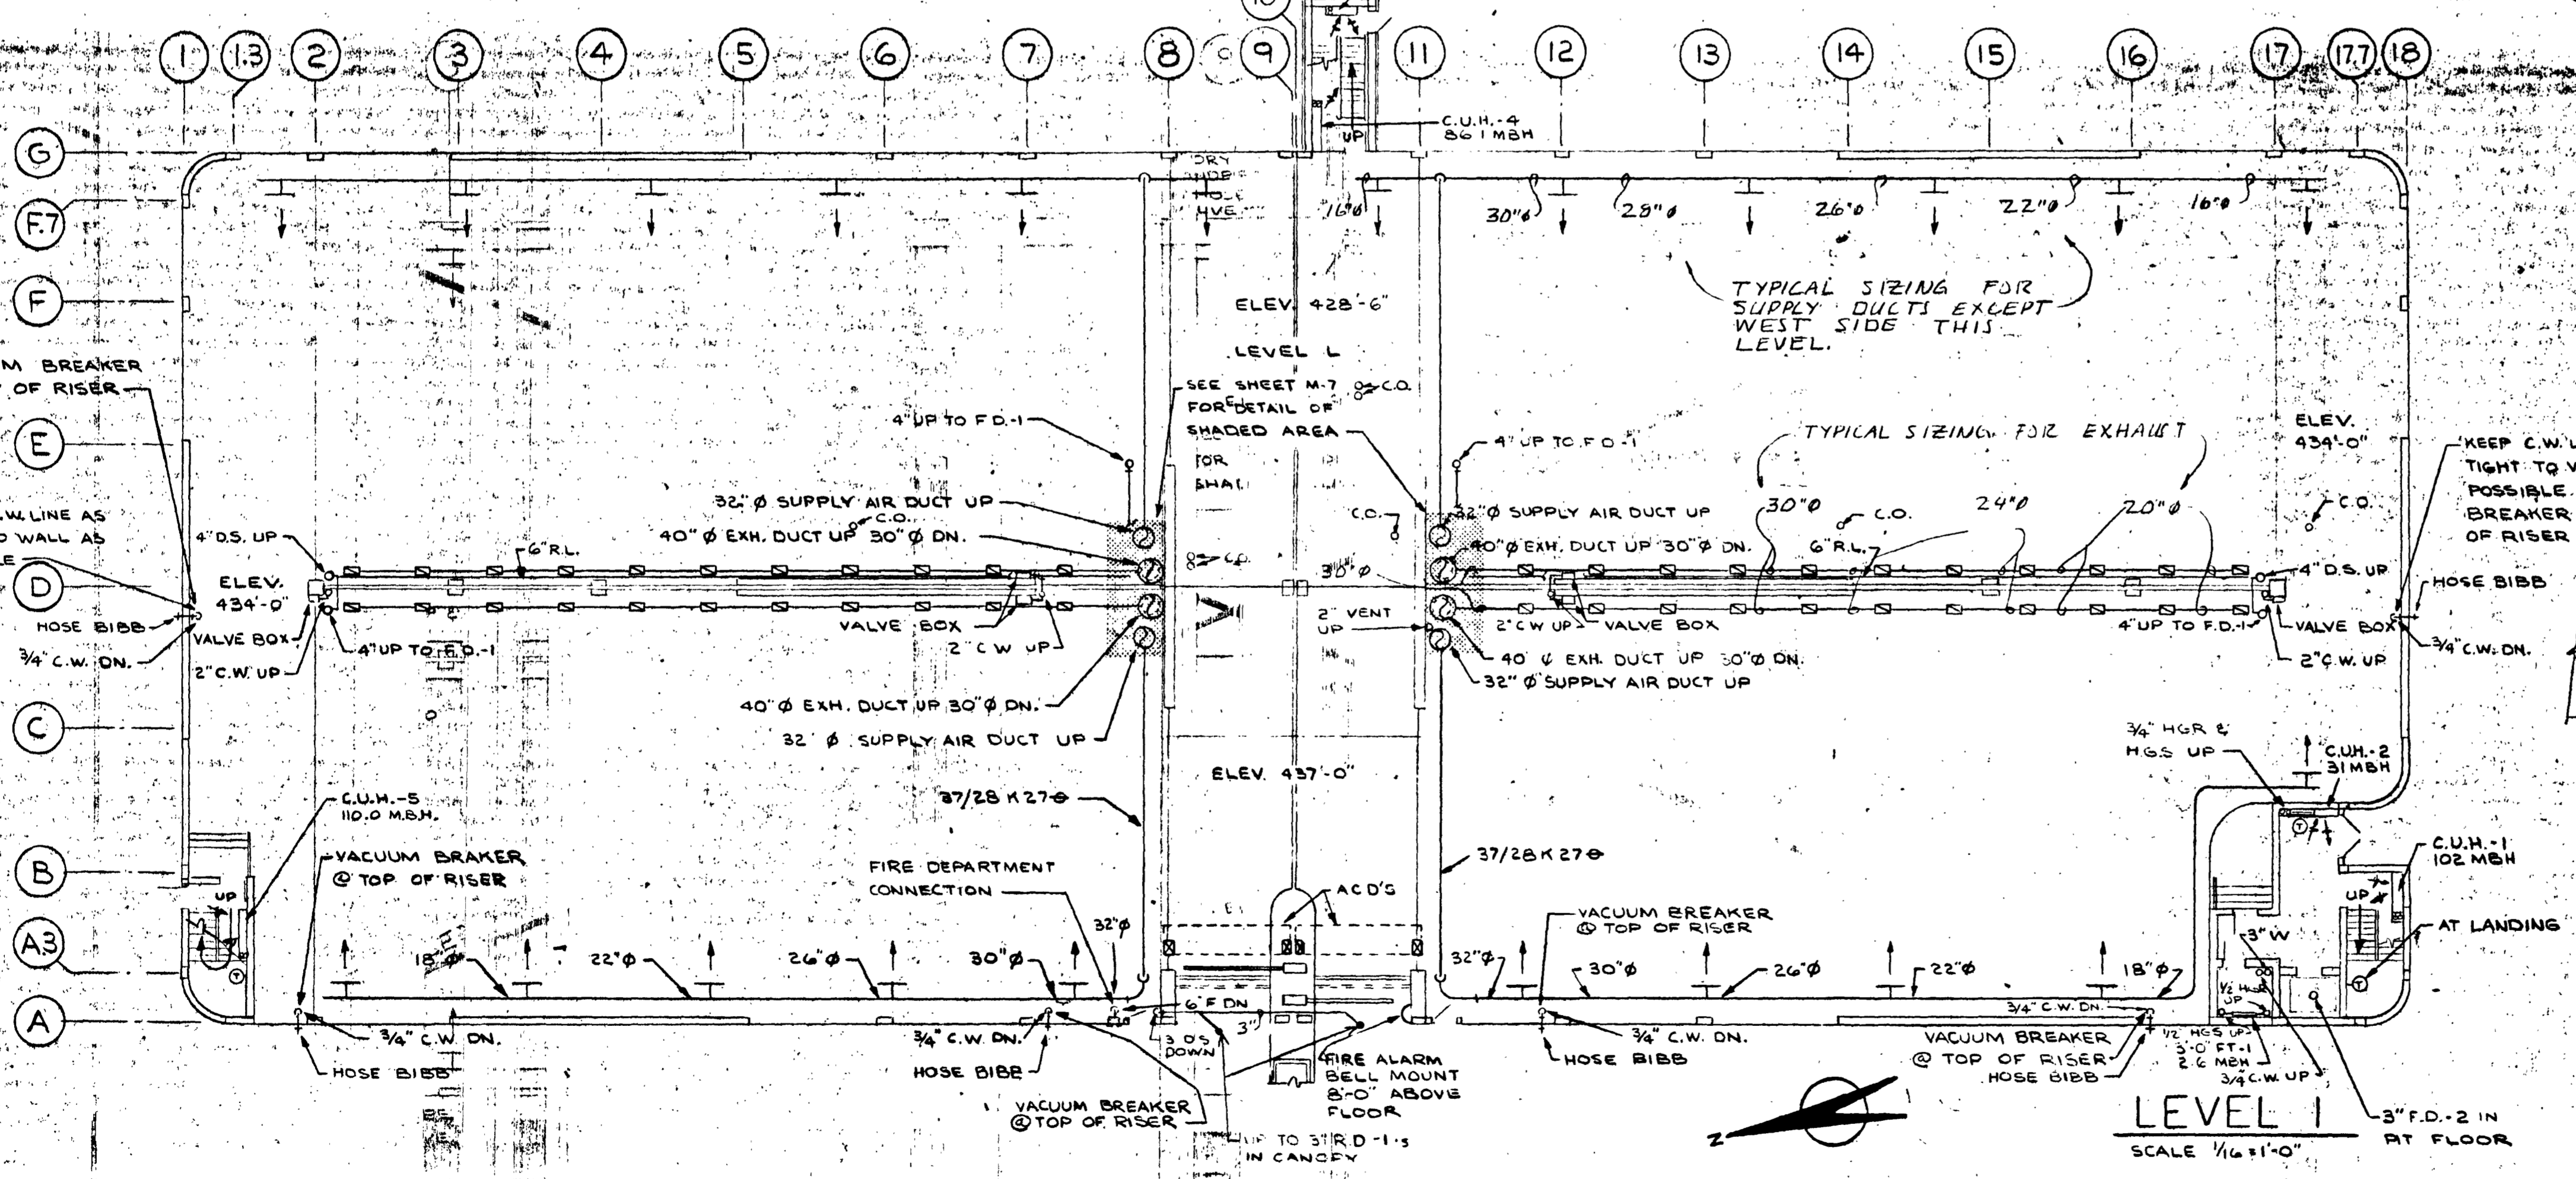

SECTION A-A
NO SCALE

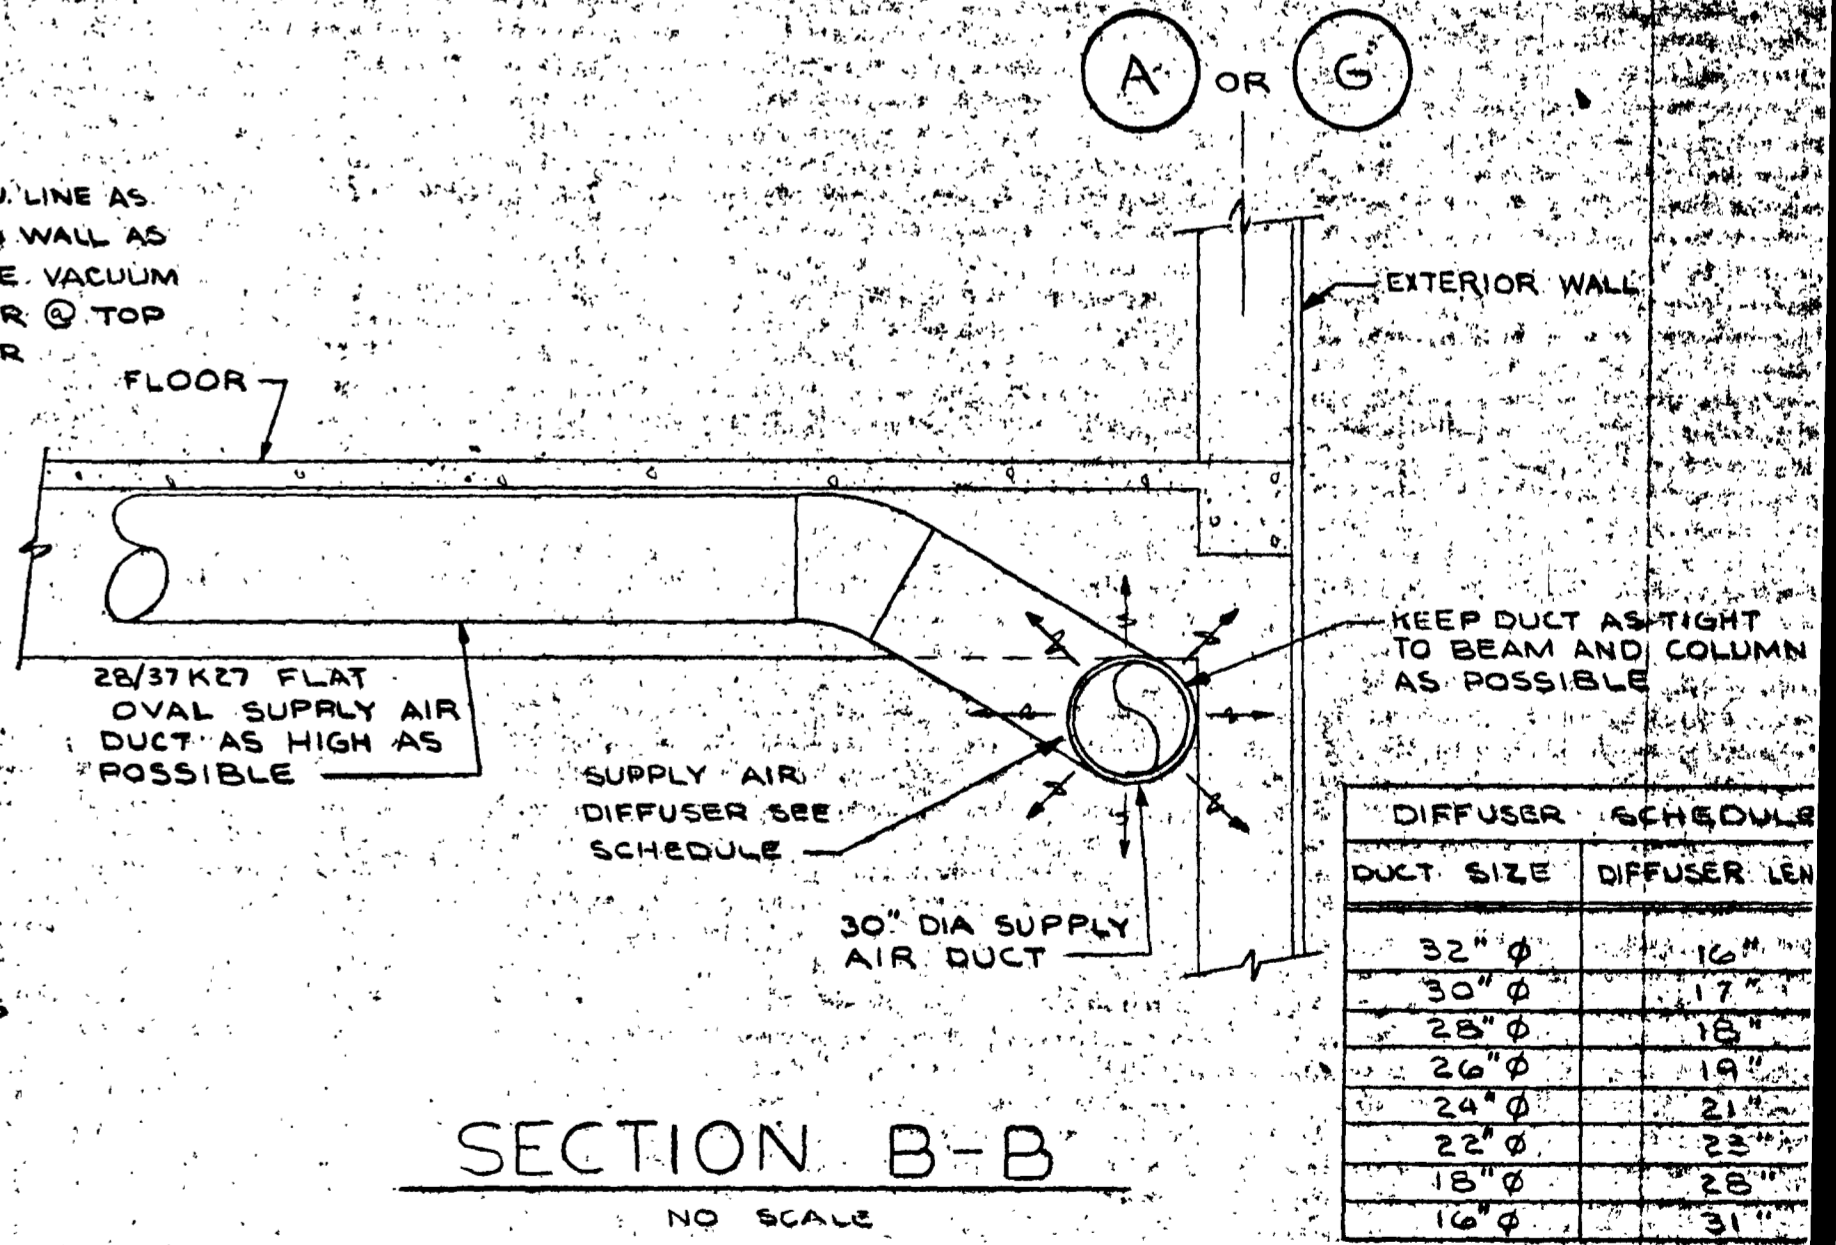

SECTION B-B
NO SCALE

DUCT SIZE	DIFFUSER LEN
32" Ø	16"
30" Ø	17"
28" Ø	18"
26" Ø	19"
24" Ø	21"
22" Ø	23"
18" Ø	25"
16" Ø	31"

LEVEL 1 PLAN AND DETAILS


ARCHITECTS • ENGINEERS • SURVEYORS
601 COLLEGE ROAD, FAIRBANKS, ALASKA 99701, PHONE: 452-1241

STATE OF ALASKA
DEPT. OF PUBLIC WORKS
DIVISION OF BUILDINGS
JUNEAU ALASKA

FAIRBANKS PARKING STRUCTURE
FAIRBANKS, AK.
DBA - 2 - 0130






PETER WIEWITSON'S CO.
DATE: _____

M-3
SHEET 38 OF 40

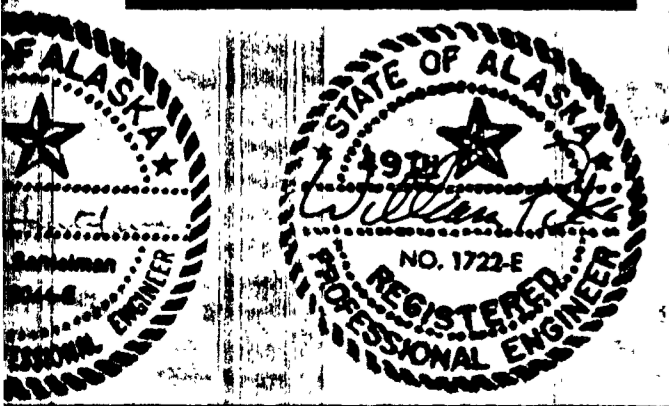

GRAY ROGERS MYERS & TORGAN

A DIVISION OF ELLERBE

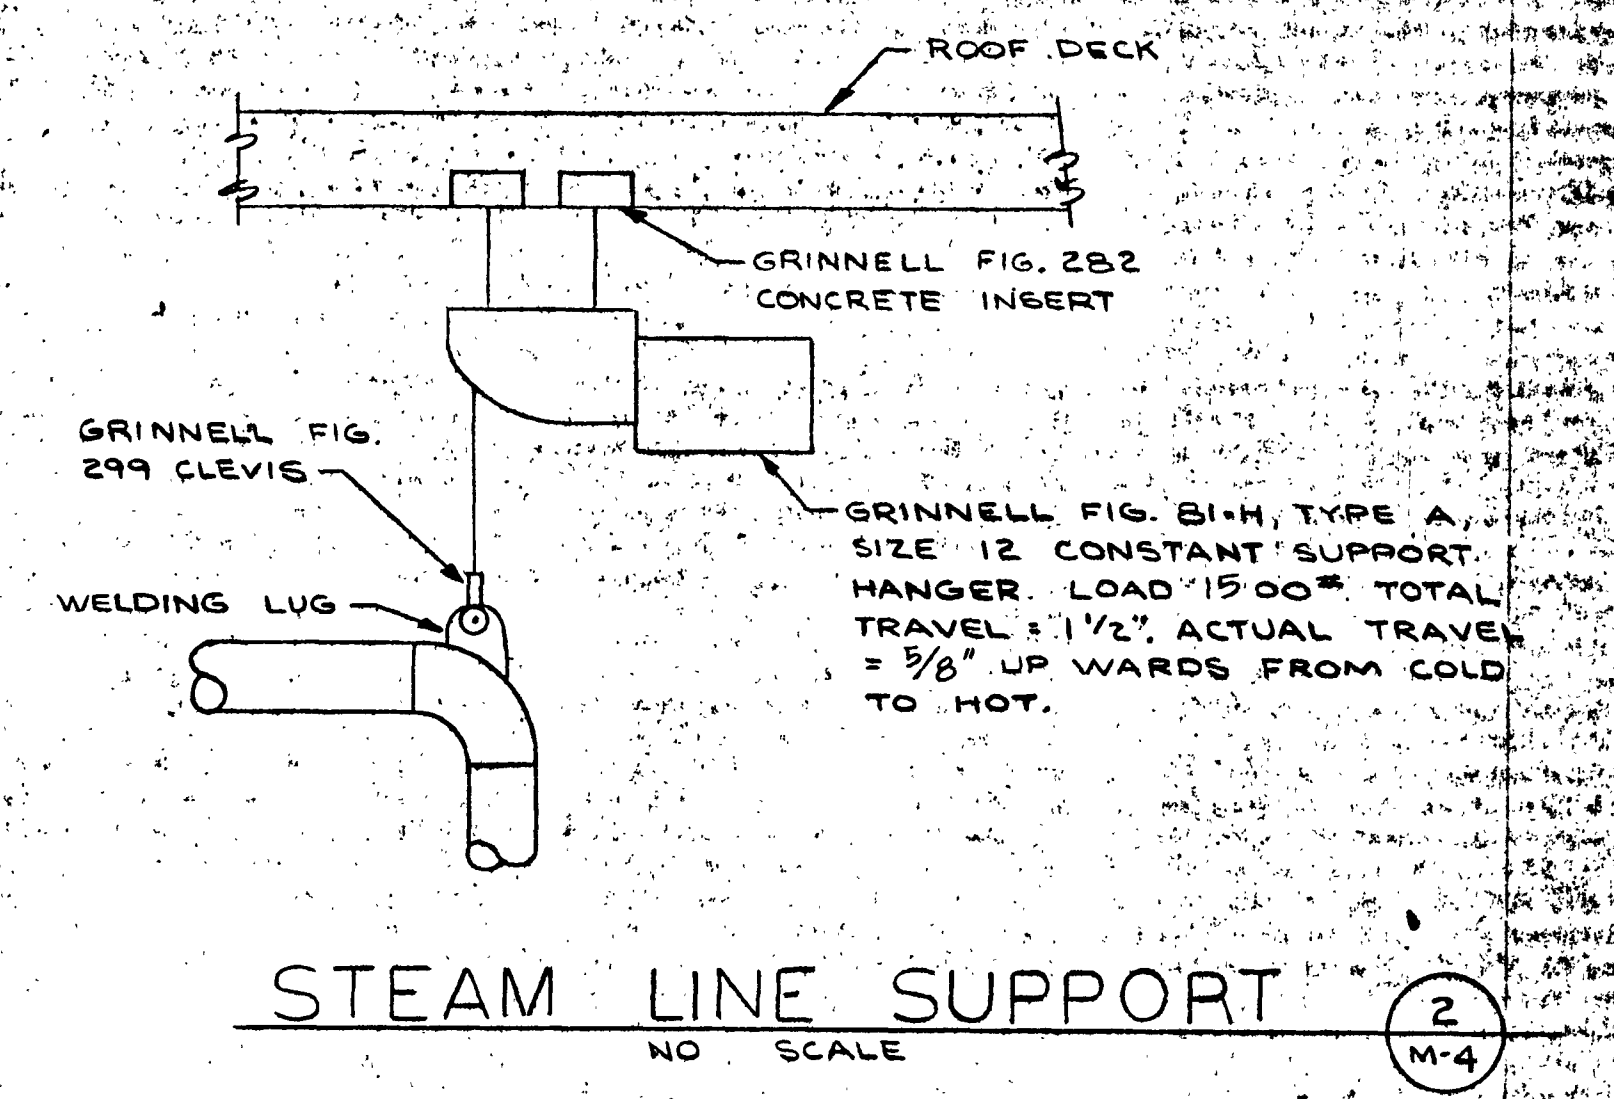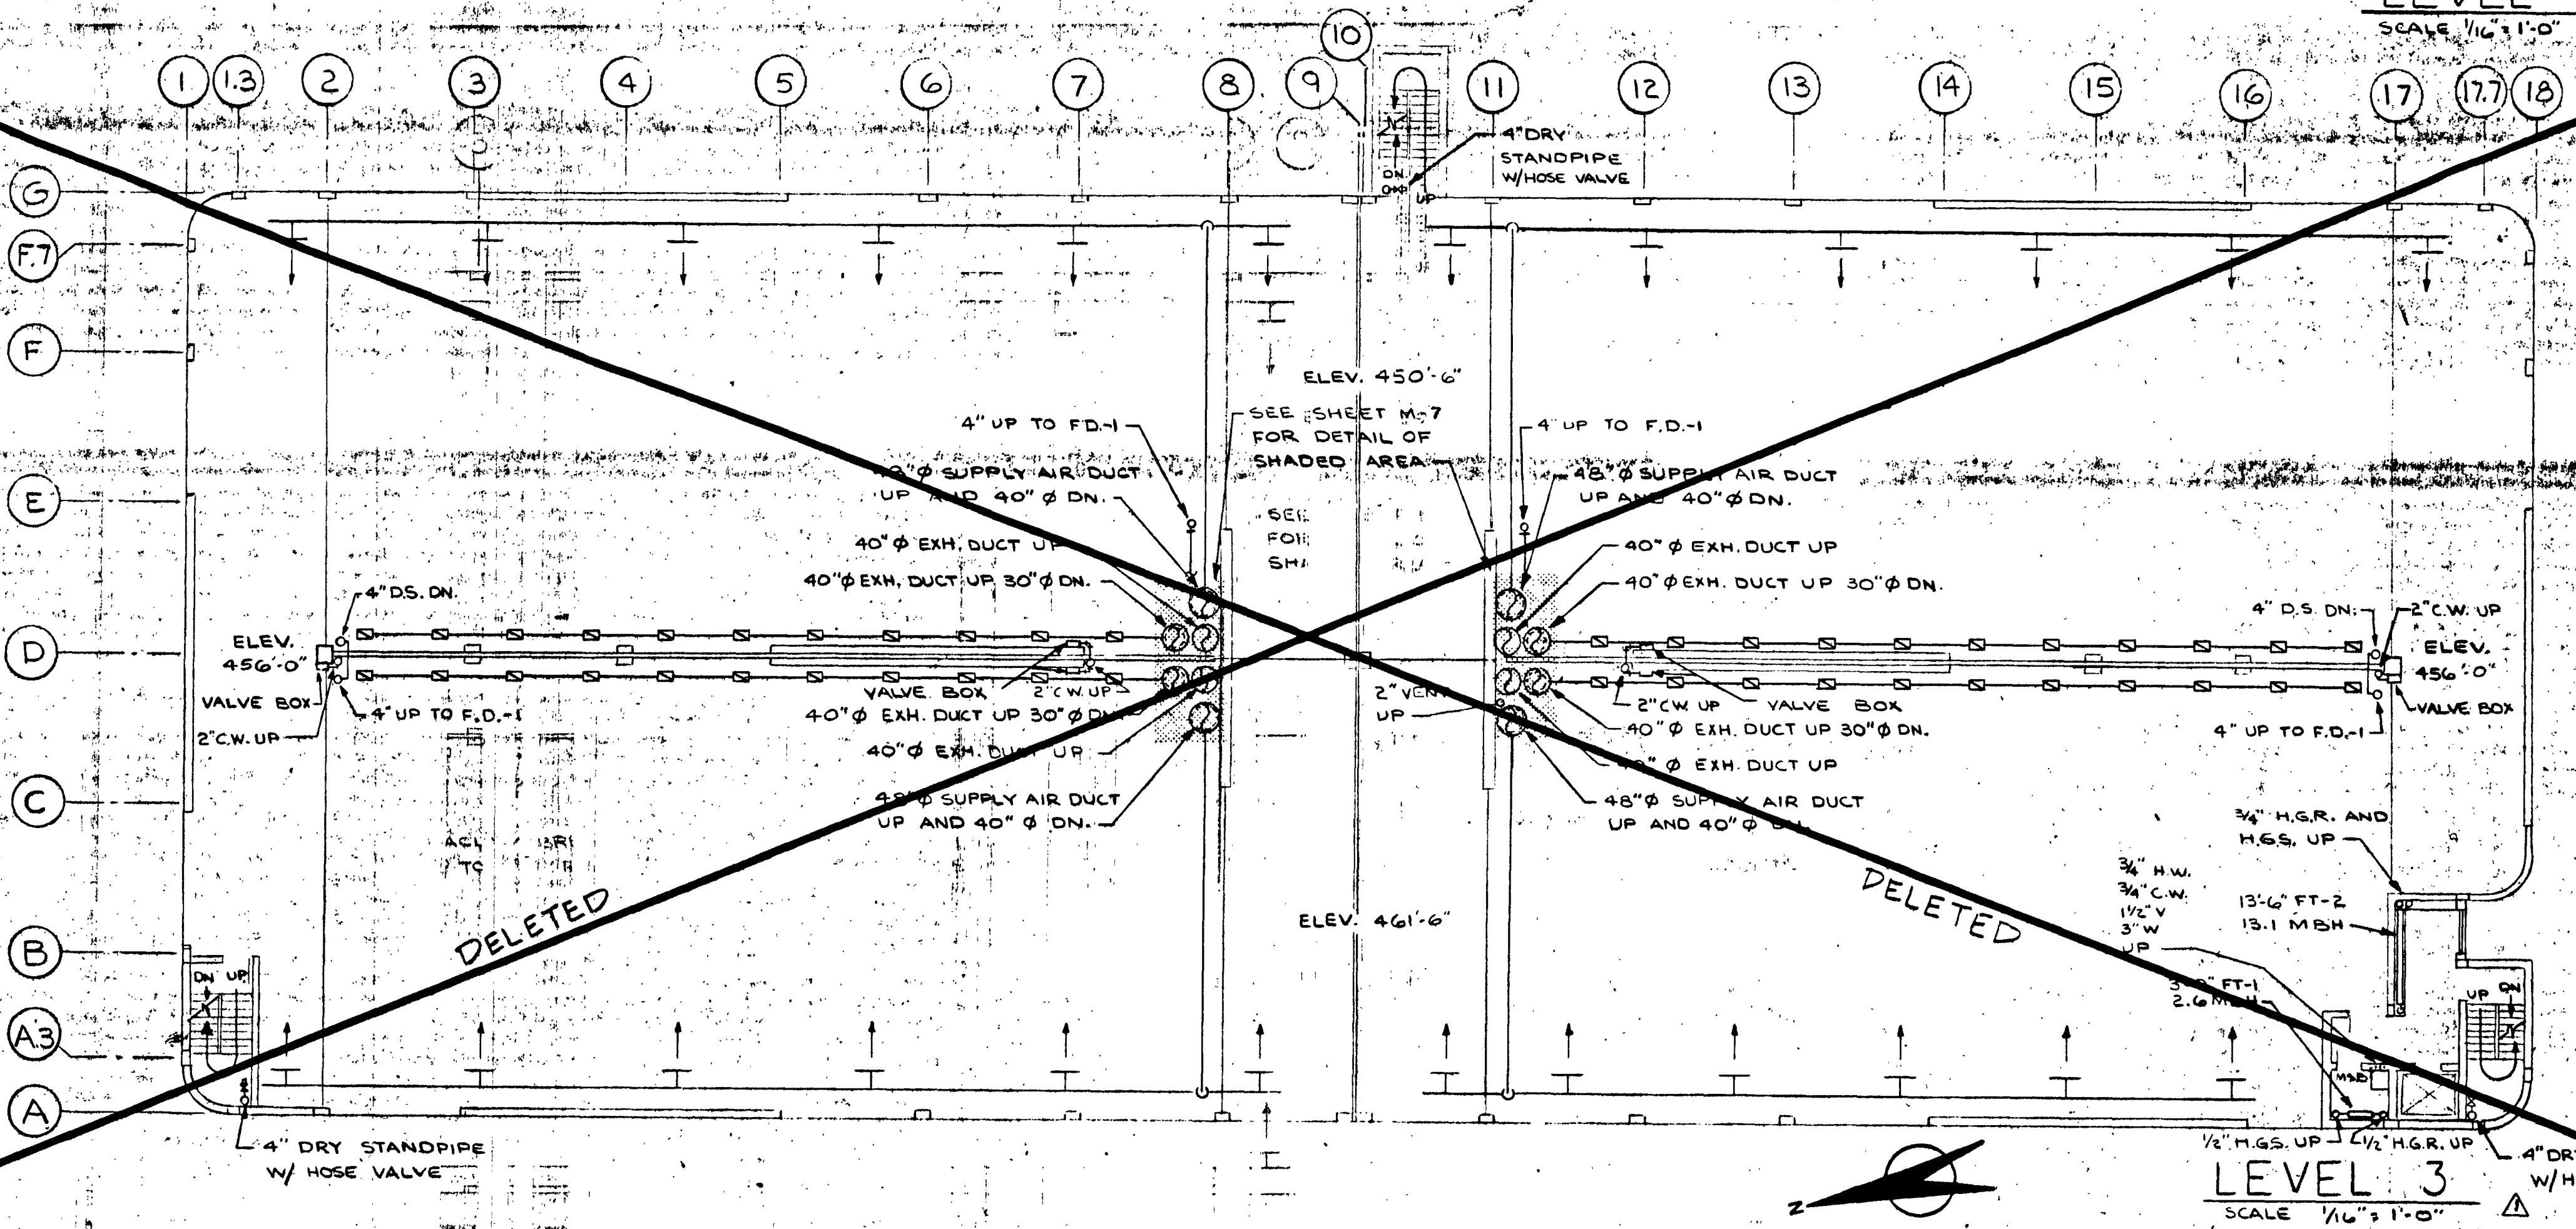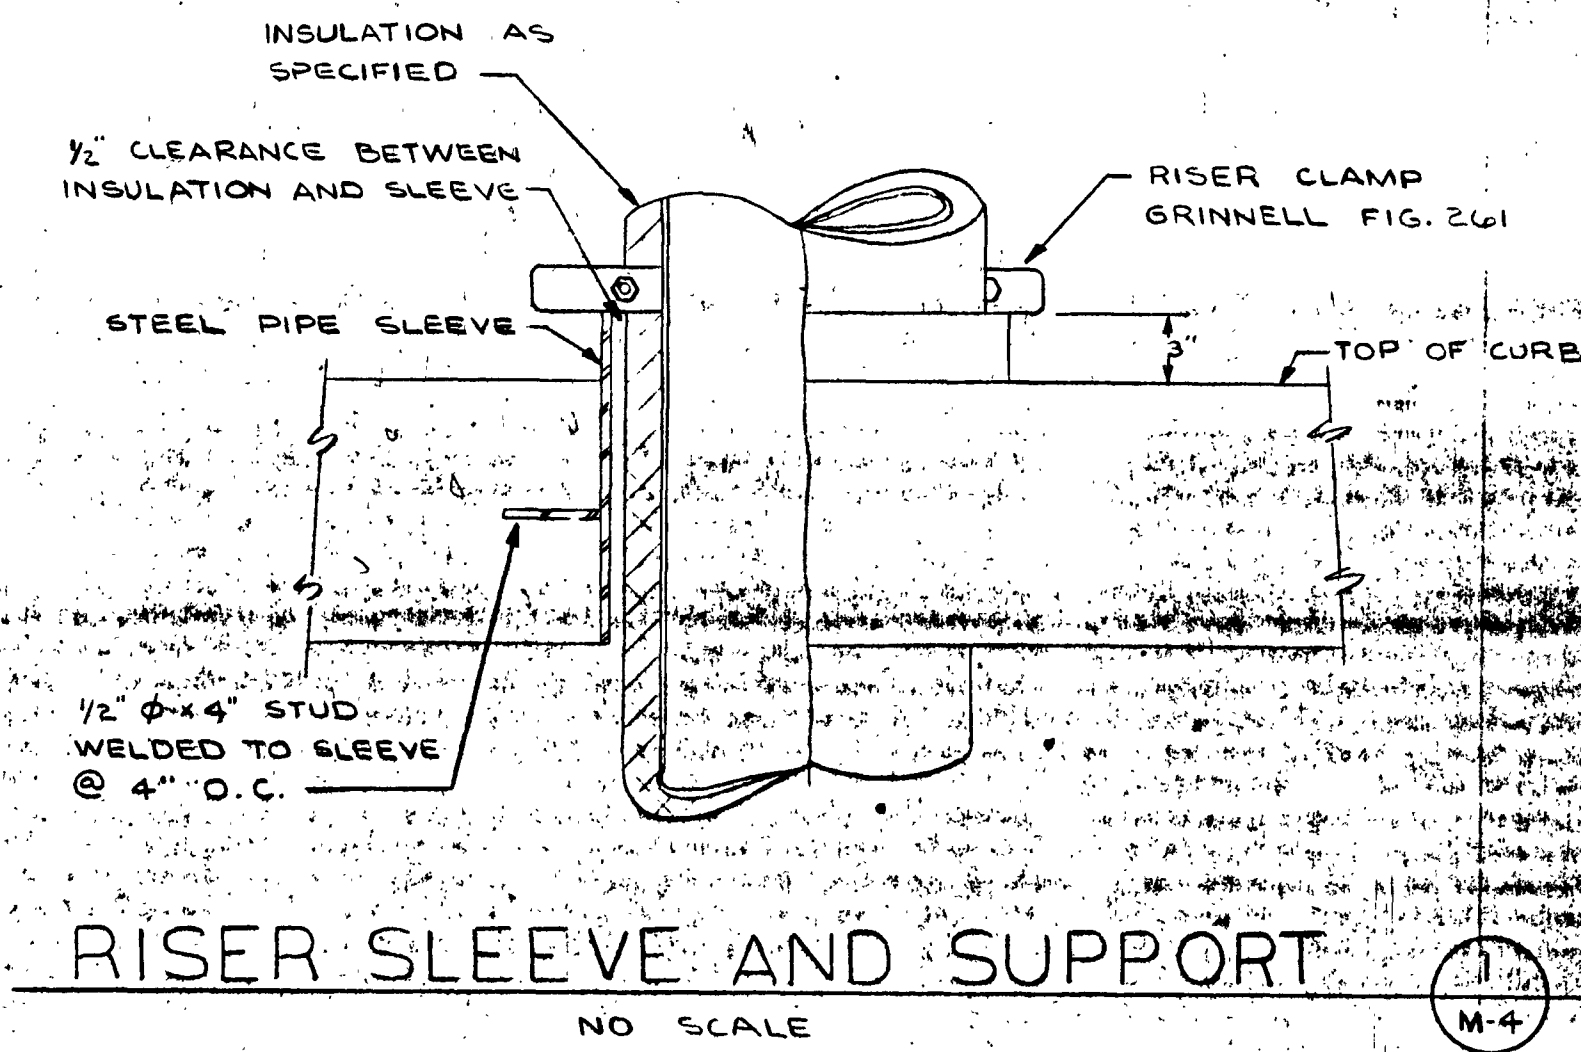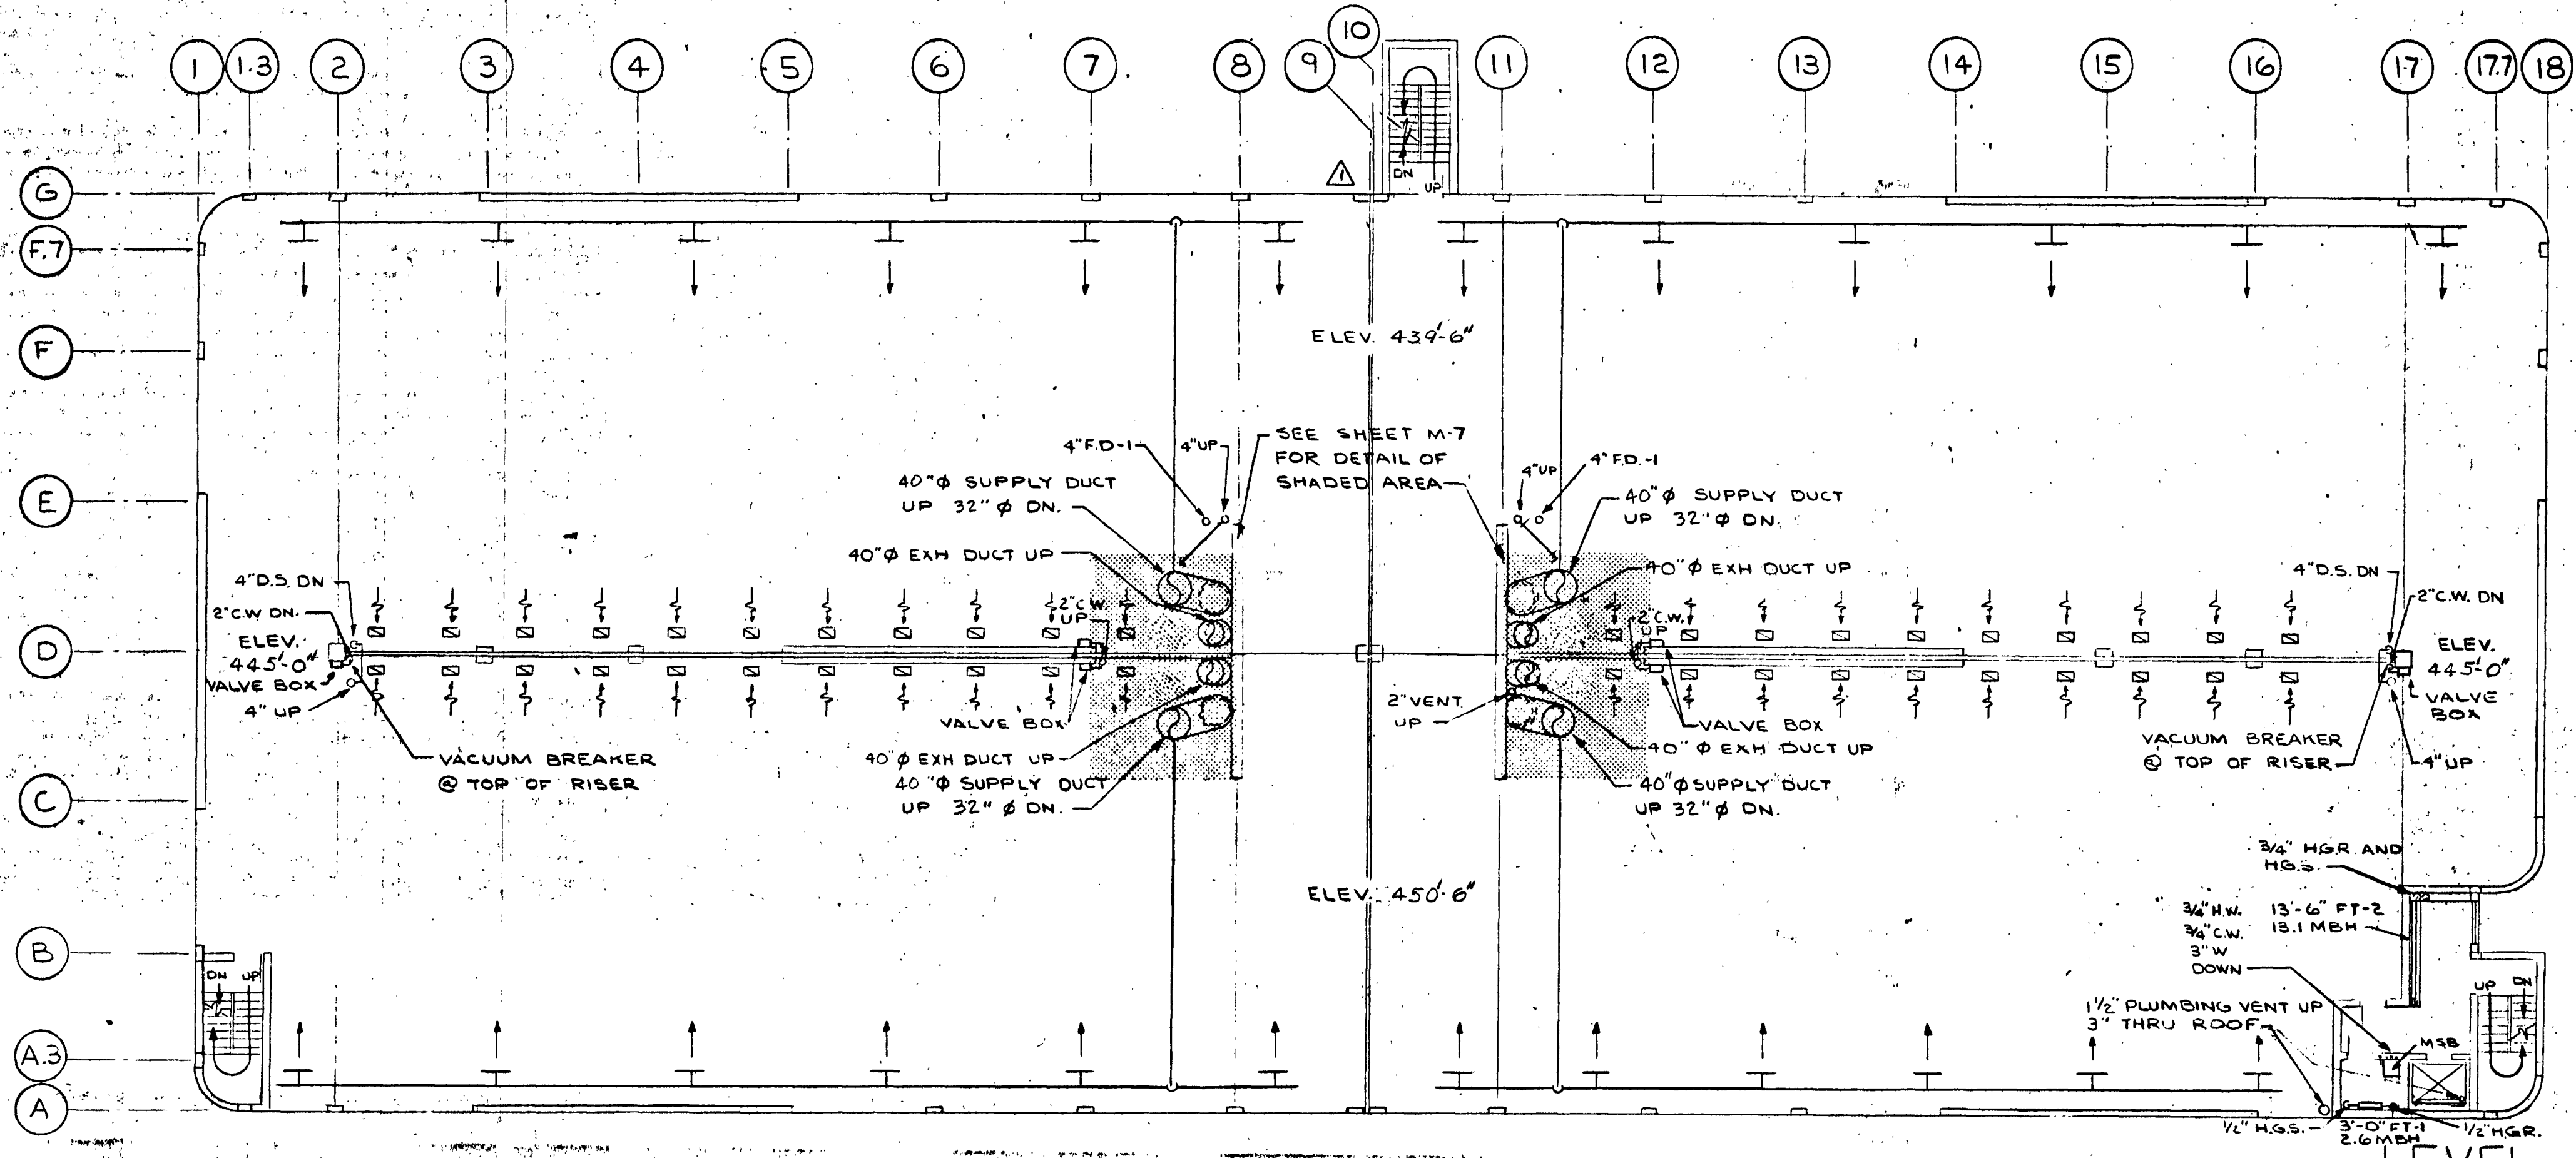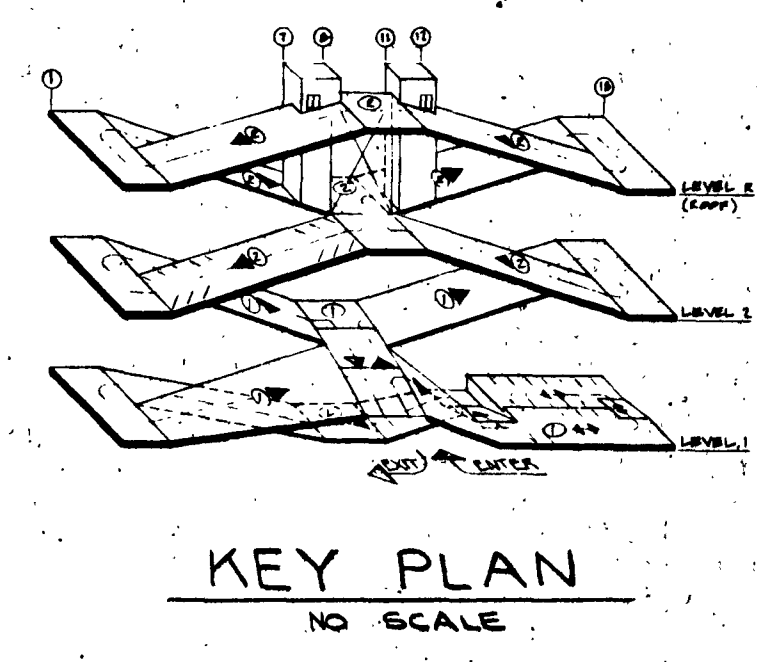

ARCHITECTS • ENGINEERS • SURVEYORS
601 COLLEGE ROAD, FAIRBANKS, ALASKA 99701, PHONE: 452-1241


STATE OF ALASKA
DEPT. OF PUBLIC WORKS
DIVISION OF BUILDINGS
JUNEAU ALASKA

FAIRBANKS PARKING STRUCTURE
FAIRBANKS, AK.
DBA - 2 - 0130

LEVEL 2 PLAN, AND DETAILS



PETER MEWIT SONS' CO.
FAIRBANKS, ALASKA
DATE: _____

M-4
SHEET 39 OF 4

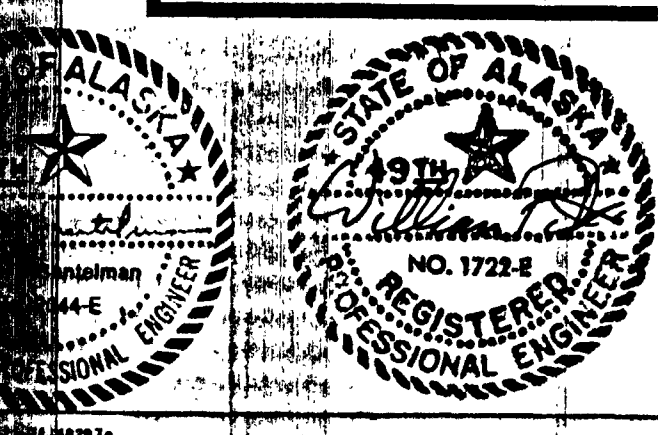


GRAY ROGERS MYERS & PRGAN


A DIVISION OF ELLERBE

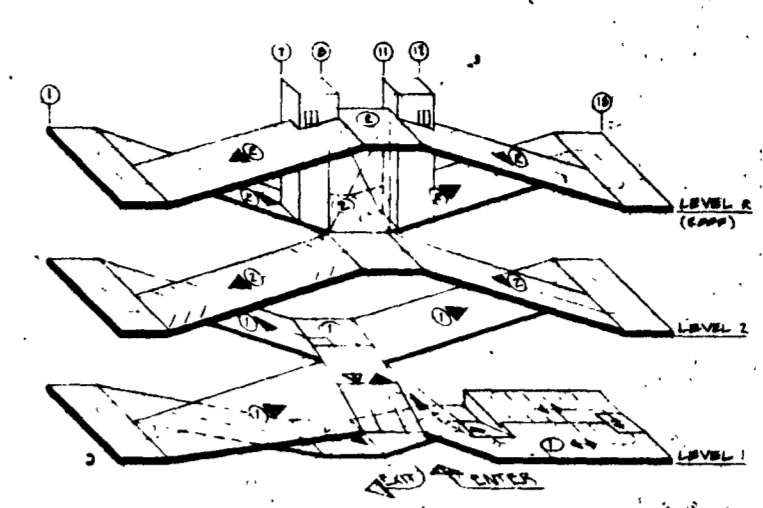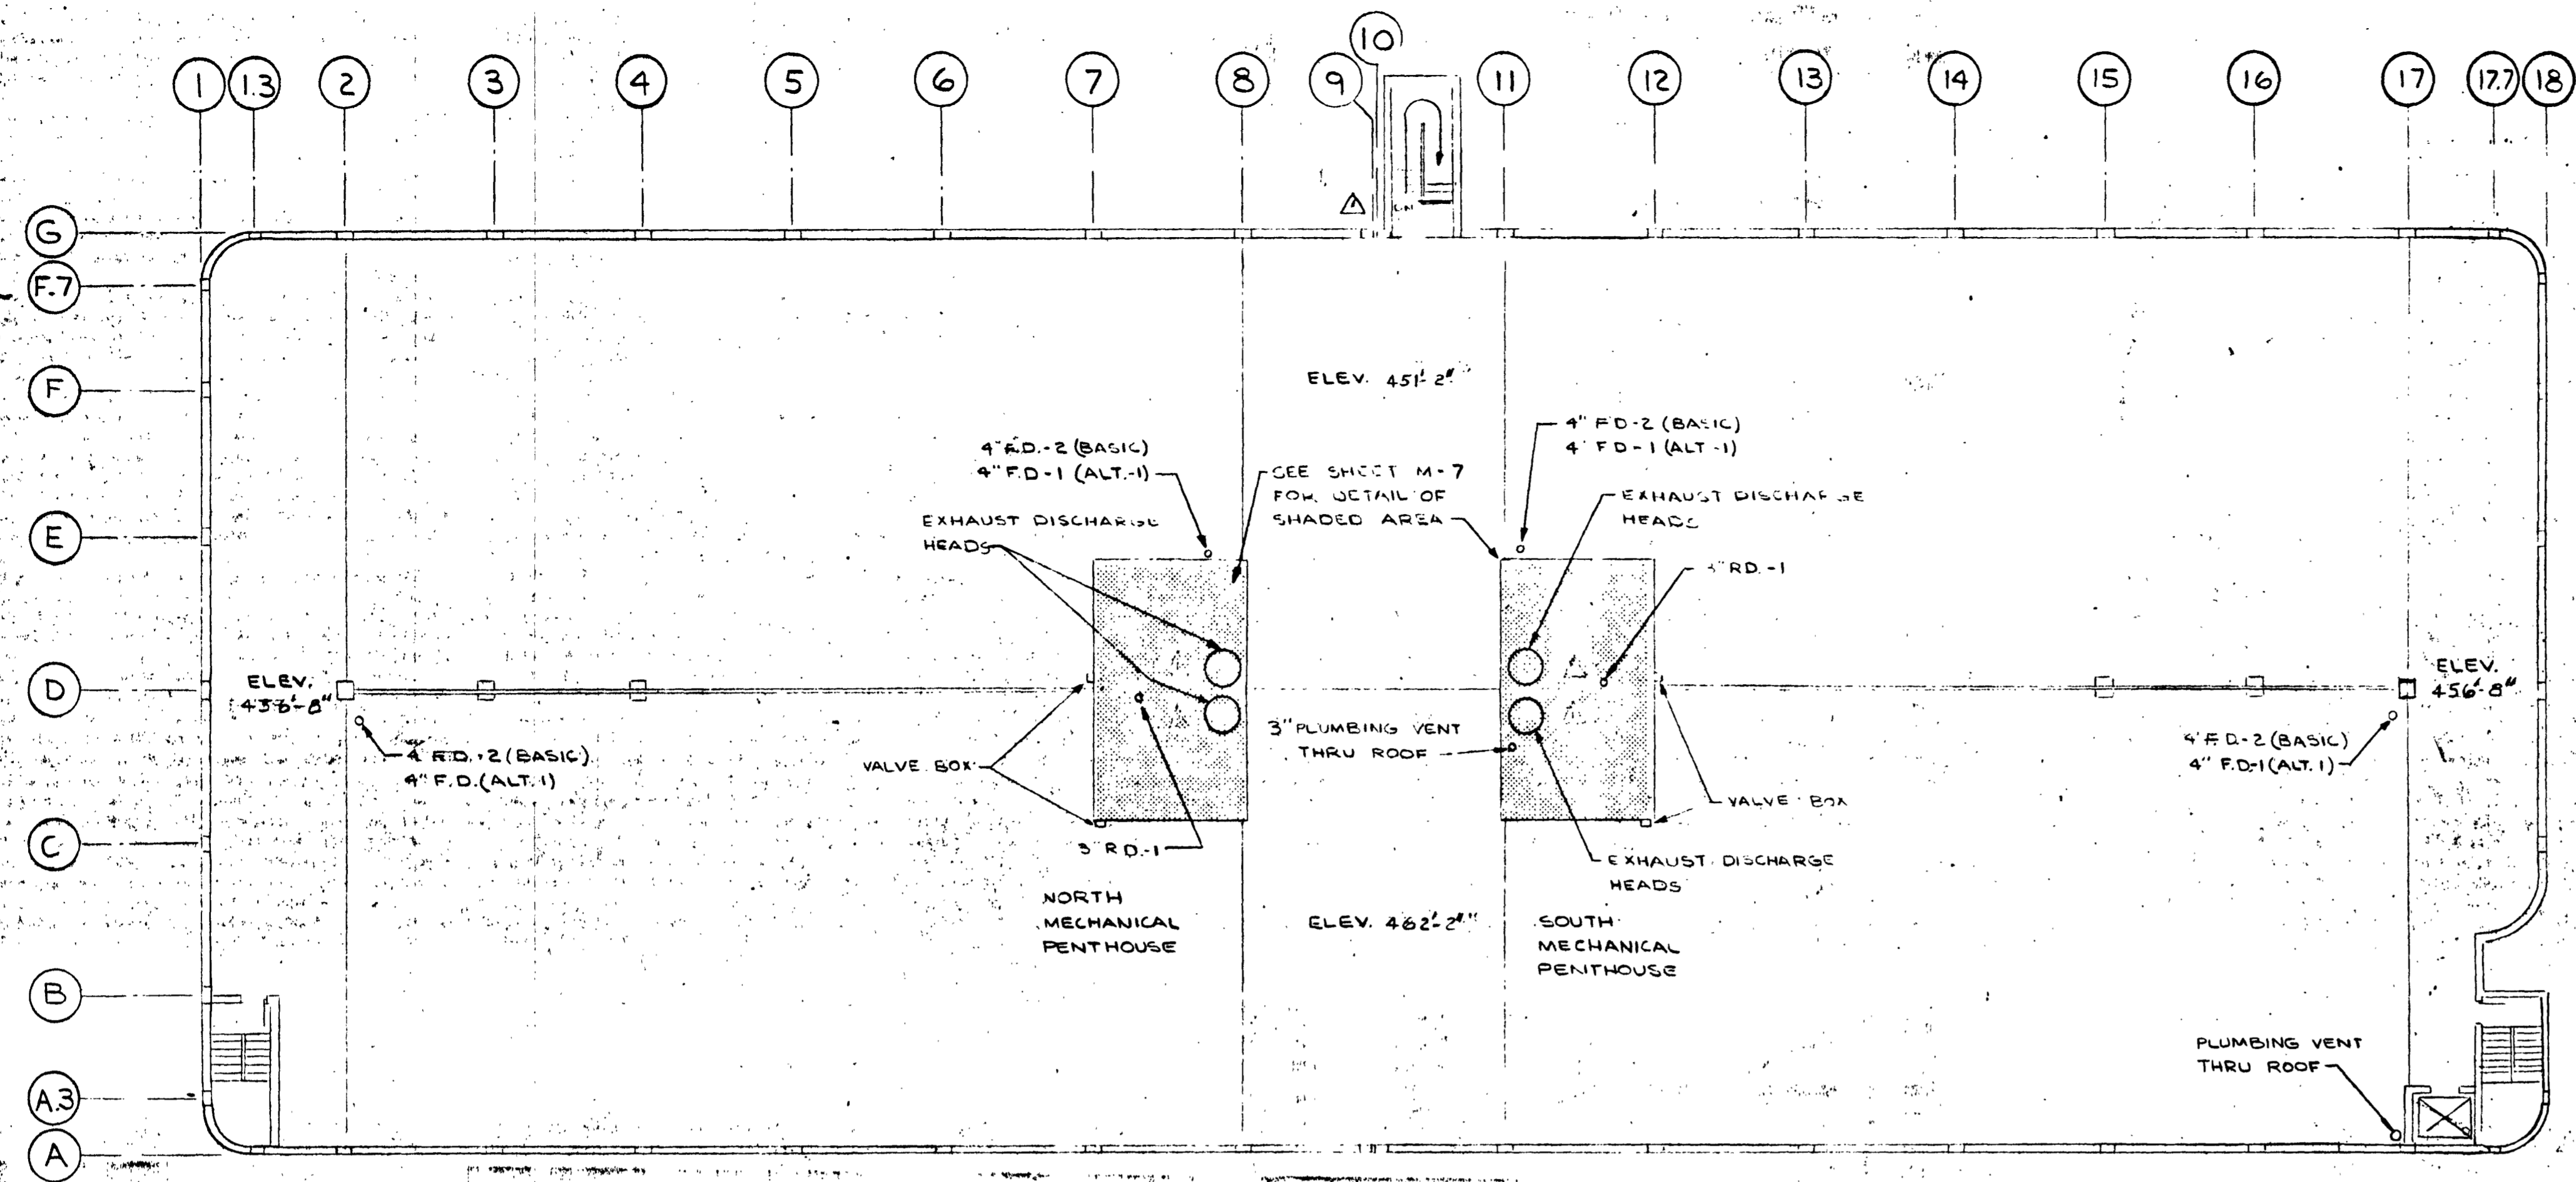


KEY PLAN
NO SCALE

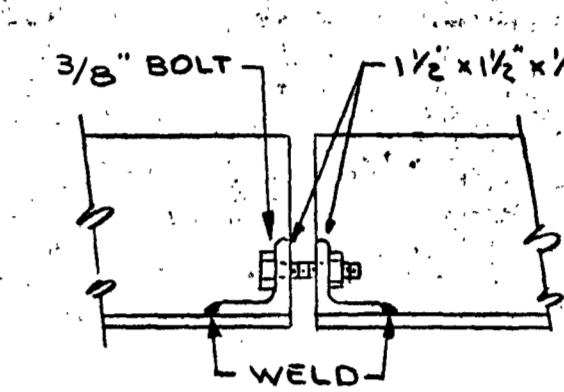


LEVEL R
SCALE 1/16" = 1'-0"

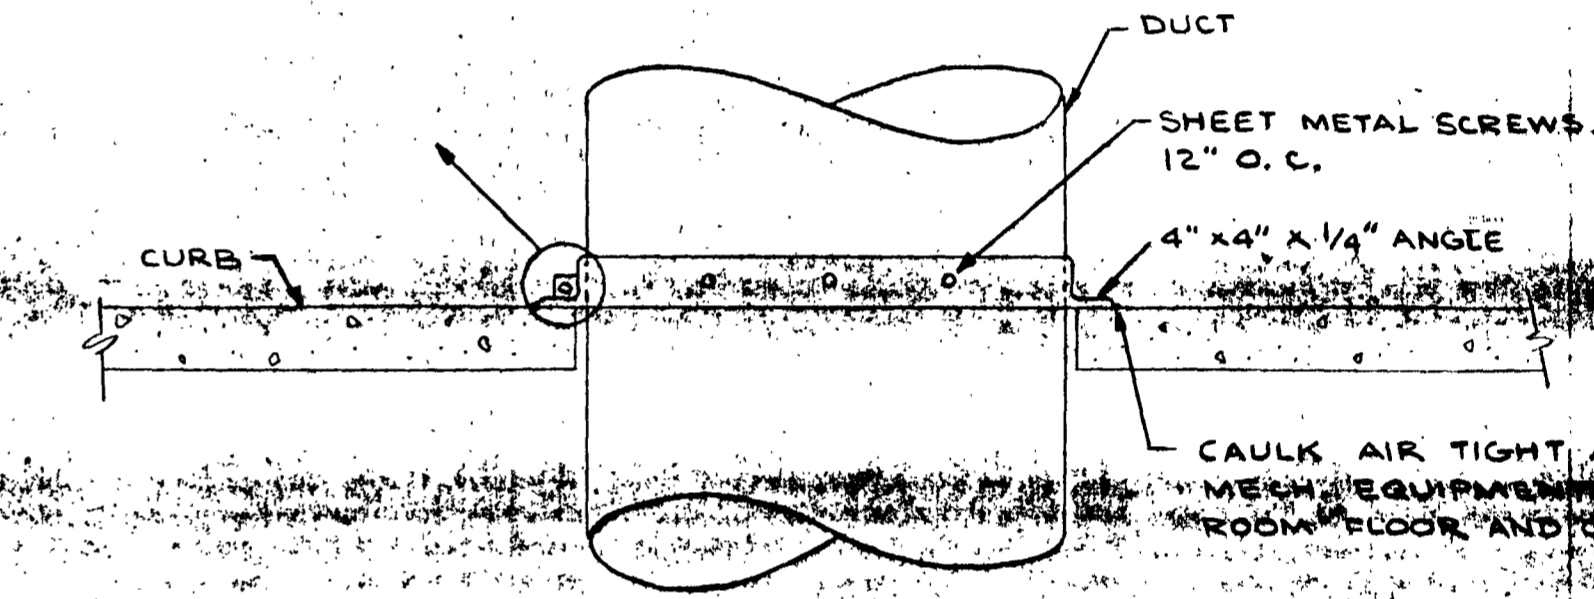

DETAIL
NO SCALE
M-5

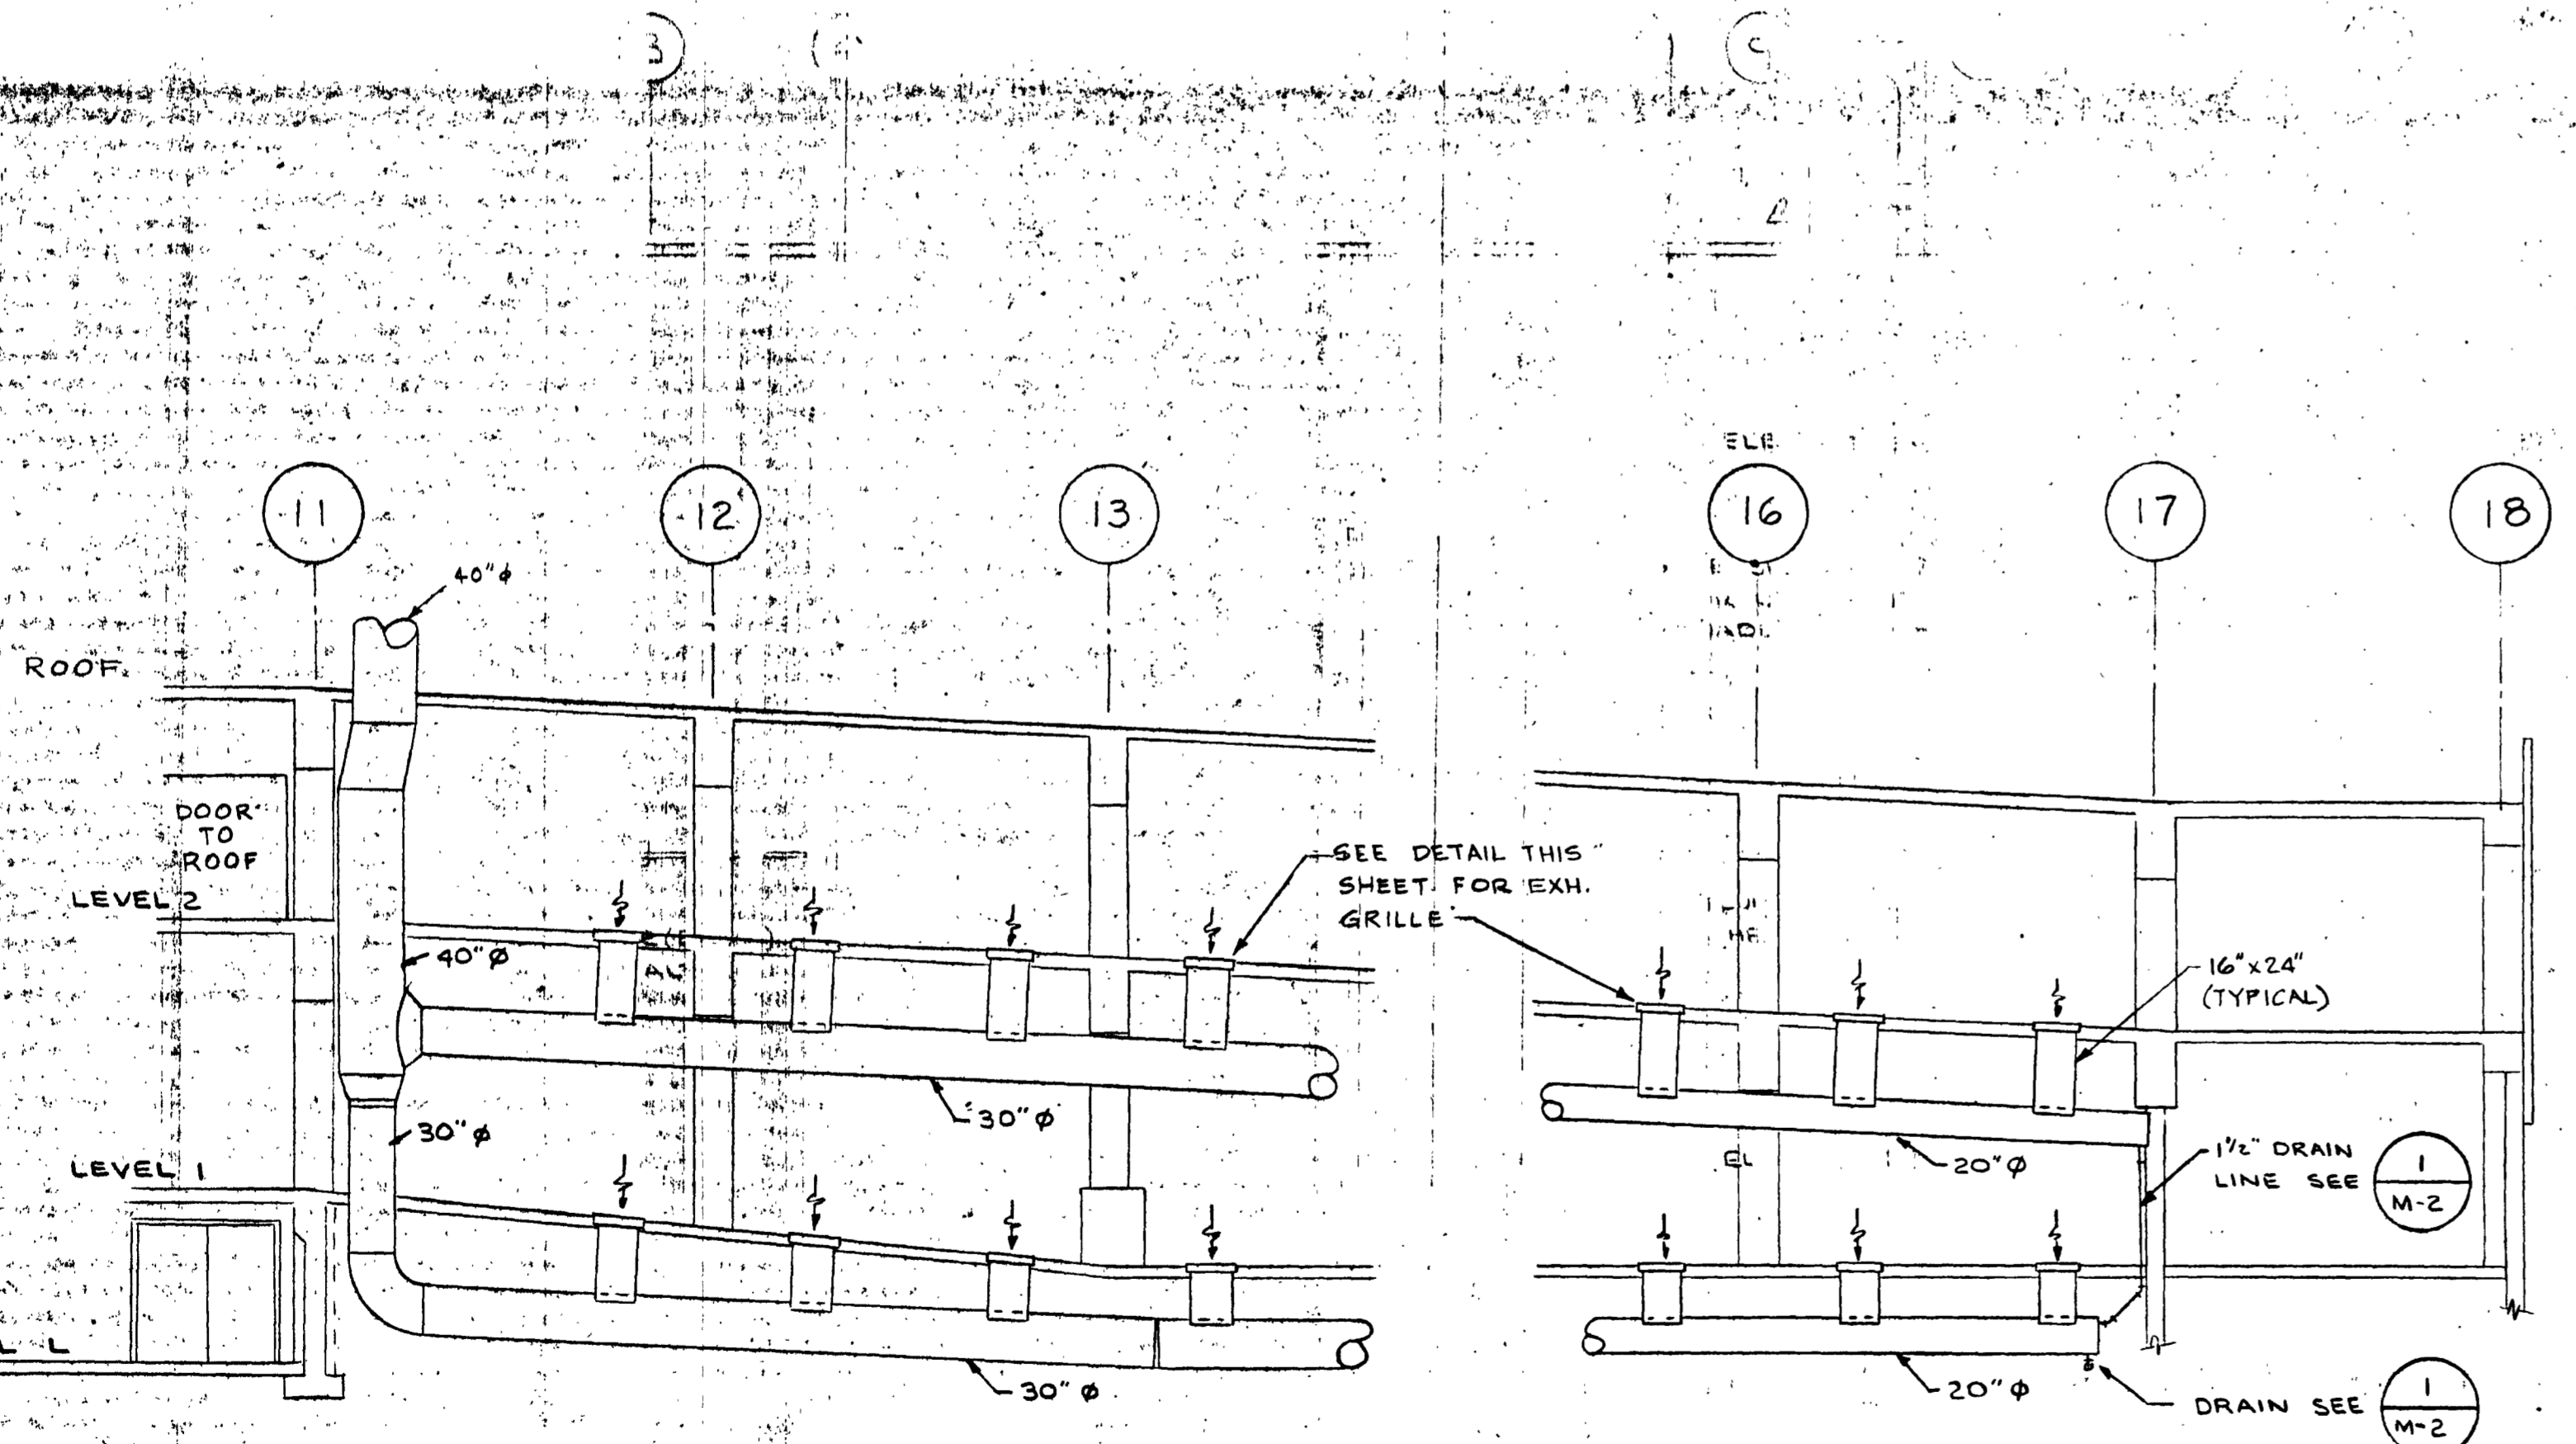

ELEVATION
NO SCALE
M-5

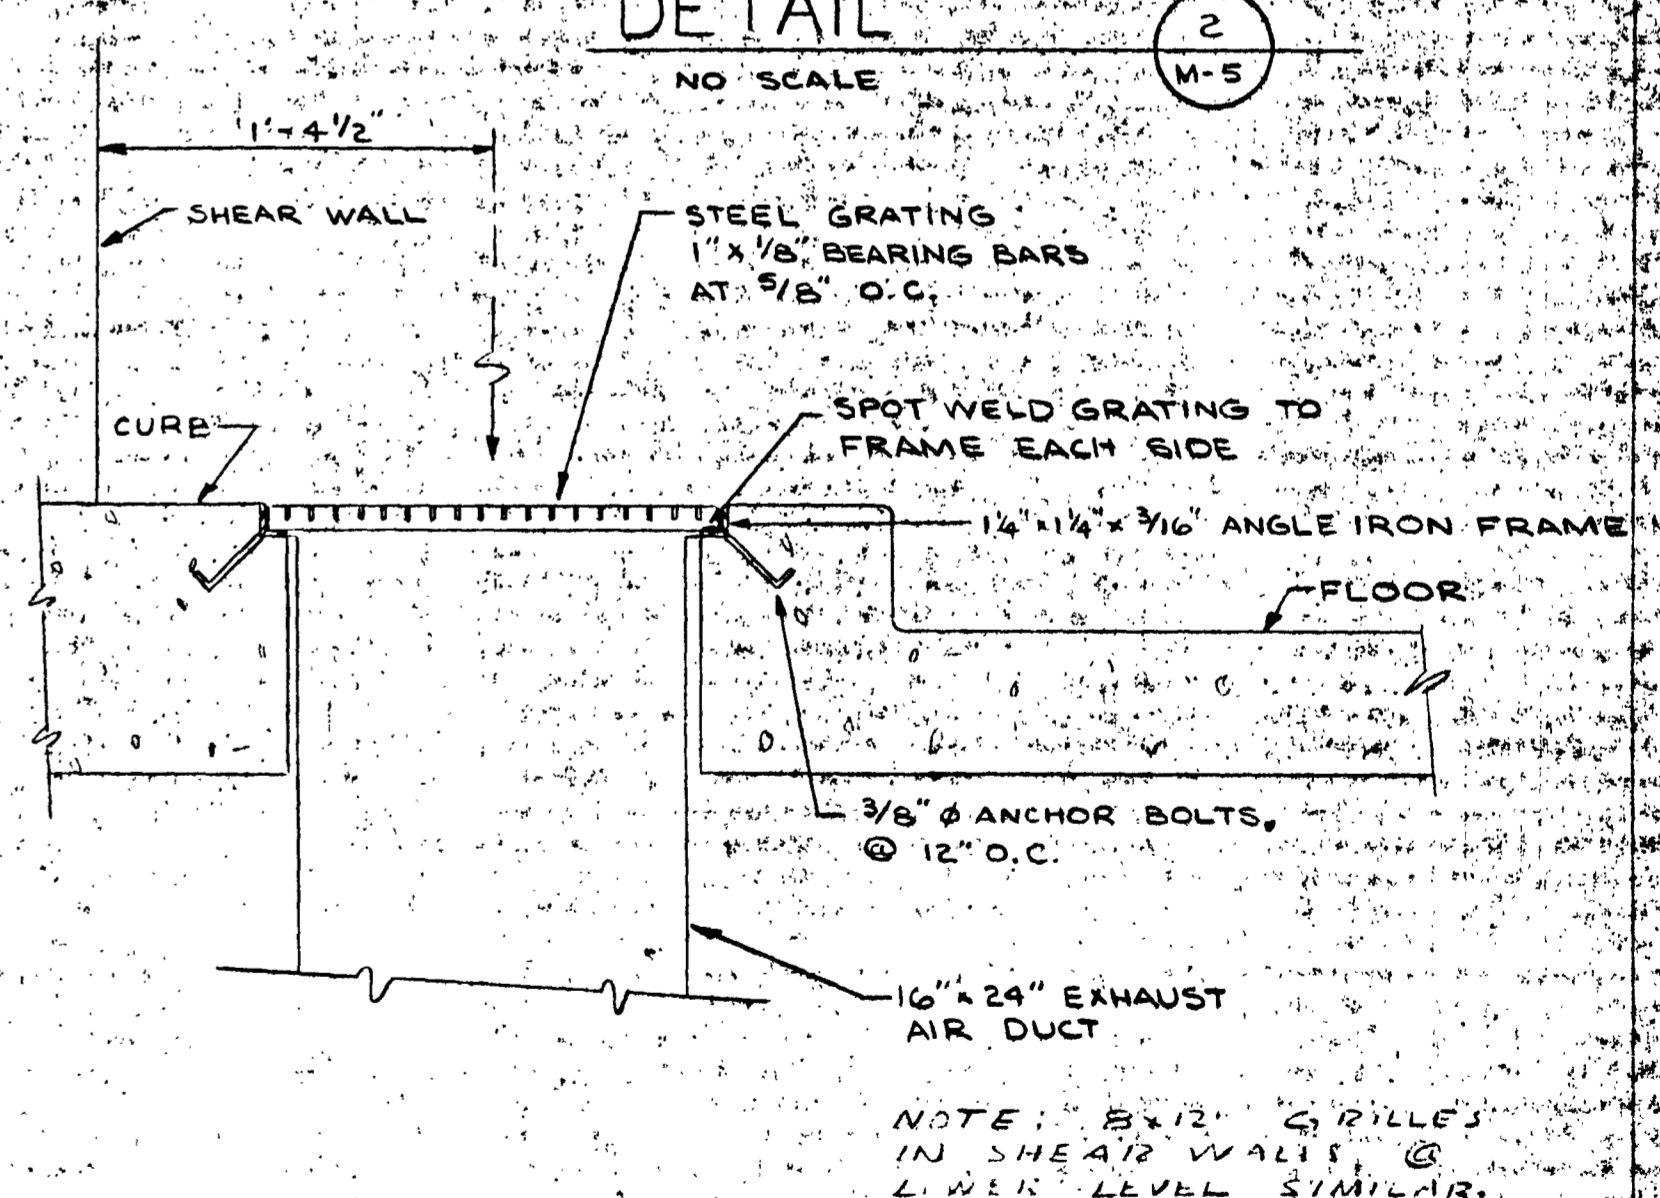

DETAIL
SCALE 1/2" = 1'-0"
M-5

LEVEL R PLAN, AND DETAILS

JOB NO. 1722-B
DATE: 6-27-74

ARCHITECTS - ENGINEERS - SURVEYORS
601 COLLEGE ROAD, FAIRBANKS, ALASKA 99701, PHONE: 452-1241



STATE OF ALASKA
DEPT. OF PUBLIC WORKS
DIVISION OF BUILDINGS
JUNEAU ALASKA

FAIRBANKS PARKING STRUCTURE
FAIRBANKS, AK.
DBA - 2 - 0130


BY: [Signature]
FAIRBANKS, ALASKA
RECOMMENDED: [Signature]
APPROVED: [Signature]
DATE: AS-BLT

M-5


SHEET 40 OF 49

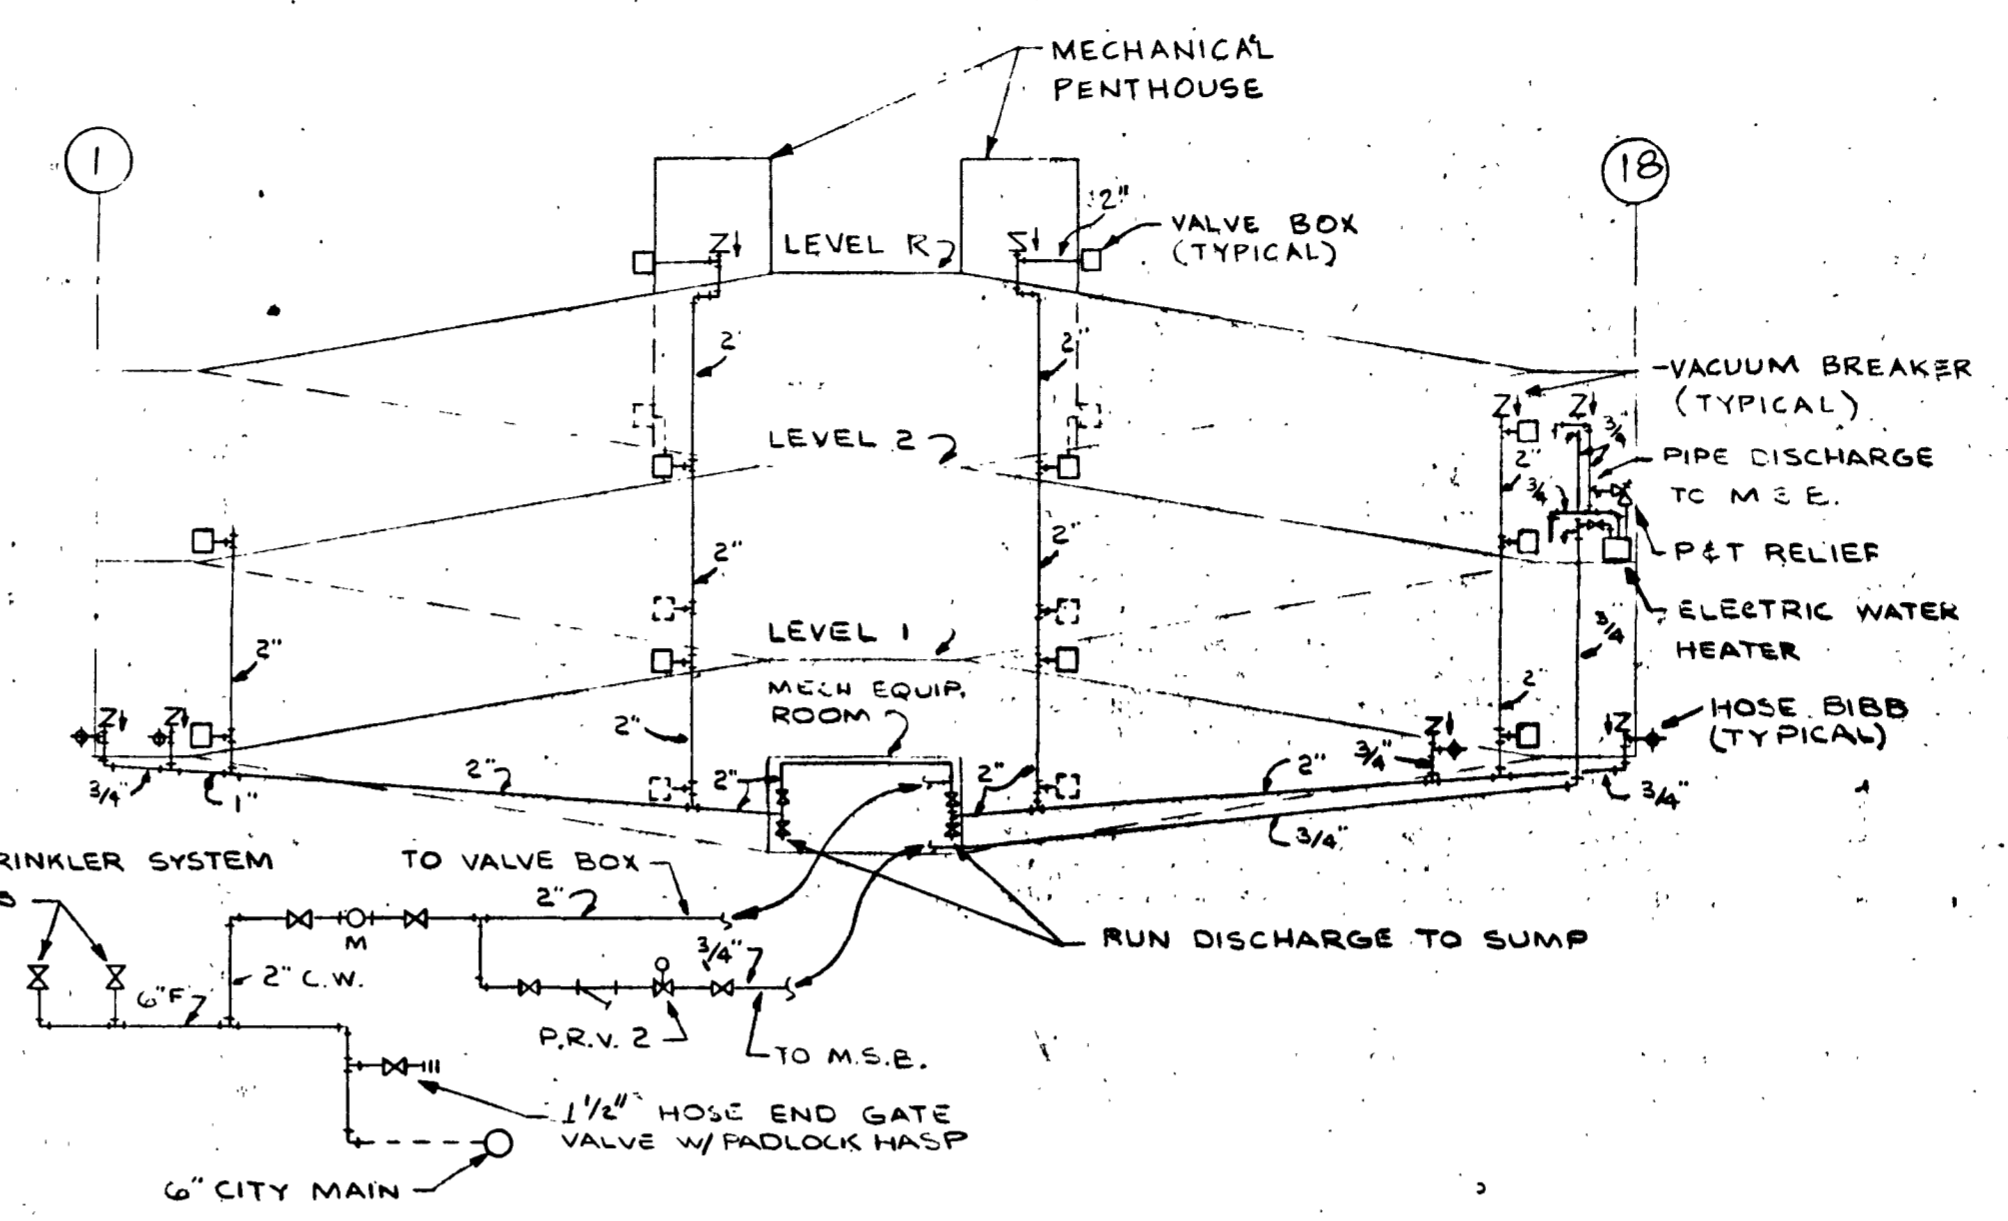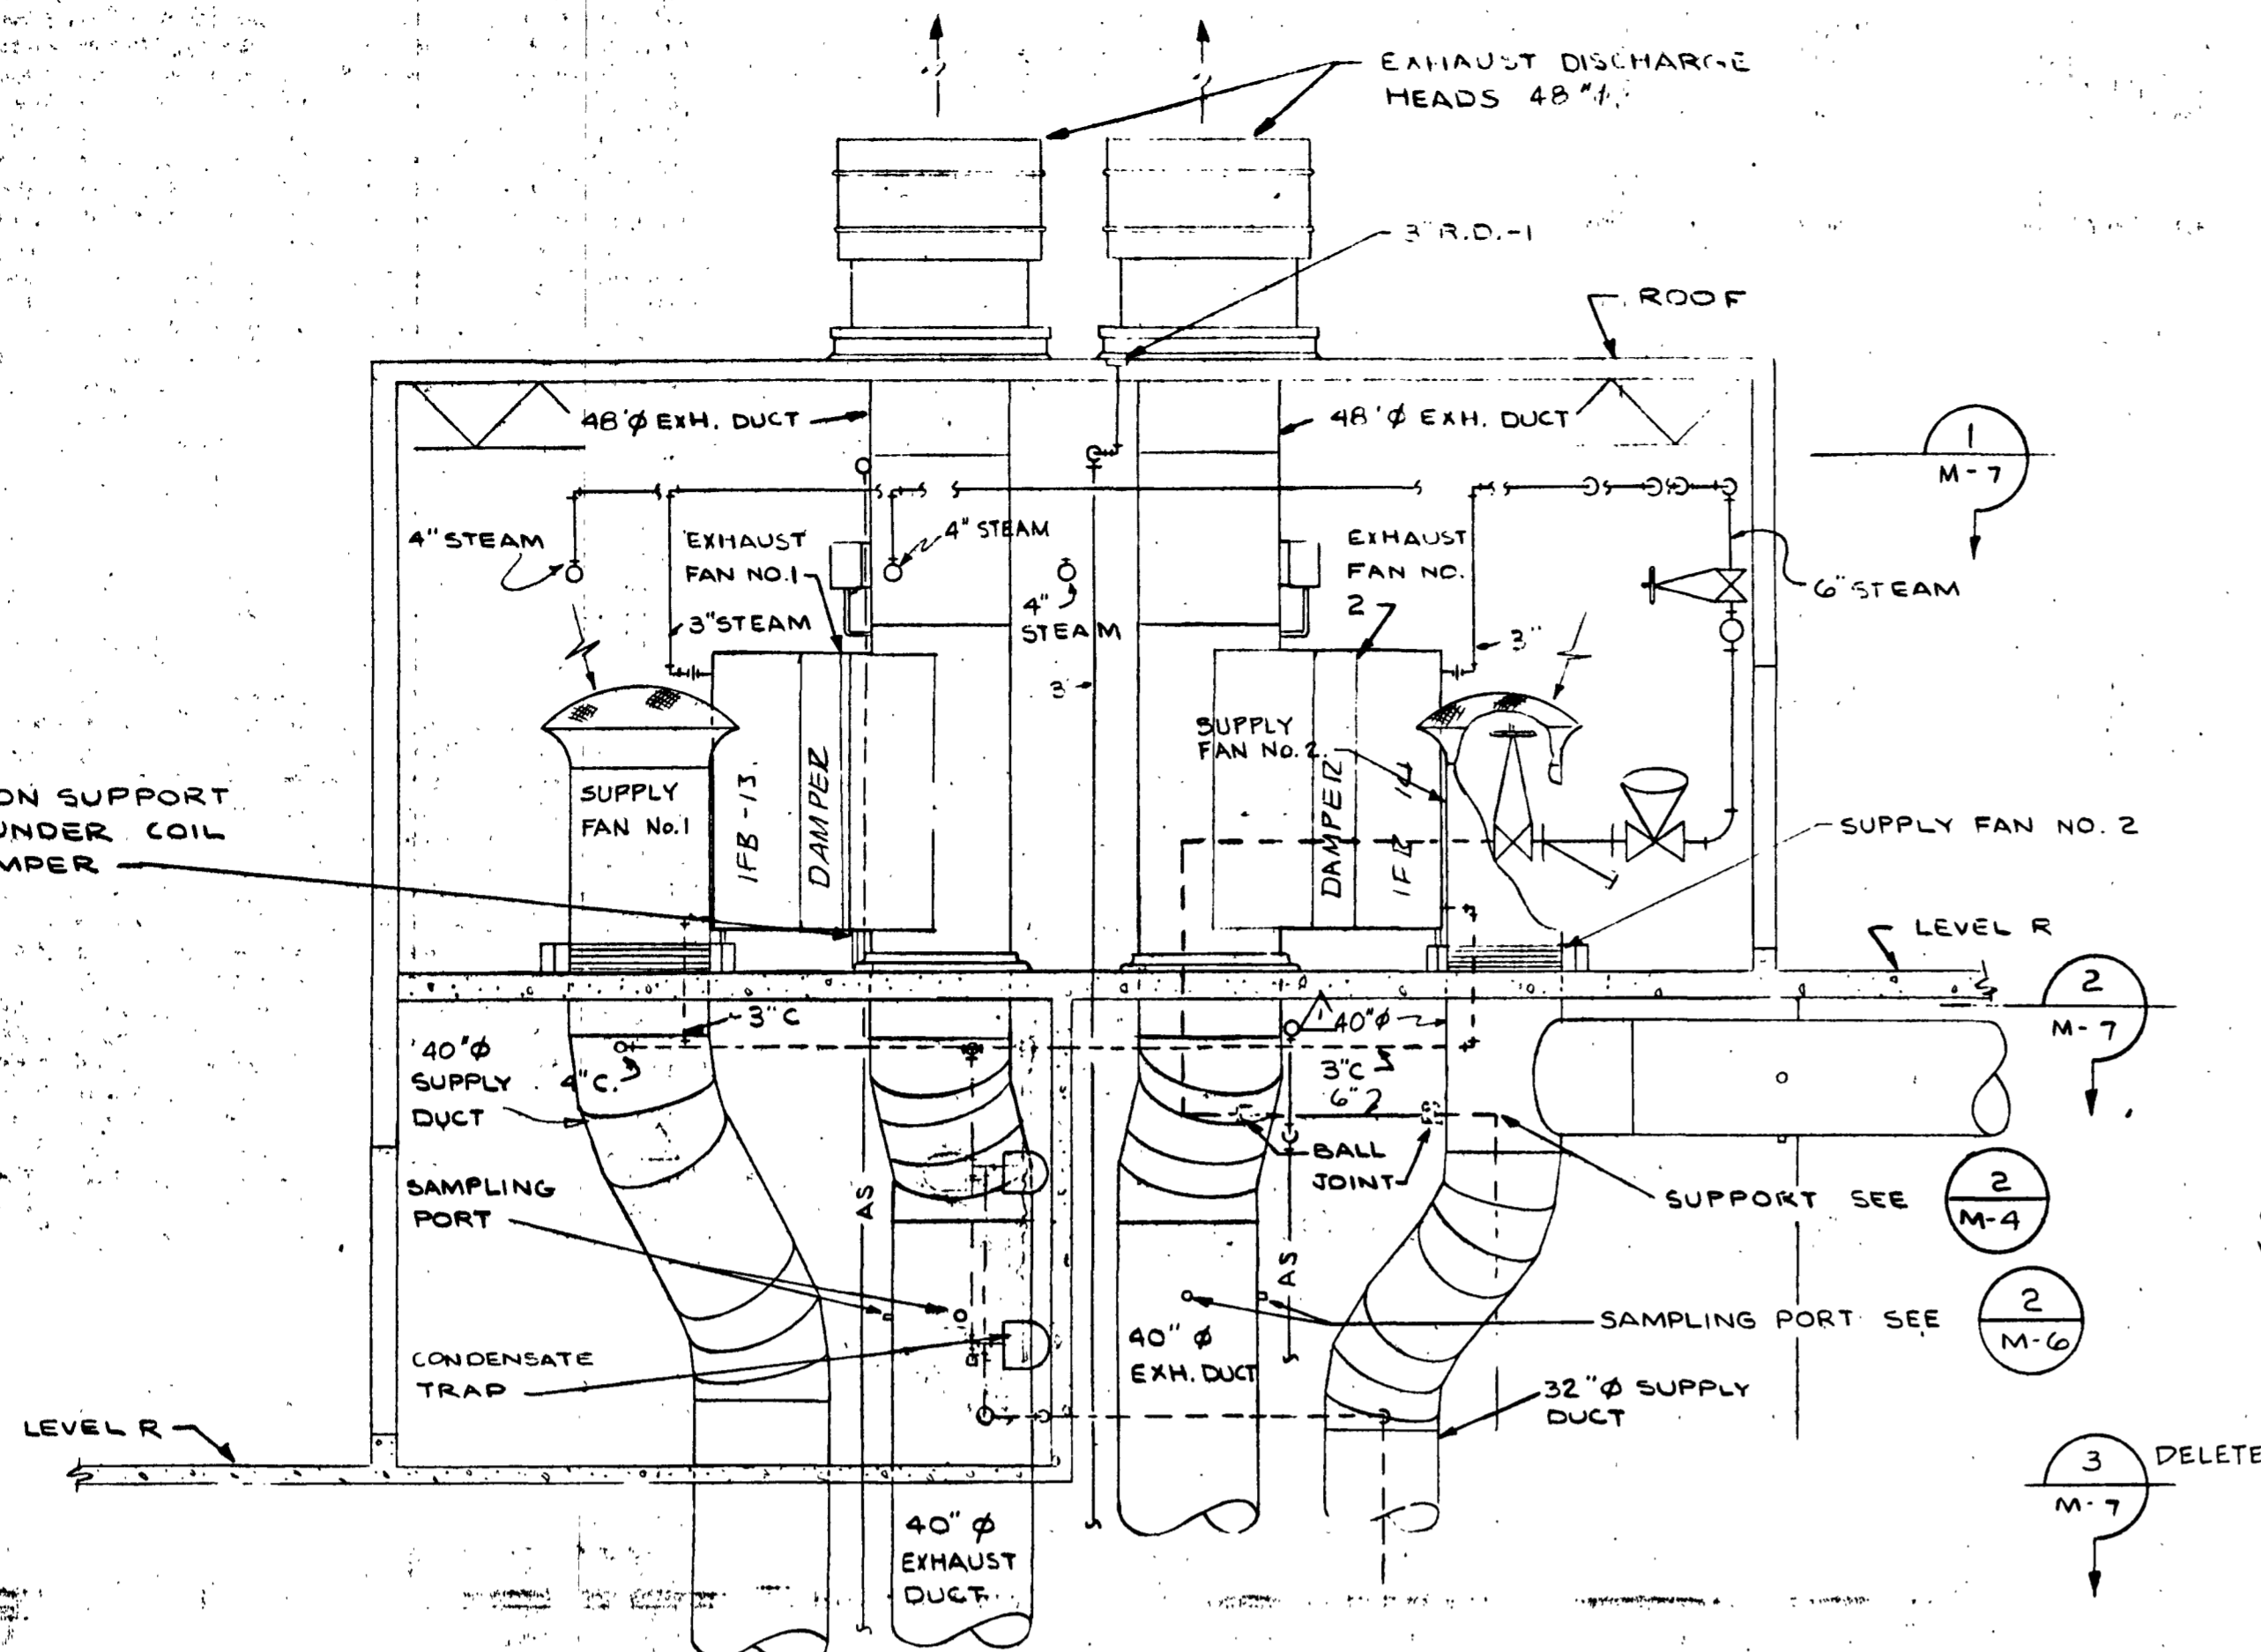


WATER RISER DIAGRAM
NO SCALE

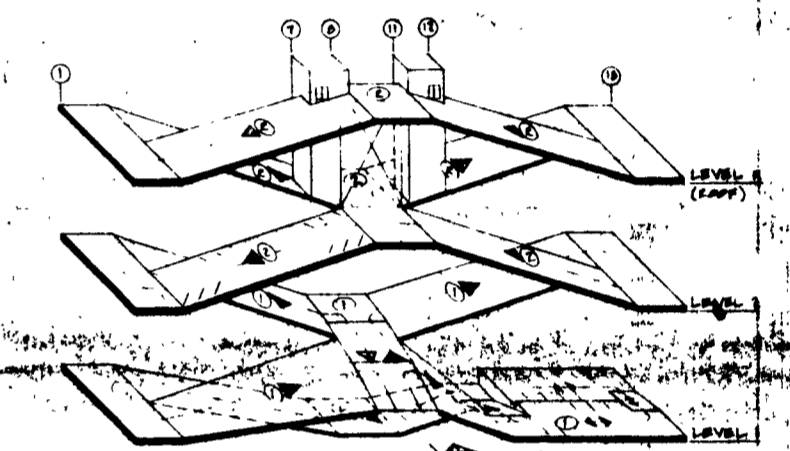


KEY PLAN
NO SCALE

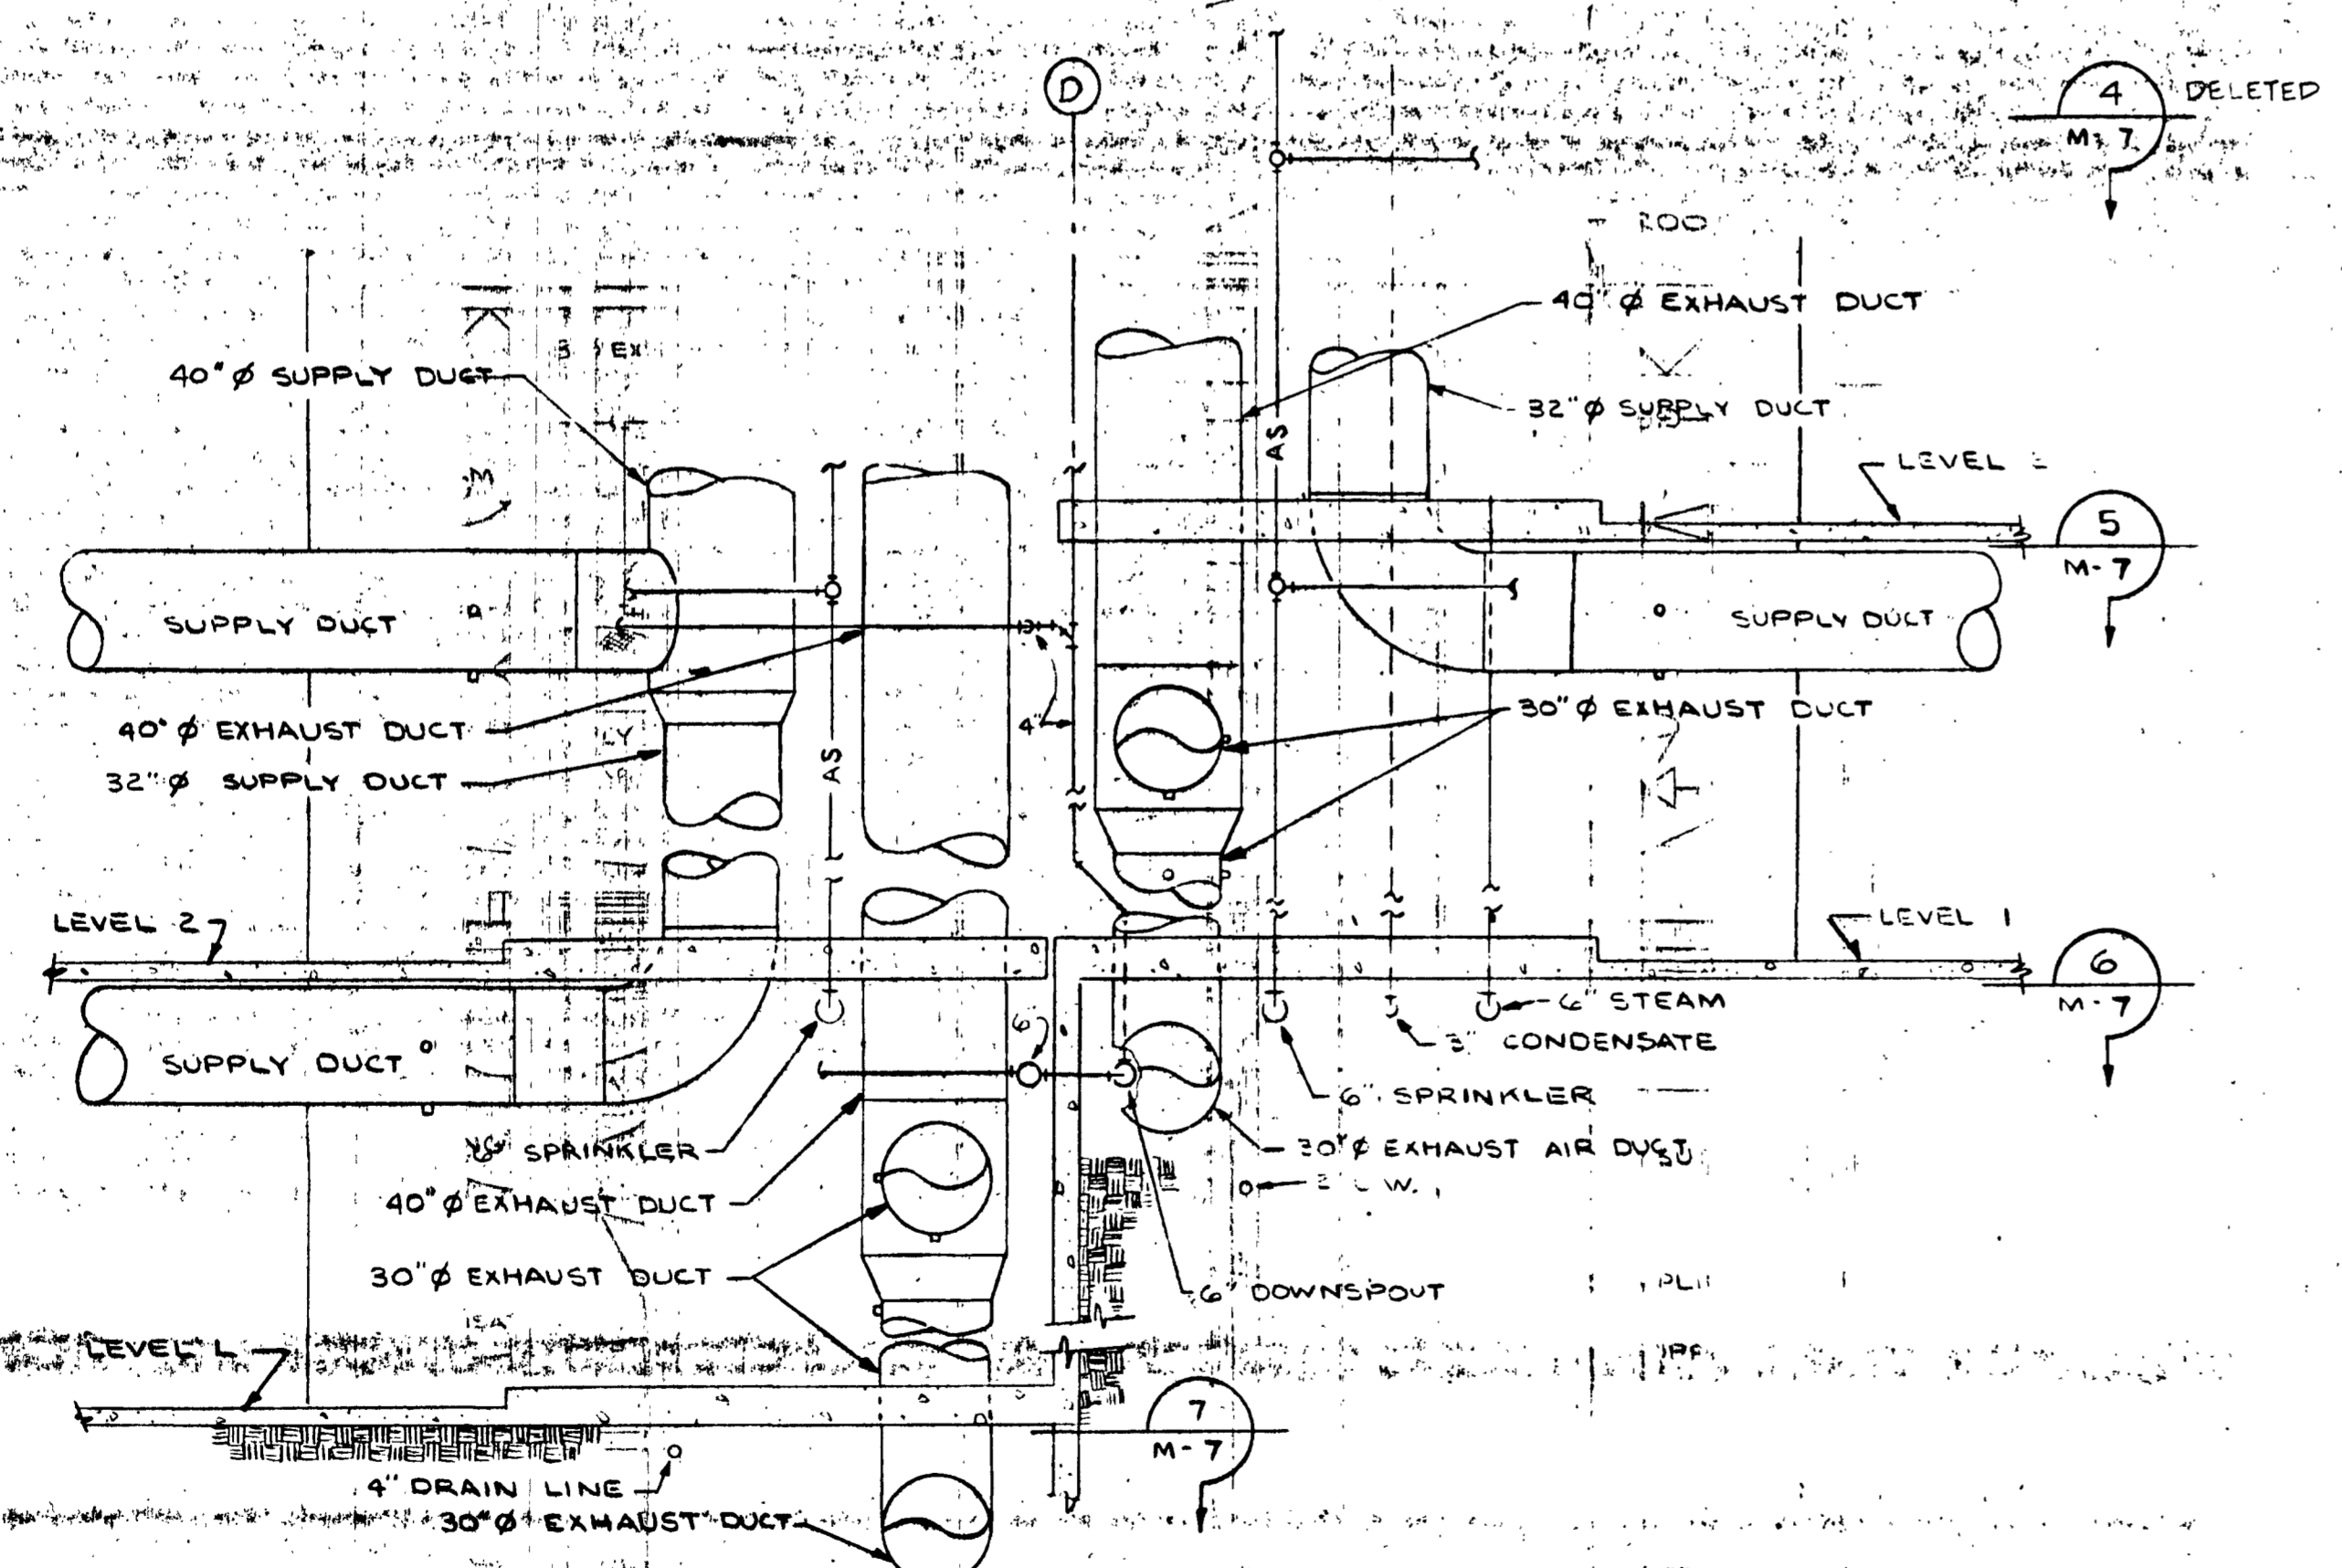

ELEVATION
SCALE 1/8\"/>

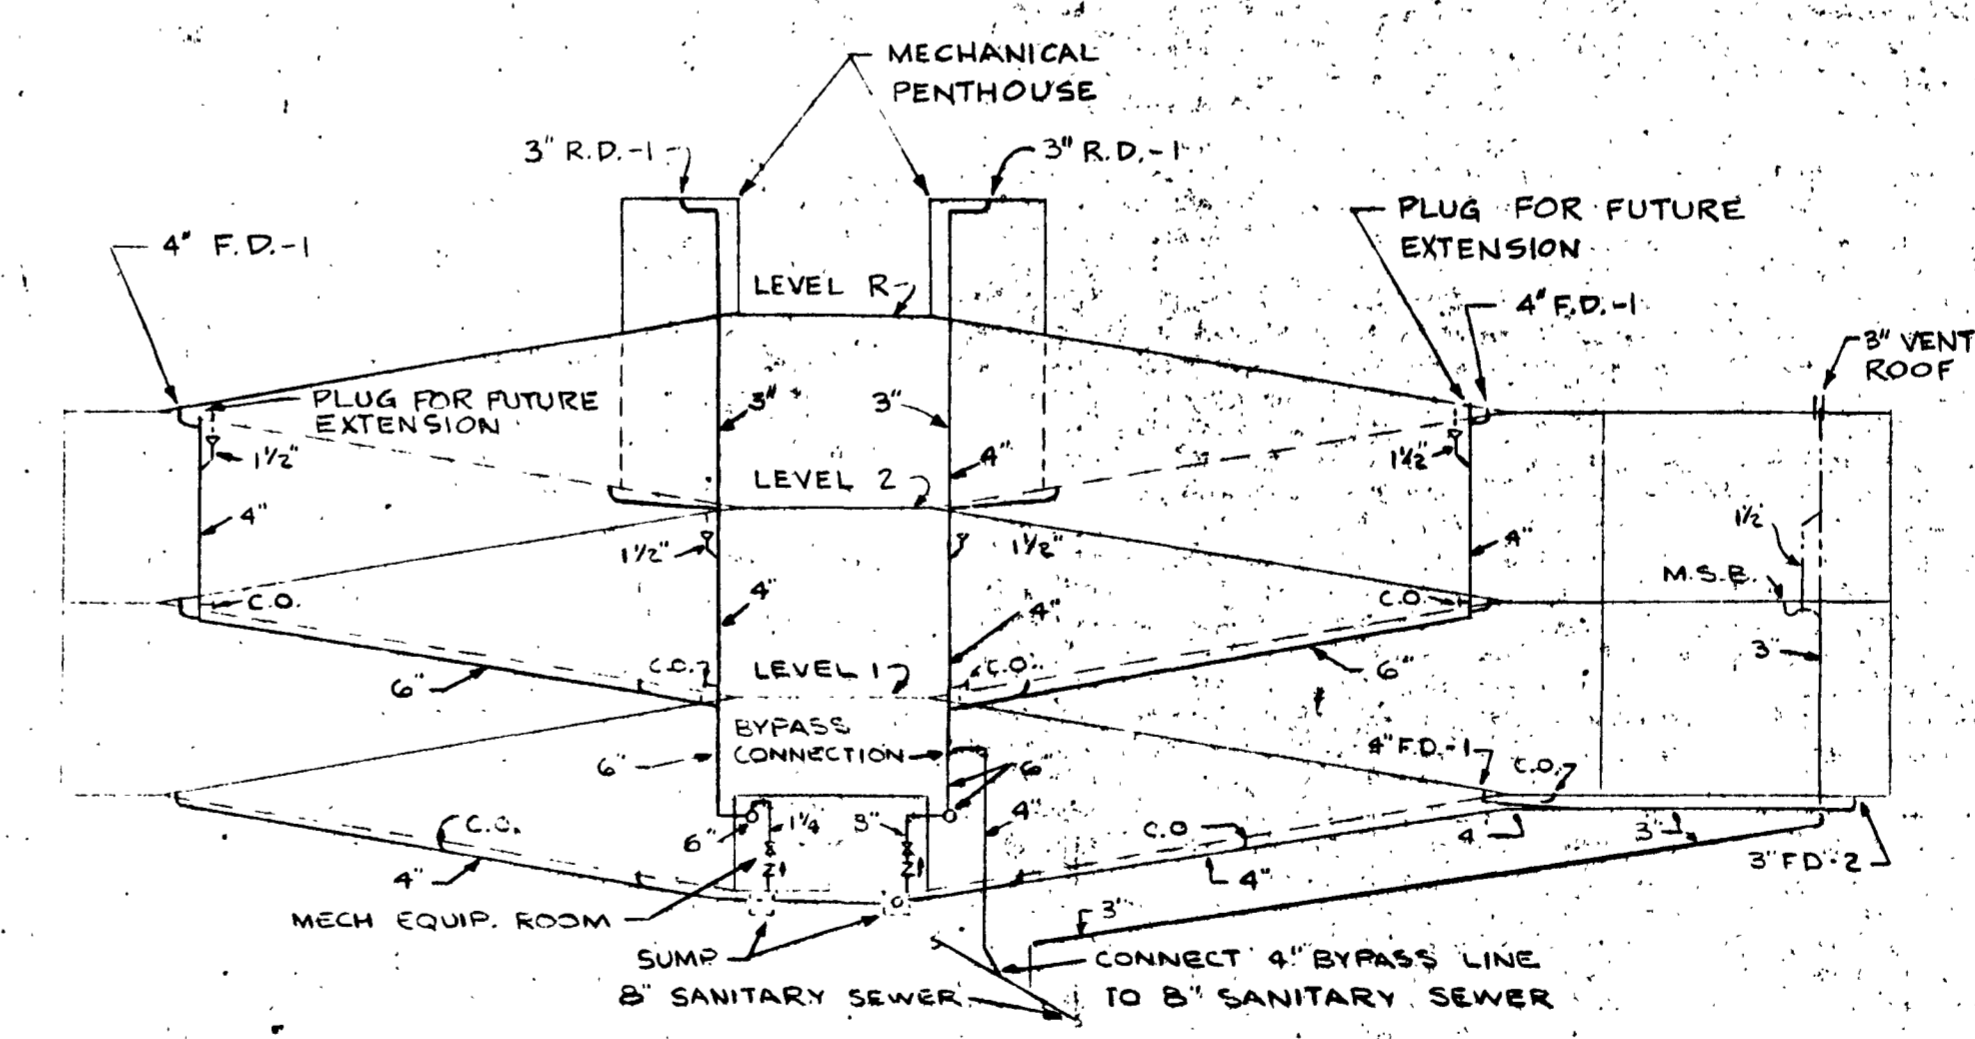

DRAINAGE DIAGRAM
NO SCALE

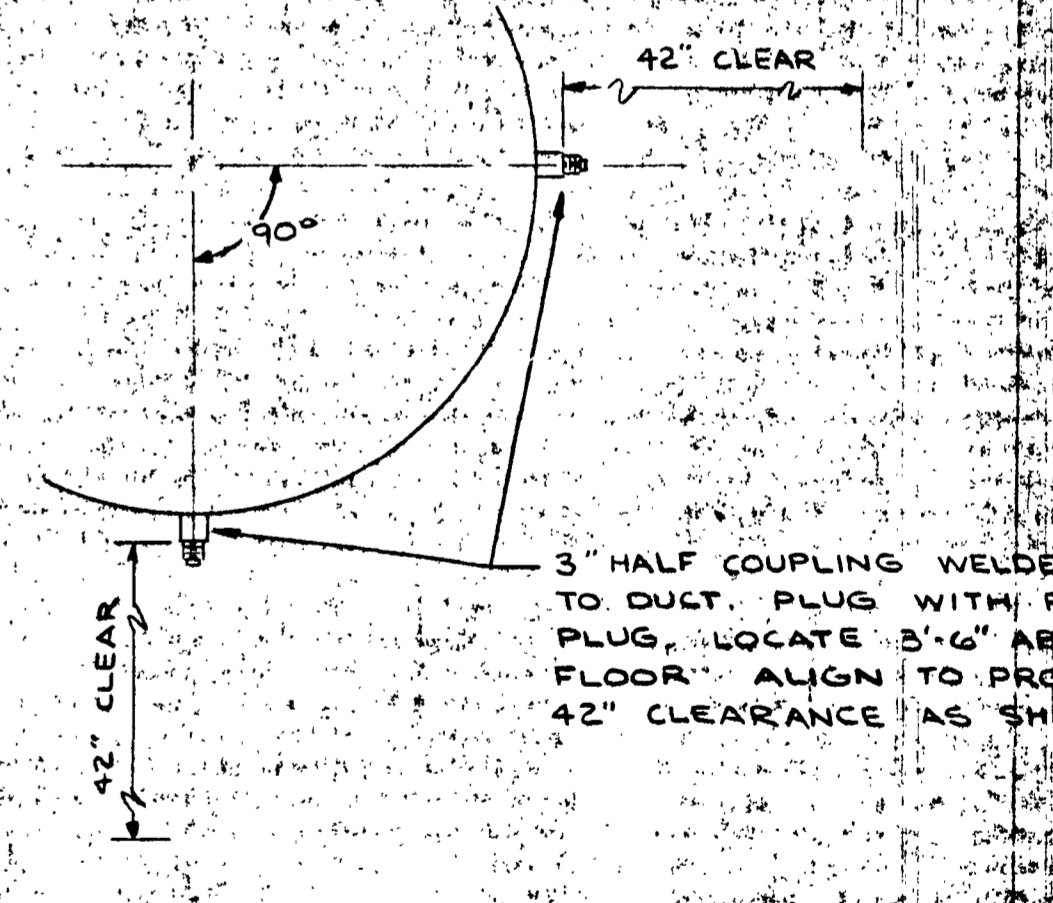

SAMPLE PORT
NO SCALE

JOE NO. 1
DATE 12-27-74


ARCHITECTS • ENGINEERS • SURVEYORS
401 COLLEGE ROAD, FAIRBANKS, ALASKA 99701, PHONE: 452-1241

STATE OF ALASKA
DEPT. OF PUBLIC WORKS
DIVISION OF BUILDINGS
JUNEAU ALASKA

FAIRBANKS PARKING STRUCTURE
FAIRBANKS, AK.
DBA - 2 - 0130

PETER MEYER SONS' CO.
FAIRBANKS, ALASKA
APPROVED: [Signature]
DATE: 12/27/74


M-6
SHEET 41 OF 49

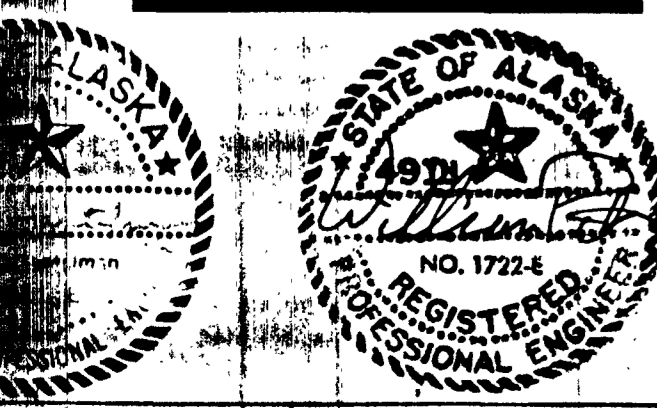


DETAILS

GRAY ROGERS MYERS & MORGAN


A DIVISION OF ELLERBE

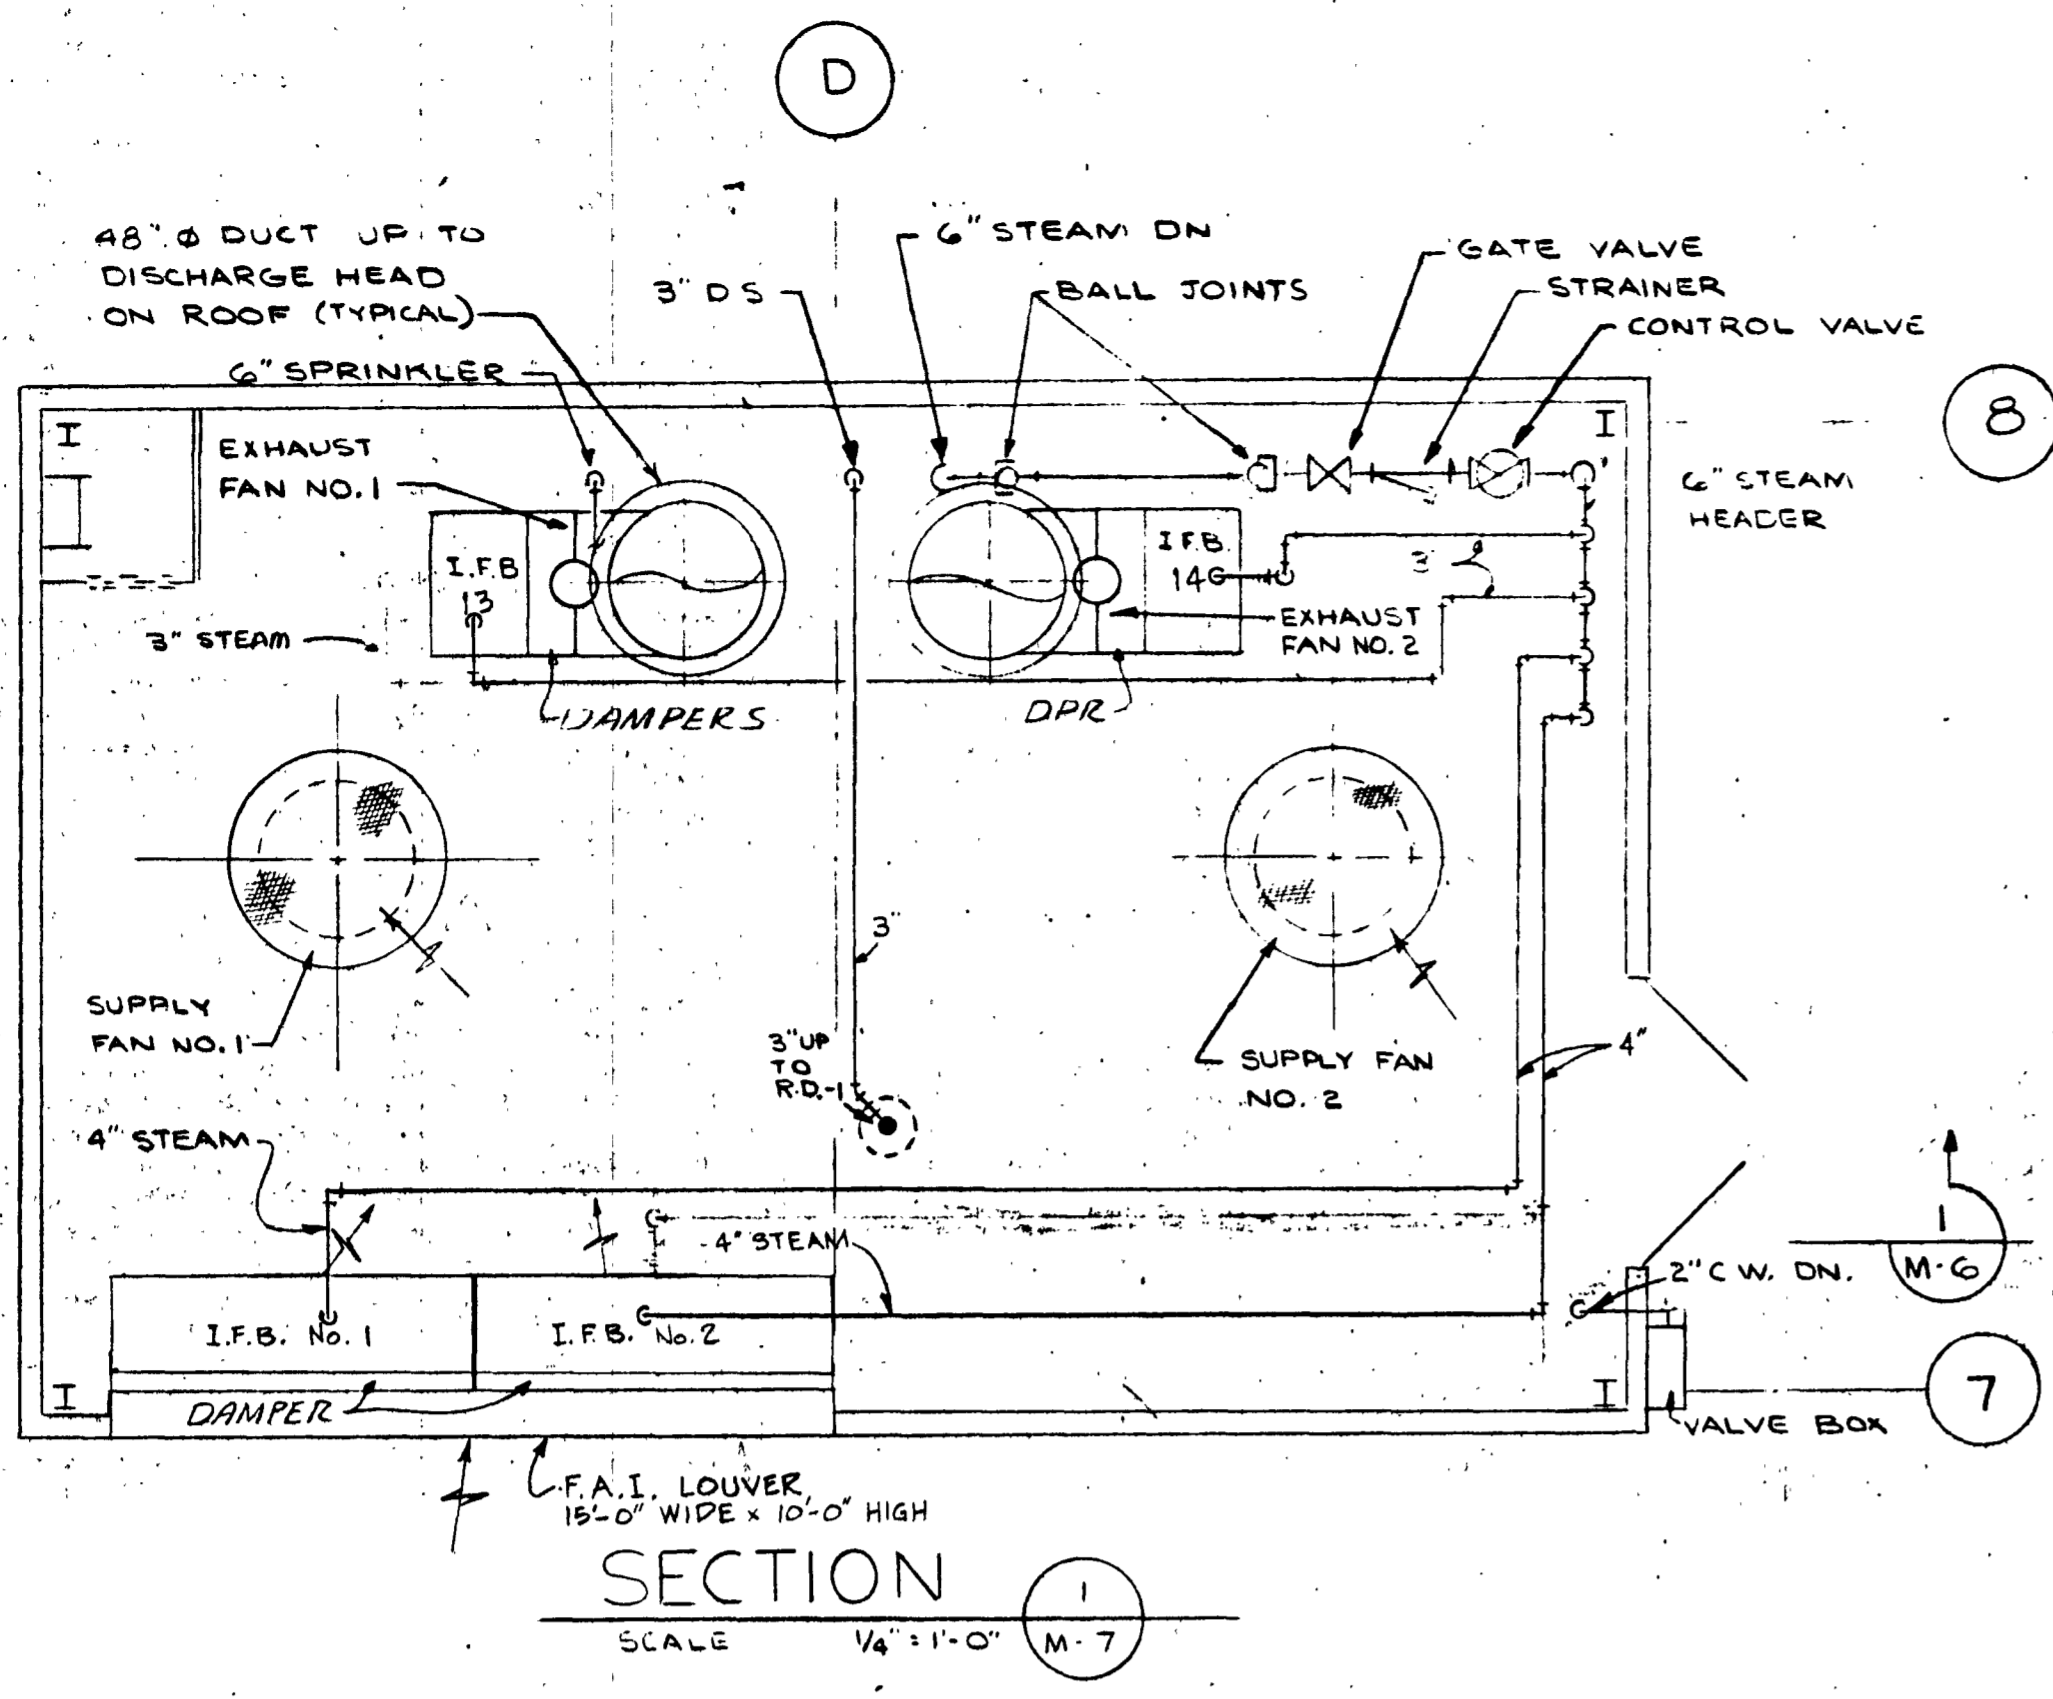


SECTION 1
SCALE 1/4" = 1'-0" M-7

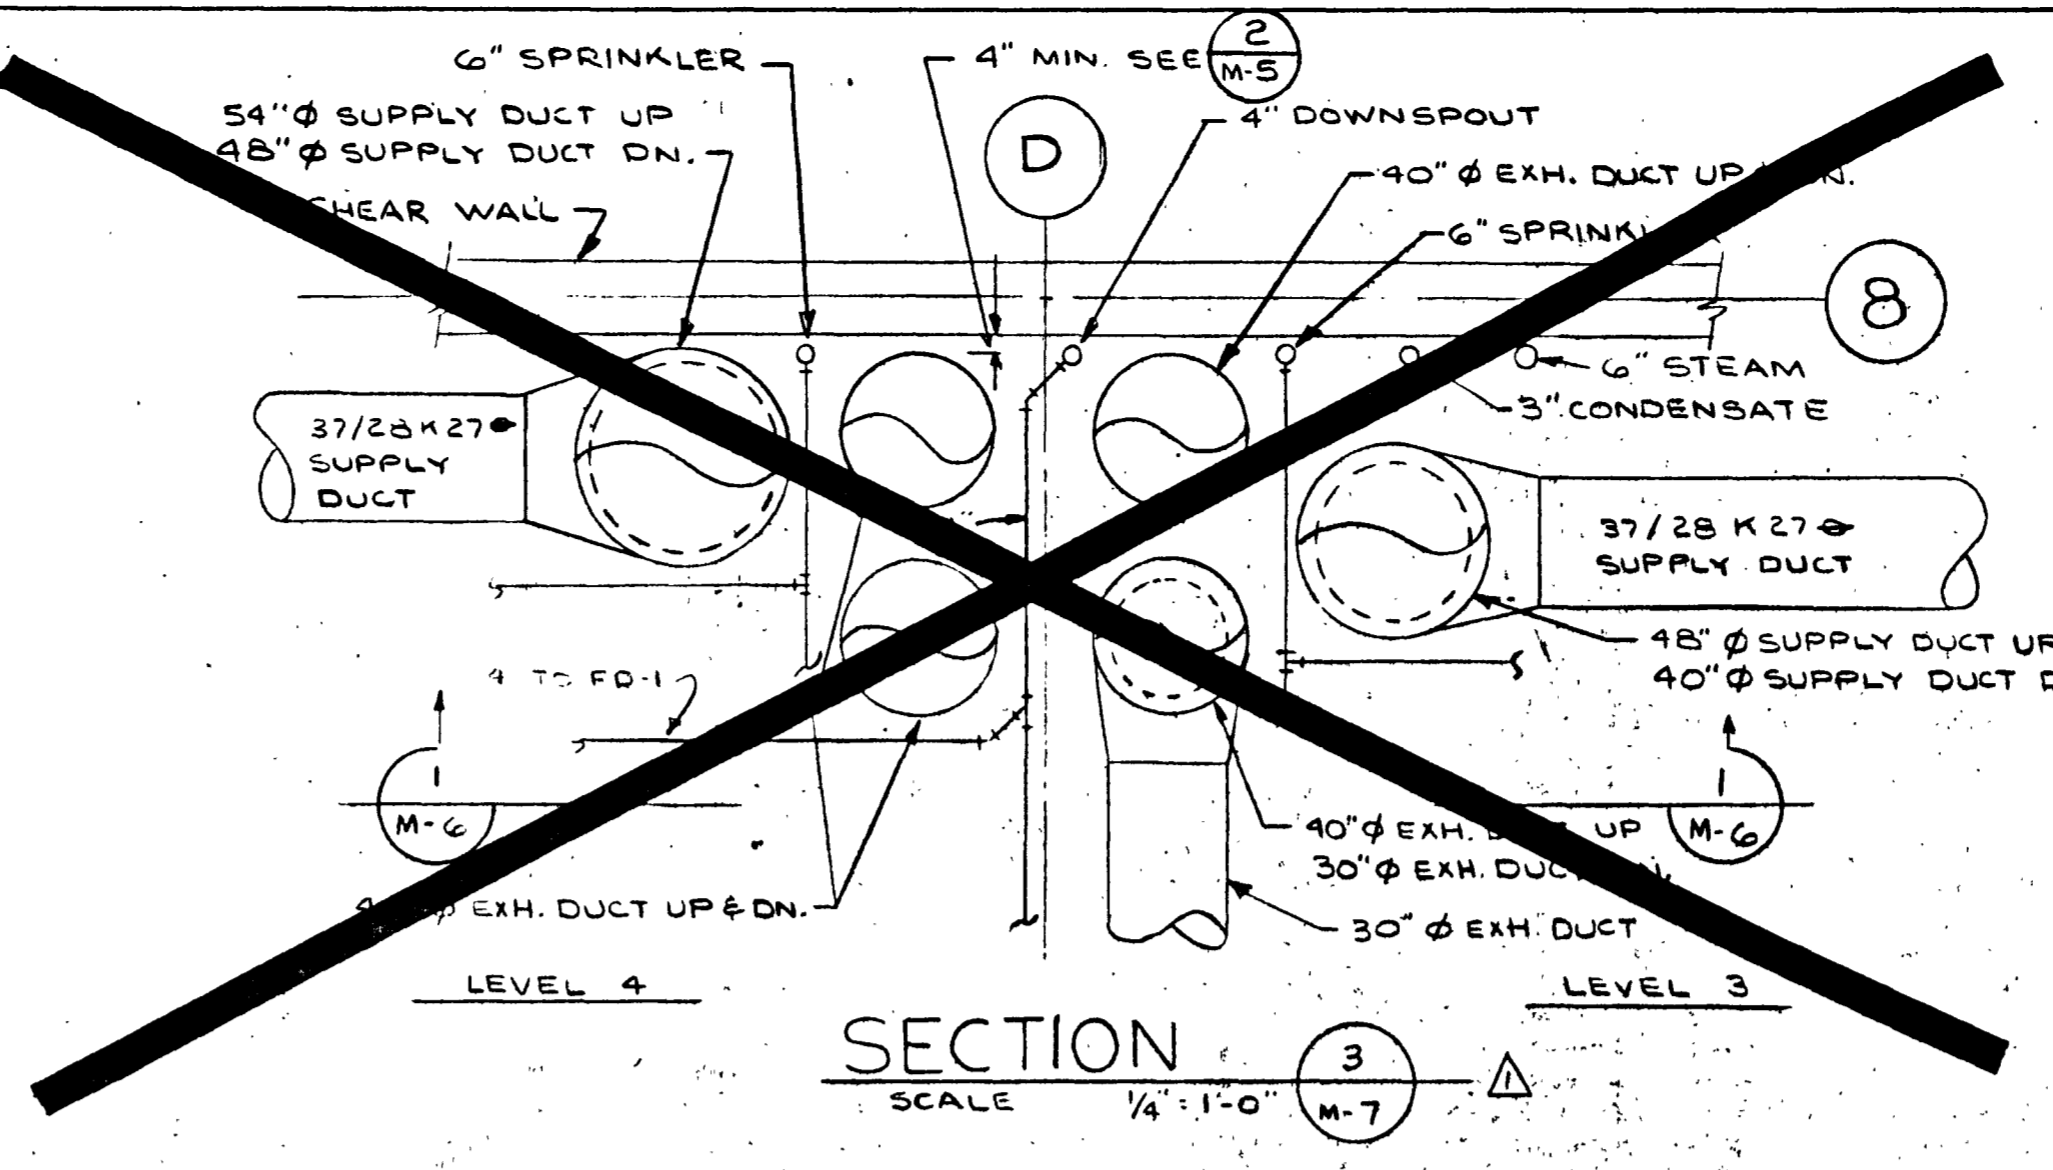


SECTION 3
SCALE 1/4" = 1'-0" M-7

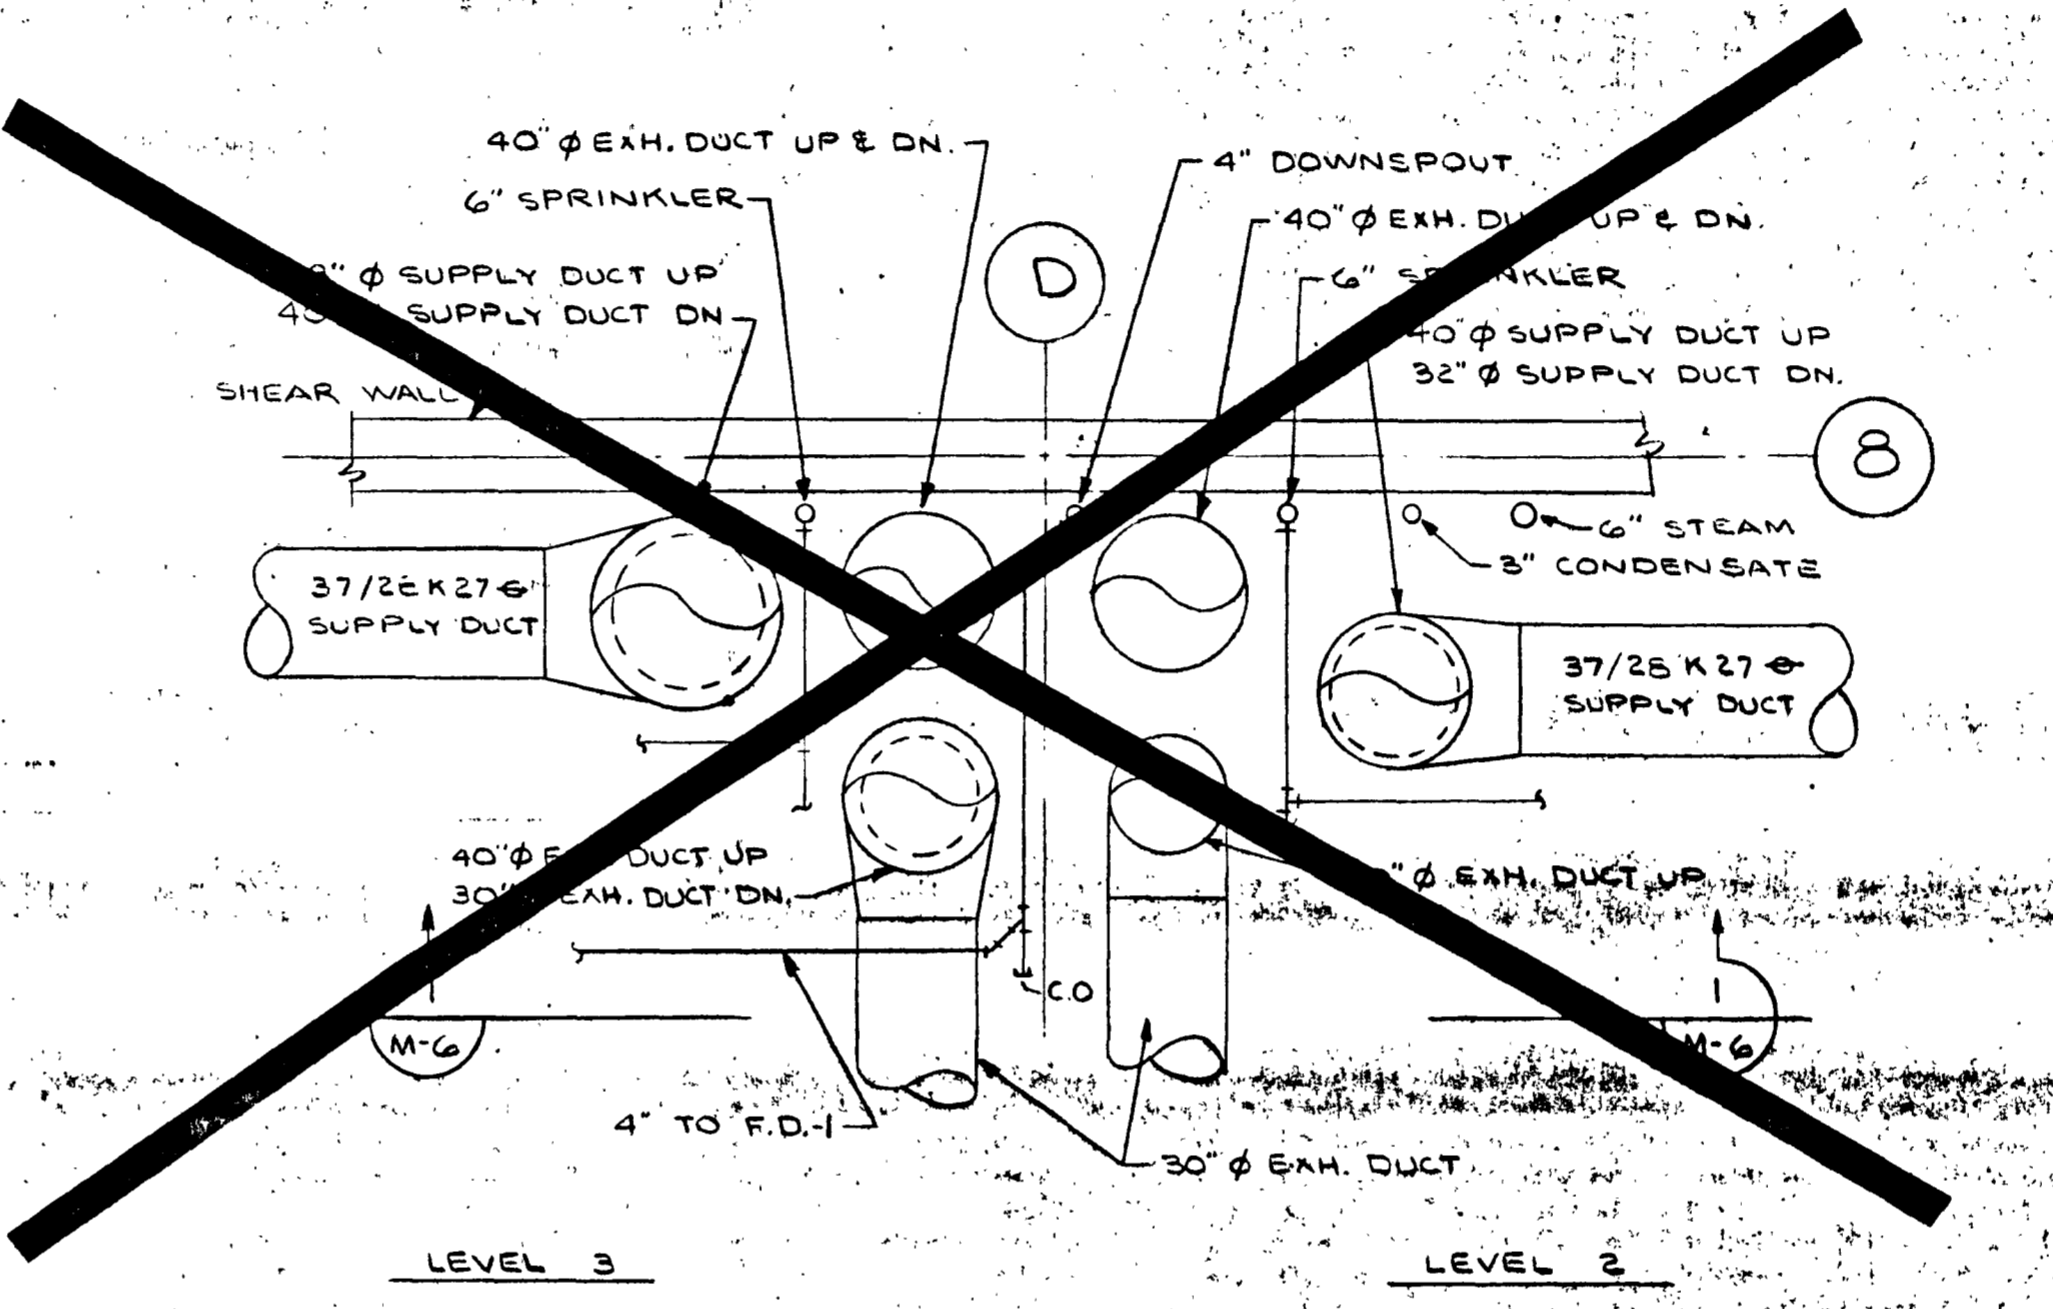


SECTION 4
SCALE 1/4" = 1'-0" M-7

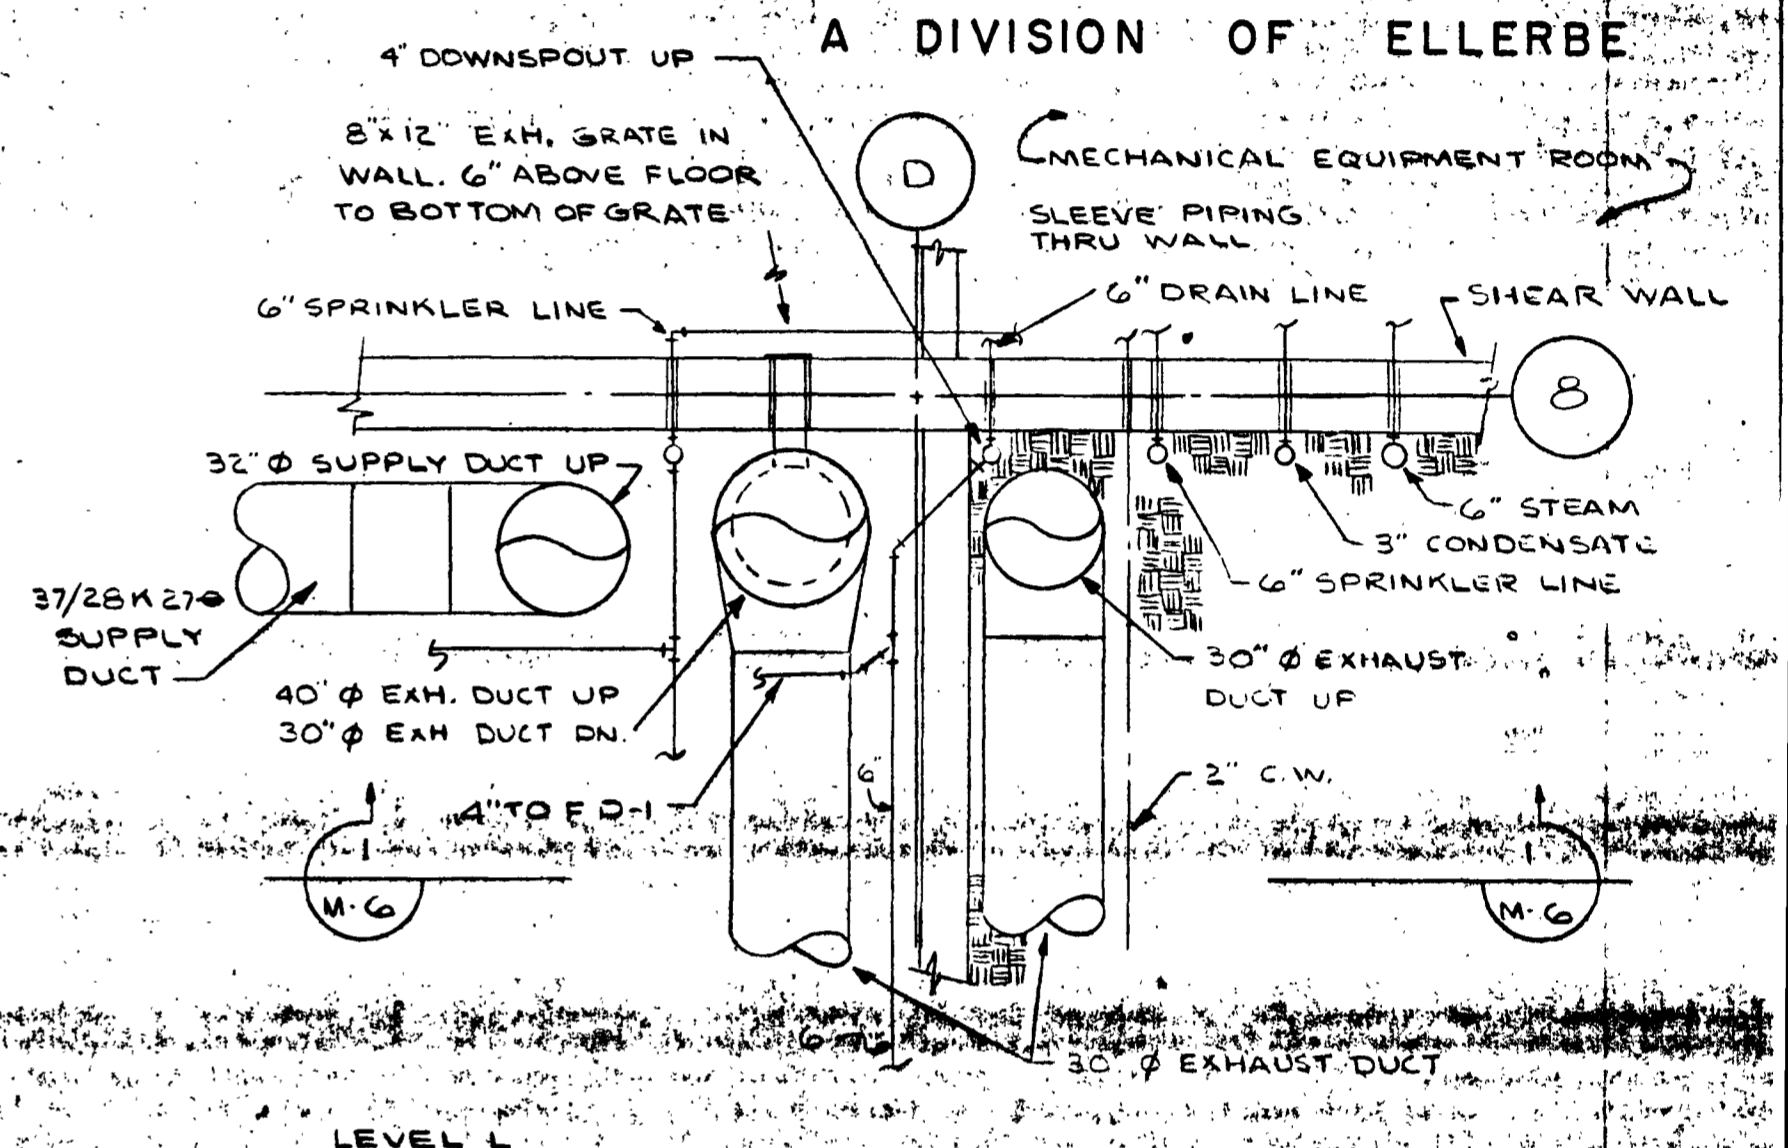


SECTION 6
SCALE 1/4" = 1'-0" M-7

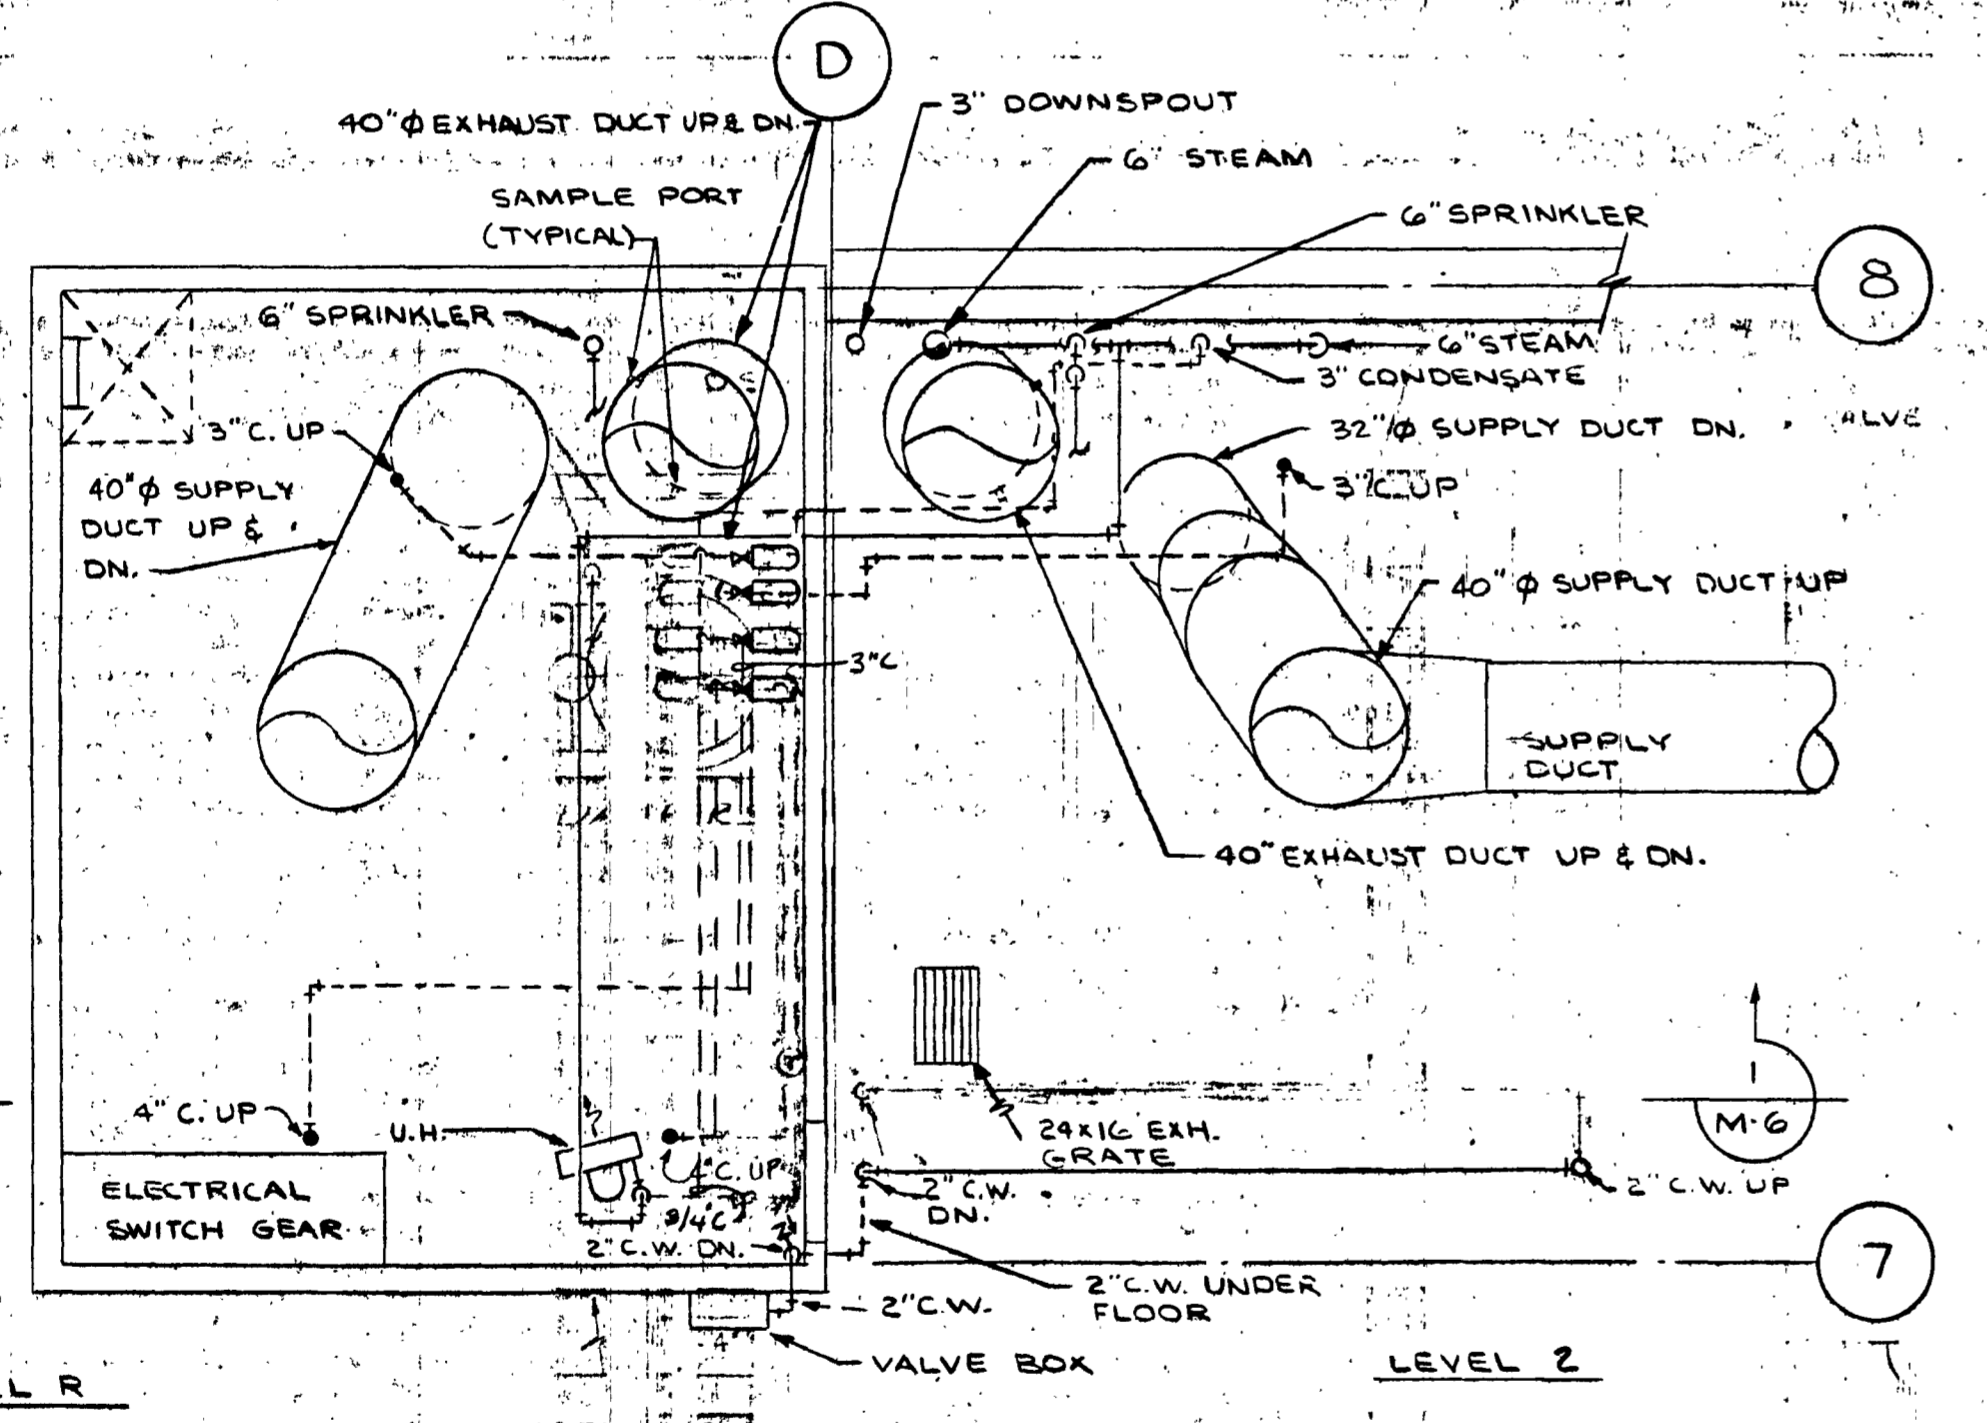

SECTION 2
SCALE 1/4" = 1'-0" M-7

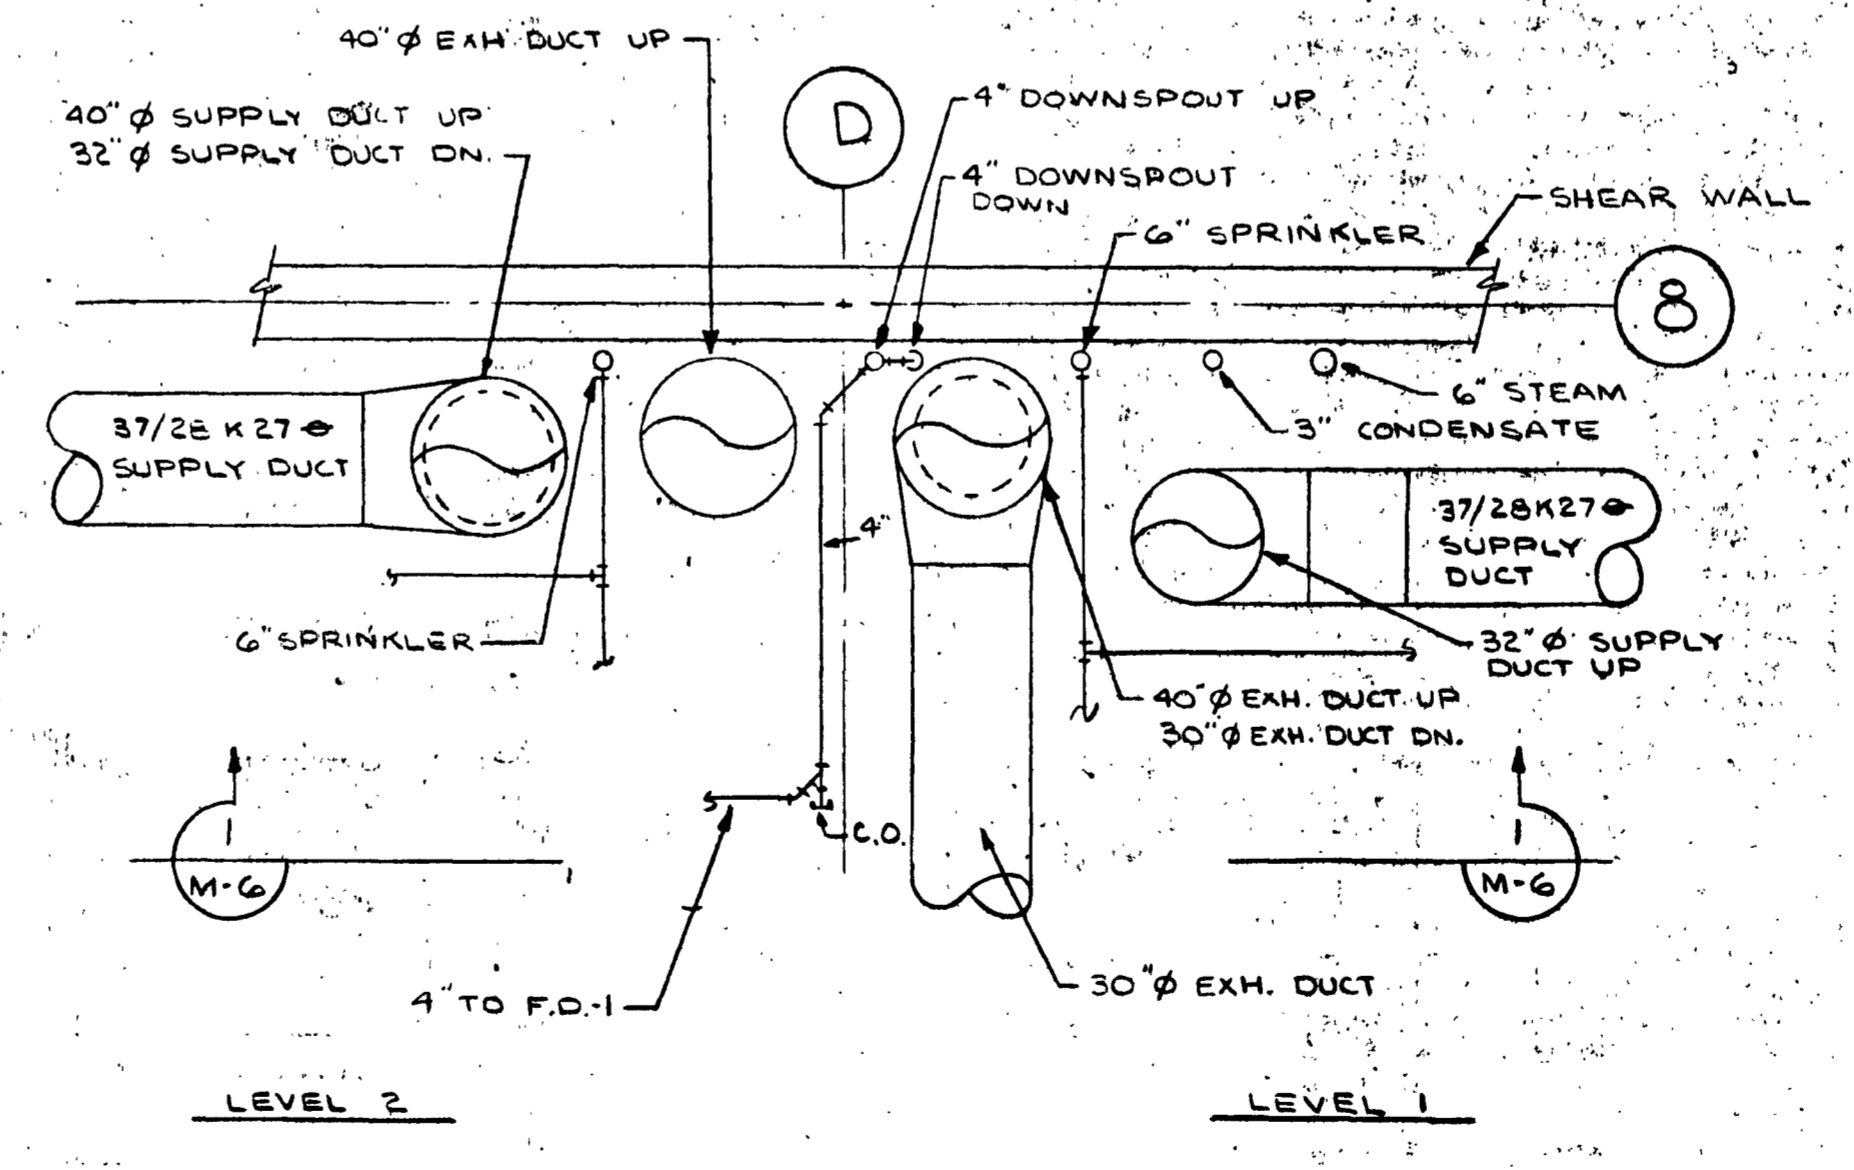

SECTION 5
SCALE 1/4" = 1'-0" M-7

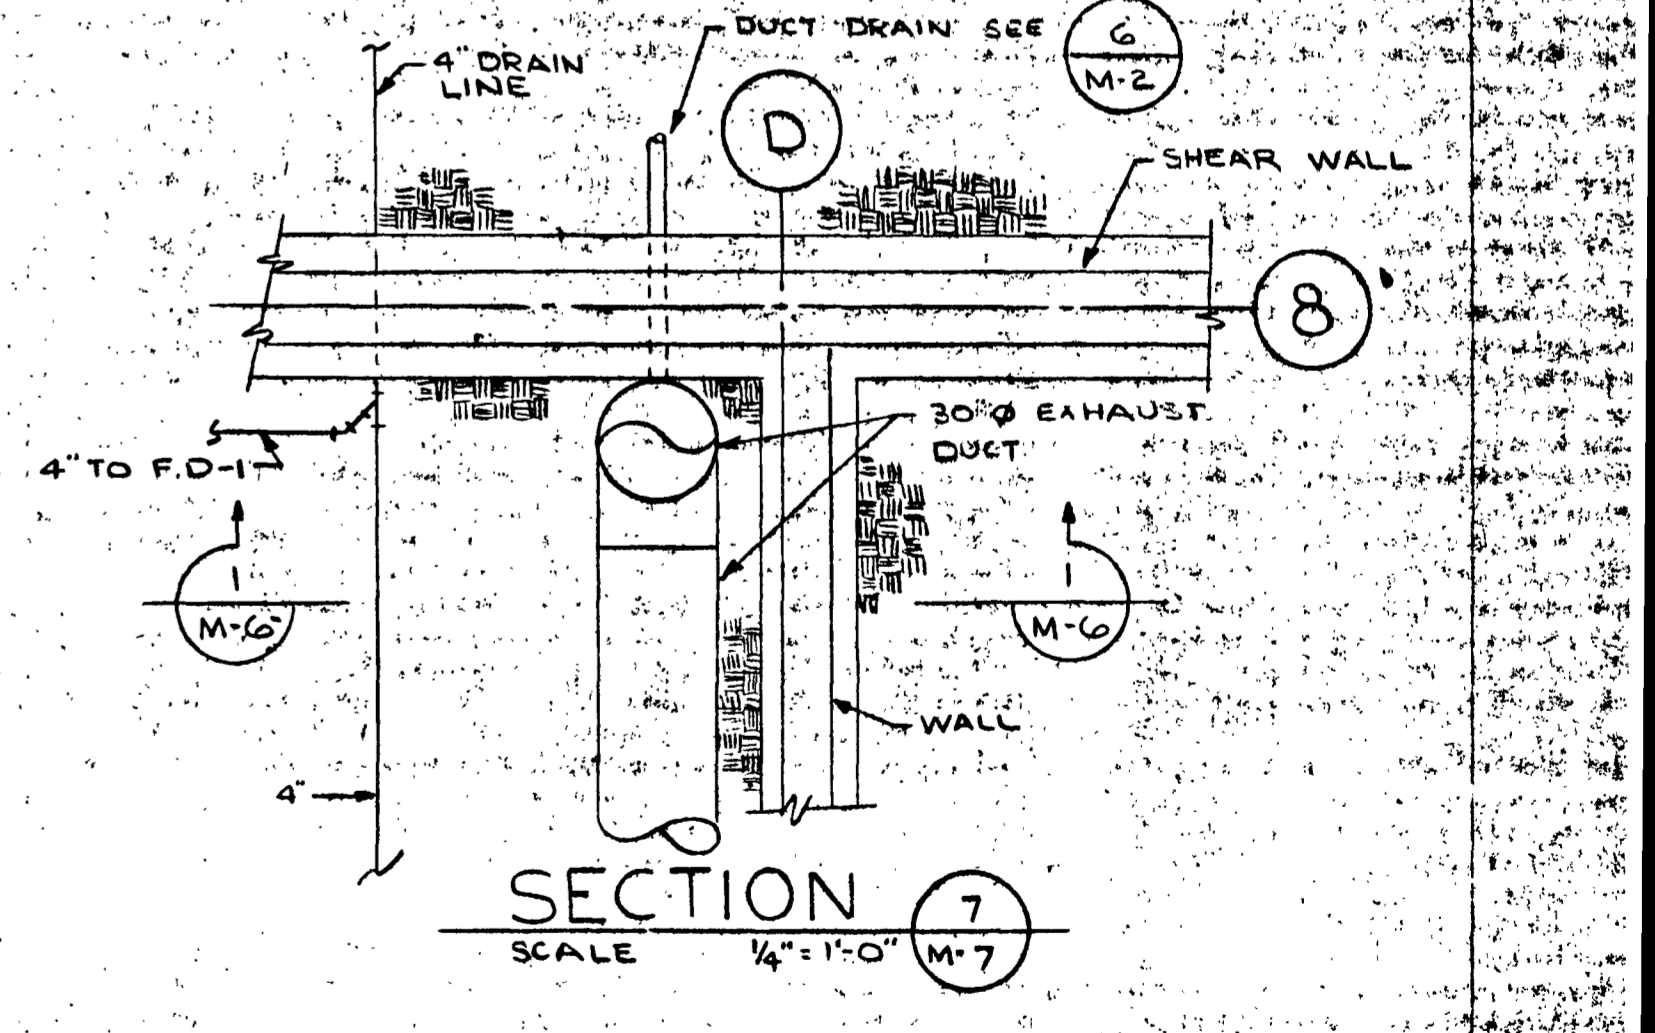

SECTION 7
SCALE 1/4" = 1'-0" M-7

NOTE: PLAN @ COL LINE 11 IS MIRROR IMAGE ABOUT COL LINE 9, 10.


ARCHITECTS • ENGINEERS • SURVEYORS
601 COLLEGE ROAD, FAIRBANKS, ALASKA 99701; PHONE: 452-1241

STATE OF ALASKA
DEPT. OF PUBLIC WORKS
DIVISION OF BUILDINGS
JUNEAU ALASKA

FAIRBANKS PARKING STRUCTURE
FAIRBANKS, AK.
DBA - 2 - 0130

PETER-KIEWIT SOMS CO.
ALASKA
AS-BLT



M-7
SHEET 42 OF 49

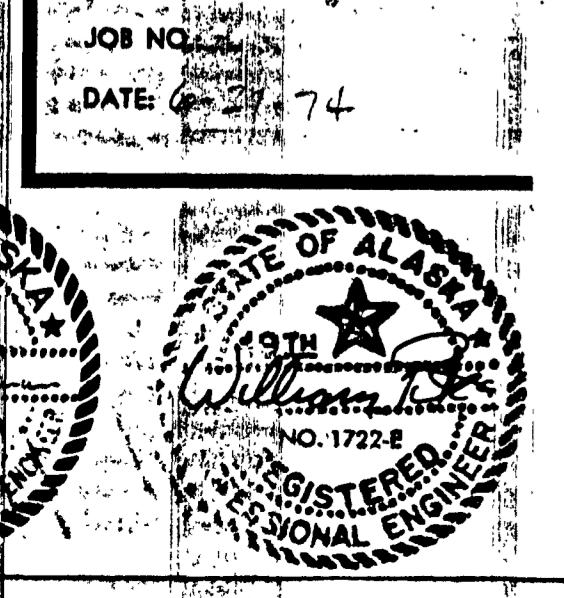


MECHANICAL EQUIPMENT SCHEDULE

SYMBOL	ITEM	CAPACITY/SIZE	MOTOR DATA	BASIS OF DESIGN	SYMBOL	ITEM	CAPACITY/SIZE	MOTOR DATA	BASIS OF DESIGN
UH-1	Unit Heater	60,500 Btuh at 2 PSI Steam & 60°F EAT	1/2 HP 1550 RPM 120 Volts	Trane 60S Dunham Bush H250C (4 req'd)	SP-1	Duct Drain Sump Pump	30 GPM at 20' Head Submersible pump w/ auto level control	1/3 HP 120 Volt 1 Phase	Pacific Pumping ASNI 3
RT-1	Fin Tube Radiation	1-1/4" x 4-1/4" x 32 Expanded metal cover, 877 Ptu/foot, 180° AW		Sterling Type X S 143 element	SP-2	Floor Drainage Sump Pump	81 GPM at 20' Head, Submersible pump w/ auto level control and mechanical alternator.	3/4 HP 460 Volt 3 Phase	Pacific Pumping MS7 duplex set.
RT-2	Fin Tube Radiation	1-1/4" x 4-1/4" x 32 Stepped for one row cover, 870 Ptu/foot, 180° AW		Sterling Type S S 143 element	EF-1 EF-2 EF-5 EF-6	Exhaust Fans	37,500 CFM 0°F air each at 2.5" SP. Controllable pitch. Flow trial up.	30 HP 460 Volt 3 Phase 1150 RPM Explosion Proof	Jov Axivane 45-26 1170 Series 1000 (4 req'd) FOUR
CUH-1	Cabinet Unit Heater	102,378 Btuh 1800 CFM nom Inverted Flow 220° EGT 60° EAT	120 Volt 1 Phase 3 Speed	Trane Model M46A018 with G3TWPC Motor	SF-1 thru SF-4	Supply Fans	41,250 CFM 0°F air each at 2.5" SP. Controllable pitch. Flow vertical down Inlet bell & screen	40 HP 460 Volt 3 Phase 1170 RPM	Jov Axivane 42 1/4-17-1770 Series 2000 (4 req'd)
CUH-2	Cabinet Unit Heater	31,000 Btuh 300 CFM nom Inverted Flow Fully insulated, 220° EGT 60° EAT	120 Volt 1 Phase 3 Speed	Trane Model N46A003 with G3TWPC Motor	IFB-1 IFB-2 IFB-5 IFB-6	Make-up Air Heating Coils	41,250 CFM each 46.5 sq. ft. face area EAT = 60°F LAT = +36°F 30 PSI steam Integral face and bypass dampers.		Wing VFB size VE8T (4 req'd)
CUH-3	Cabinet Unit Heater	45,000 Btuh 600 CFM nom Inverted Flow 220° EGT 60° EAT	120 Volt 1 Phase 3 Speed	Trane Model M46A006 with G3TWPC Motor	IFB-11 IFB-12 IFB-13 IFB-14	Recirculating Air Heating Coils	10,000 CFM each 13.5 sq. ft. face area EAT = 0°F Lat = 50°F 30 PSI steam Integral face and bypass dampers		Wing VFB Size VD-3 (6 req'd) 4
CUH-4	Cabinet Unit Heater	86,166 Btuh 1300 CFM nom Inverted Flow 220° EGT 60° EAT	120 Volt 1 Phase 3 Speed	Trane Model M46A013 with G3TWPC Motor		Exhaust Discharge Floods	37,500 CFM Upblast discharge. Integral low leakage back draft dampers. Pre-fabricated, insulated metal curb. For 48" duct.		Pann Hi-Ex cap w/ Uni-Beam curb.
CUH-5	Cabinet Unit Heater	129,000 Btuh 1800 CFM nom Inverted Flow 220° EGT 60° EAT	120 Volt 1 Phase 3 Speed	Trane Model M46A018 with G3TWPC Motor		Fl. Tank	15 PSI ASME construction central tank, 42" diameter, 28" high. Pmg. base.		National, A.C.
	Steam Heating	53 GPM glycol	3/4 HP		ACD	Air Curtain Door	8' 2 1/2" High x 17' 10 1/2" Wide door opening, 14000 CFM each. Without heating coil.	4 1/2 HP 460 Volts 3 Phase	Disco In-wall Model with door switch (two req'd)
CP-2	Heating Pump	37 GPM glycol at 25 ft head. Size 1-1/2"AA, 1-1/2" pipe size.	1/2 HP, 460 Volt 3 Phase	B&G 60-13T	CONVERTER		37 GPM EGT 200°F LGT 220°F 100% STEAM IN SHELL 32 sq. ft. HEATING SURFACE, FOUR PASS		B&G SU 84-4
PRV-1	Pressure Reducing Valve	3/4" pipe size Set at 12 PSI discharge		B&G #12	Compression Tank		100 Gallon ASME tank with gage glass, tank fitting and tank drainer.		B&G
PRV-2	Domestic Water Pressure Reducing Valve	3/4" Pipe Size with strainer		Wilkins 500YS	Condensate Pump		Duplex Set 60 GPM ea. 200° condensate, 25 PSI discharge, 100 Gallon cast iron receiver. Mechanical alternator and float switch.	2 HP 460 Volt 3 Phase	Pacific Pumping GRD 412MD20P
PRV-3	Steam Pressure Reducing Valve	350 PPH 40 PSI inlet 15 PSI outlet 1-1/4" valve CV=11		Sarco 25P	Air Eliminator		In-line type, 185 GPM max. flow 3" pipe connections.		B&G IAF-3
EWB	Electric Water Heater	20 Gallon cap. Glasslined steel tank, 5 yr warranty.	2000 Watt 120 Volt 1 Phase	National NSG-20					


GRAY ROGERS MYERS & MORGAN
A DIVISION OF ELLERBE

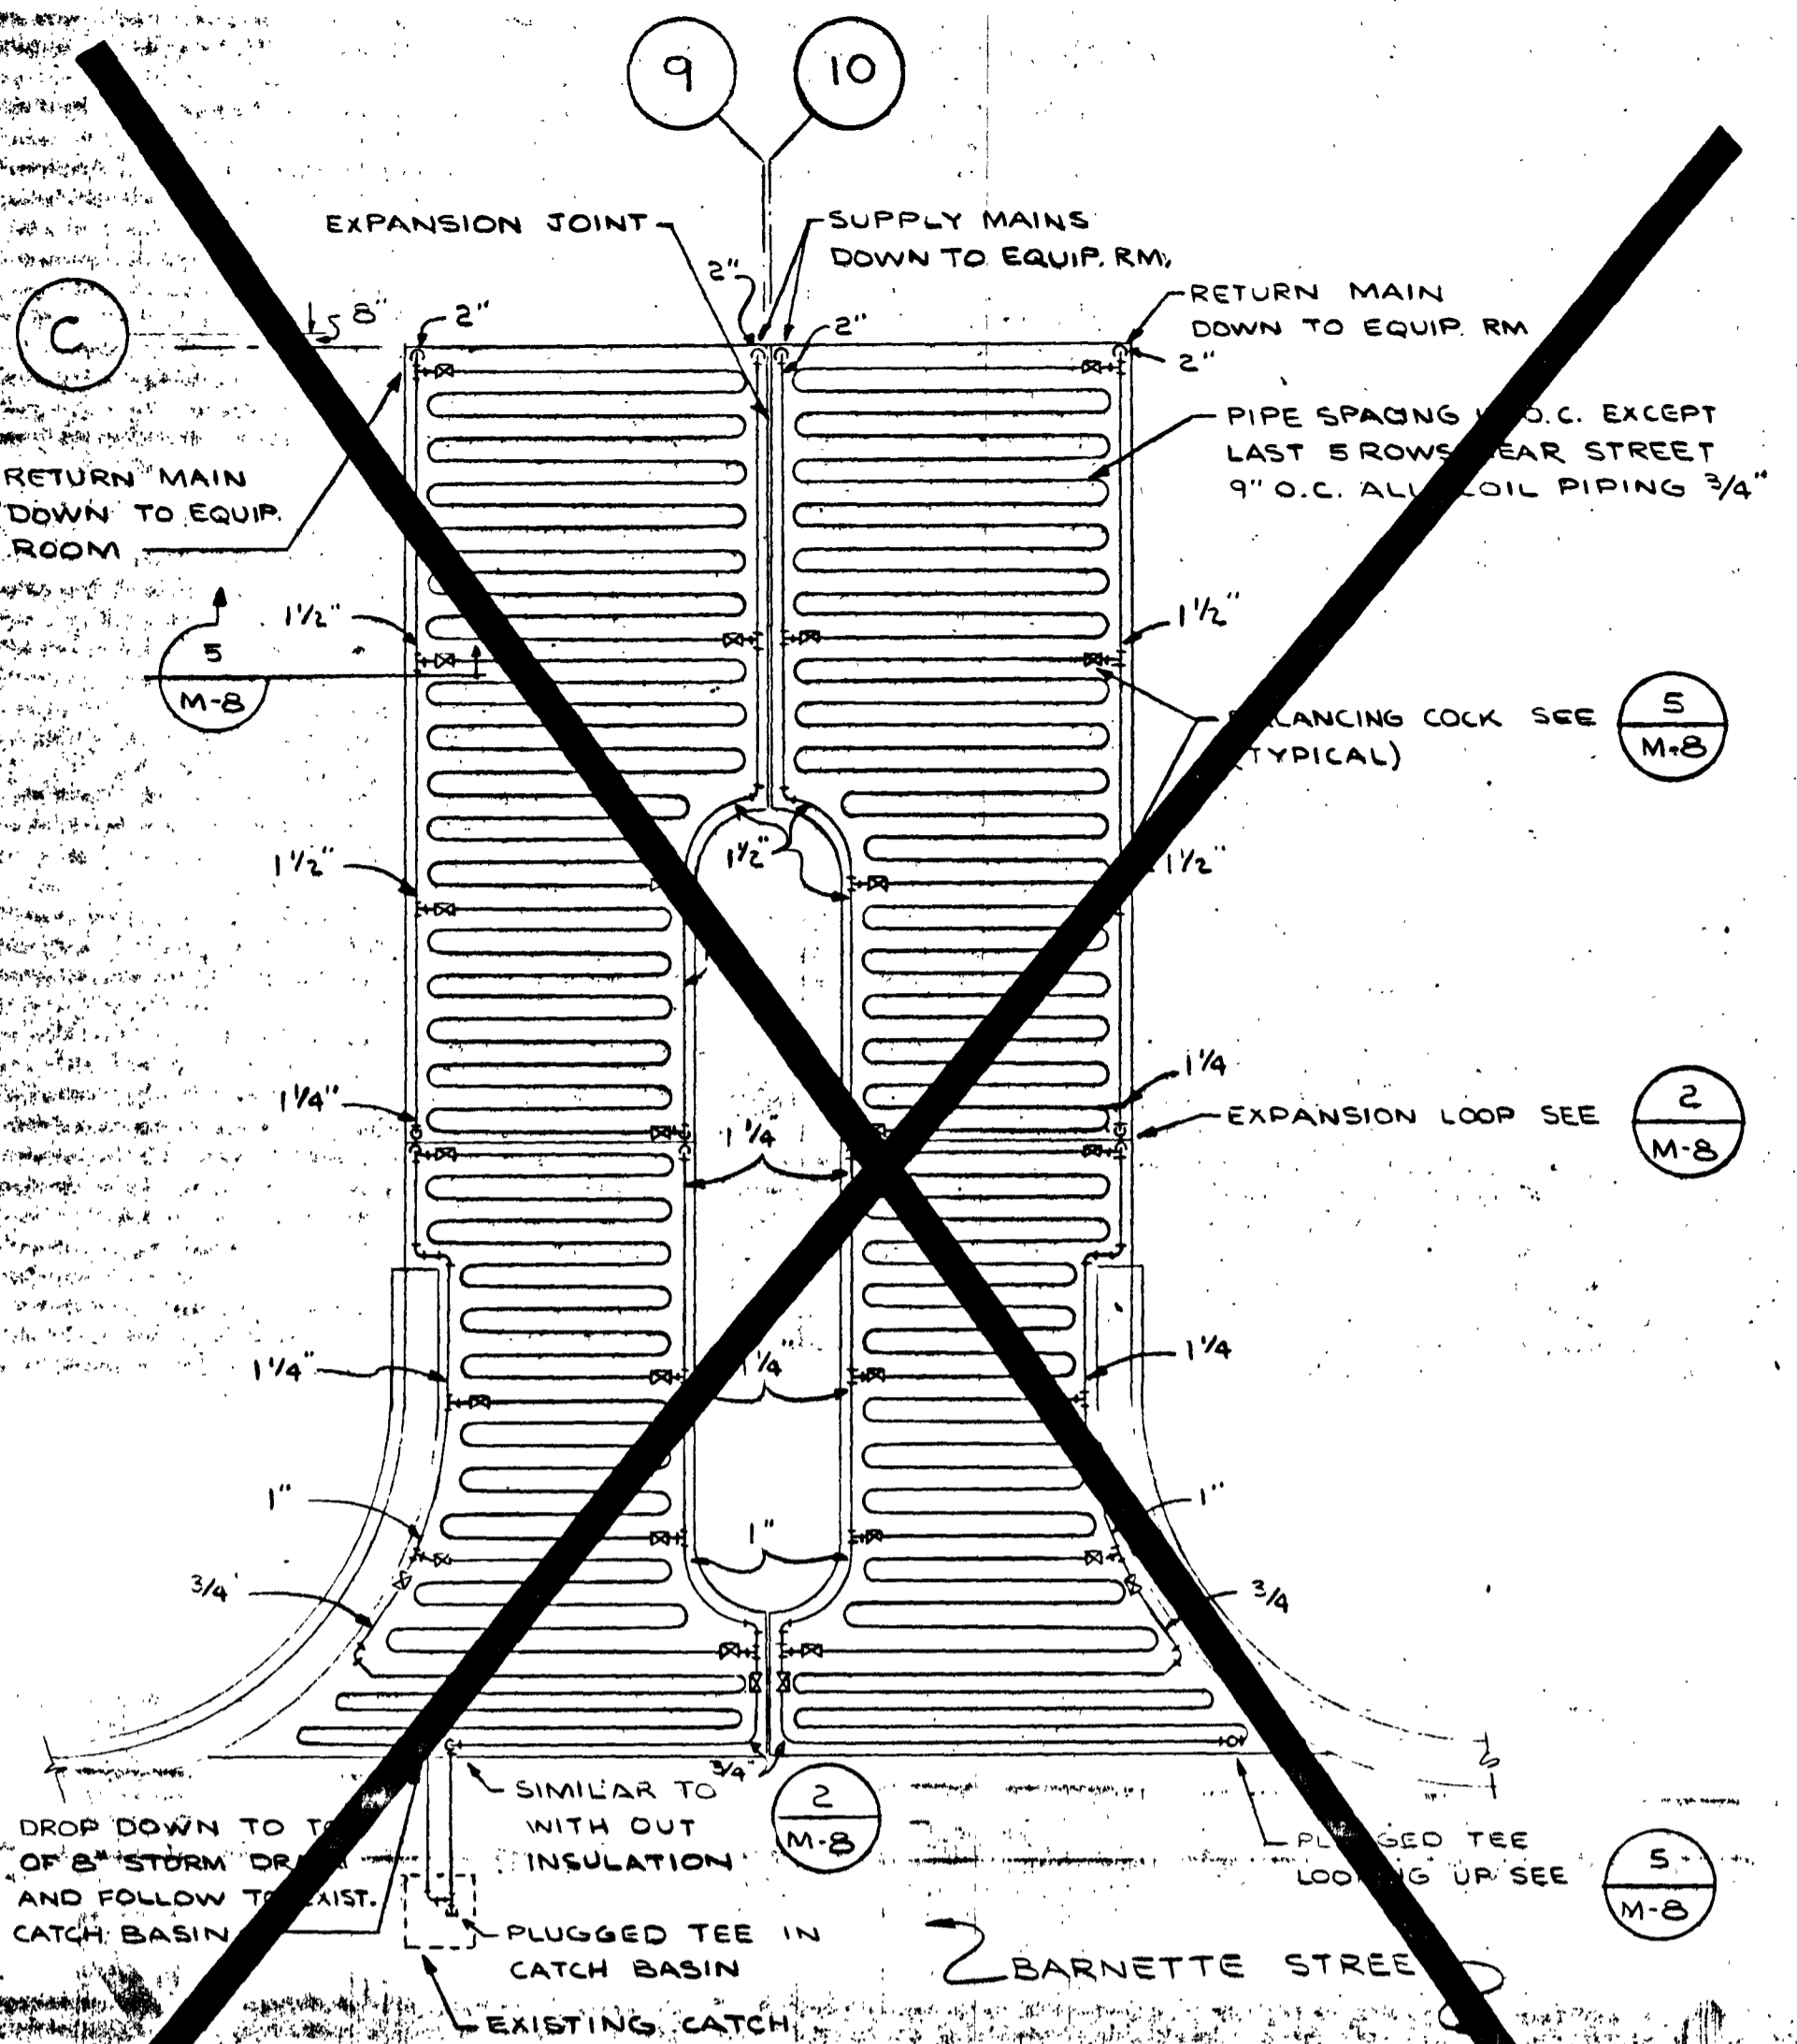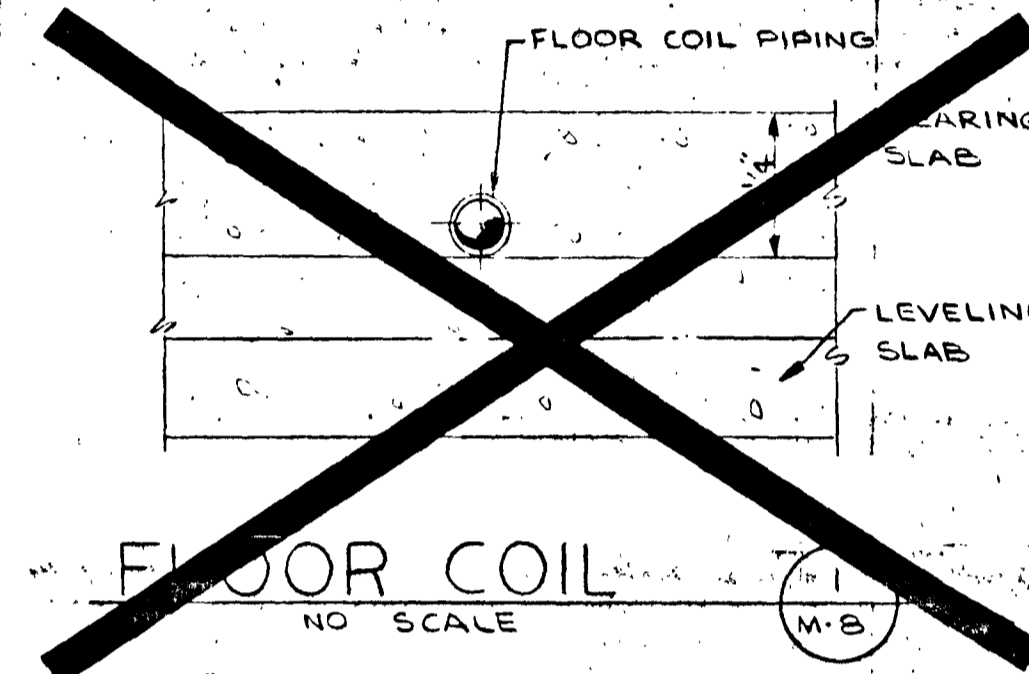


SNOW MELTING PIPING PLAN
SCALE 1/8" = 1'-0"

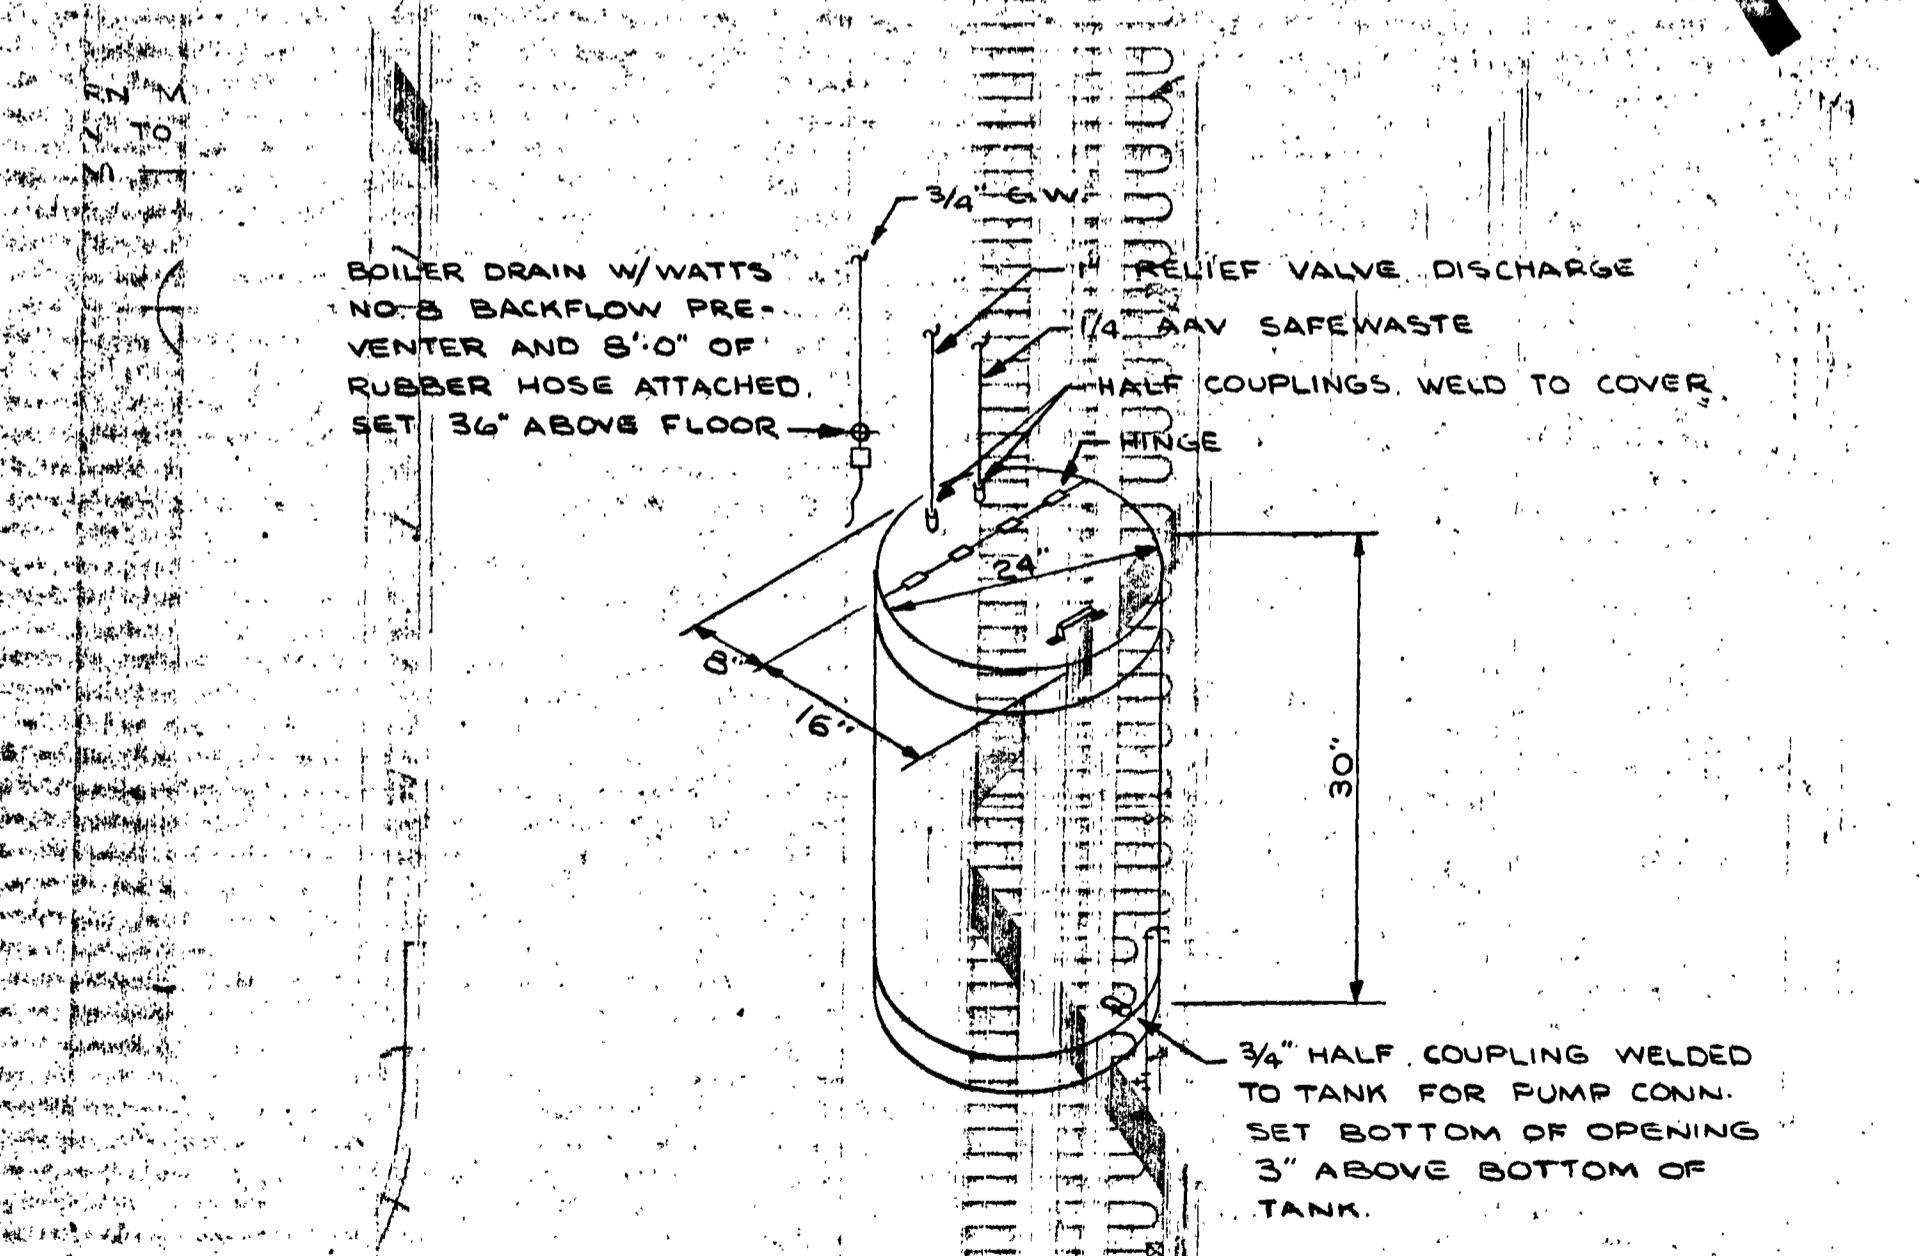


GLYCOL MIXING TANK
NO SCALE

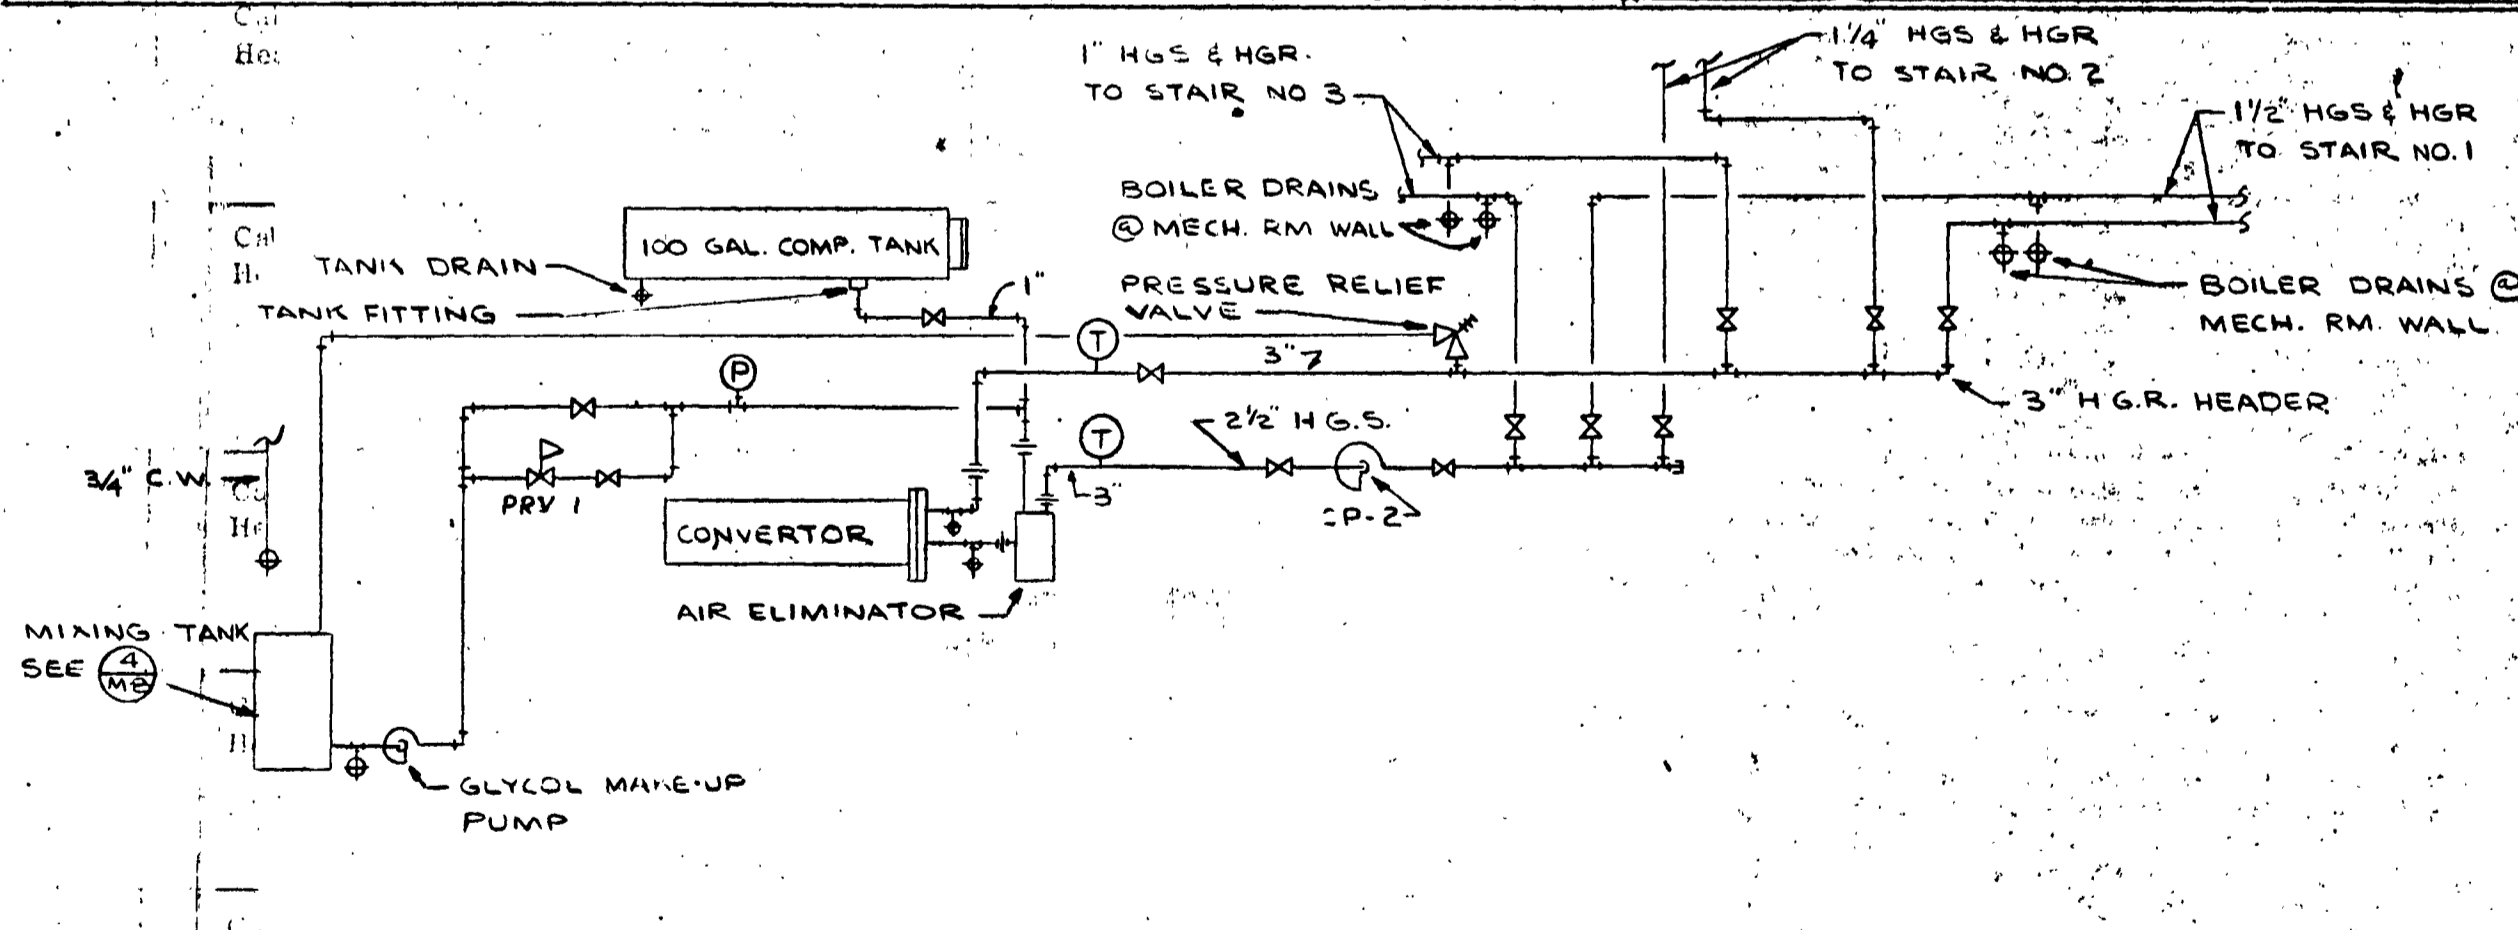

GLYCOL PIPING SCHEMATIC
NO SCALE

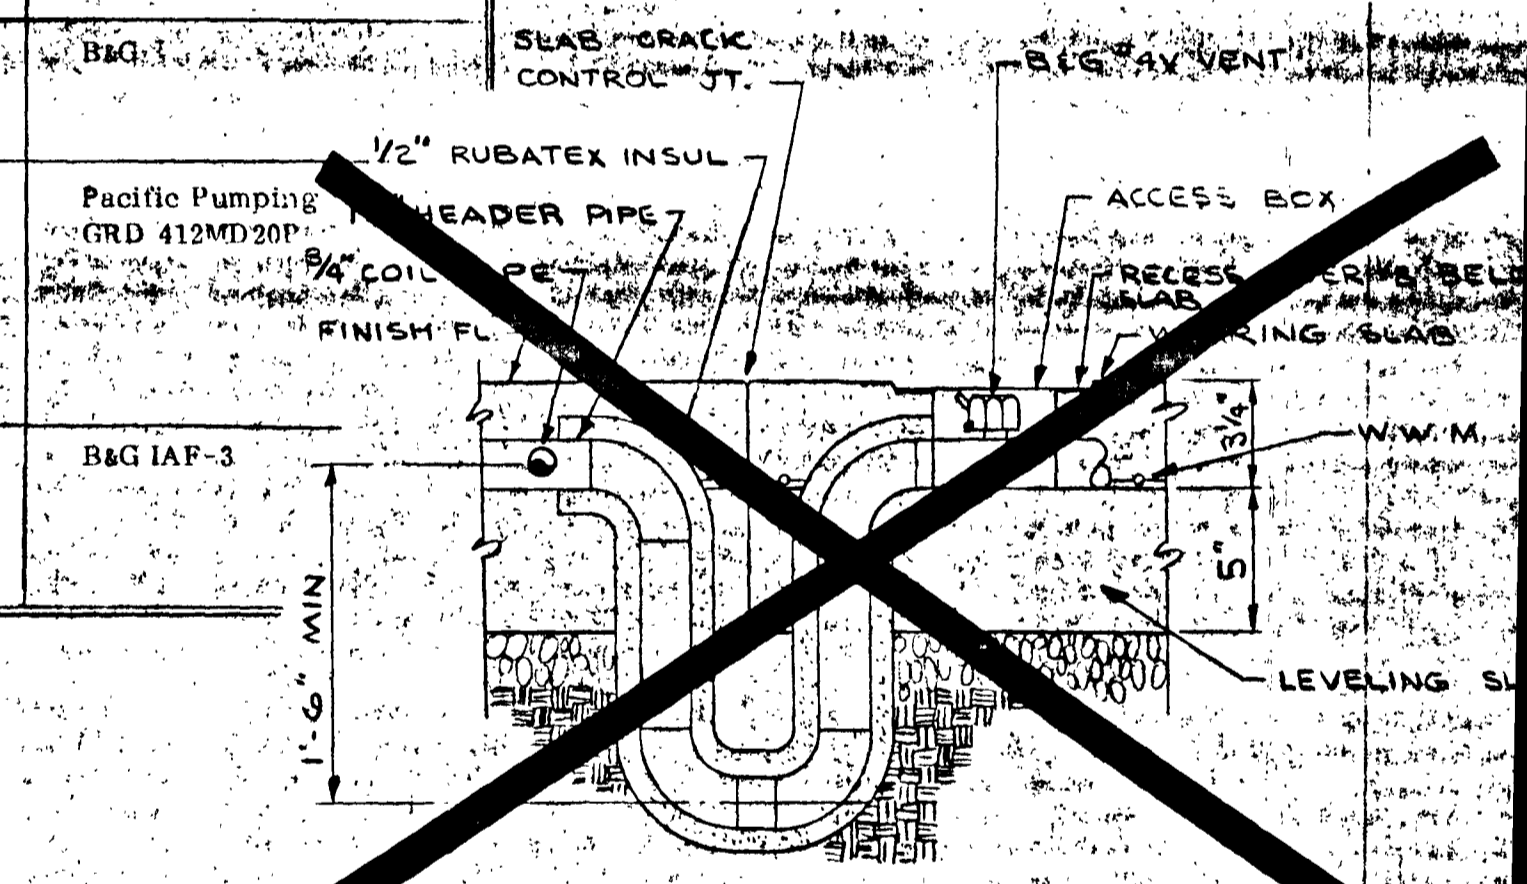

FLOOR COIL EXPANSION LOOP
NO SCALE

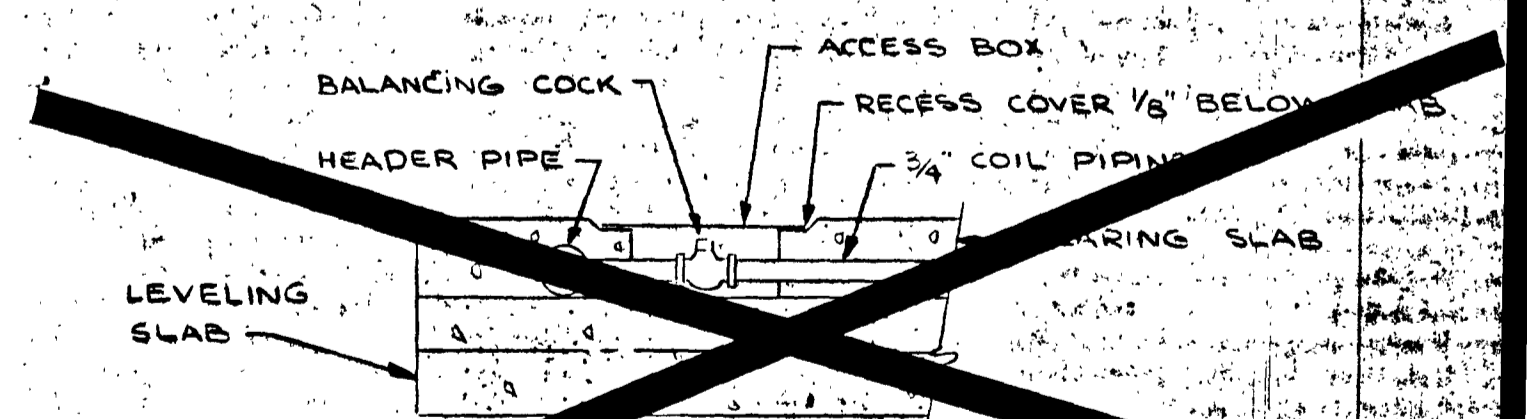

BALANCING COCK ACCESS
NO SCALE


ARCHITECTS - ENGINEERS - SURVEYORS
601 COLLEGE ROAD, FAIRBANKS, ALASKA 99701, PHONE: 452-1241

STATE OF ALASKA
DEPT. OF PUBLIC WORKS
DIVISION OF BUILDINGS
JUNEAU ALASKA

FAIRBANKS PARKING STRUCTURE
FAIRBANKS, AK.
DBA - 2 - 0130



WATER POWER SOFT CO.
FAIRBANKS ALASKA
DATE: 12/17/74
AS-BLT
SHEET 43 OF 74

M-8

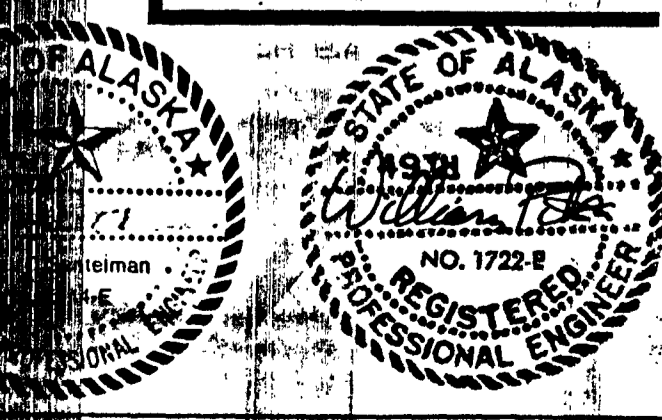


GRAY ROGERS MYERS & TORGAN

A DIVISION OF ELLERBE

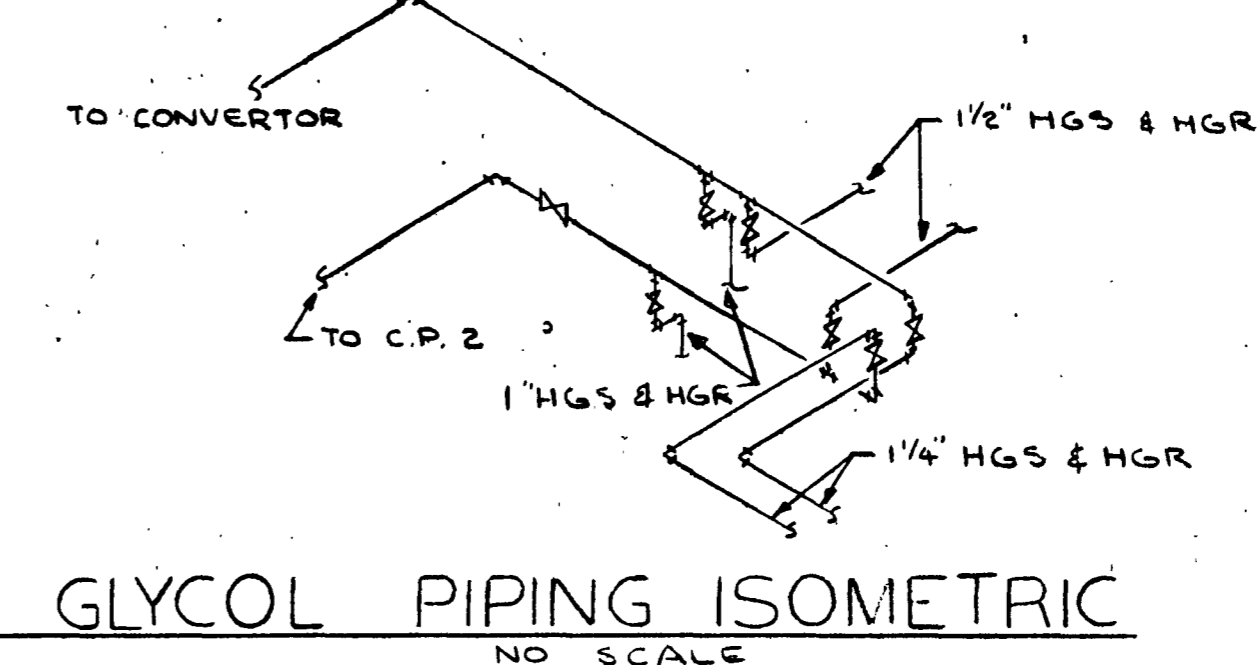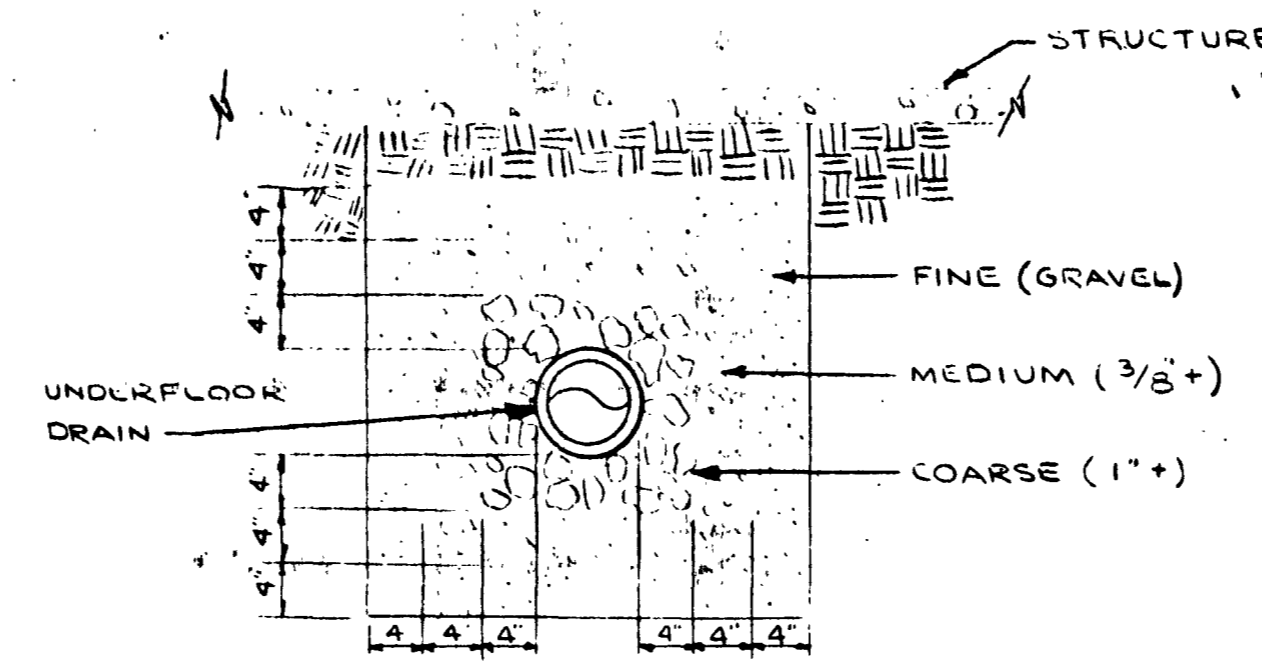


SECTION 3
NO SCALE
M-10

GLYCOL PIPING ISOMETRIC
NO SCALE

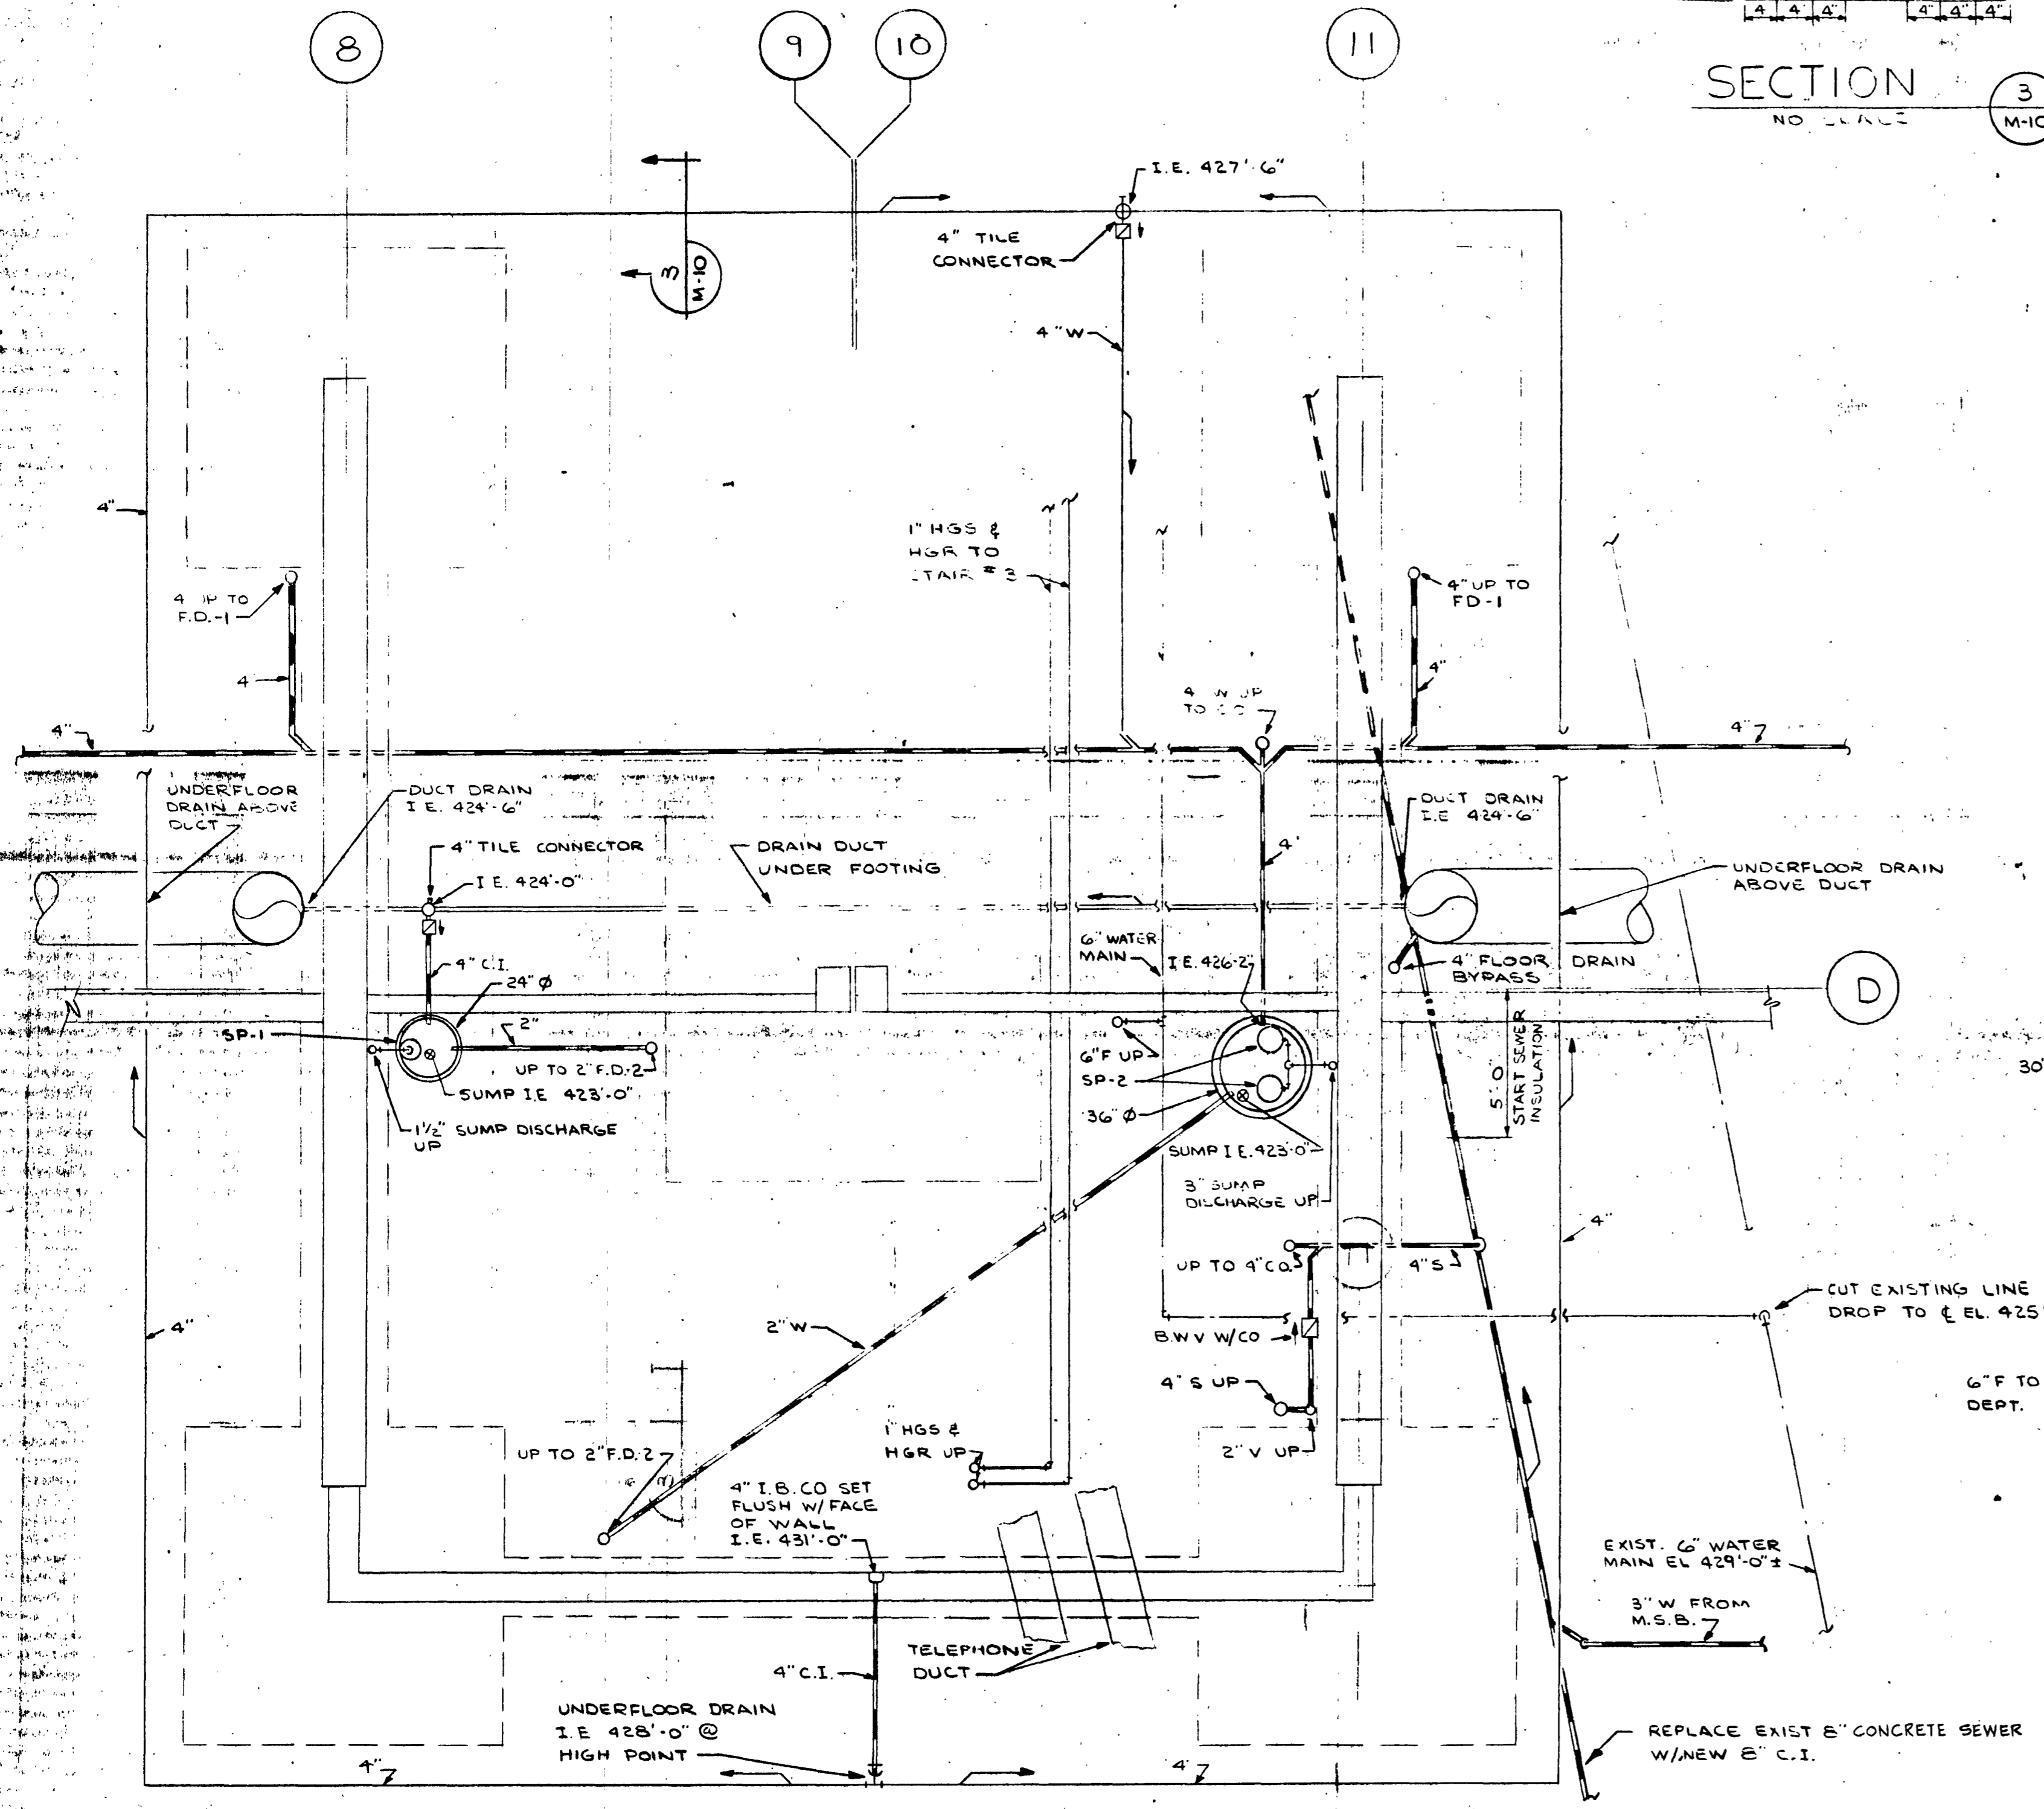

FOUNDATION PLAN 2
SCALE 1/4\"/>

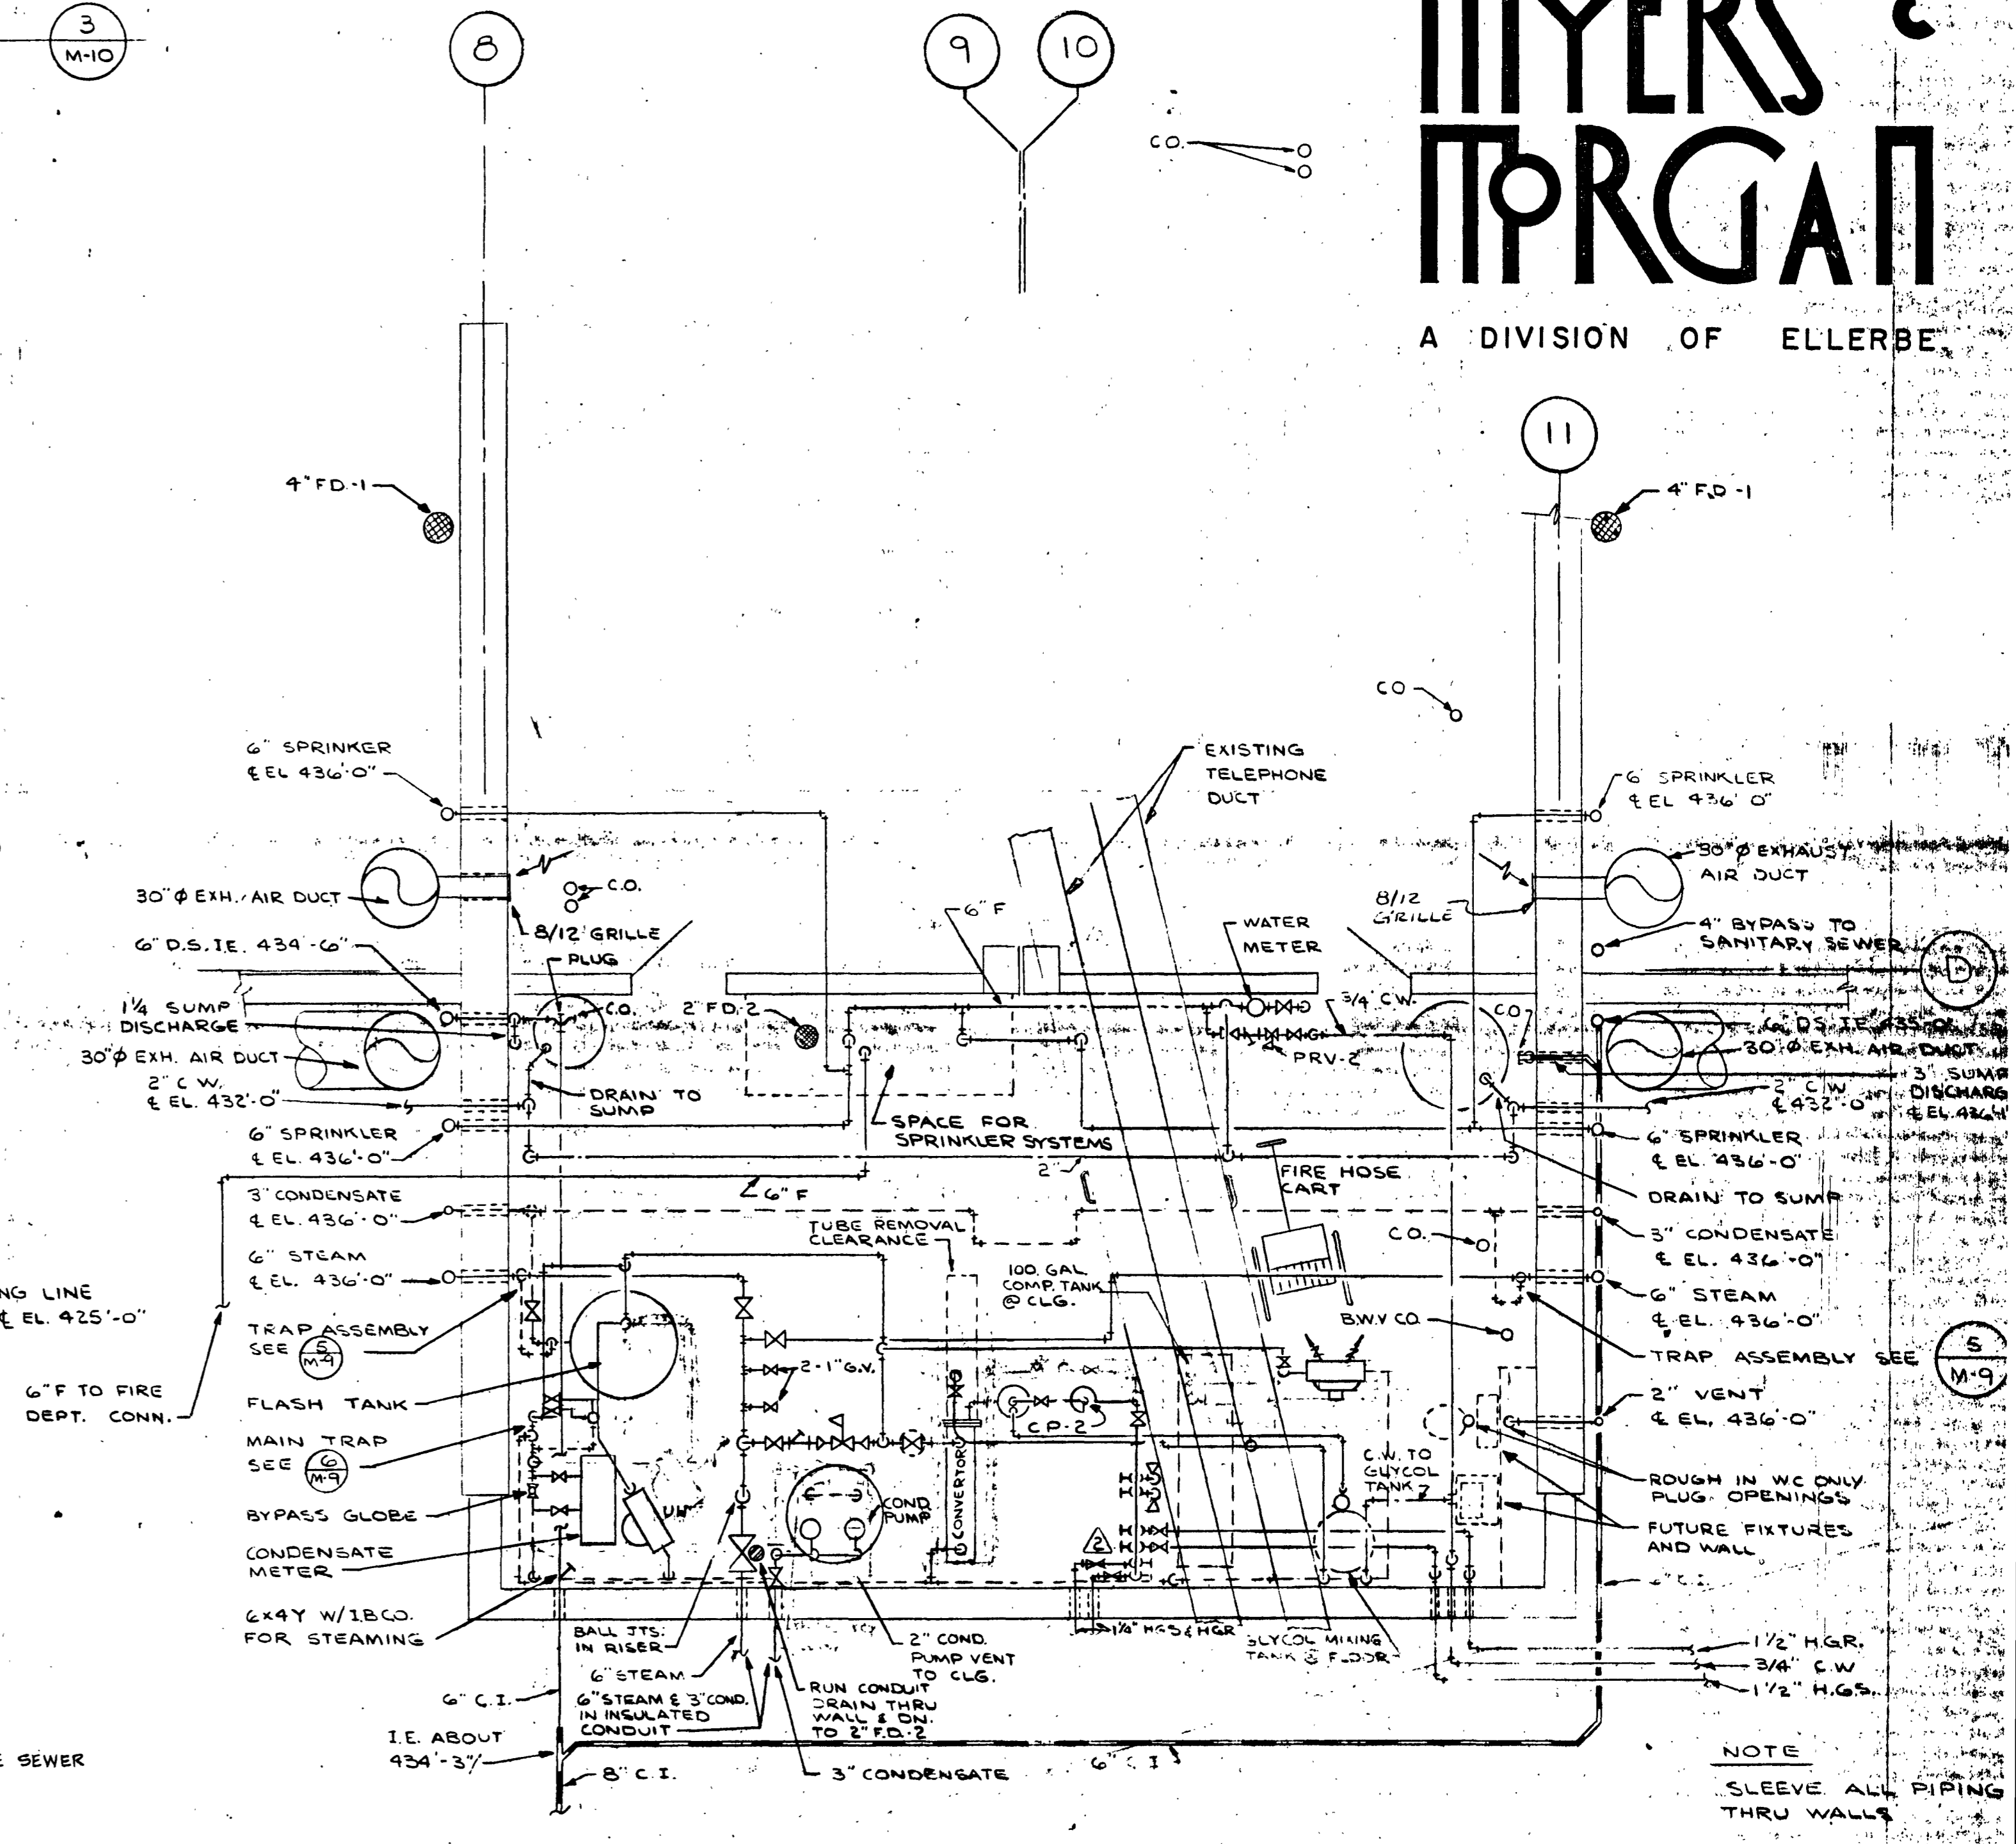

MECHANICAL EQUIPMENT ROOM 1
SCALE 1/4\"/>

JOB NO. 7313-734
DATE 6-27-74


ARCHITECTS • ENGINEERS • SURVEYORS
601 COLLEGE ROAD, FAIRBANKS, ALASKA 99701, PHONE: 452-1241

STATE OF ALASKA
DEPT. OF PUBLIC WORKS
DIVISION OF BUILDINGS
JUNEAU ALASKA

FAIRBANKS PARKING STRUCTURE
FAIRBANKS, AK.
DBA - 2 - 0130


LEVEL L MECHANICAL ROOM PLANS

ROTOR PUMP SYSTEMS CO.
DATE: 6/27/74
SHEET 45 OF 49
M-10

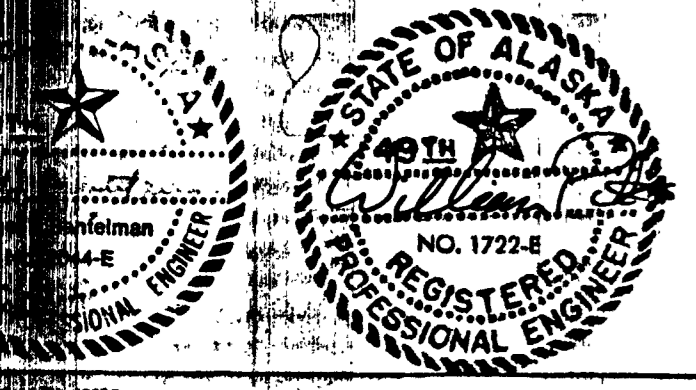


GRAY ROGERS MYERS & ORGAN

A DIVISION OF ELLERBE

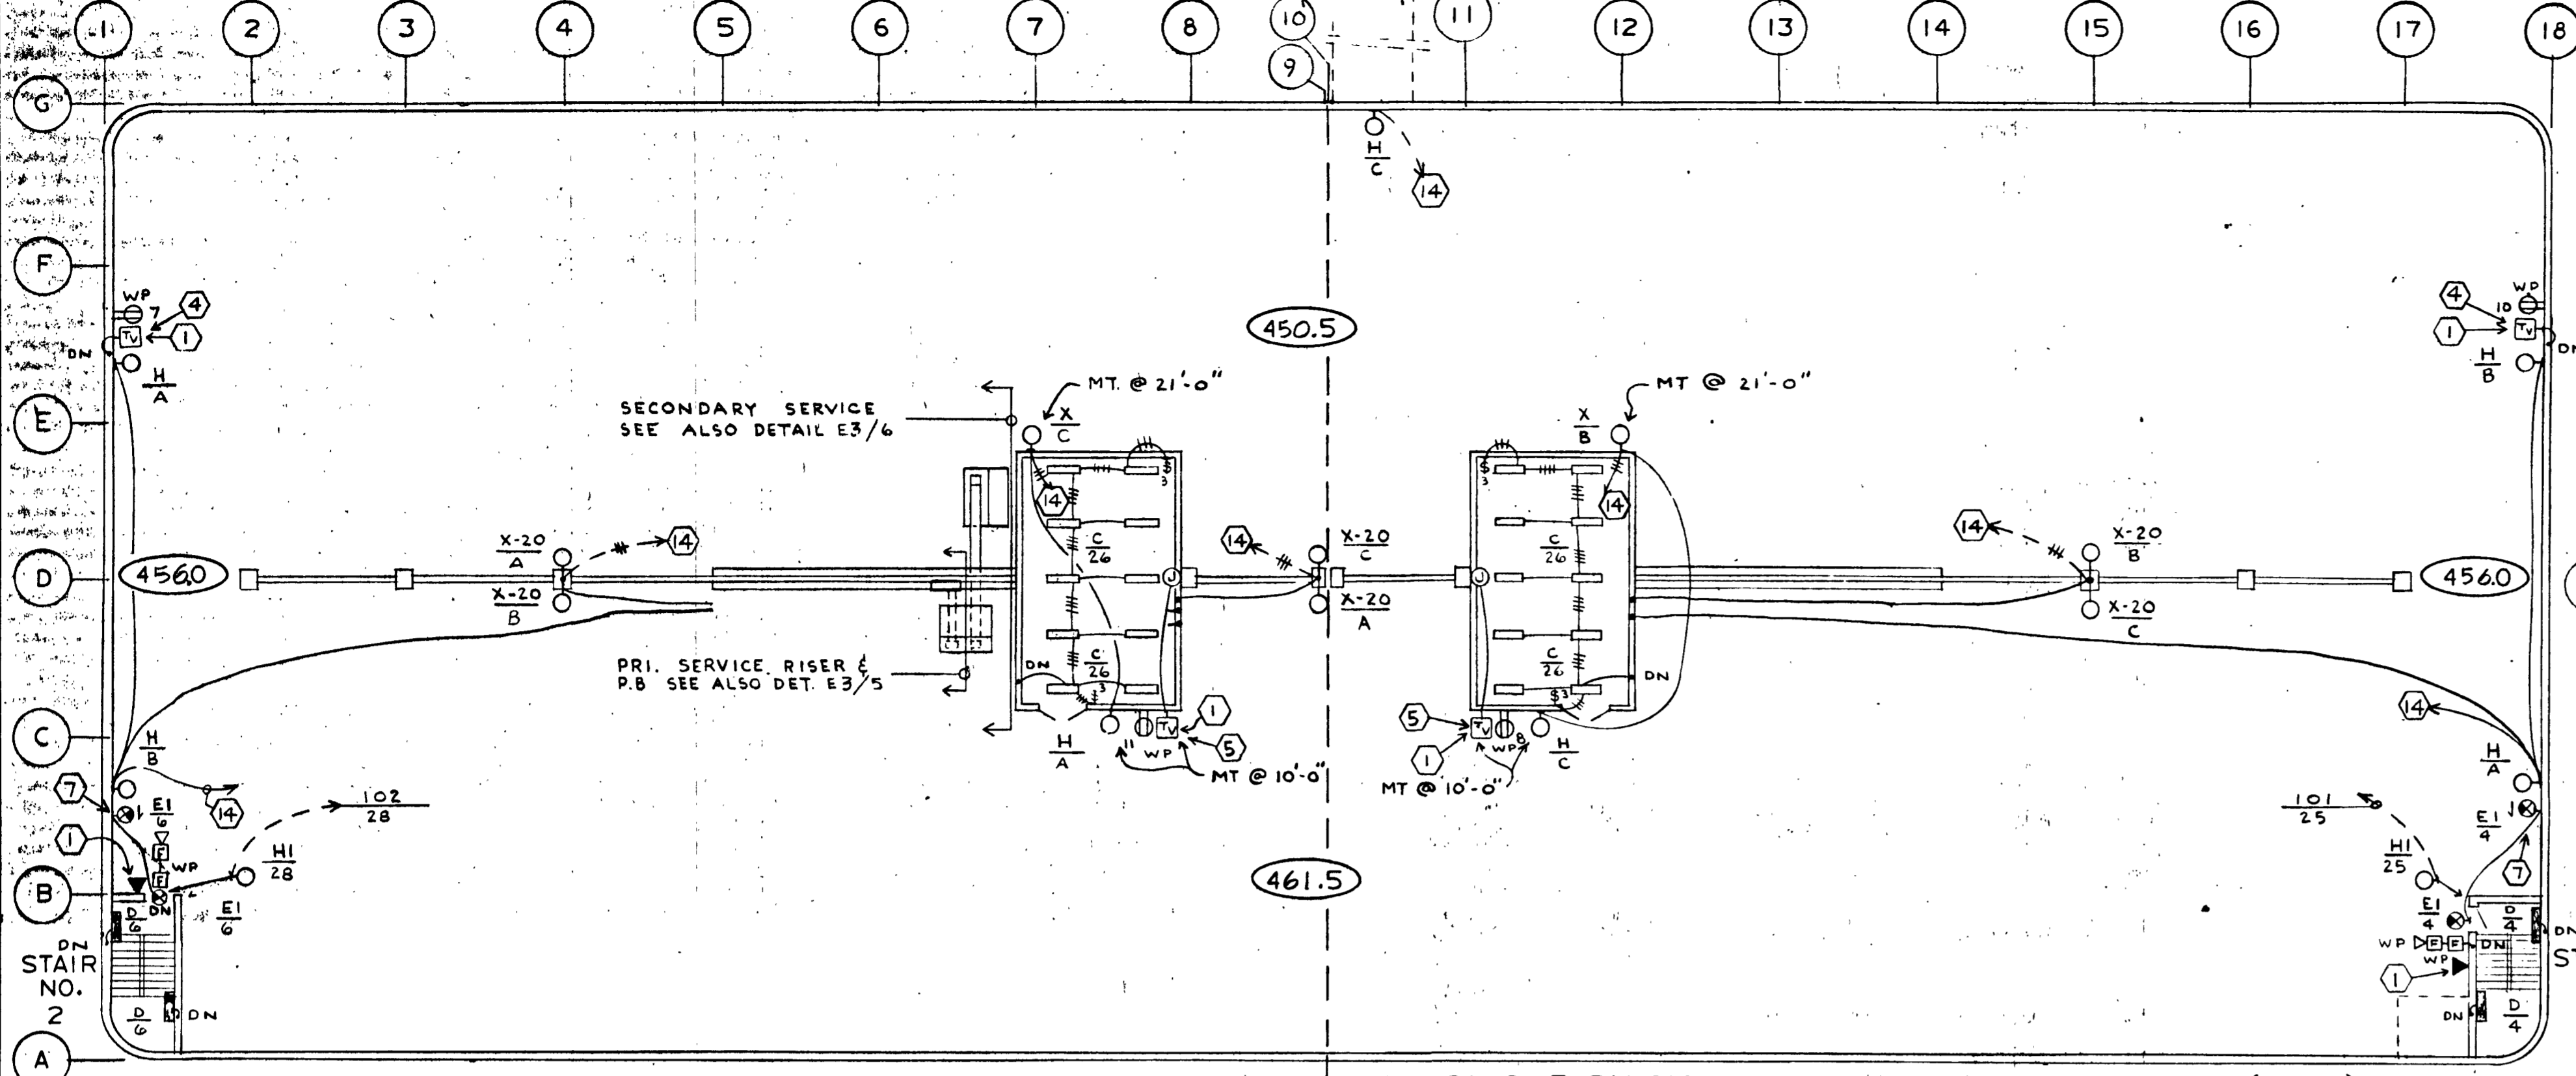

LEVEL R (ROOF) PLAN
FUTURE 3RD LEVEL

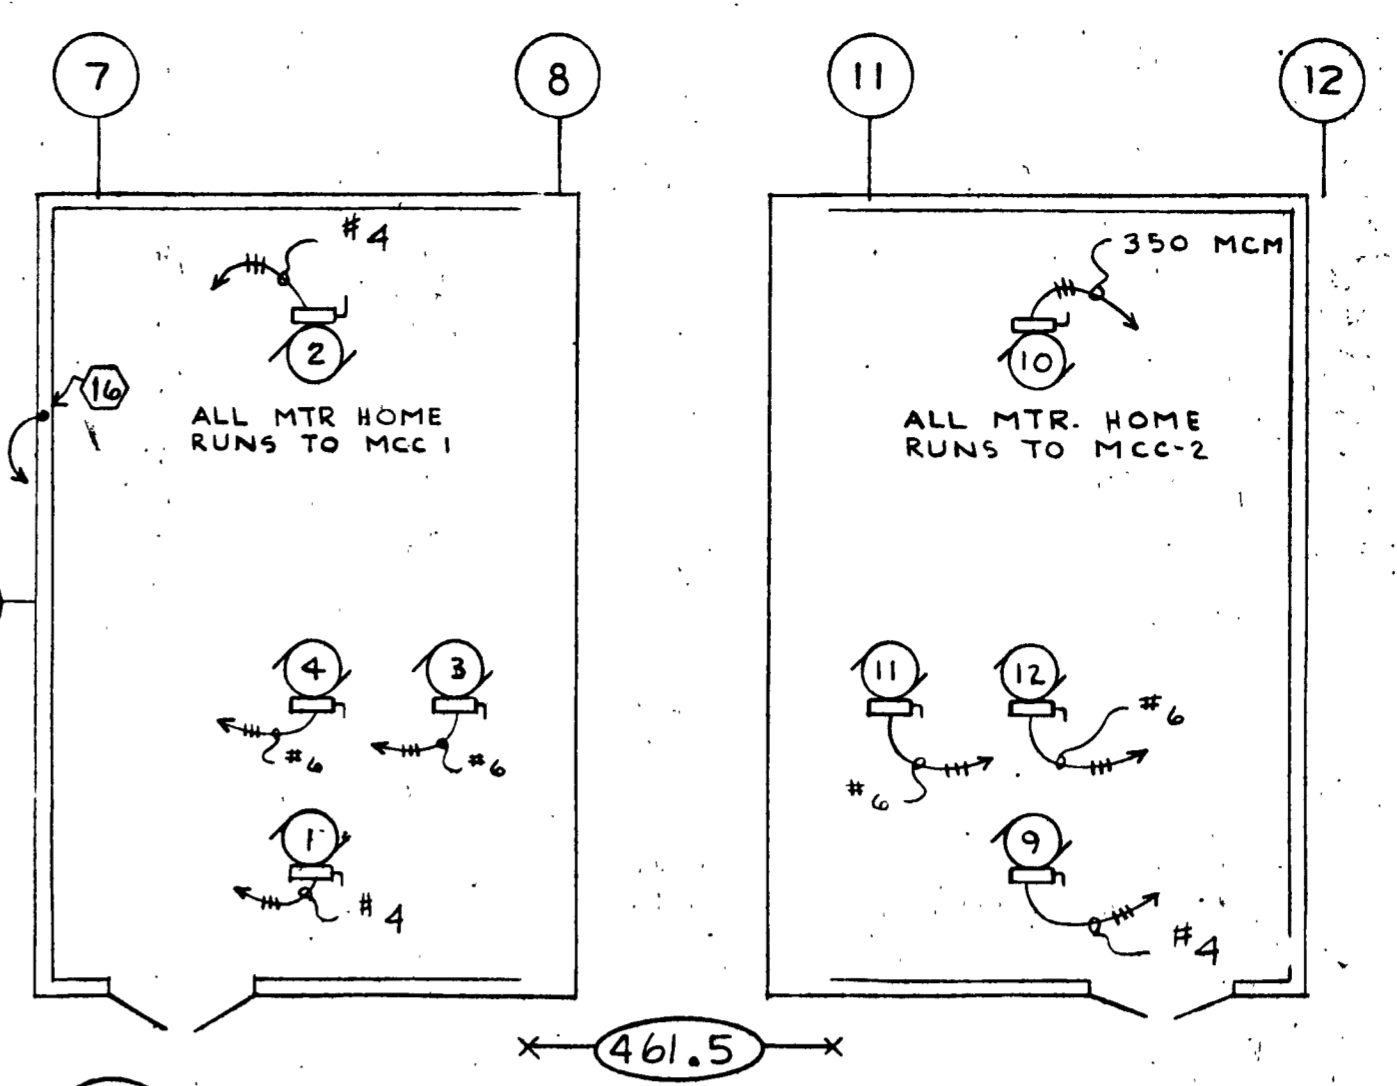



E2 ROOF LEVEL MECHANICAL ROOMS
SEE ALSO ROOF PLAN SCALE 1/8" = 1'-0"

ELECTRICAL NOTES CONTINUED


- (1) JUNCTION BOX NEAR CEILING RUN 1 1/2" EMT CONDUIT UP TO PANEL 102 FOR FUTURE PRIVATE LIGHTING.
- (2) 2000 WATT 120V HOT WATER HEATER, RUN 3/4" - 2 # 10 TO PANEL 102.

ELECTRICAL NOTES

- (1) PROVIDE BLANK WEATHER PROOF COVER.
- (2) UN-ITTED.
- (3) OMITTED.
- (4) INSTALL OUTLET IN FACE OF BEAM RUN CONDUIT IN COLUMN OR SHEAR. WALL MOUNT AT 8'-6".
- (5) INSTALL CAST PD TYPE SURFACE OUTLET ON METAL PANEL WALL.
- (6) INSTALL OUTLET IN FACE OF COLUMN RUN CONDUIT IN COLUMN. MOUNT AT 8'-6".
- (7) EXIT LIGHT TO BE MOUNTED ON FACE OF BEAM.
- (8) 1/2" - 2 # 12 DOWN TO ANNUNCIATOR RELAY PANEL IN LOWER MECHANICAL ROOM.
- (9) PROVIDE FLOOR MOUNTED, UNISTRUT FRAME TO MOUNT AUTOMATIC TRANSFER SWITCH, PANELS E1 & E2, TRANSFORMER AND BATTERY CHARGER.
- (10) PROVIDE DEFLECTOR ON COOLING AIR DUCT TO DEFLECT HOT AIR UP.
- (11) FUEL TANK, CONNECT UP-FLOAT SWITCH FOR ALARM.
- (12) PROVIDE THIMBLE FOR EXHAUST PIPE THROUGH WALL.
- (13) PROVIDE ANGLE IRON FRAME TO SUPPORT TRANSFORMER FROM BUILDING STRUCTURE.
- (14) 3/4" - 3 # 10 TO OUTDOOR LIGHTING CONTROL (SEE E4/8 FOR WIRING DETAIL).
- (15) LIGHTING CONTROL CONTACTOR.
- (16) PHOTO ELECTRIC CELL FOR OUTDOOR LIGHTING CONTROL MOUNT ON 1" CONDUIT STEM 24" ABOVE ROOF AND RUN 3/4" - 3 # 12 TO CONTACTOR BELOW.
- (17) 120 VOLT CONNECTION FOR SIGN ILLUMINATION.
- (18) KEY SWITCH FOR SIGN ENGRAVE PLATE "SIGN".

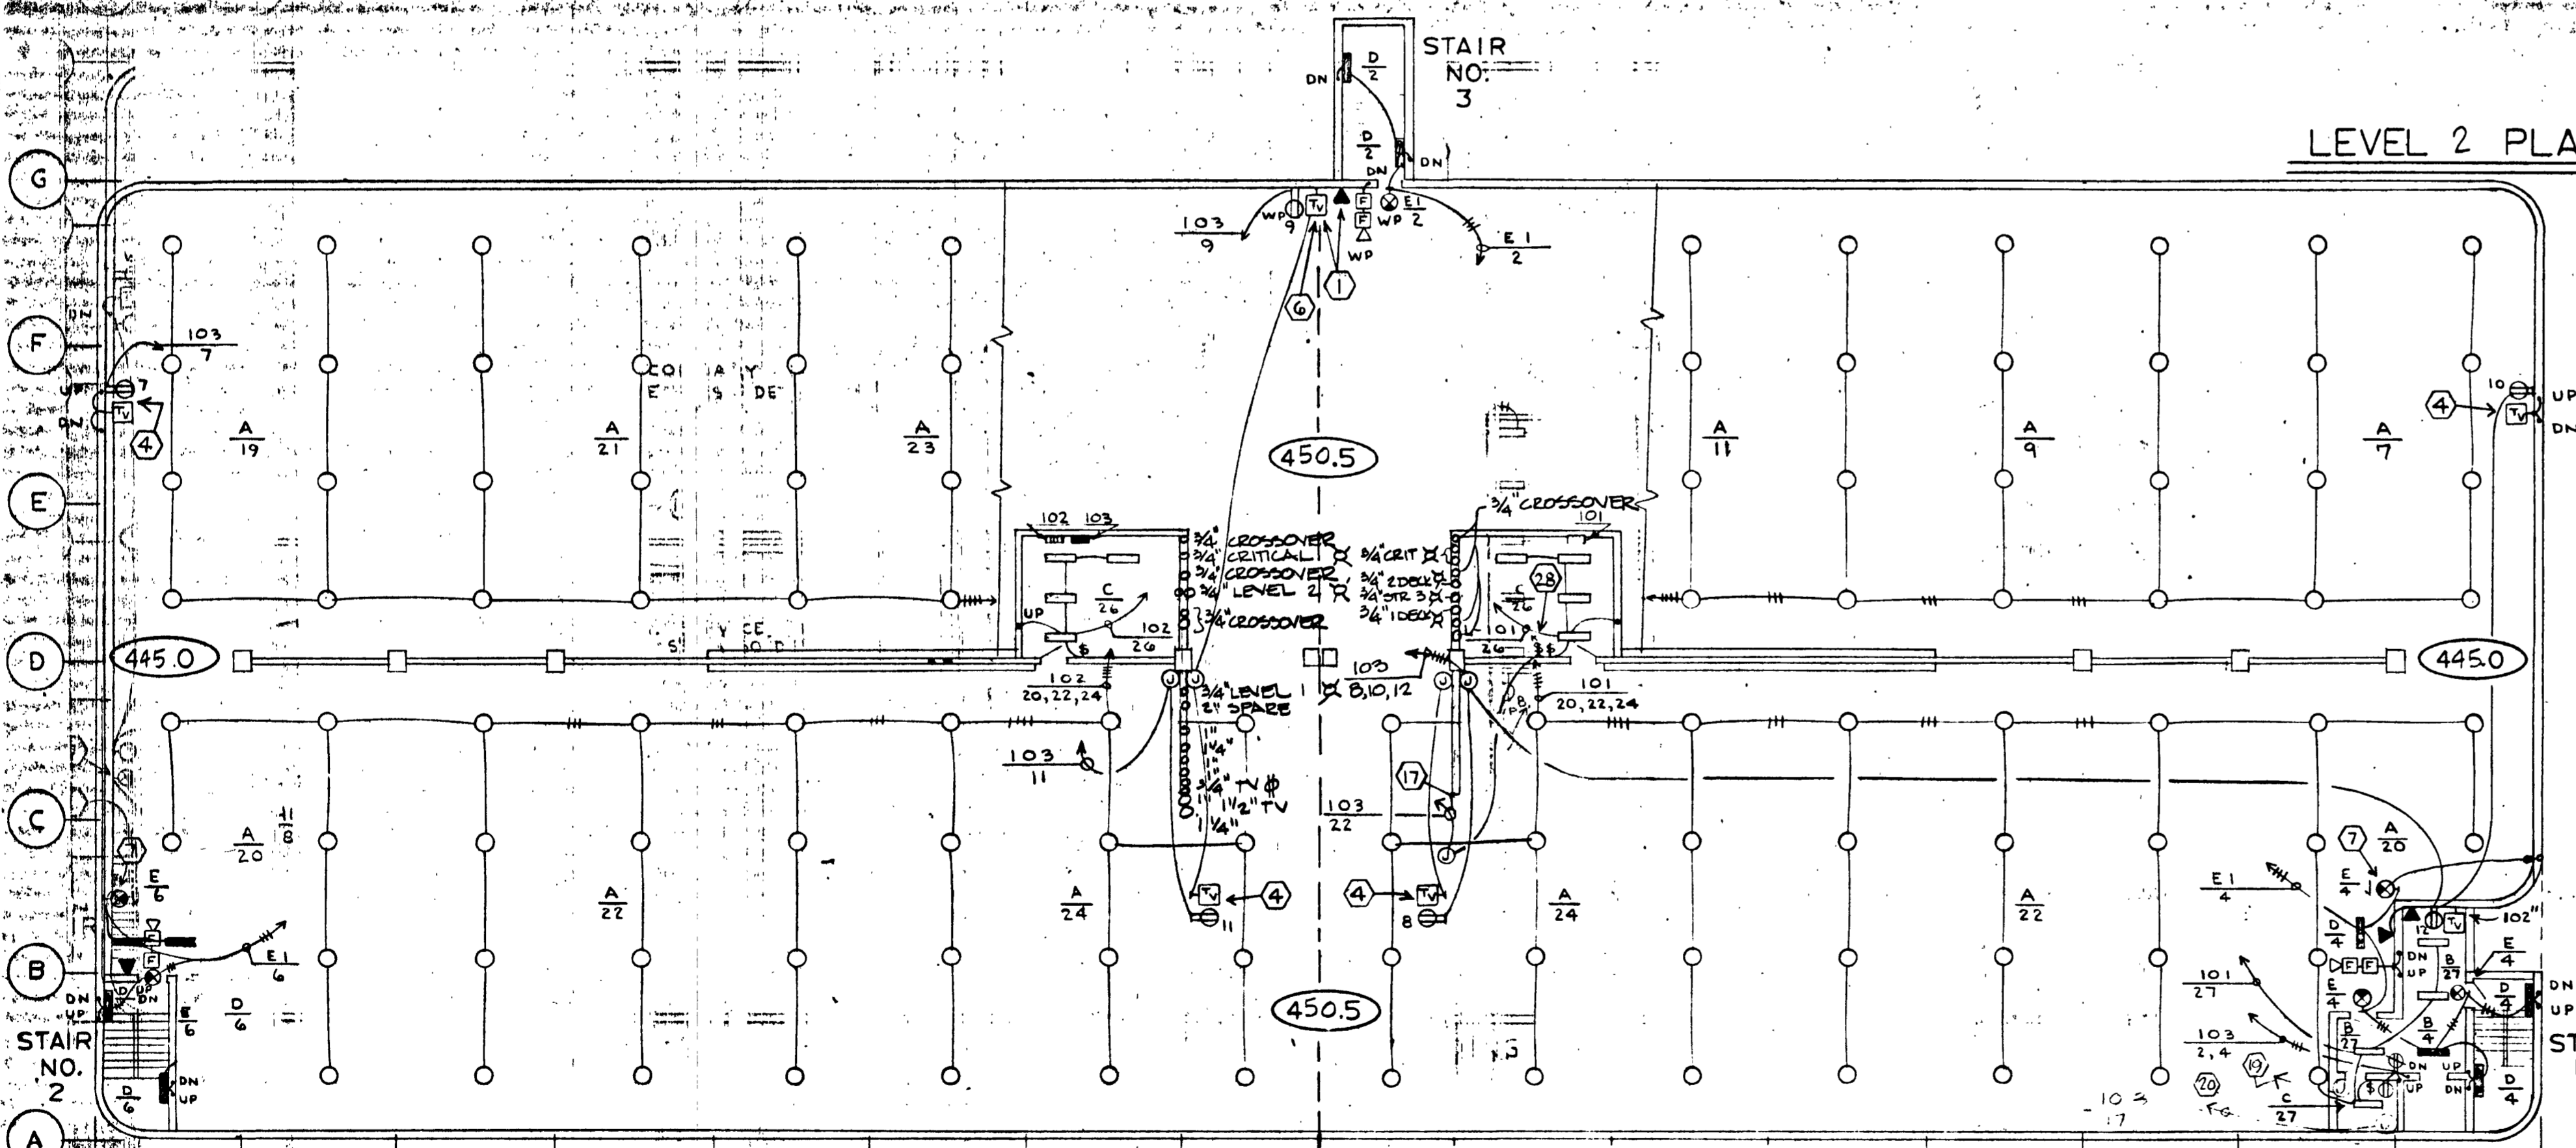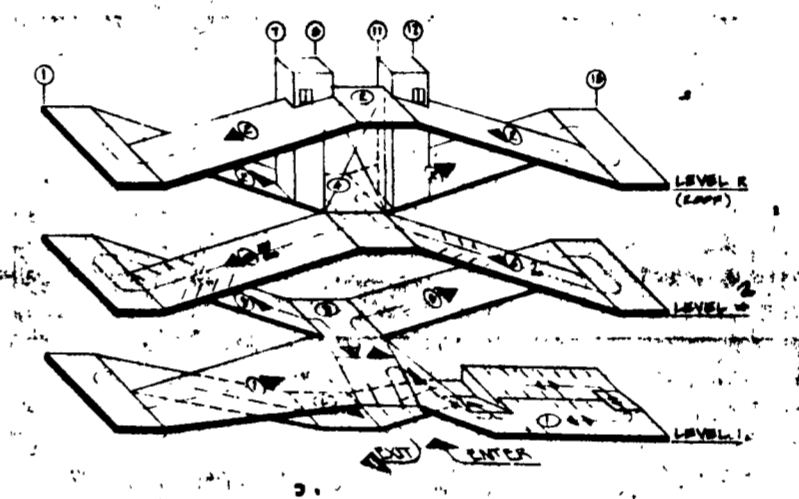

LEVEL 2 PLAN

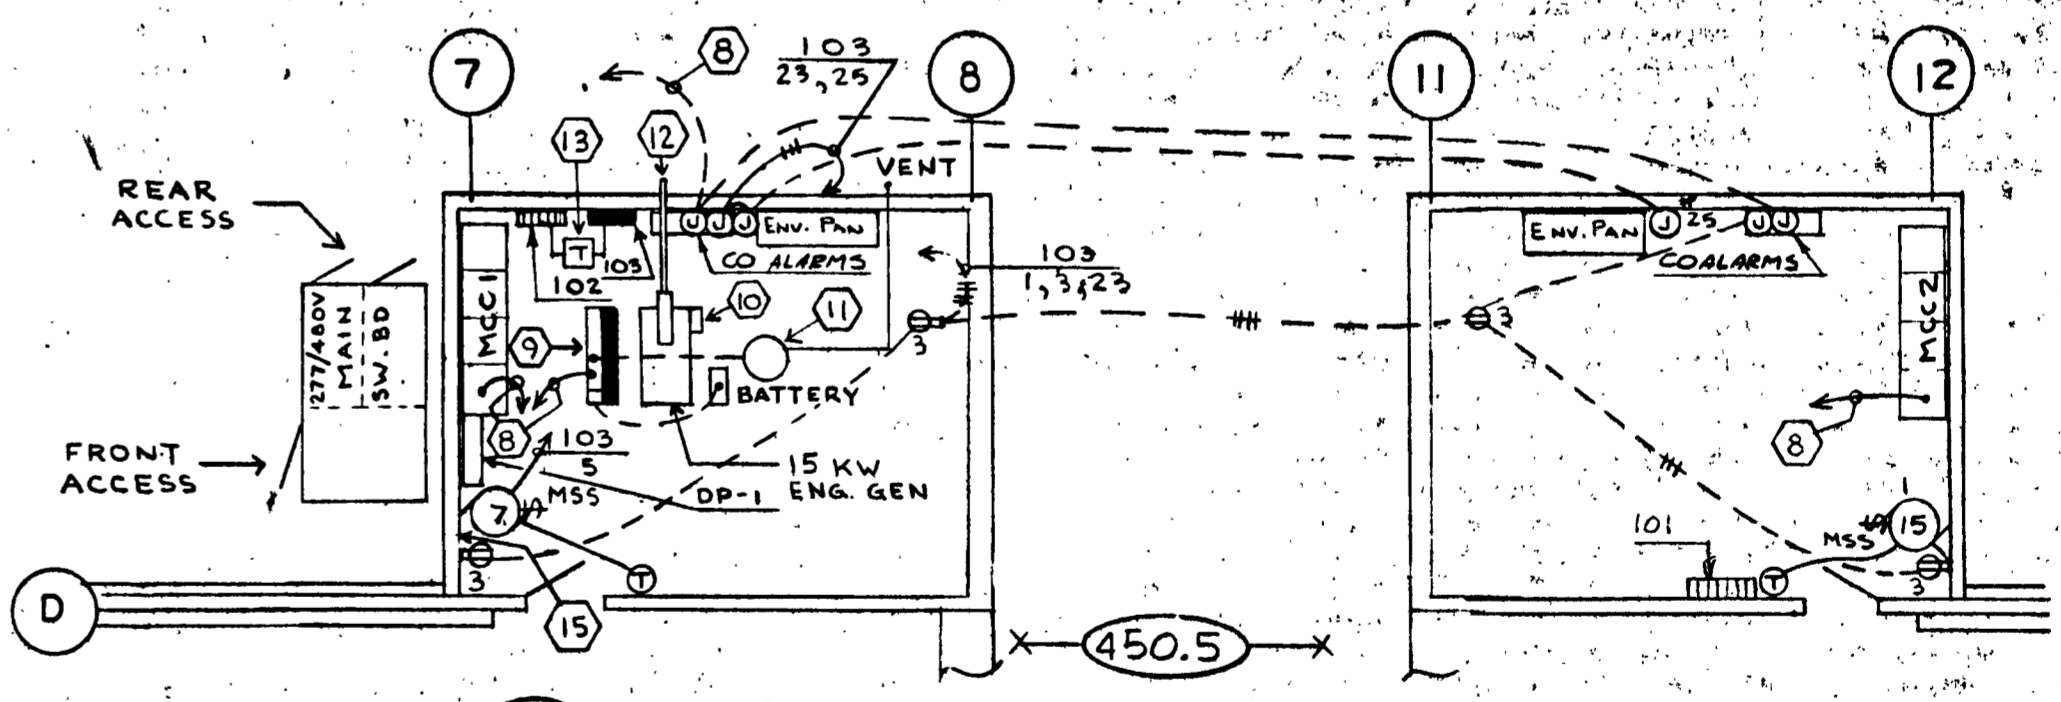

E2 LEVEL 2 MECHANICAL ROOMS
SEE ALSO LEVEL 2 PLAN SCALE 1/8" = 1'-0"


PETER KREWIT SONS' CO.	
FAIRBANKS, ALASKA	ALASKA
RECOMMENDED BY: <i>W. Hoop</i>	APPROVED BY: _____ DATE: _____
CONTRACT NO. 202	AS-BIT

JOB NO. 7313-734
DATE: 6-27-74

ARCHITECTS • ENGINEERS • SURVEYORS
601 COLLEGE ROAD, FAIRBANKS, ALASKA 99701, PHONE: 452-1241

STATE OF ALASKA
DEPT. OF PUBLIC WORKS
DIVISION OF BUILDINGS
JUNEAU ALASKA

FAIRBANKS PARKING STRUCTURE
FAIRBANKS, AK.
DBA - 2 - 0130

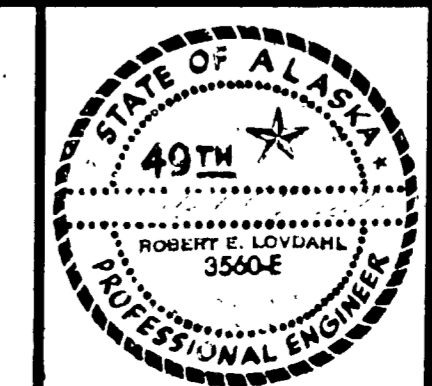


E2
SHEET 47 OF 49


ELECTRICAL LIGHTING, POWER AND SIGNAL
LEVEL 2 AND LEVEL R (ROOF) FLOOR PLANS

GRAY ROGERS MYERS & TORGAN


A DIVISION OF ELLERBE

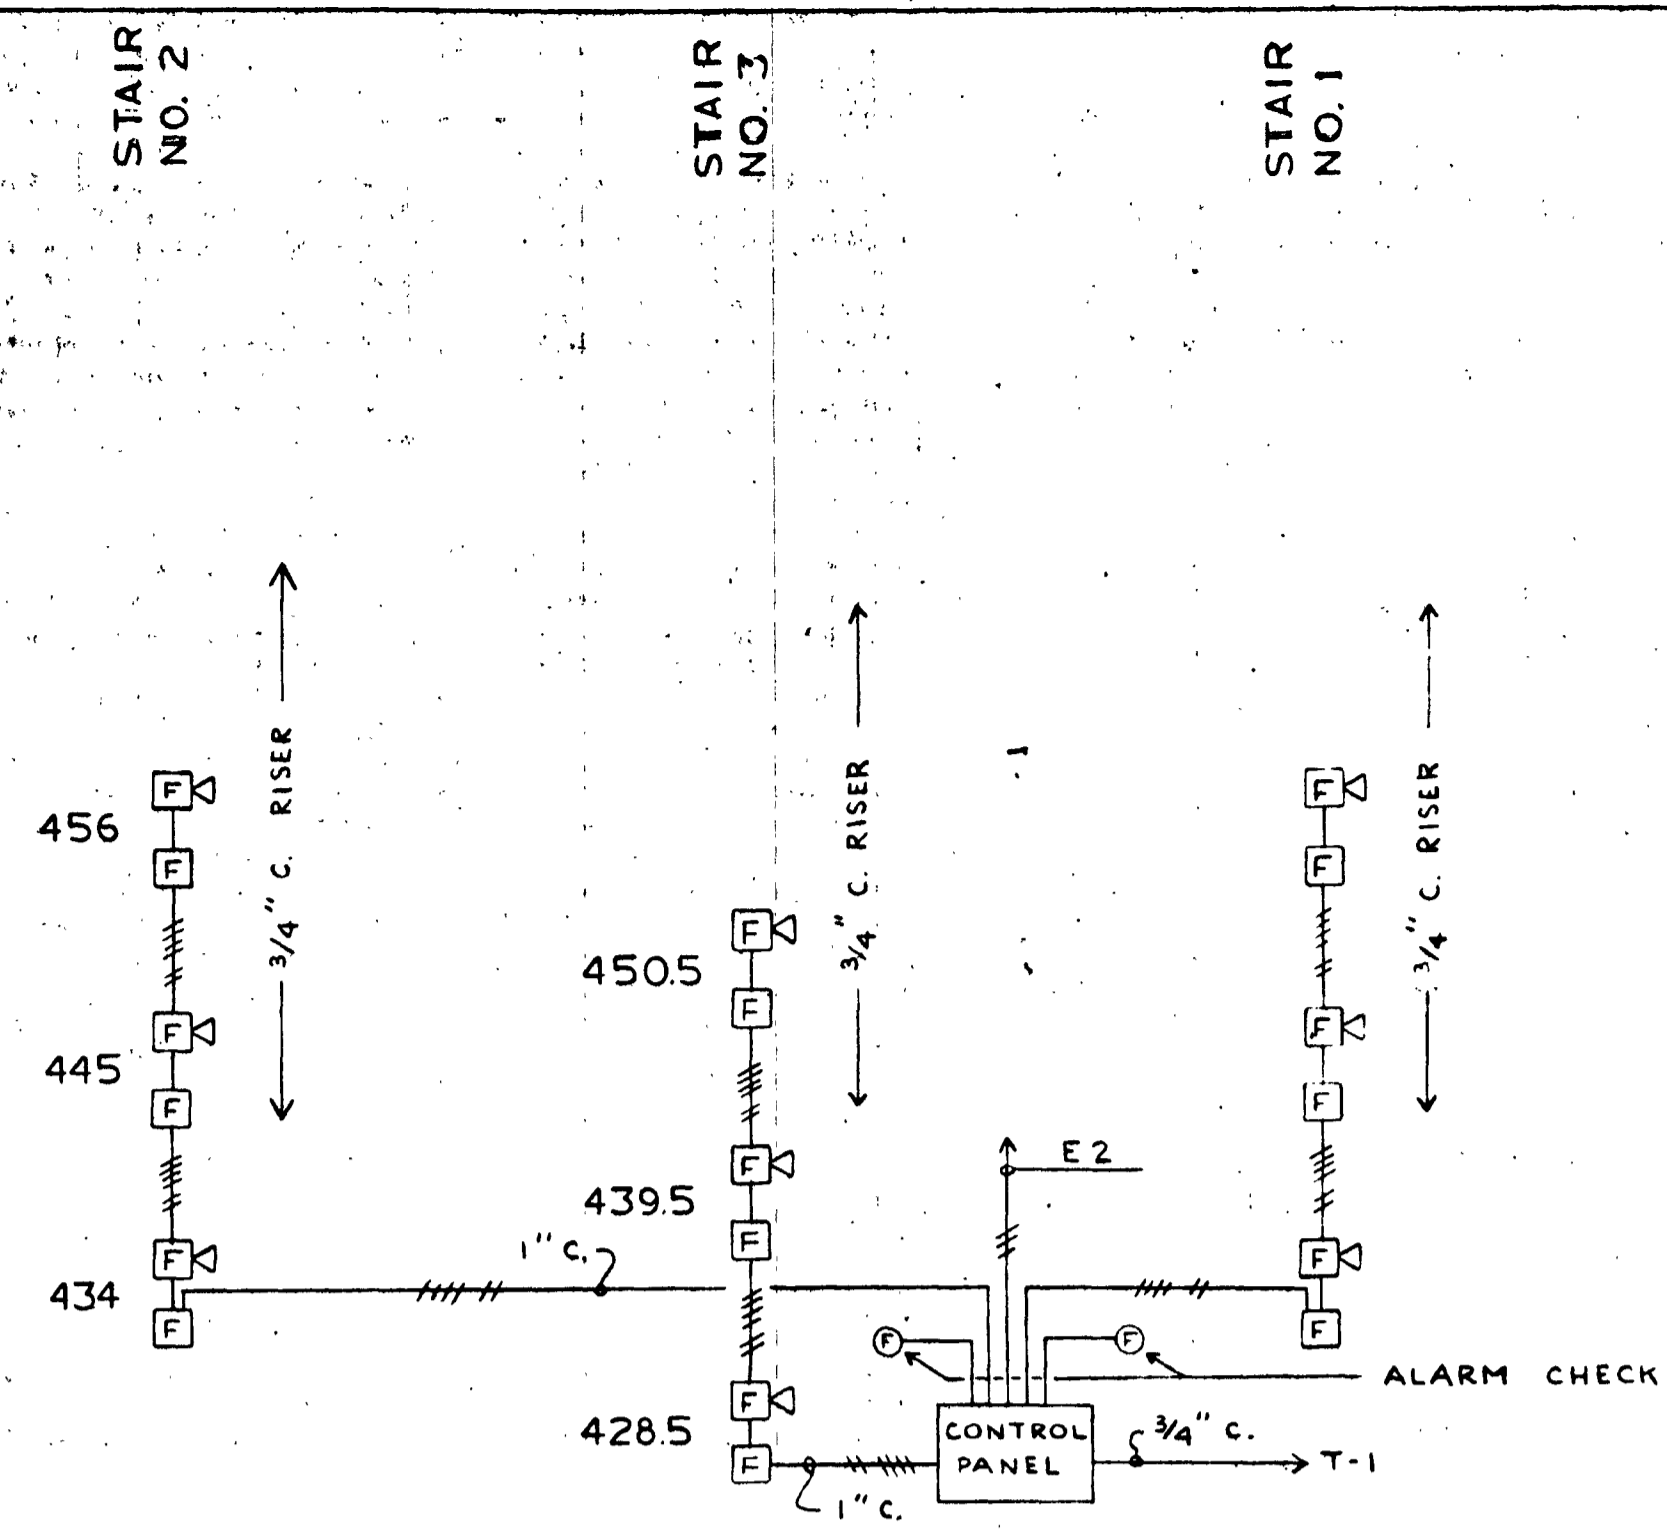


E3 3 FIRE ALARM RISER

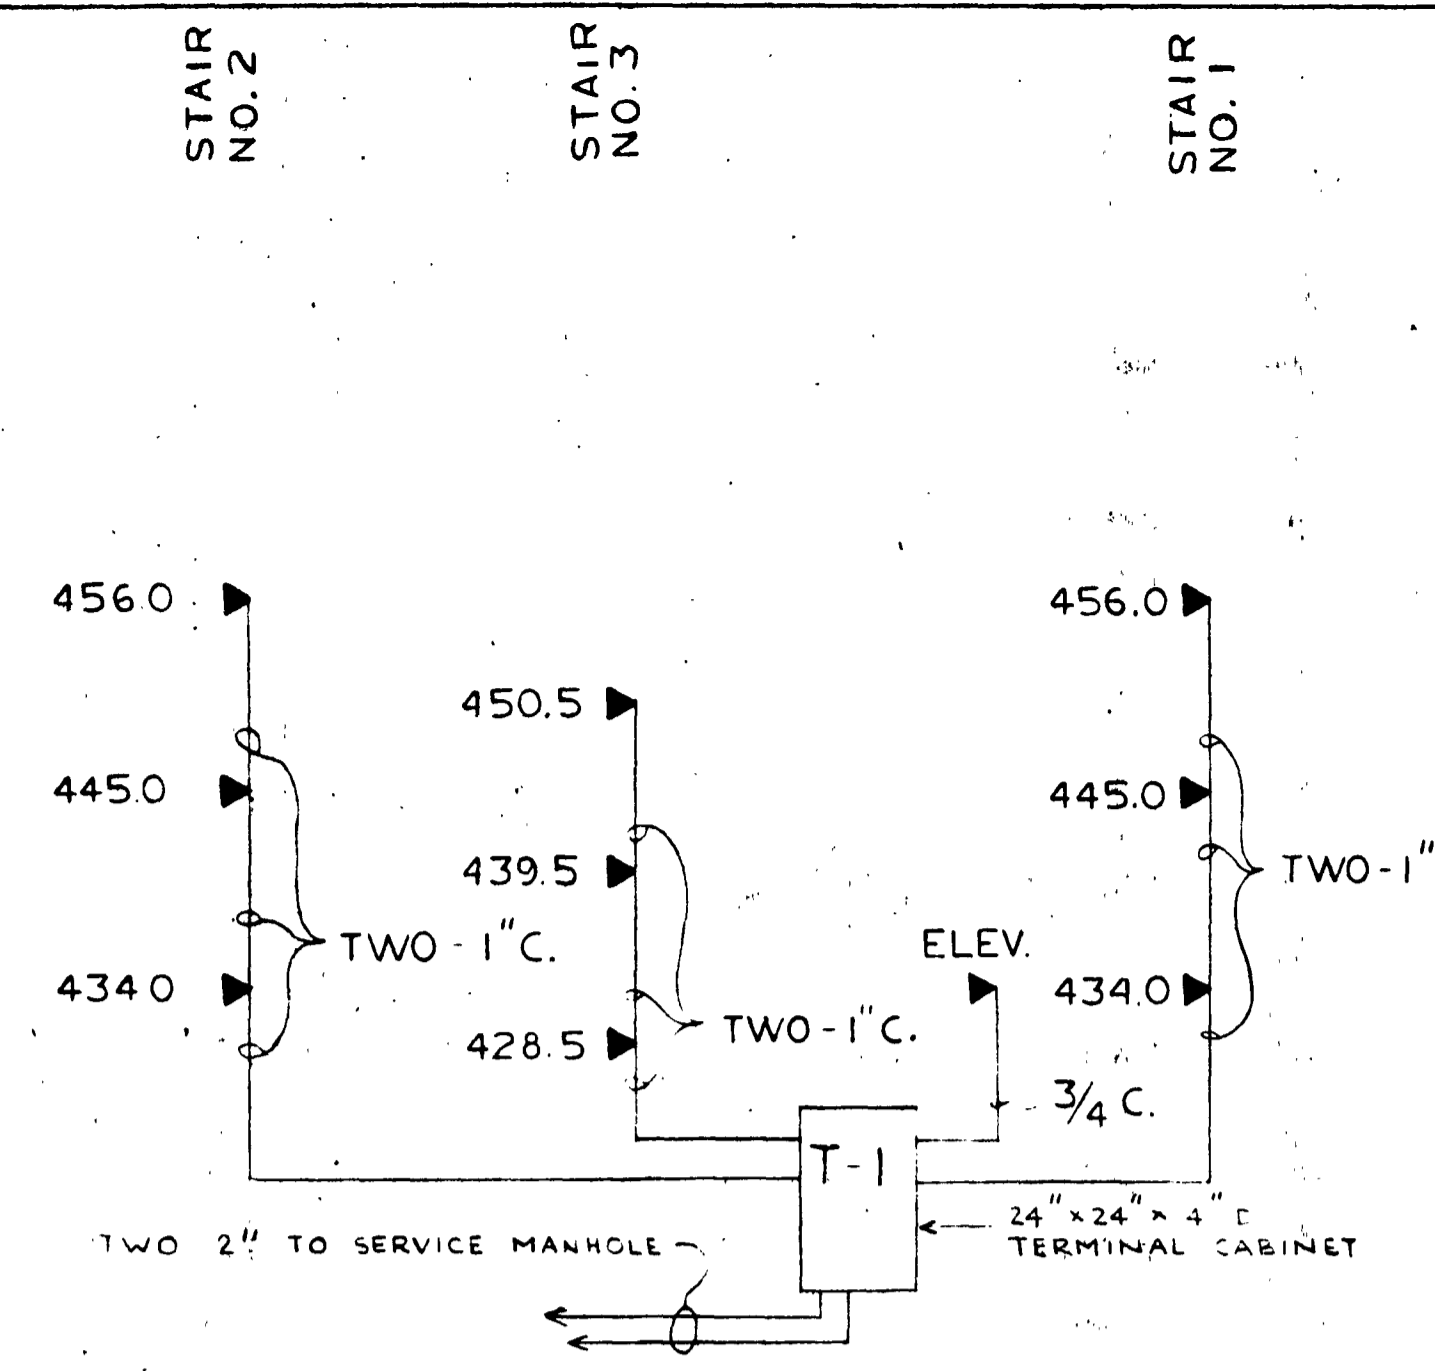


E3 2 TELEPHONE RISER

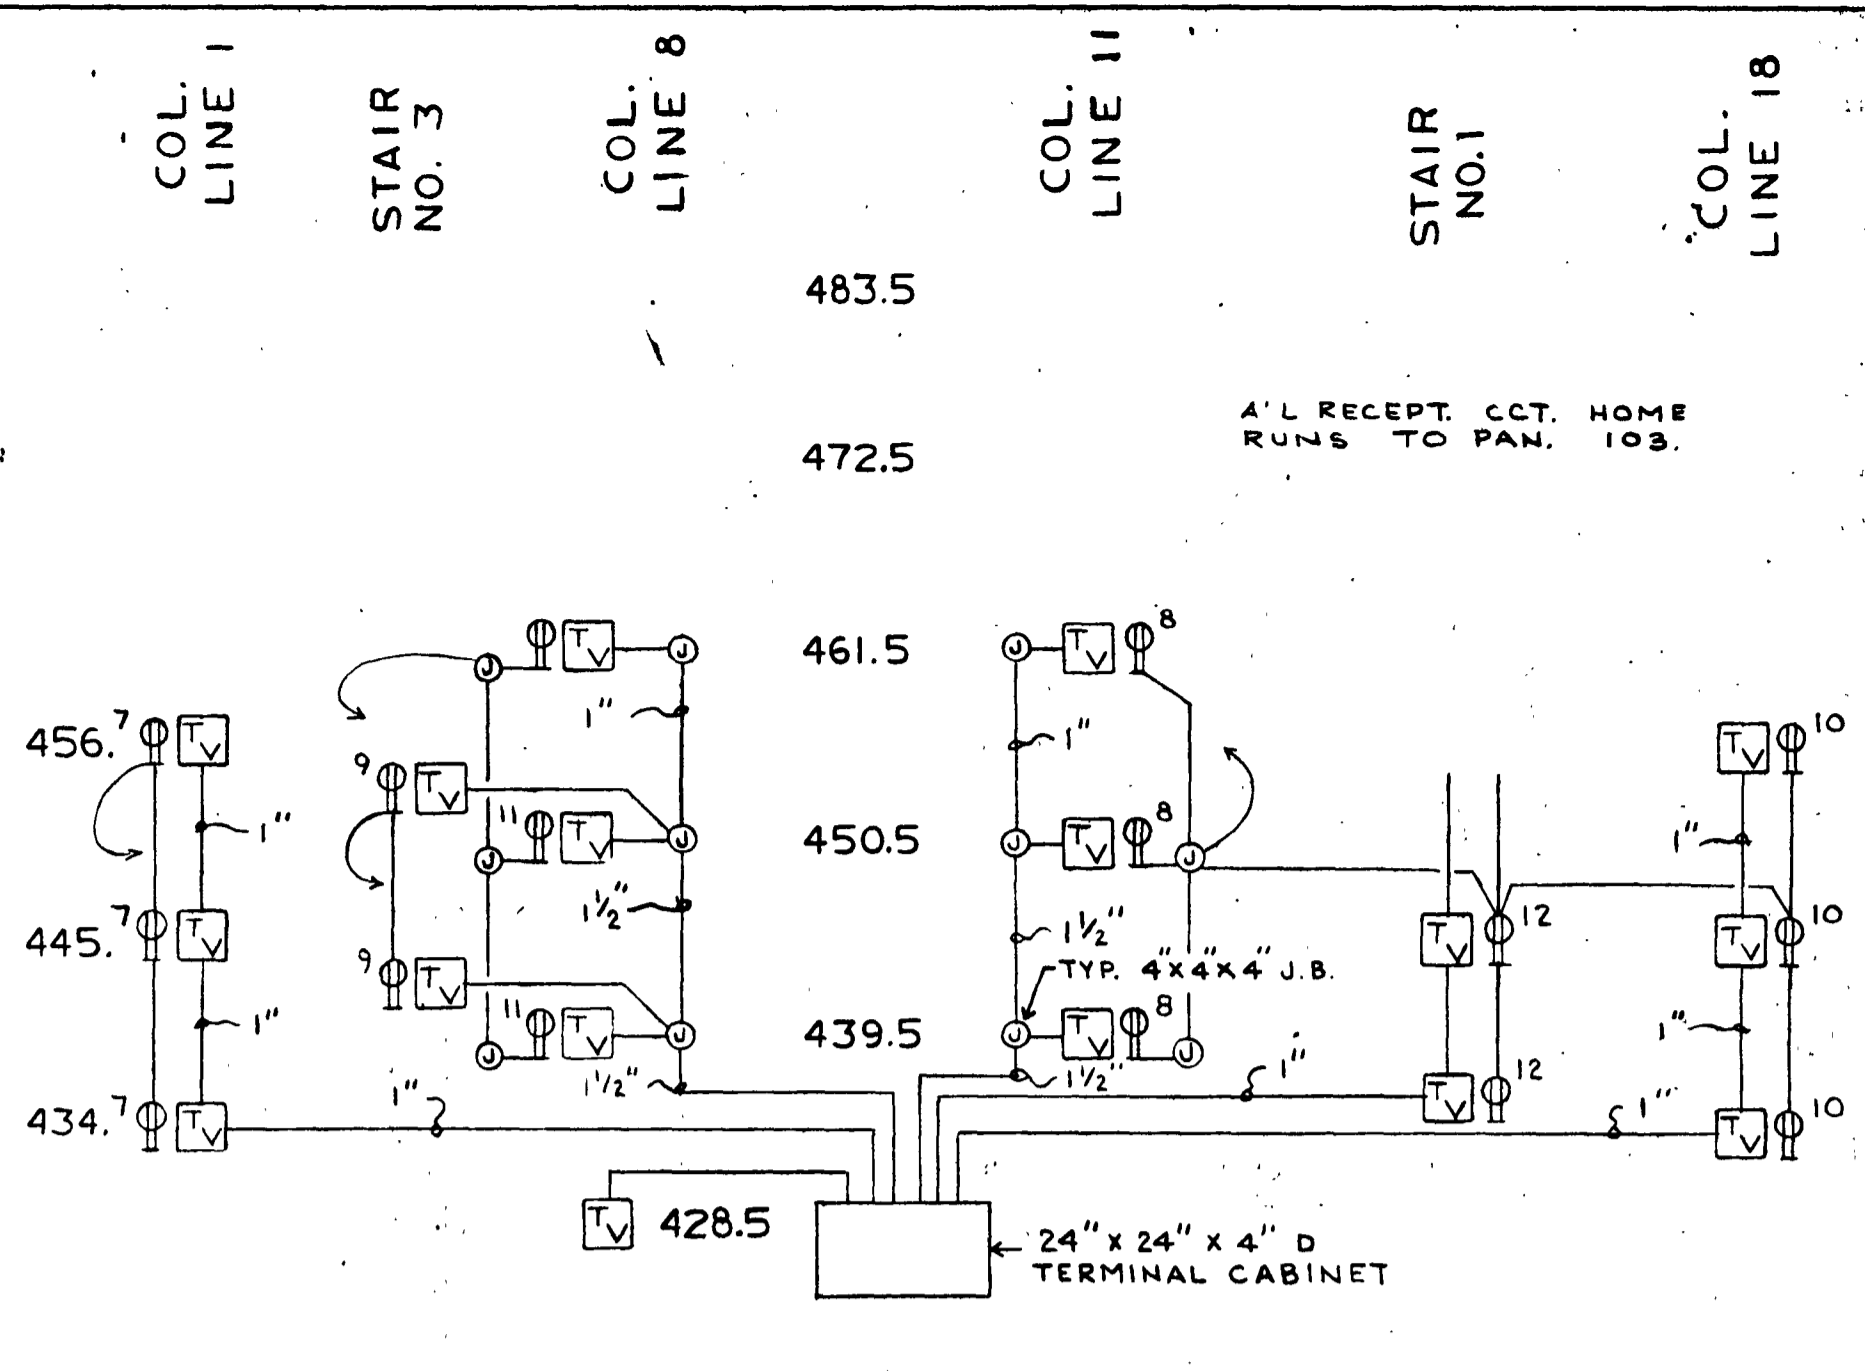


E3 1 RISER FOR CLOSED CIRCUIT TV
NOTE: ALL CONDUIT 3/4" UNLESS SHOWN OTHERWISE

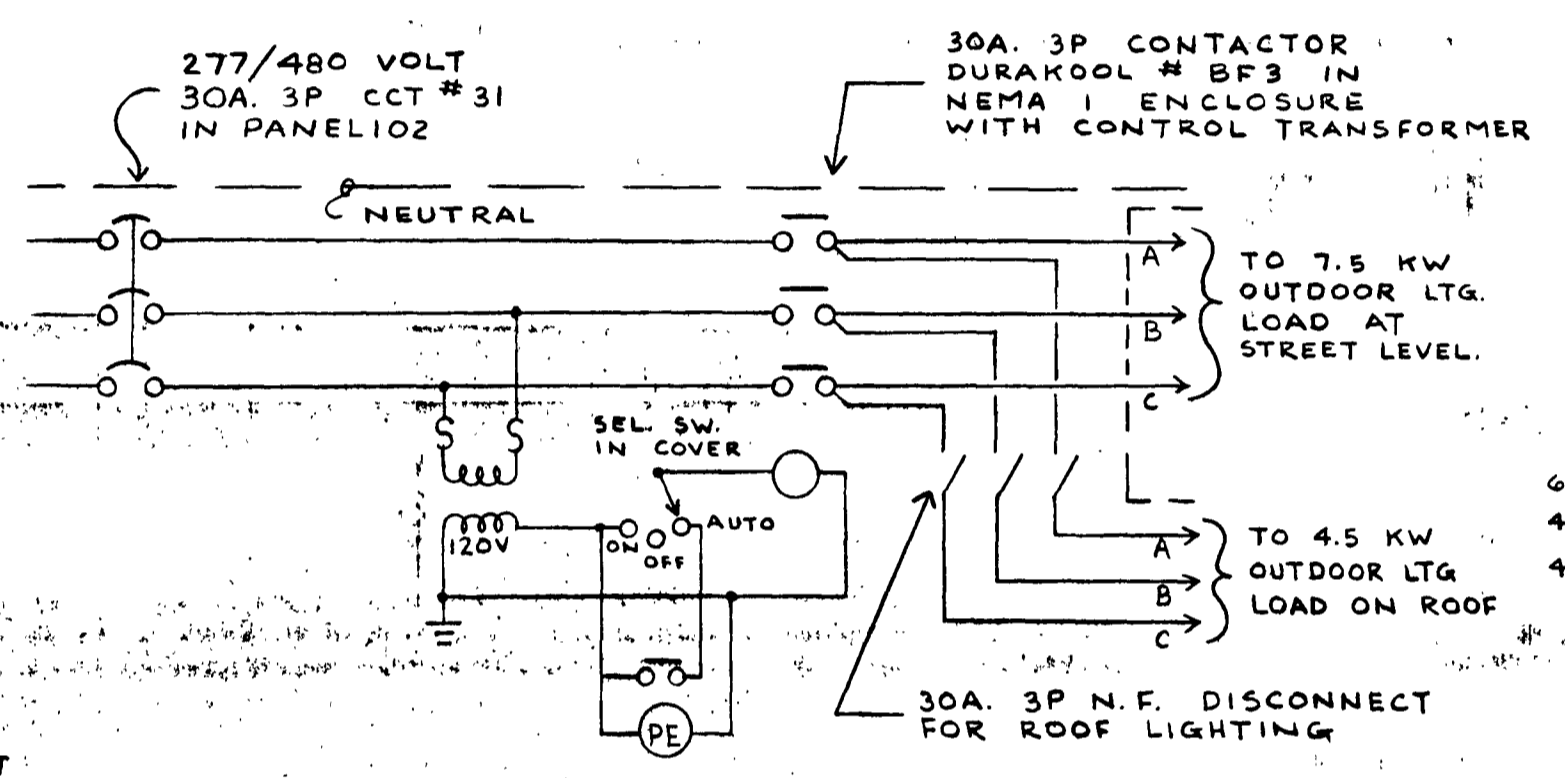


E3 8 DETAIL OUTDOOR LIGHTING WIRING

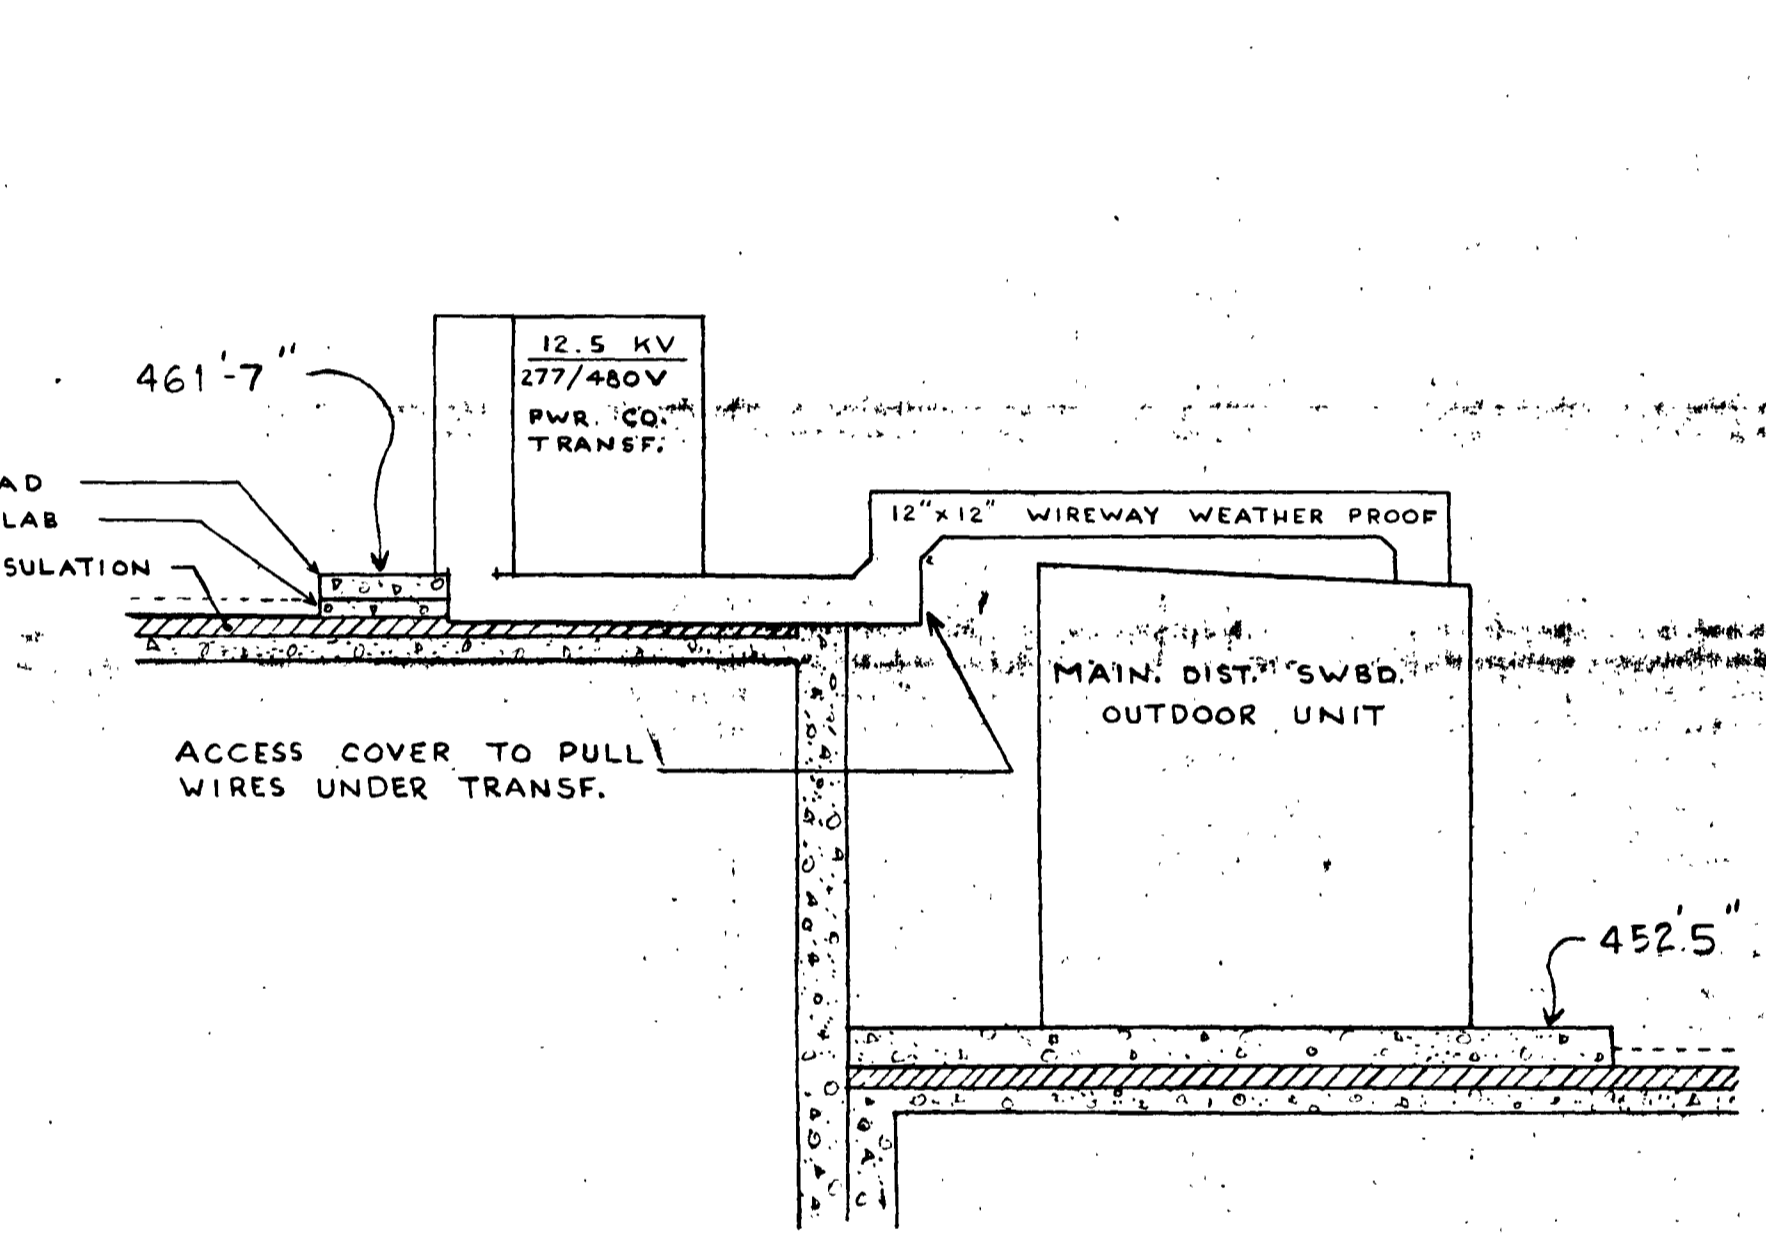


E3 6 DETAIL - SECONDARY SERVICE
NO SCALE

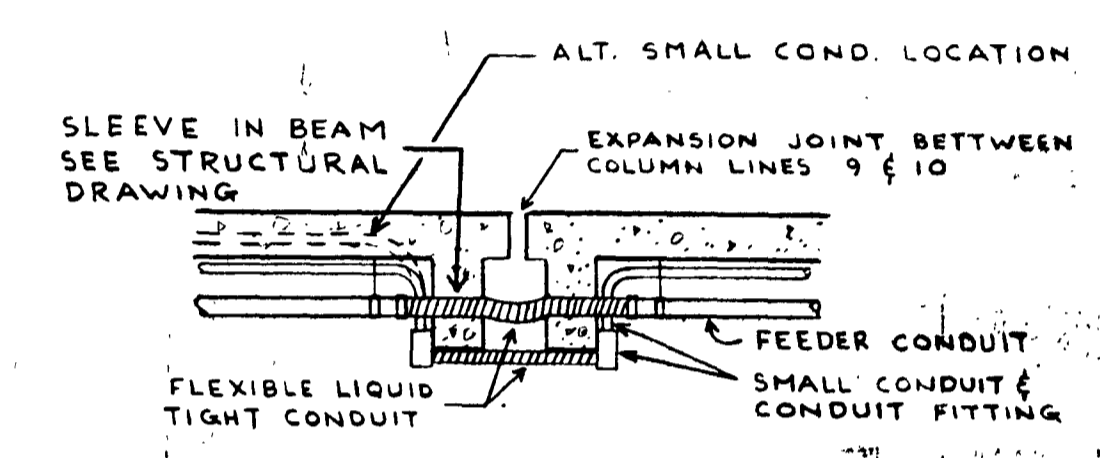


E3 4 EXPANSION JOINT DETAIL
NO SCALE

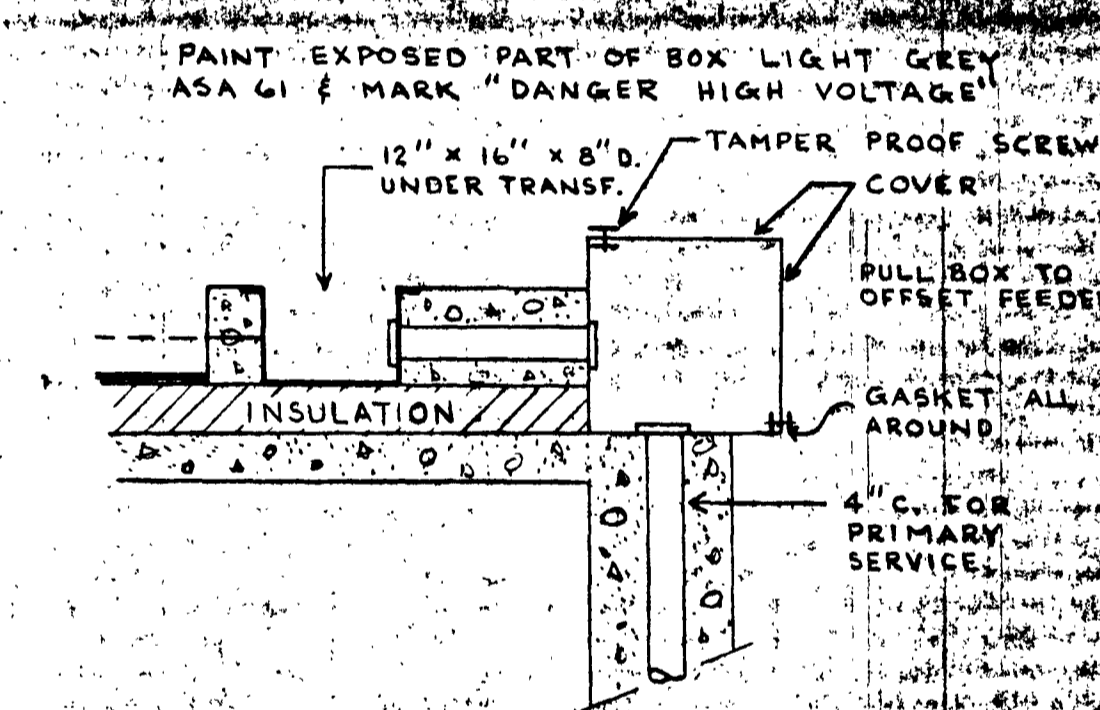


E3 5 DETAIL - PRIMARY SERVICE
NO SCALE

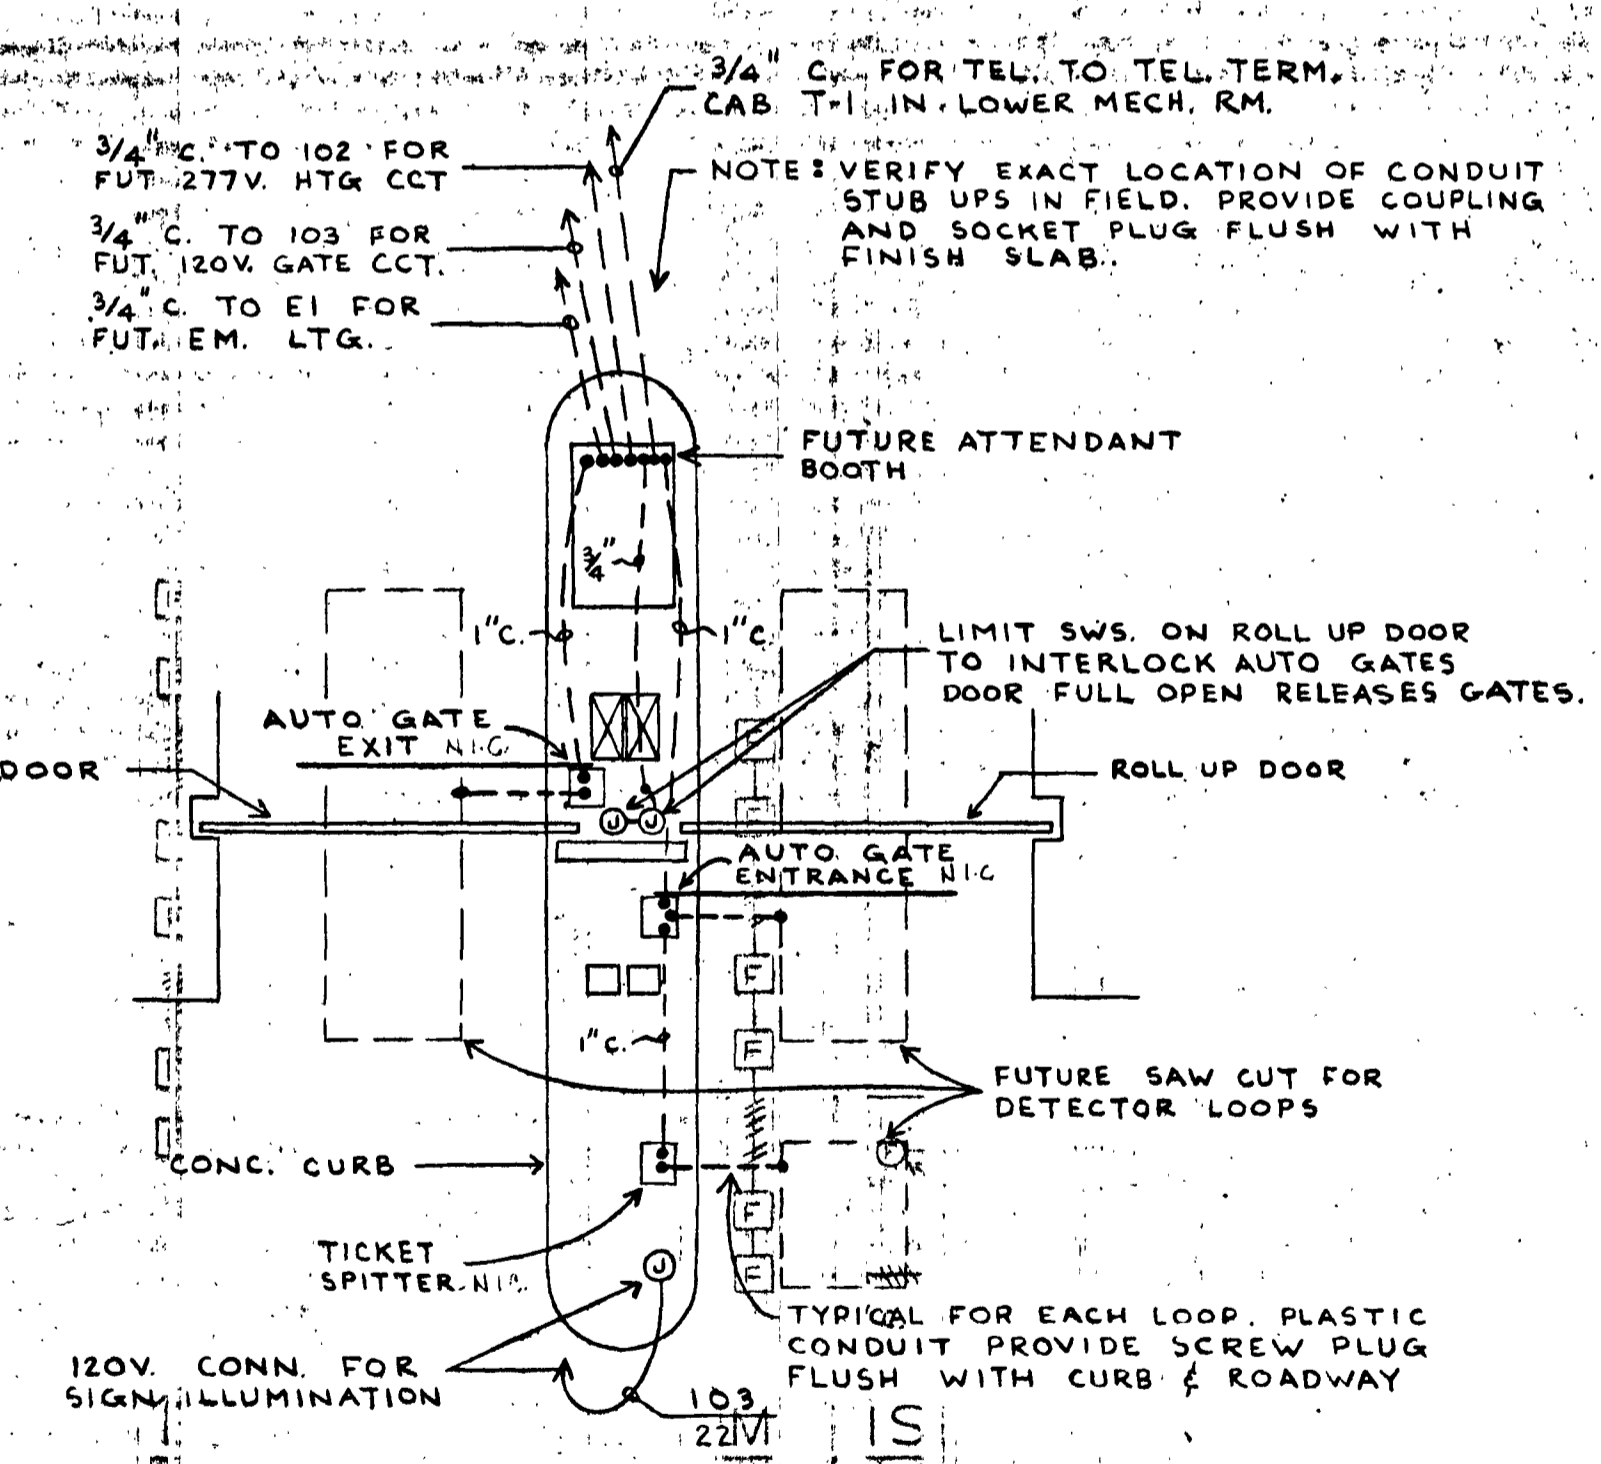

E3 7 DETAIL FUTURE PARKING GATE
SEE ARCHITECTURE FOR EXACT DIMENSIONS

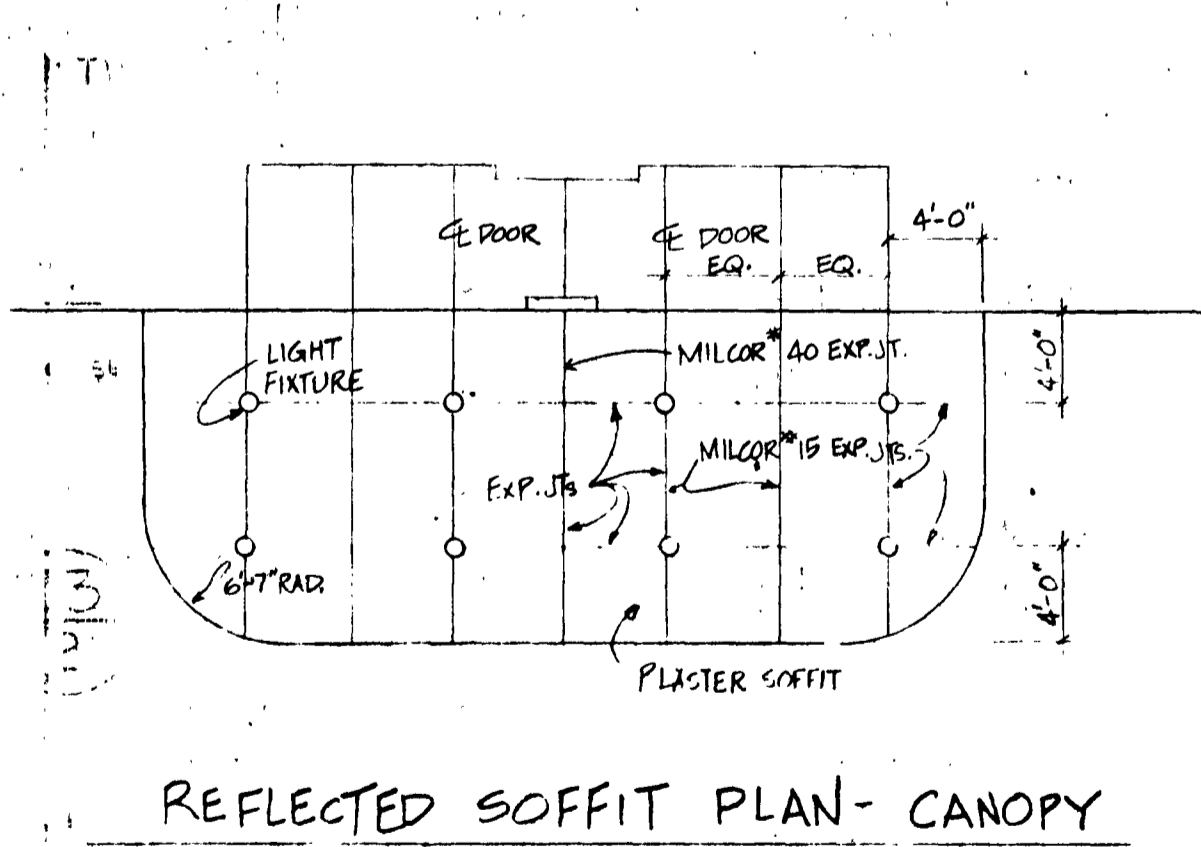

E3 9 DETAIL - MAIN ENTRANCE AIR DOORS

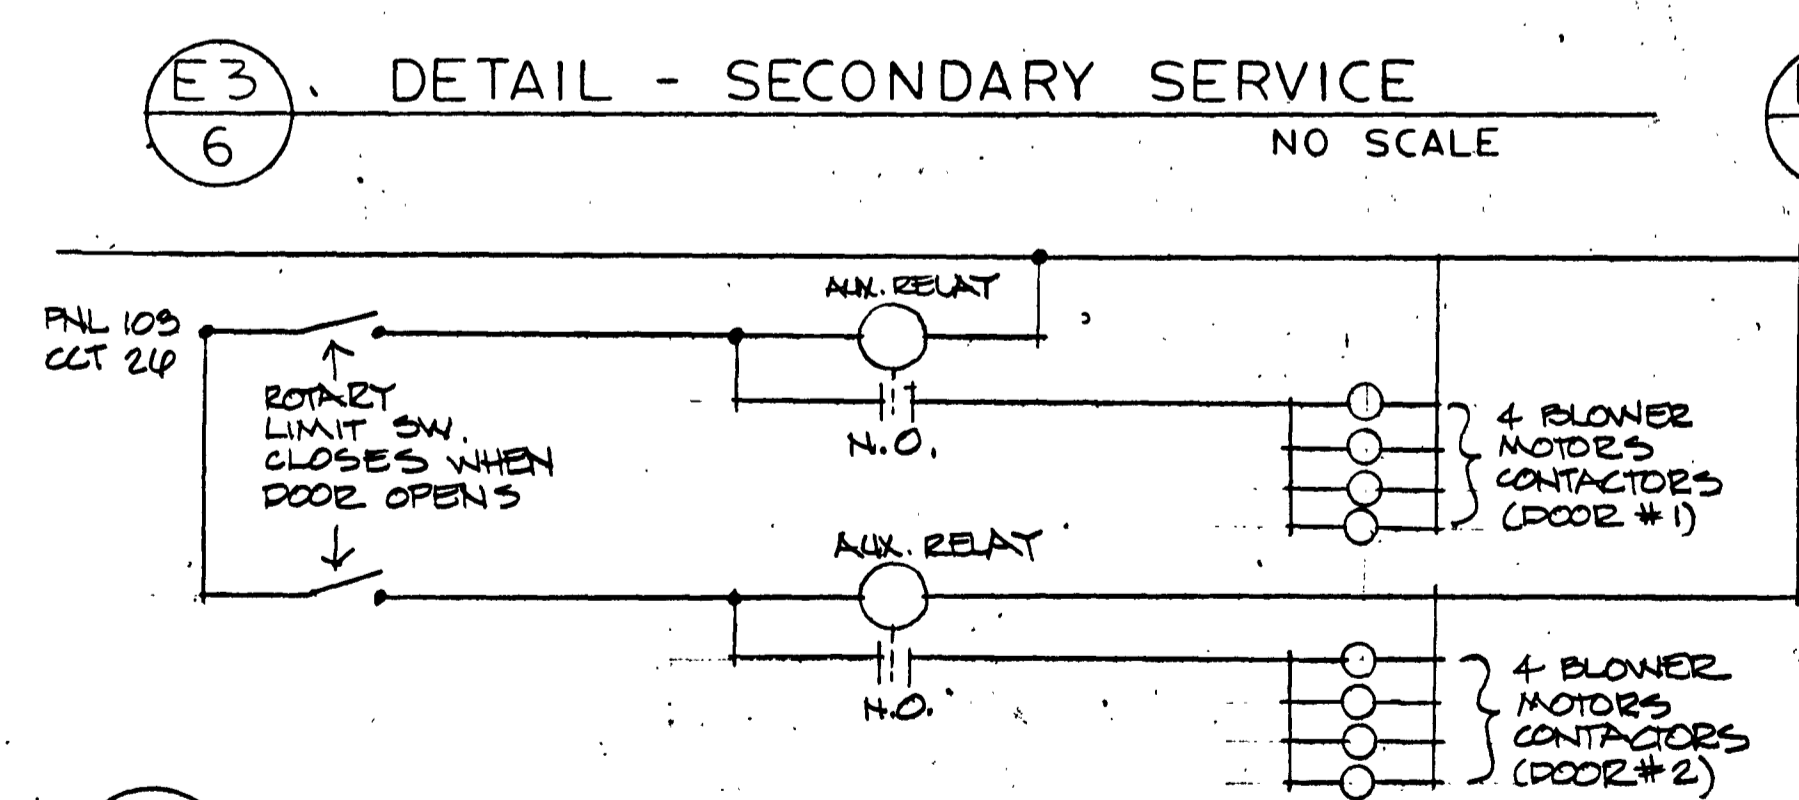


FAIRBANKS PARKING STRUCTURE
RECOMMENDED BY: [Signature]
DATE: _____
APPROVED BY: _____
DATE: _____

ELECTRICAL SIGNAL RISERS AND DETAILS

ARCHITECTS - ENGINEERS - SURVEYORS
601 COLLEGE ROAD, FAIRBANKS, ALASKA 99701, PHONE: 452-1241

STATE OF ALASKA
DEPT. OF PUBLIC WORKS
DIVISION OF BUILDINGS
JUNEAU ALASKA

FAIRBANKS PARKING STRUCTURE
FAIRBANKS, AK.
DBA - 2 - 0130

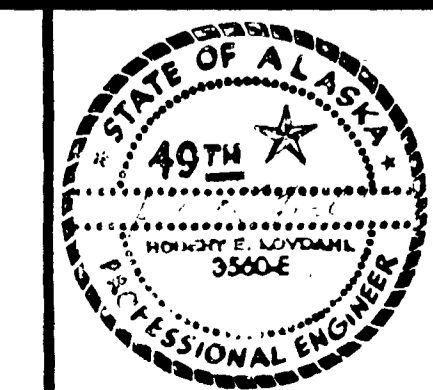

E3

GRAY ROGERS MYERS & TORGAN

A DIVISION OF ELLERBE

PANELBOARD NO. 103 120 / 208 VOLTS 3 PH. 4 WIRE MOUNTING - SURFACE				PANELBOARD NO. 101 277 / 480 VOLTS 3 PH. 4 WIRE MOUNTING - SURFACE				PANELBOARD NO. 102 277 / 480 VOLTS 3 PH. 4 WIRE MOUNTING - SURFACE							
CCT. NO.	SIZE NO. OF POLES	TYPE OF LOAD	WATTS	CCT. NO.	SIZE NO. OF POLES	TYPE OF LOAD	WATTS	CCT. NO.	SIZE NO. OF POLES	TYPE OF LOAD	WATTS	CCT. NO.	SIZE NO. OF POLES	TYPE OF LOAD	WATTS
1A	20-1	U.H.	500	2A	20-1	REC	1200	1A	20-1	LTG	2400	2A	20-1	LTG	2400
3B	20-1	REC	1000	4B	20-1	REC	1200	3B	20-1	LTG	2400	4B	20-1	LTG	2400
5C	20-1	U.H.	500	6C	20-1	REC	1200	5C	20-1	LTG	2400	6C	20-1	LTG	2400
7A	20-1	REC	1200	8A	20-1	REC	1200	7A	20-1	LTG	2400	8A	20-1	LTG	2400
9B	20-1	REC	1200	10B	20-1	REC	1200	9B	20-1	LTG	2400	10B	20-1	LTG	2400
11C	20-1	REC	1200	12C	20-1	REC	1200	11C	20-1	LTG	2400	12C	20-1	LTG	2400
13A	20-1	MTR	1000	14A	20-1	C.U.H.	500	13A	20-1	LTG	2400	14A	20-1	LTG	2400
15B	20-1	C.U.H.	400	16B	20-1	C.U.H.	300	15B	20-1	LTG	2400	16B	20-1	LTG	2400
17C	20-1	E.W.H.	2000	18C	20-1	MTR	900	17C	20-1	LTG	2400	18C	20-1	LTG	2400
19A	20-1	SPR	200	20A	20-1	MTR	25 900	19A	20-1	LTG	2400	20A	20-1	LTG	2400
21B	20-1	SPR	200	22B	20-1	SIGN	600	21B	20-1	LTG	2400	22B	20-1	LTG	2400
23C	20-1	S.P. H.N.W.L. CONTROL		24C	20-1	SPR		23C	20-1	LTG	2400	24C	20-1	LTG	2400
25A	20-1	I.N.P. H.N.W.L. CONTROL		26A	20-1	AIR DOOR CONTROL		25A	20-1	LTG	2400	26A	20-1	LTG	2400
27B	20-1	SPR		28B	20-1	SPR		27B	20-1	LTG	2400	28B	20-1	LTG	2400
29C	20-1	H.N.W.L. AIR DRYER		30C	20-1	SPR		29C	20-1	LTG	2400	30C	20-1	LTG	2400
31A	20-1	HONEYWELL COMPRESSOR		32A	20-1	SPR		31A	20-1	LTG	2400	32A	20-1	LTG	2400
33B	20-1	SPC		34B	20-1	SPC		33B	20-1	LTG	2400	34B	20-1	LTG	2400
35C	20-1	SPC		36C	20-1	SPC		35C	20-1	LTG	2400	36C	20-1	LTG	2400
37A	20-1	SPC		38A	20-1	SPC		37A	20-1	LTG	2400	38A	20-1	LTG	2400
39B	20-1	SPC		40B	20-1	SPC		39B	20-1	LTG	2400	40B	20-1	LTG	2400
41C	20-1	SPC		42C	20-1	SPC		41C	20-1	LTG	2400	42C	20-1	LTG	2400

ELECTRICAL NOTES

① RUN 3/4" 1# 3/0 GROUND WIRE TO COLD WATER PIPE NEAR COLUMN 10-1/2 D IN LOWER MECHANICAL ROOM. RUN 3/4" - 1# 3/0 GROUND WIRE TO GROUND COUNTERPOISE IN FOOTING NEAR COLUMN G-8.

② POWER COMPANY METERING EQUIPMENT. SEE SPECIFICATIONS 16230 SERVICE CONNECTIONS AND 16332 LOW VOLTAGE SWITCHBOARD.

MOTOR STARTER SCHEDULE									
MTR. NO.	DESCRIPTION	MOTOR			STARTER			CONTROL NOTES	
		HP	VOLT	PH.	SIZE	LOCATION			
1	SUPPLY FAN SF-1	460	460	3	N. PH.	MCC 1	11,12,15		
2	SUPPLY FAN SF-2	460	460	3	N. PH.	MCC 1	11,12,15		
3	EXHAUST FAN EF-1	30	460	3	N. PH.	MCC 1	1,12,13,14		
4	EXHAUST FAN EF-2	30	460	3	N. PH.	MCC 1	1,12,13,14		
7	UNIT HEATER UH-1	1/20	120	1	N. PH.	MSS	ON UNIT	7	
8	OMITTED								
9	SUPPLY FAN SF-3	460	460	3	S PH	MCC 2	11,12,15		
10	SUPPLY FAN SF-4	460	460	3	S PH	MCC 2	11,12,15		
11	EXHAUST FAN EF-5	30	460	3	S PH	MCC 2	1,12,13,14		
12	EXHAUST FAN EF-6	30	460	3	S PH	MCC 2	1,12,13,14		
15	UNIT HEATER UH-2	1/20	120	1	S PH	MSS	ON UNIT	7	
16	GLYCOL MAKE-UP PUMP	1/3	120	1	EQ. RM.	MSS	ON UNIT	10	
17	AIR DOOR NORTH	5	460	3	ENTRANCE	1	ON UNIT	2,4	
18	AIR DOOR SOUTH	5	460	3	ENTRANCE	1	ON UNIT	4	
19	AIR DOOR SOUTH	5	460	3	ENTRANCE	1	ON UNIT	2,5	
20	AIR DOOR SOUTH	5	460	3	ENTRANCE	1	ON UNIT	5	
21	OMITTED								
22	AIR COMP. SPRINKLER	480	480	3	EQ. RM.	ON UNIT	8		
25	SUMP PUMP SP-1	1/3	120	1	EQ. RM.	MSS	ON UNIT	10	
26	SUMP PUMP SP-2	3/4	460	3	EQ. RM.	1	EQ. RM.	1,9	
27	SUMP PUMP SP-3	3/4	460	3	EQ. RM.	1	EQ. RM.	1,9	
28	UNIT HEATER UH-3	1/20	120	1	EQ. RM.	MSS	ON UNIT	7	
29	UNIT HEATER UH-4	1/20	120	1	EQ. RM.	MSS	ON UNIT	7	
30	HEATING PUMP CP-2	1/2	460	3	EQ. RM.	1	EQ. RM.	1,6	
31	CONDENSATE PUMP	2	460	3	EQ. RM.	1	EQ. RM.	1,9	
32	CONDENSATE PUMP	2	460	3	EQ. RM.	1	EQ. RM.	1,9	


LIGHTING FIXTURE SCHEDULE				
TYPE LETTER	MOUNTING	DESCRIPTION	MANUFACTURER	NOTE
A	SUSPENDED	CLOSE SWIVEL SUSPENDED FIXTURE FOR 1-150 WATT HI PRESSURE SODIUM LAMP GE-LU150/BU	HOLOPHANE # 906-55-277	1,3
B	RECESSED	1 X 4, 2 LAMP, 40 WATT, FLUORESCENT WITH ACRYLIC LENS K-12.	SEE NOTE	1,7
C	SUSPENDED	STRIP FIXTURE FOR ONE 40 WATT FLUORESCENT LAMP. BAKED WHITE ENAMEL FINISH.	GLOBE 1201-4R	1,5
D	SURFACE	2-40 WATT FLUORESCENT LAMPS, WRAP AROUND OPAL, LEXAN PLASTIC DIFFUSER.	MARCO #143	1,4
E	AS INDICATED	EXIT LIGHT FIXTURE WITH MULTIPLE LONG LIFE BULBS, METAL STENCIL, 6" LETTERS, DOWN LIGHT ARROWS AS INDICATED.	MILLER PATH-FINDER PRESCOLITE THIN LINE	1,2
ET	AS INDICATED	SAME AS "E" EXCEPT WEATHERPROOF CONSTRUCTION		
F	RECESSED	WEATHERPROOF DOWN LIGHT FOR ONE 150 WATT GE LU150/BU LAMP. TAMPER PROOF SCREWS, FRESNEL LENS.	MARCO #RT33-756-LU	
G	SURFACE	VAPOR TIGHT FOR 100W LAMP WITH GLASS GLOBE & SHOCK RESISTING SOCKET WITH CAST JUNCTION BOX.	MILLER ACTOGRS STEBER VB150SR	
H	SURFACE	WALL BRACKET FOR ONE 150 WATT GE LU150/BU LAMP WITH TOP SHIELD.	HOLOPHANE # 600LU	
HI	SURFACE	SAME AS "H" EXCEPT WITH PHOTO-ELECTRIC CONTROL.		
I	OMITTED			
J	SURFACE	WALL BRACKET FOR ONE 150 WATT INCANDESCENT LAMP.	HOLOPHANE # 400	

NOTES:

- FIXTURE SHALL HAVE 277-VOLT BALLAST.
- THE NUMBER OF FACES, LOCATION OF FACES, AND DIRECTIONAL ARROWS ARE INDICATED ON THE DRAWINGS.
- FIXTURE SHALL HAVE WIRE GUARD.
- FIXTURE SHALL HAVE TAMPER PROOF SCREWS.
- CHAIN SUSPEND FIXTURE TO CLEAR MECHANICAL EQUIPMENT. PROVIDE 2 WIRE PLUS GROUND HEAVY DUTY TYPE S. CORD CONNECTION TO CEILING OUTLET.
- IF GE LU150/BU LAMP AND BALLAST NOT AVAILABLE IN FIXTURE AT TIME OF INSTALLATION, PROVIDE 250 WATT METAL HALIDE LAMP AND CW BALLAST OR PROVIDE A SUBSTITUTE FIXTURE APPROVED BY THE ARCHITECT.
- TROFFER FIXTURES SHALL BE SUITABLE FOR RECESSING INTO CEILING TYPES AS INDICATED IN THE ROOM FINISH SCHEDULE AND VERIFIED BY THE CONTRACTOR BEFORE ORDERING. FIXTURE SHALL HAVE STURDY FRAMED DIFFUSER PANELS FOR HANGING ON EITHER SIDE AND WITH UNBROUSIVE POSITIVE CATCHES, LENS HOLDERS DESIGNED FOR MINIMUM STRAIN ON THE DIFFUSER. ALL METAL PARTS BLENDED AGAINST CORROSION AND FINISHED IN A DURABLE WHITE BAKED ENAMEL. FIXTURES SHALL BE ALL ONE MANUFACTURE AND SHALL BE AS MANUFACTURED BY DAYBRITE, MILLER, LIGHTOLIER, GLOBE.

- PROVIDE HAND-OFF-AUTO SELECTOR SWITCH AND PILOT IN STARTER COVER.
- PROVIDE REMOTE HAND-OFF-AUTO SELECTOR SWITCH AND PILOT.
- START-STOP PUSH BUTTON AND PILOT IN STARTER COVER.
- INTERLOCK MOTOR 18 TO RUN WITH MOTOR 17. CONNECT LIMIT SWITCH IN ROLL UP DOOR TO START MOTOR 17 IN AUTO POSITION.
- INTERLOCK MOTOR 20 TO RUN WITH MOTOR 19. CONNECT LIMIT SWITCH IN ROLL UP DOOR TO START MOTOR 19 IN AUTO POSITION.
- CONNECT UP THERMOSTAT TO CONTROL MOTOR IN AUTO POSITION.
- CONNECT UP THERMOSTAT AND AQUASTAT TO CONTROL MOTOR. SEE SPECIFICATION 16622.
- CONNECT UP PRESSURE SWITCH TO CONTROL UNIT.
- MECHANICAL ALTERNATOR AND FLOAT SWITCHES FURNISHED AND INSTALLED ON EQUIPMENT UNDER DIVISION 15. CONNECT UP ALTERNATOR AND FLOAT SWITCHES TO CONTROL MOTOR IN AUTO POSITION. ALSO CONNECT UP ADDITIONAL FLOAT SWITCH TO ALARM ANNUNCIATOR.
- CONNECT UP FLOAT SWITCH TO CONTROL MOTOR.
- PROVIDE ON-OFF SELECTOR SWITCH IN STARTER COVER.
- PROVIDE TIME DELAYS TO PREVENT SIMULTANEOUS STARTING OF 4-100 HP AND 8-30 HP MOTORS AFTER A POWER FAILURE. TIME DELAY RELAYS SHALL BE ADJUSTED IN 10 SECOND STEPS TO PERMIT MOTORS TO START IN THE FOLLOWING ORDER: 3, 11, 4, 12, 5, 13, 6, 14, 1, 9, 2, 10.
- CONNECT UP CARBON MONOXIDE DETECTOR CONTACTS TO START MOTOR IN AUTO POSITION.
- PROVIDE TIME DELAY TO PROVIDE 5 MINUTE MINIMUM RUN TIME AFTER CONTROL CIRCUIT IS DEENERGIZED.
- PROVIDE N.C. AUXILIARY CONTACT FOR VENTILATION FAILURE ALARM.

PETER KIEWIT SONS' CO.
FAIRBANKS, ALASKA
RECOMMENDED: _____ UNPROVED: _____
DATE: _____ CONTRACTOR'S REP. _____ OWNER'S REP. _____
AS-BLT

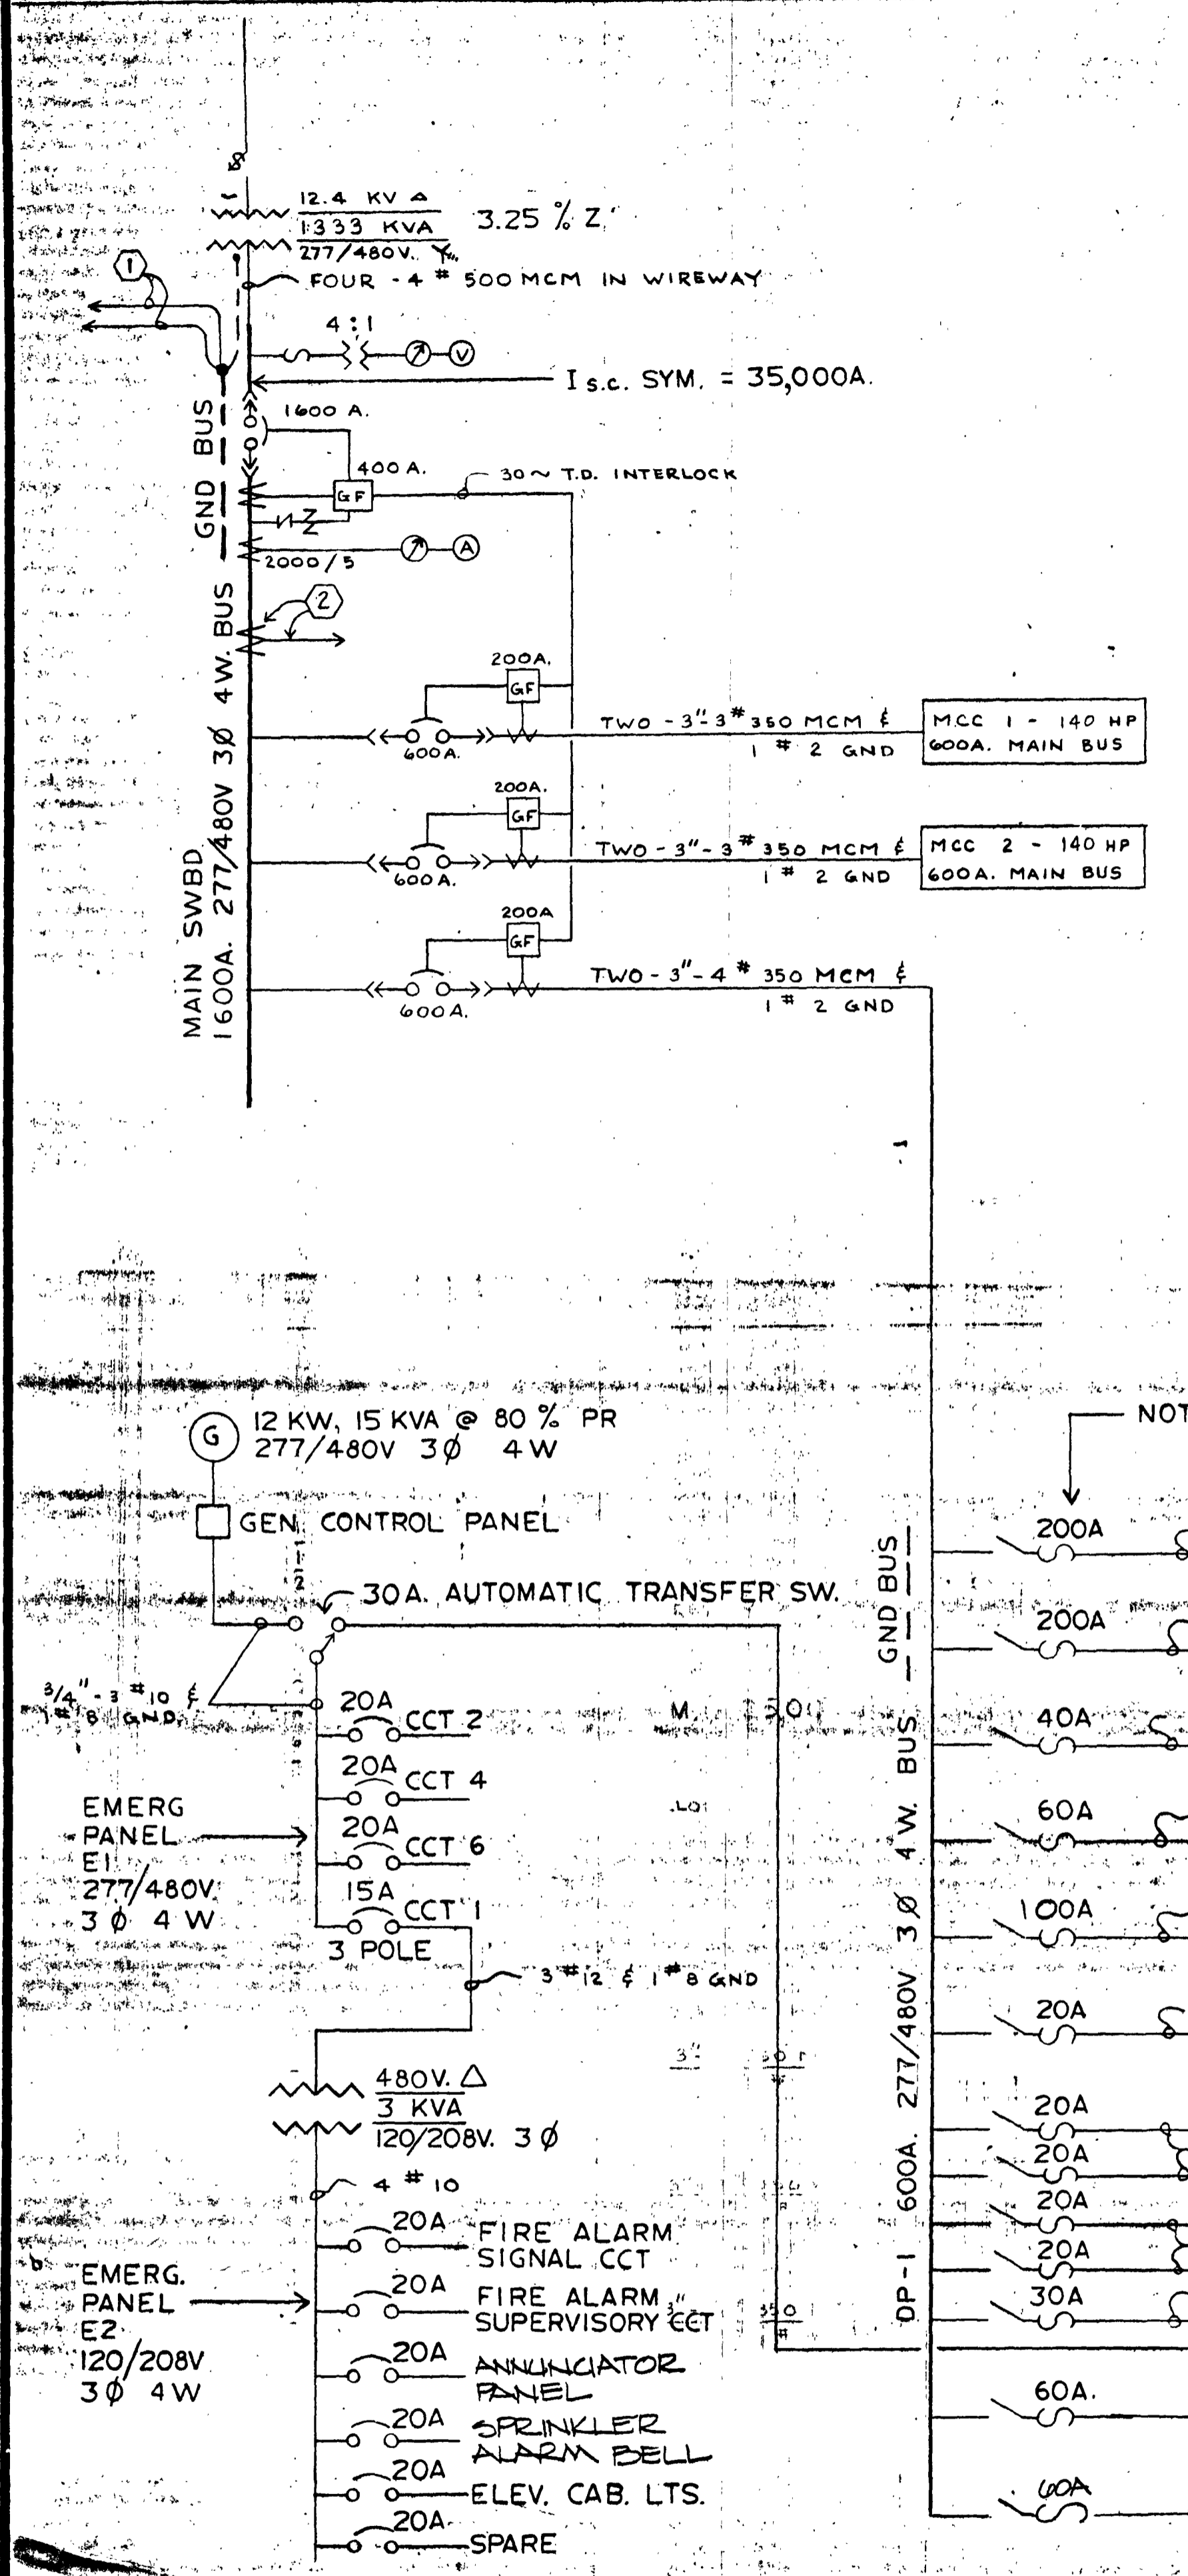


ONE LINE POWER DIAGRAM

ARCHITECTS - ENGINEERS - SURVEYORS
601 COLLEGE ROAD, FAIRBANKS, ALASKA 99701, PHONE: 452-1241

STATE OF ALASKA
DEPT. OF PUBLIC WORKS
DIVISION OF BUILDINGS
JUNEAU ALASKA

FAIRBANKS PARKING STRUCTURE
FAIRBANKS, AK.
DBA - 2 - 0130

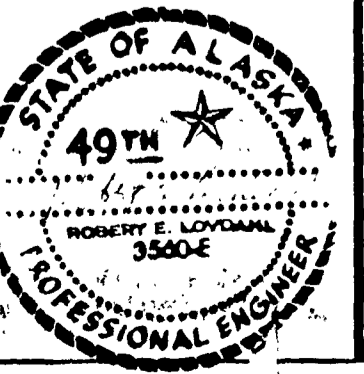

E4
SHEET 149 OF 149