T13N R3W SEC 28
TR 2

POLE CONTACT RECORD		
LOCATION	ATU	CATV
INITIAL/DATE		

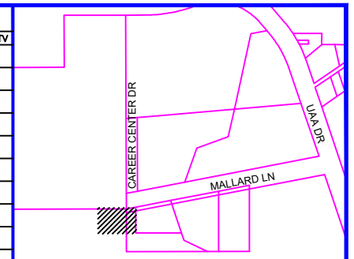

Vicinity Map
N.T.S.

CONDUCTOR DATA

Manuf.	Manuf.
Manuf. Date	Manuf. Date
Volt Rating	Volt Rating
Insul. Type	Insul. Type
Insul. Size	Insul. Size
Cond. Size/Type	Cond. Size/Type
Quantity in Feet	Quantity in Feet
Manuf.	Manuf.
Manuf. Date	Manuf. Date
Volt Rating	Volt Rating
Insul. Type	Insul. Type
Insul. Size	Insul. Size
Cond. Size/Type	Cond. Size/Type
Quantity in Feet	Quantity in Feet

CALL BEFORE YOU DIG!

LOCATE CALL CENTER OF ALASKA (LCCA)
- ANCHORAGE AREA 278–3121
- STATEWIDE 800–478–3121

AT&T ALASCOM INC. 264–8465
ALASKA RAILROAD UTILITIES 265–2457
ALYESKA CABLE TV (GIRDWOOD) 783–2982
KULIS AIR BASE 249–1499
MILITARY PETROLEUM FUEL LINES ..... 552–2334 OR 552–5342
STATE STORM DRAINS & STREET LIGHTS 333–2411

CONSTRUCTION LEGEND

NEW		EXISTING
	PADMOUNT TRANSFORMER	
▲	PEDESTAL	△
●	POWER POLE	○
	STREET LIGHT	
■	WARNING POST	□
	1ϕ U.G. PRI. CONDUCTOR	
	3ϕ U.G. PRI. CONDUCTOR	
	U.G. SECONDARY CONDUCT.	
	U.G. STREET LIGHT CONDUCT.	
	1ϕ O.H. CONDUCTOR	
	3ϕ O.H. CONDUCTOR	
J	JUNCTION BOX	J
	SPLICE POINT	
	SPARE CONDUIT	
	CONDUIT W/ CONDUCTOR	
S	SWITCH CABINET	S

R.O.W. LEGEND

R.O.W. LINE
CENTERLINE OF TRENCH

UNLESS OTHERWISE NOTED
CHUGACH FACILITIES WILL BE
INSTALLED AS SHOWN BELOW

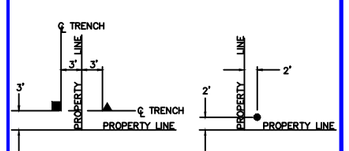

Typical Staking
N.T.S.

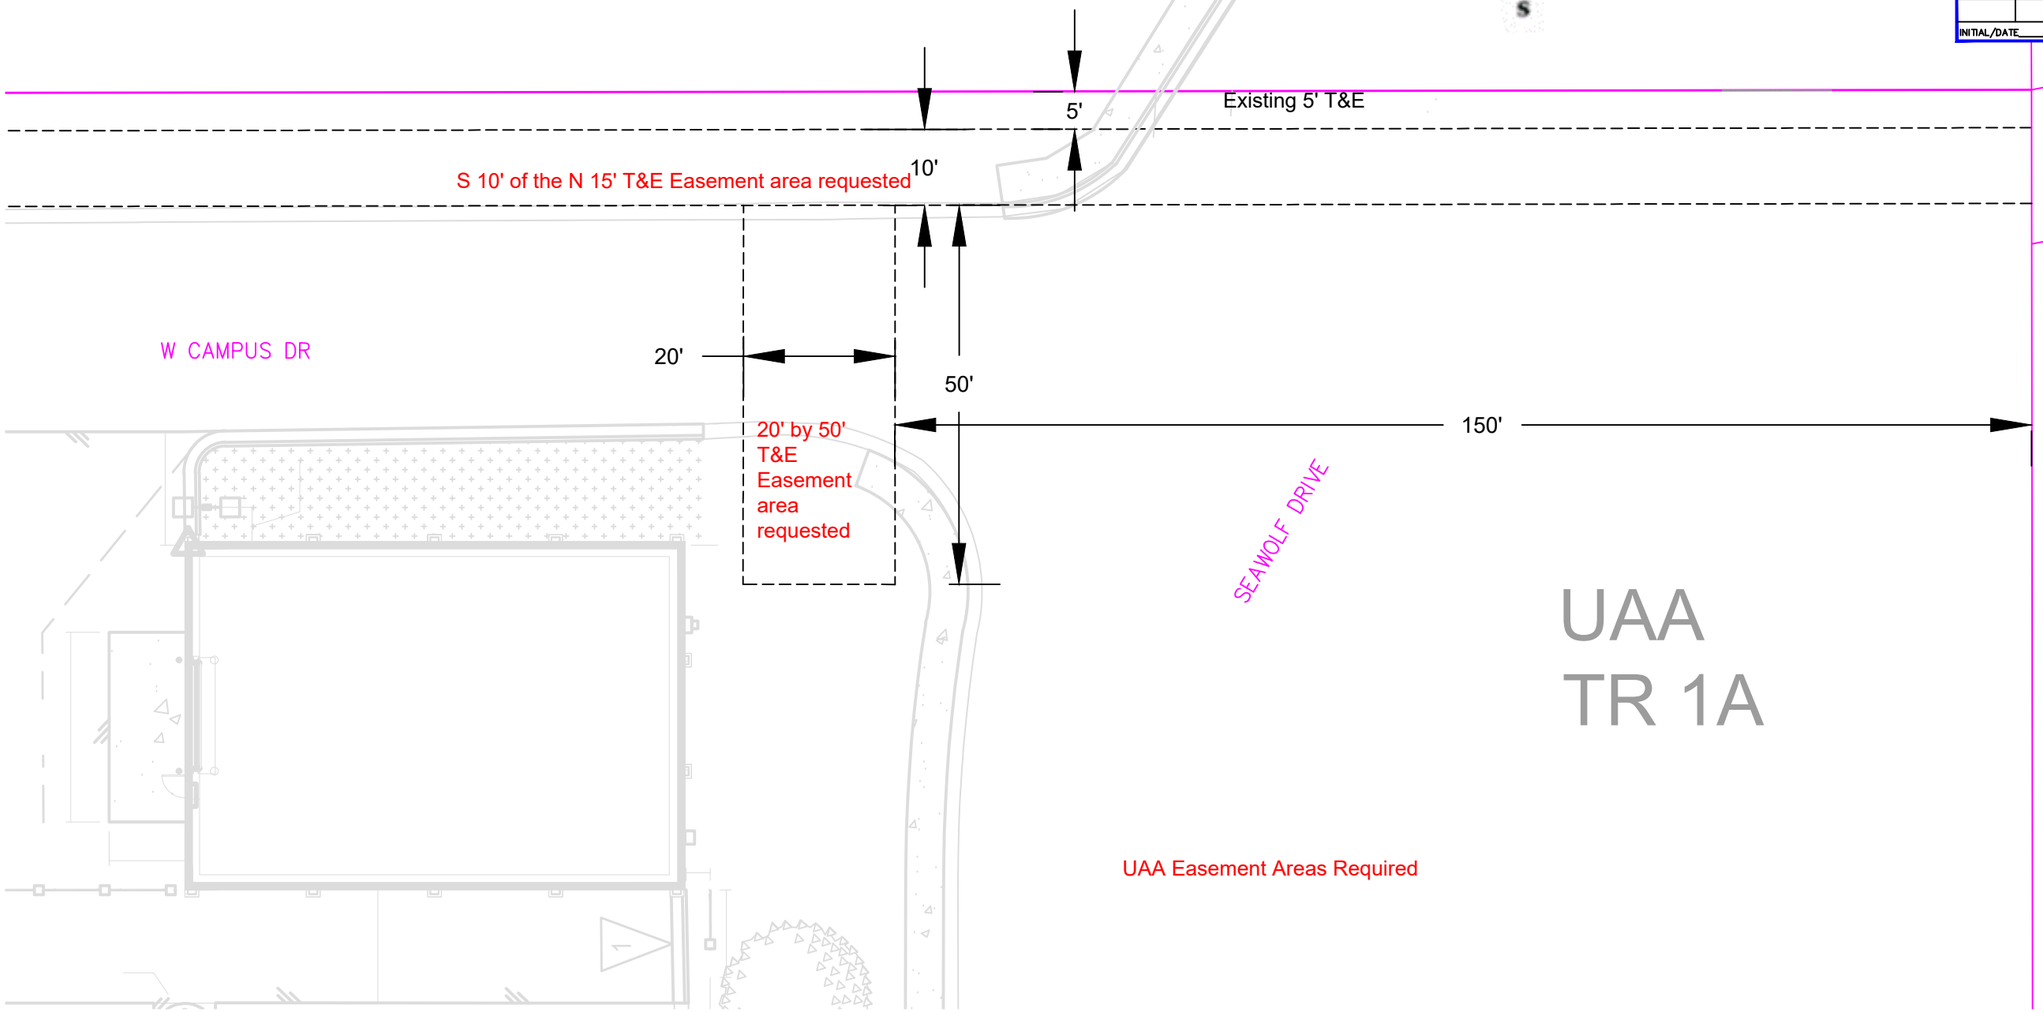

PROJECT: UAA TRACT 1A
DESIGNER/PROJECT ENGINEER: ASHLYNN NOETHLICH W.O. #: E2314201

NO.	DESIGN/CONSTRUCTION/ASBUILT REVISION	DWN BY/DATE	REVIEWED (MGR/SUPV)/DATE	APPROVED (DIRECTOR)/DATE
A	PRELIMINARY	ABN2/28/24		
0	ISSUED FOR CONSTRUCTION			

ENG. STAMP

CHUGACH
POWERING ALASKA'S FUTURE

Chugach Electric Association, Inc. 5601
Electron Drive - P.O. Box 196300 Anchorage,
Alaska 99519-6300

DRAWING NAME:
UAA TRACT 1A
1ϕ U.G. PRIMARY LINE EXTENSION
GRID: 1634 MAP:1303 - 28B
FEEDER: S8F16

W.O. NO.:
C.W.P. REF. NO.: E2314201

SHT. 1 OF 1